


TYPICAL SECTIONS & DESIGN DATA

ITEM 406.25 BITUMINOUS CONCRETE PAVEMENT
LEVELING COURSE TYPE IV (250 TONS/MILE)
1 1/4" WEARING COURSE TYPE III (± 1/4")
AS DIRECTED BY THE ENGINEER

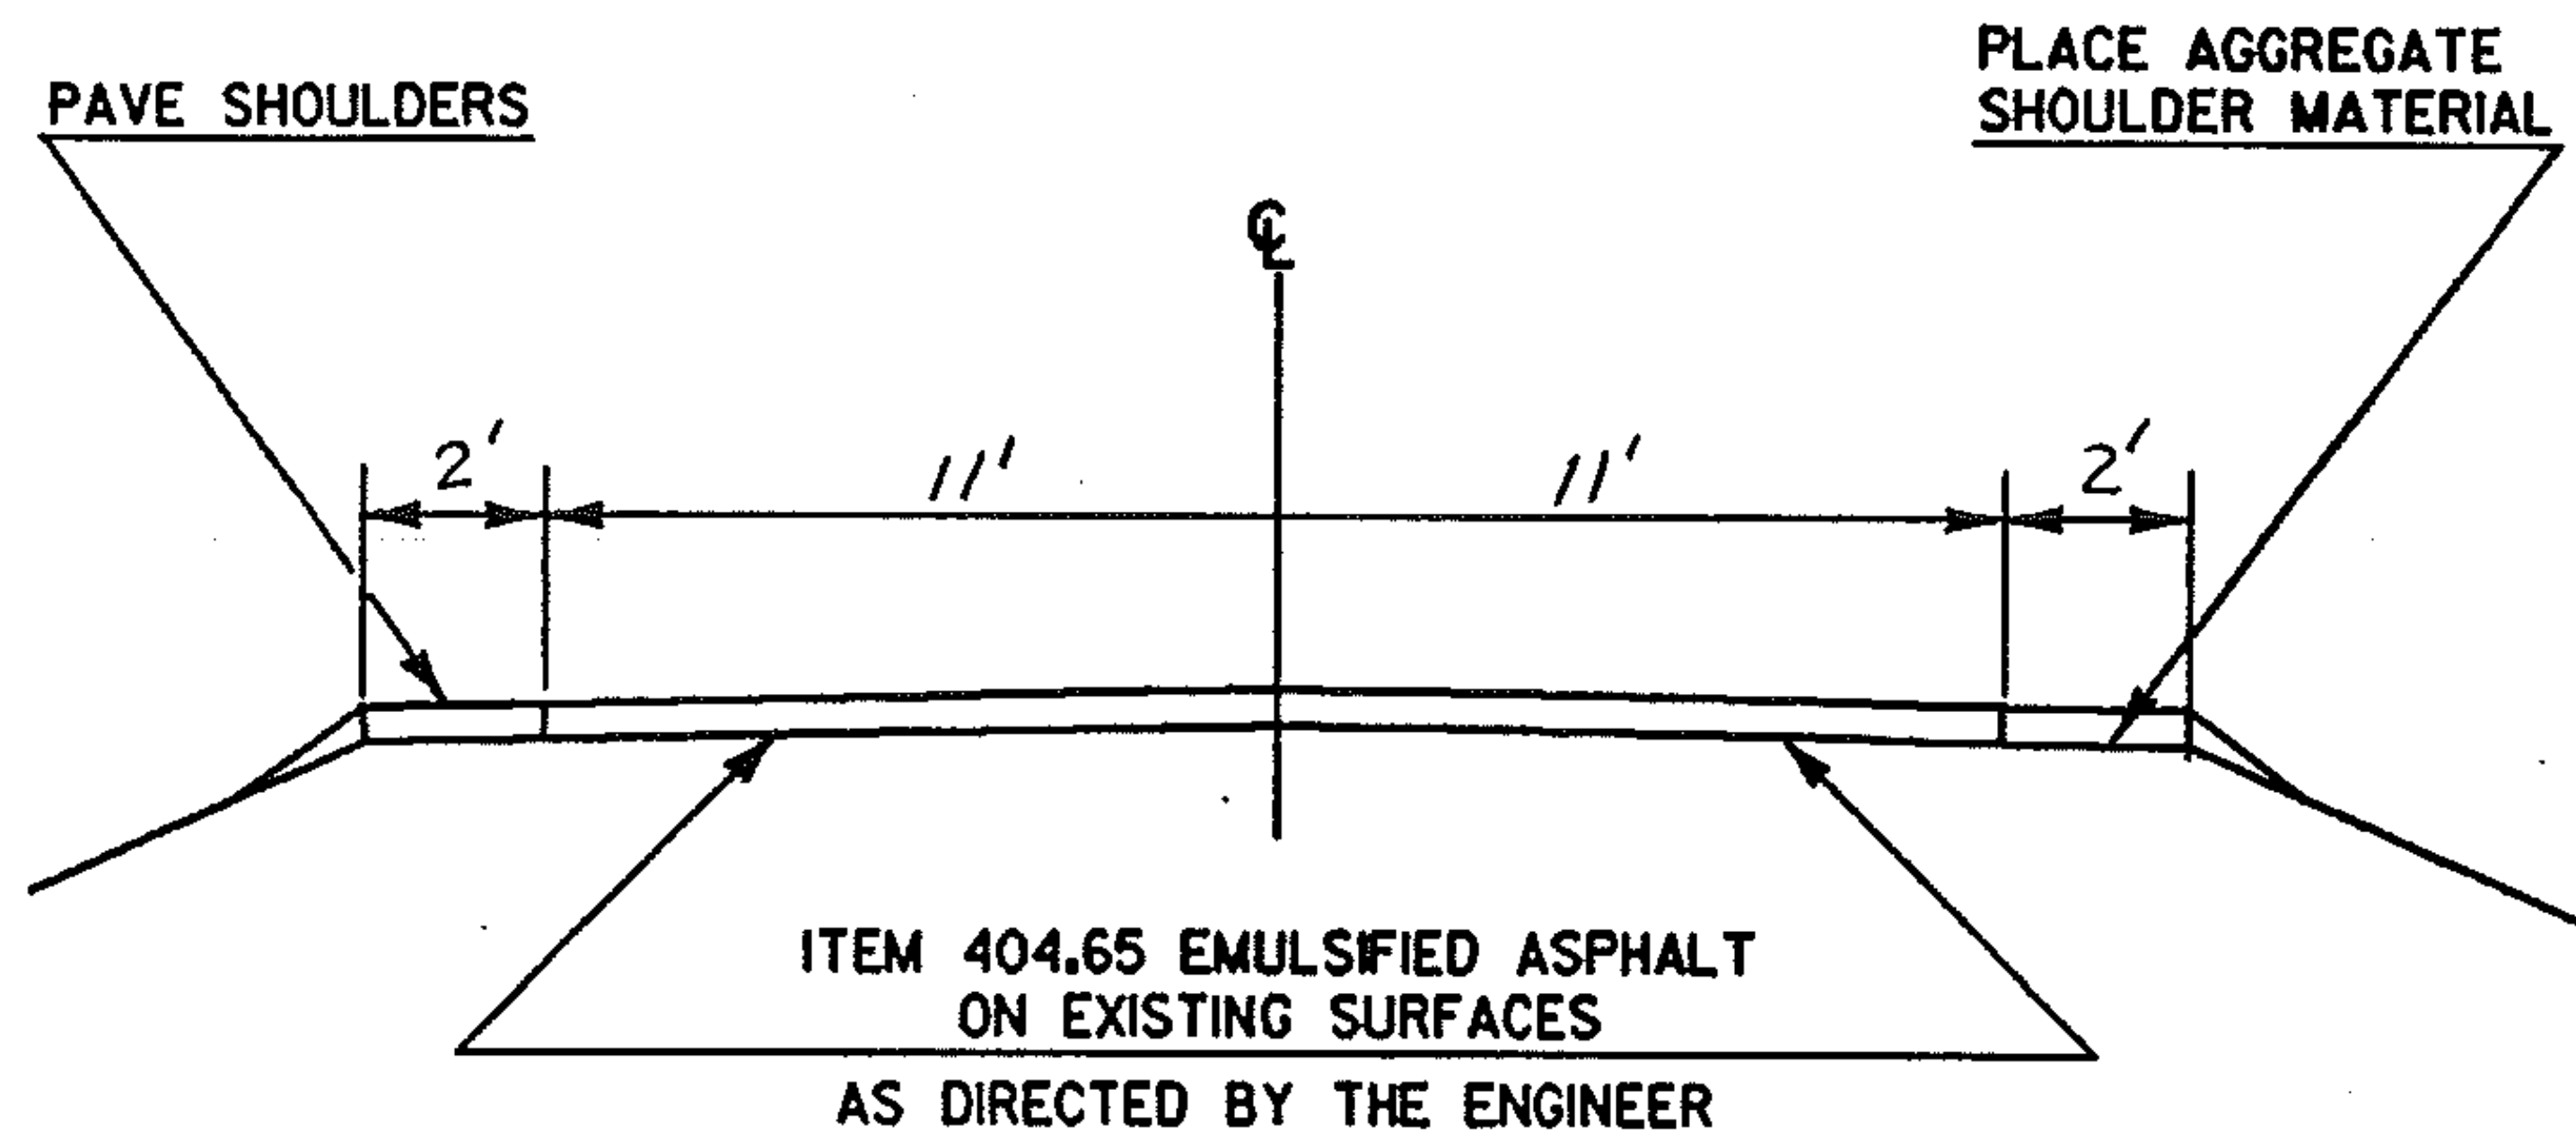

VT 78 MM 0.453 ~ MM 3.845

PROJECT SWANTON

NO. HMA 2814

SHEET 10 OF 60 SHEETS