
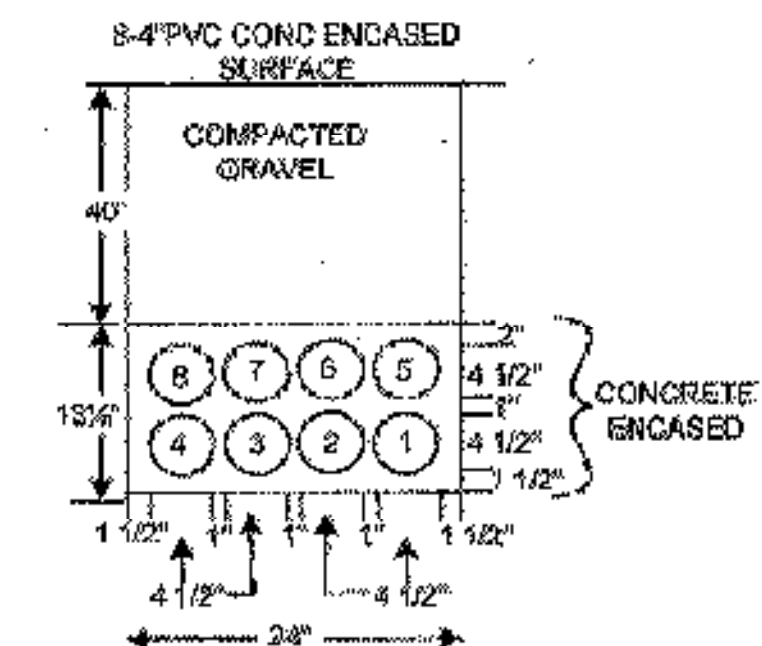


PROJ# 7AA08E


	SAFETY NOTES:		MOD/REV NO	DATE	R/W NO. 0
	Heavy Traffic				PRINT 2 OF 0
	SIGNATURE: <i>T.H. Bushey</i>		TYPE	RECORD REF.	PREPARED BY: T.H. BUSHEY
	DATE: 2/10/2006		AERIAL	1 & 1-1	C. O. / EXCHANGE NAME: RNDH
	PRE CT YES ☒ NO ☐	UNDERGROUND			C. O. / EXCHANGE CODE: 4873
	PRIMARY VOLTAGE TO GROUND	BLOCK (NYI)			MUNICIPALITY: Randolph
	7.2 KV MGN SYSTEM	CONDUIT	3 & 5		MANIFOLD LOCATION MH# NA
	CABLE PRESS UNDER PRESS YES ☐ NO ☒	YES ☐ NO ☒	YES ☐ NO ☒	YES ☐ NO ☒	NA
	TRANSMISSION 25 GA. LIMIT YES ☐ NO ☒	YES ☐ NO ☒	YES ☐ NO ☒	YES ☐ NO ☒	NA

25 GA. AREA, 24 GA. CABLE USED DUE TO DISTRICT POLICY

REVISED 2/24/2006

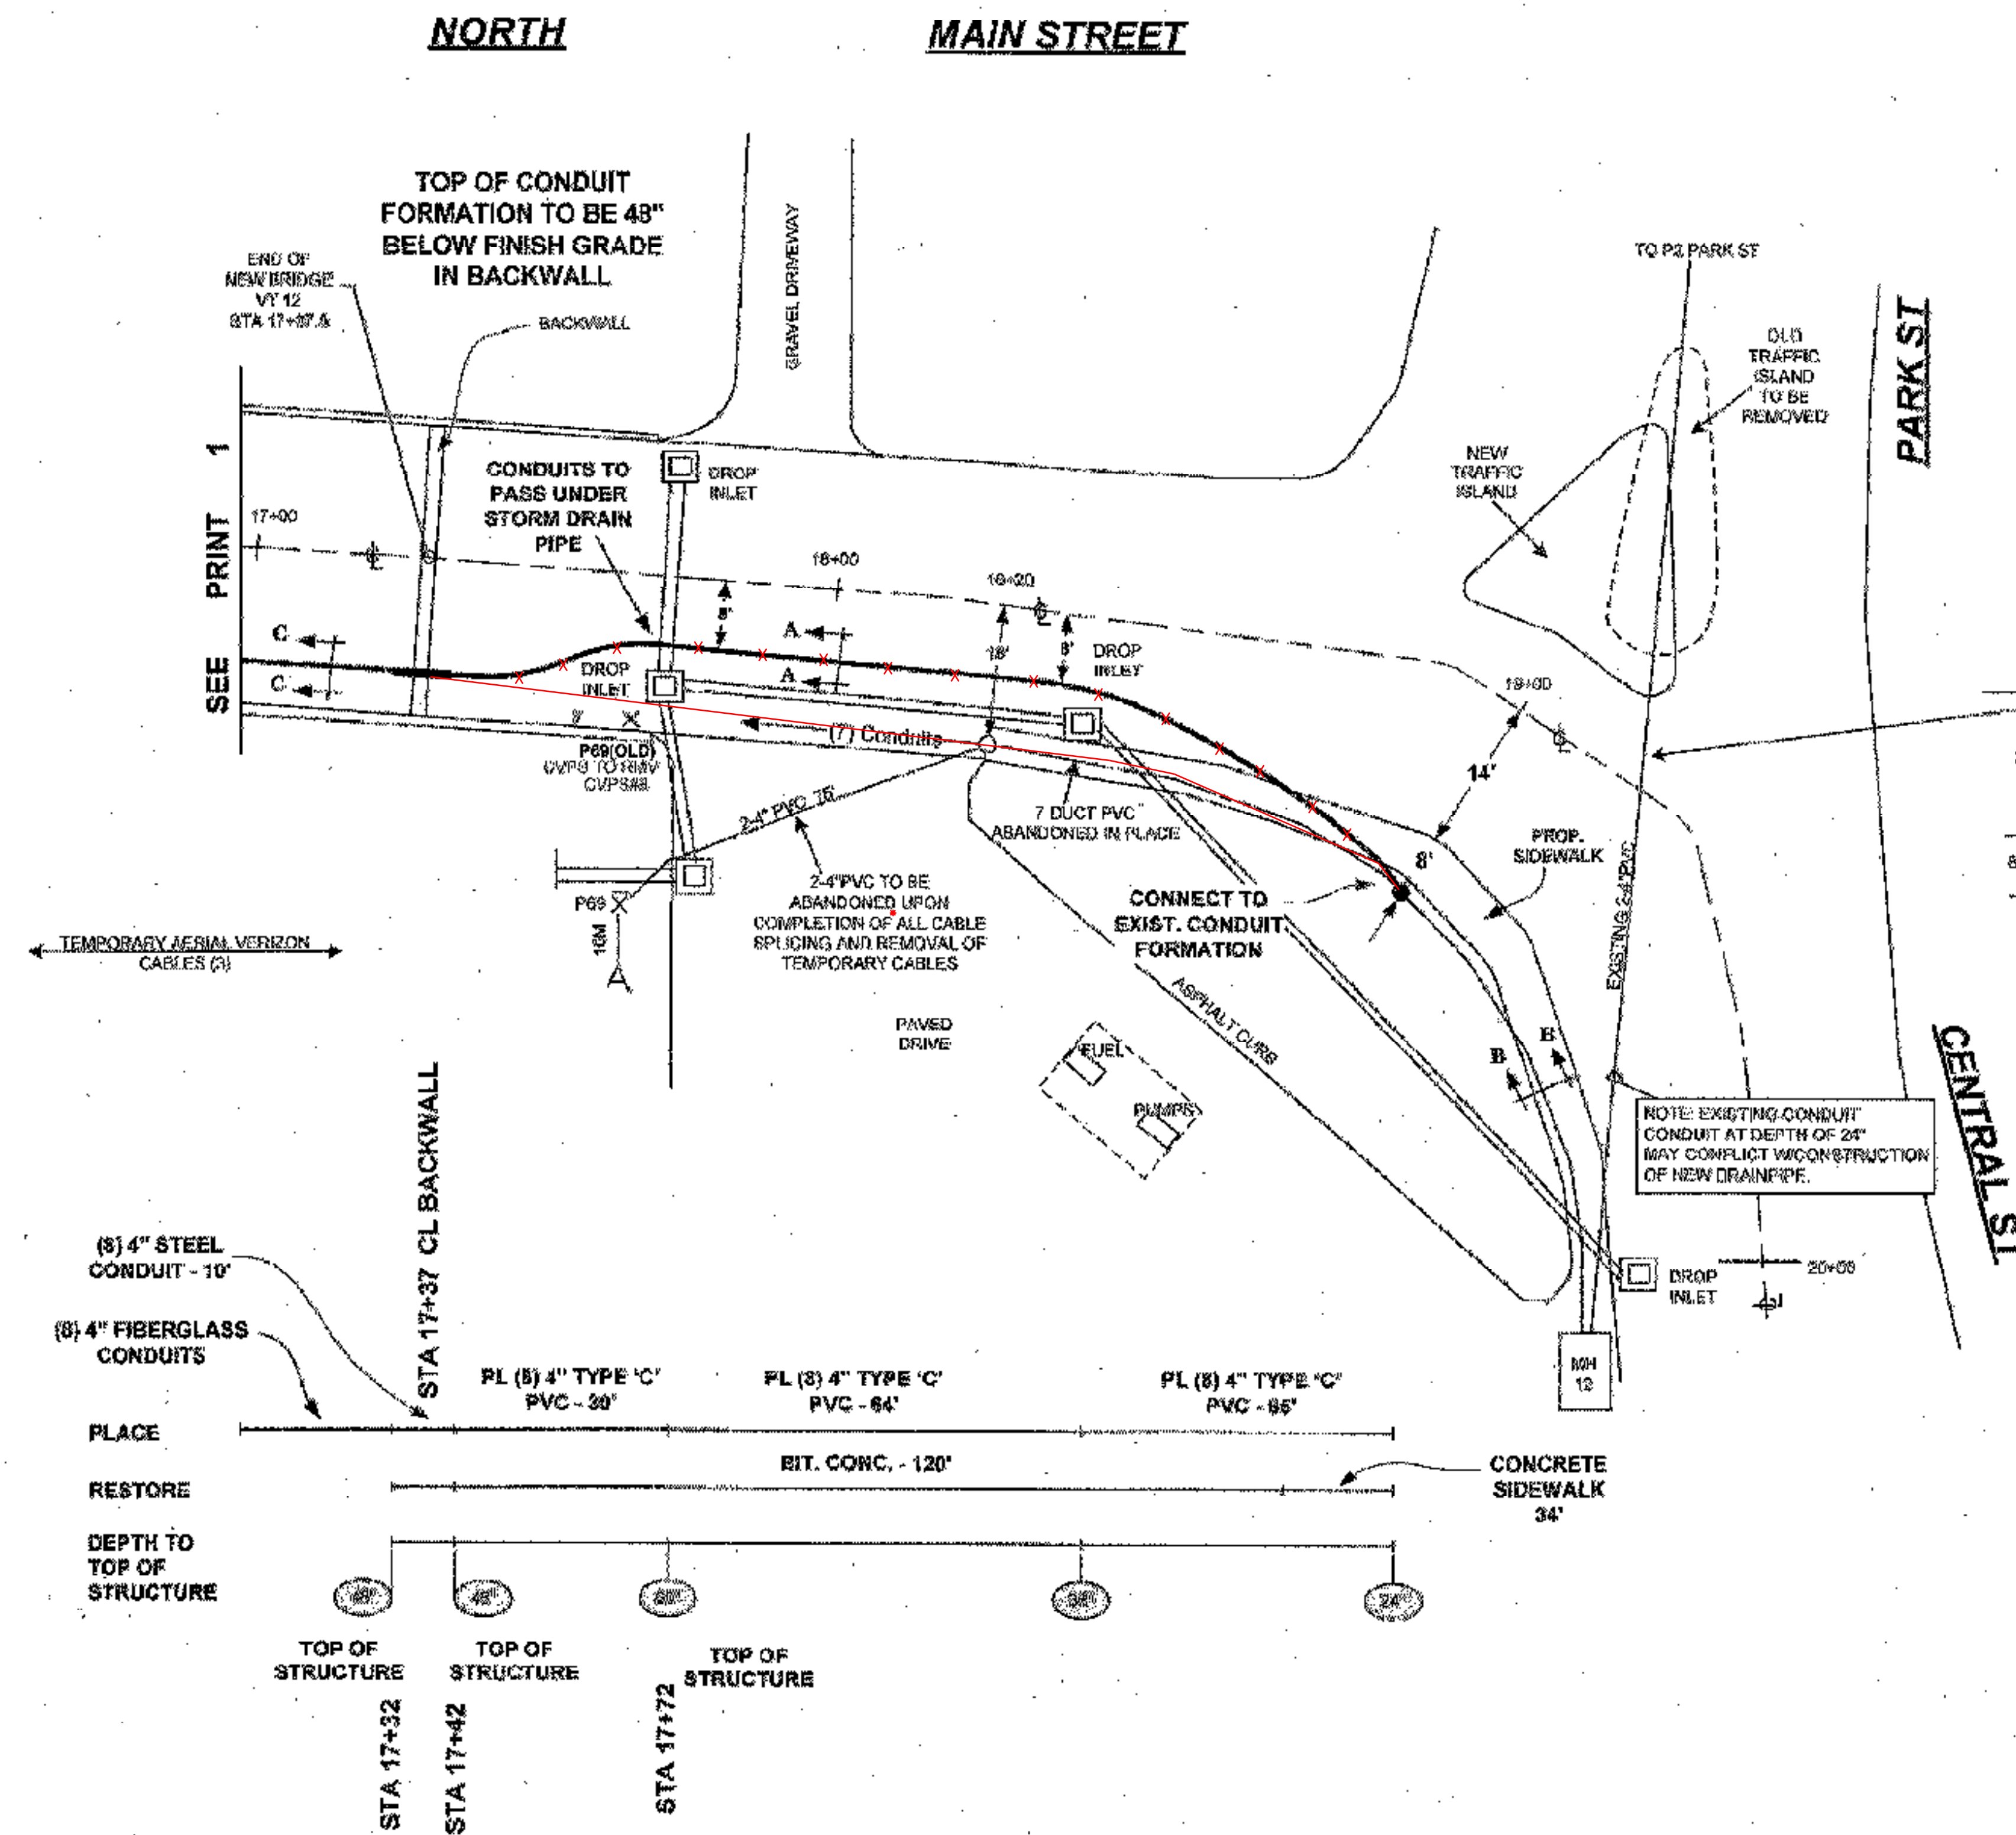


DETAIL A-A

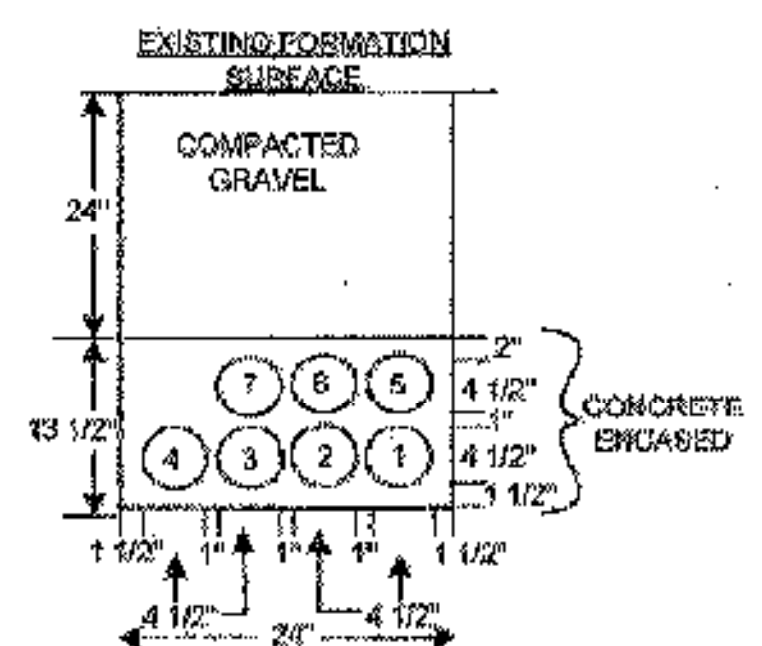

DETAIL B-B

DETAIL C-C
See Plan #5

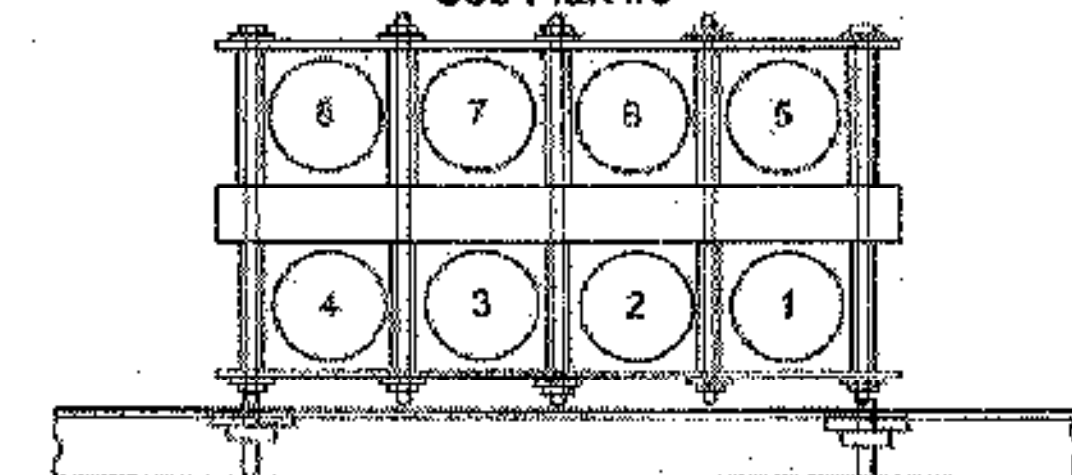

UTILITY - TELEPHONE DUCTS ON BRIDGE

PROJECT NAME:	RANDOLPH
PROJECT NUMBER:	BRF 024K(29)
FILE NAME: /88J096/SJ096/UTILITYRASTERS.DGN	PLOT DATE: 29-AUG-2006
PROJECT LEADER: W. SYMONDS	DRAWN BY: G. SHANGRAW
DESIGNED BY: VERIZON, INC.	CHECKED BY: T. SUMNER
sj096verizon6.i	SHEET 98 OF 135