
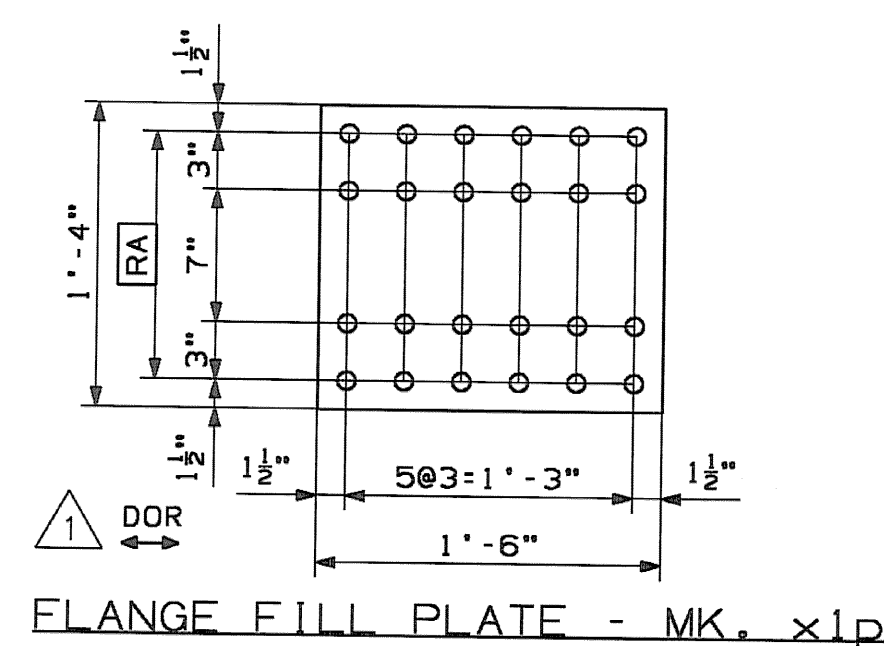
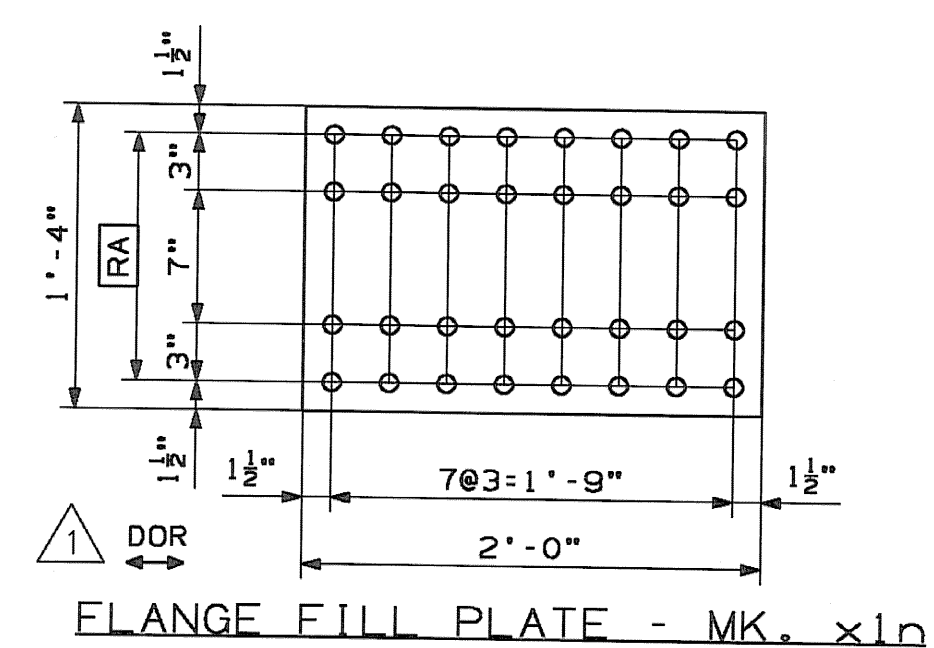
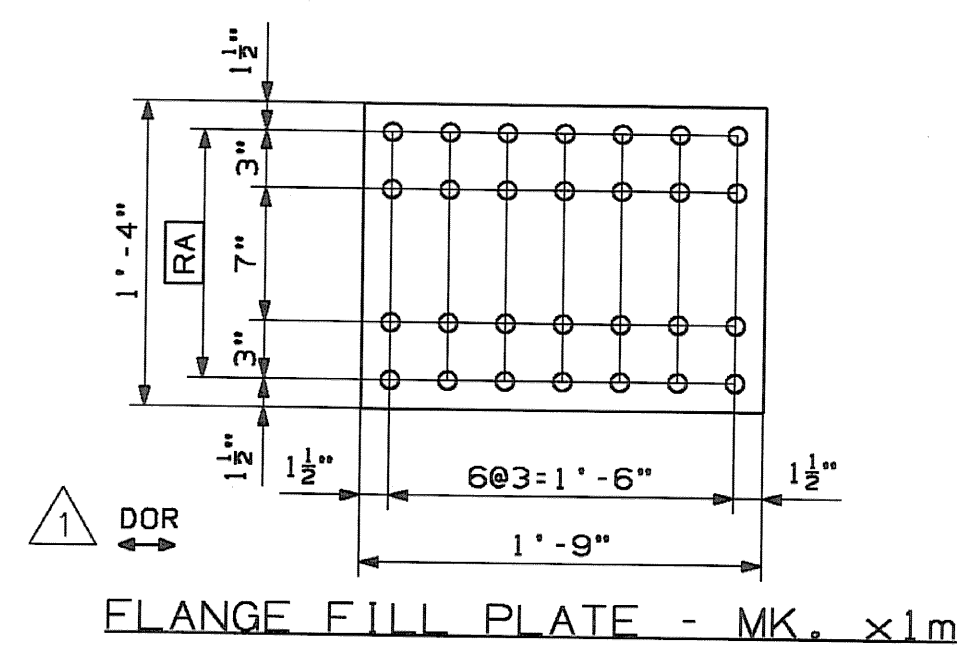
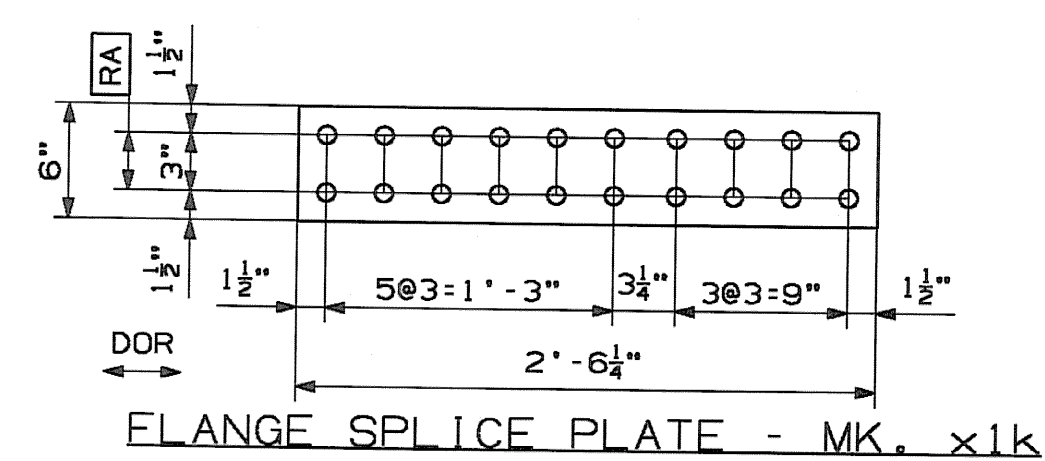
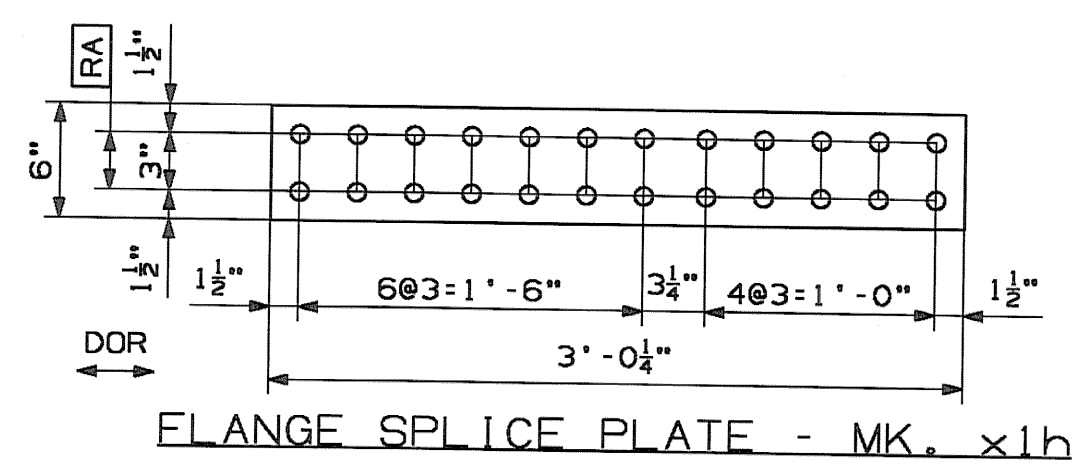
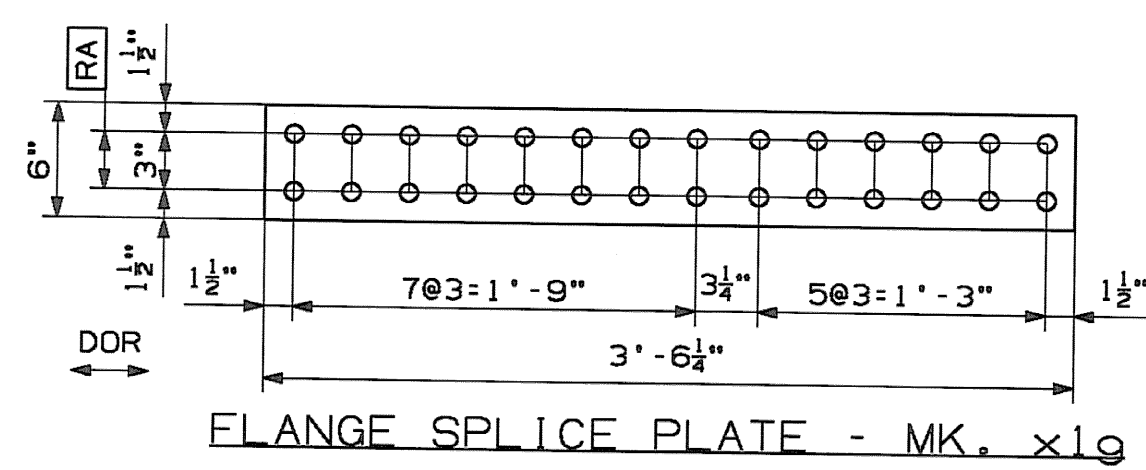
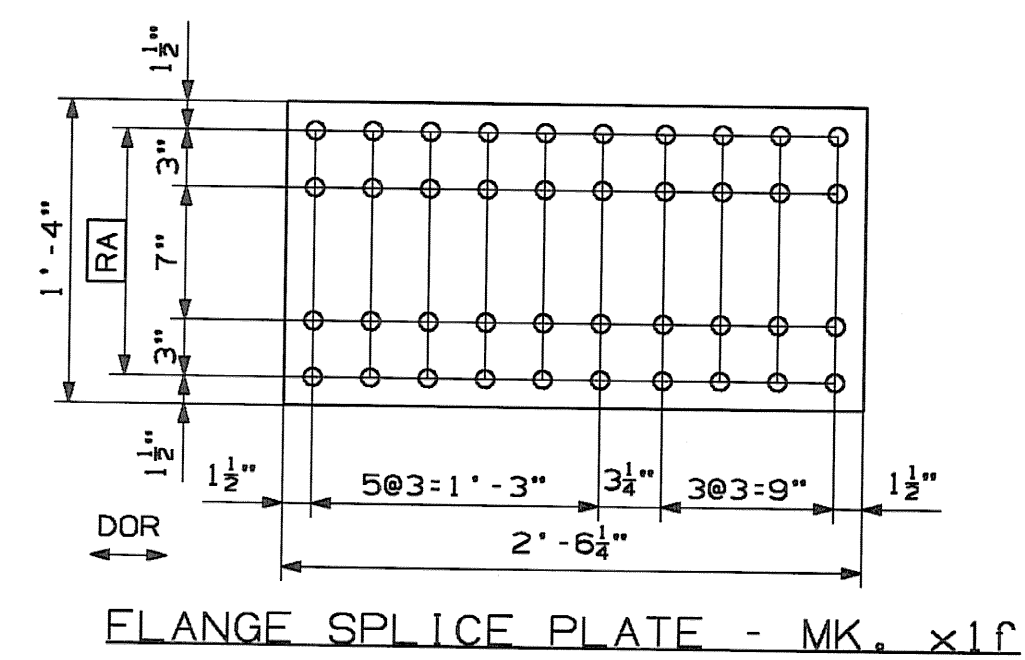
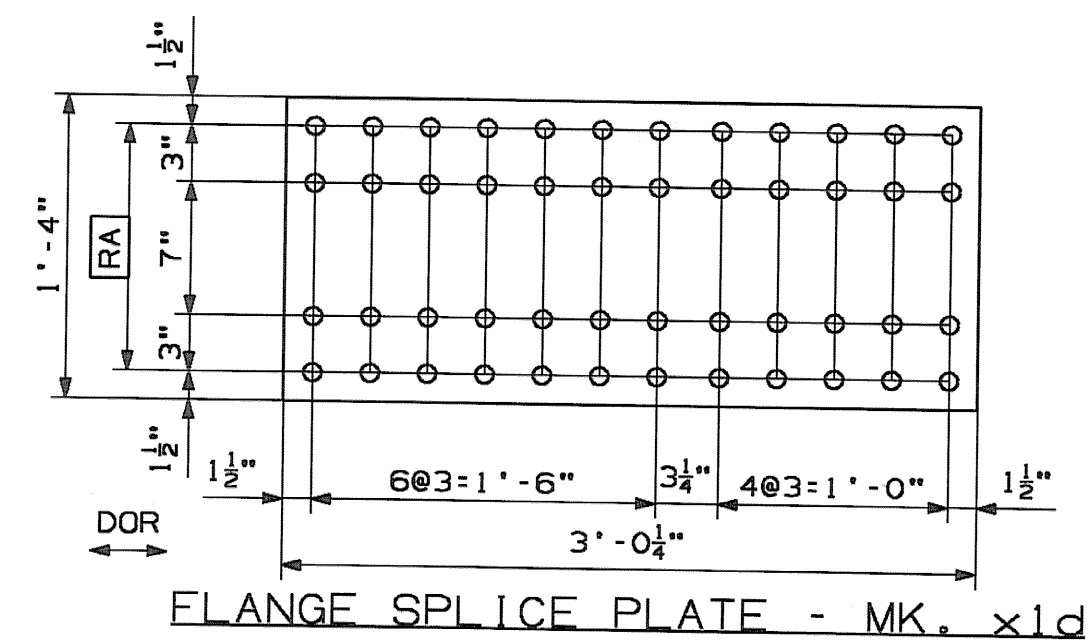
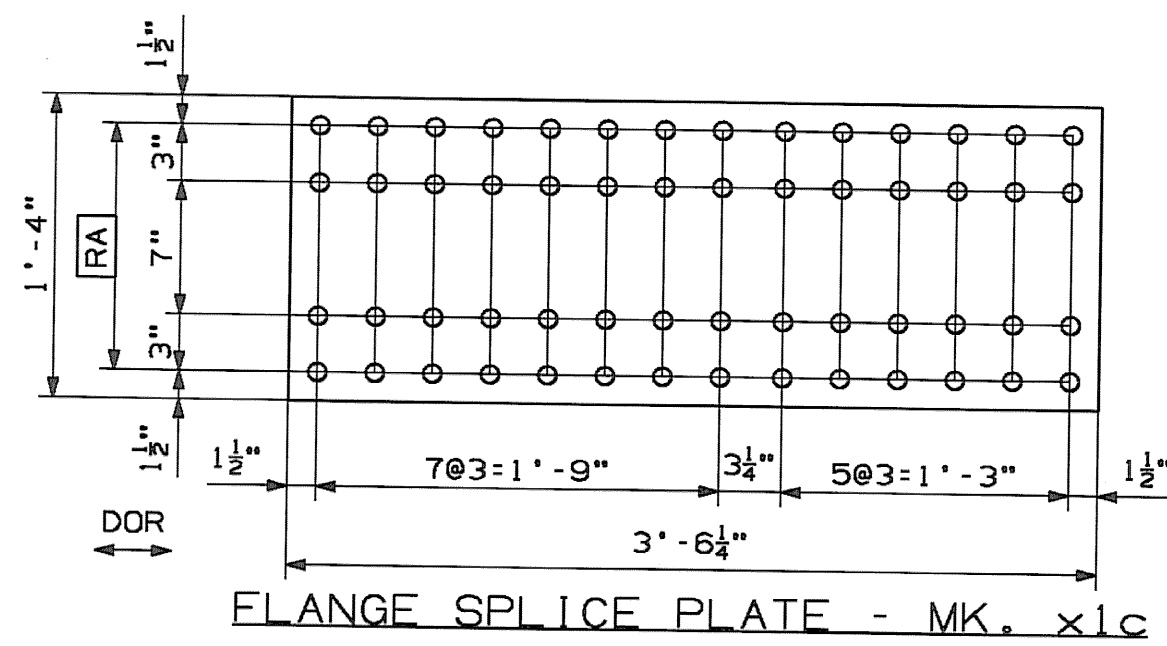
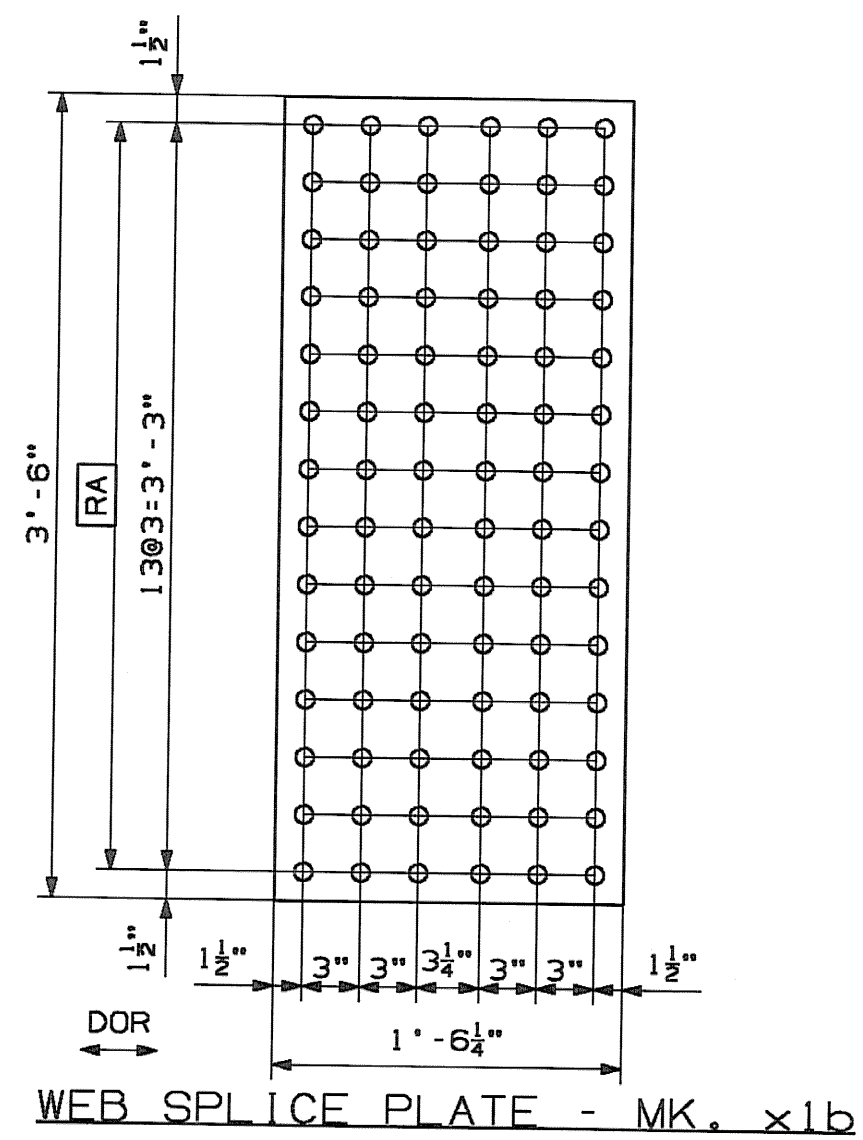
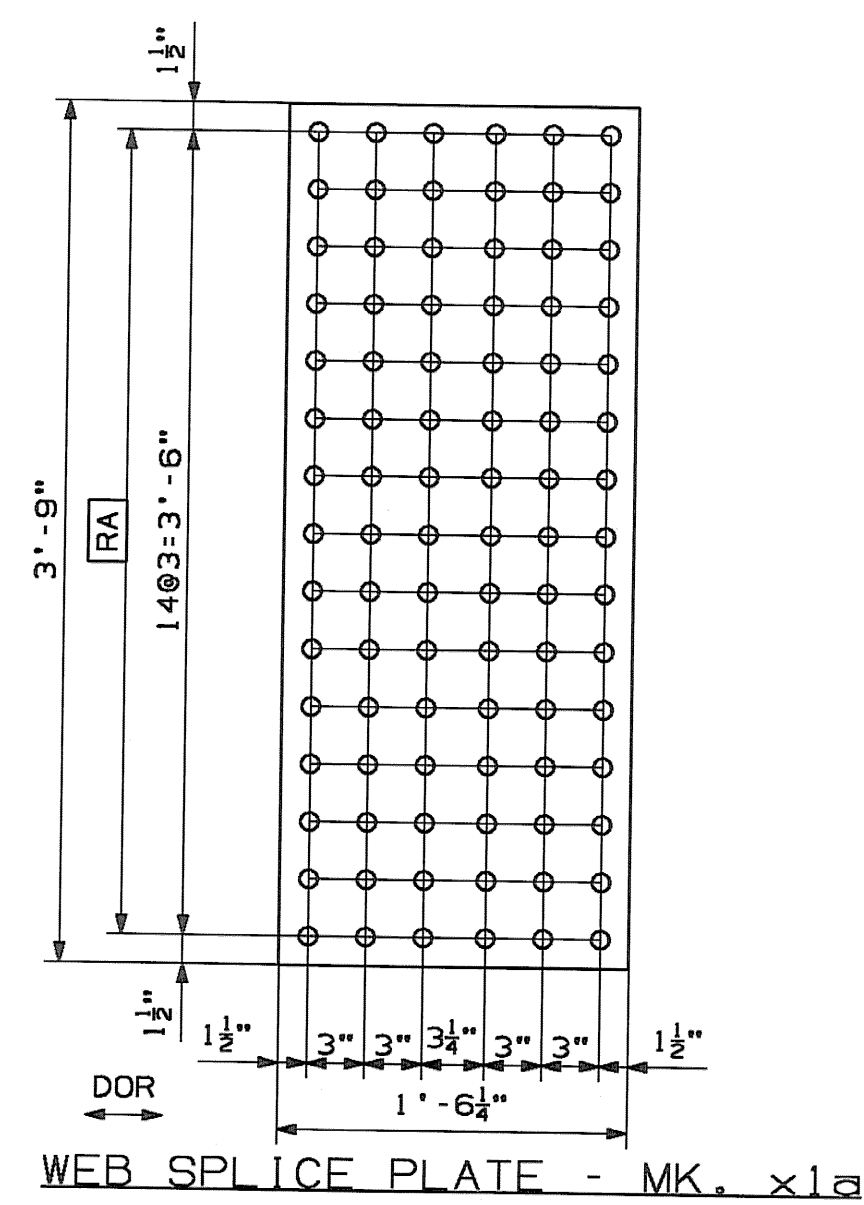


[illegible]

RECEIVED
CK'D BY TCF OK'D BY _____
JAN 30 2007
RESUBMIT _____ APPROVED TCF
BY W. S. DATE 1-31-2007

			
	ADDED DIRECTION OF ROLL AND CHARRY TEST	MAF	1-19-07
NO.	REVISION	BY	DATE

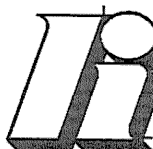

1770 Hempstead Road
Lancaster, PA 17605-0008
Phone 717/299-5211

A Division of High Industries, Inc.

GIRDER JOB STANDARDS
VT. 12 (MAIN ST.) OVER THIRD BRANCH OF THE WHITE RIVER
VT. 12 STA. 15+36.00 TO STA. 17+36.00
TOWN OF RANDOLPH, ORANGE COUNTY, VT. BRIDGE NO. 42
STATE OF VERMONT
AGENCY OF TRANSPORTATION
STATE CONTRACT OR REF. NO. PROJECT NO. RANDOLPH BR# 0241 (29)
CONTRACTOR WINTERSET, INC.
IN CHARGE: BRITIGAN (IH) MADE BY: RC CK'D. BY: CS DATE: 11/7/06
CONTRACT NUMBER: VT-06215-1 DRAWING NUMBER: X1 OF X2

NOTES:

HOLES: 15/16" Ø
BOLTS: NONE
PAINT: NONE
FOR GENERAL SHOP NOTES, SEE DWG. GN1.

CODE: 30