



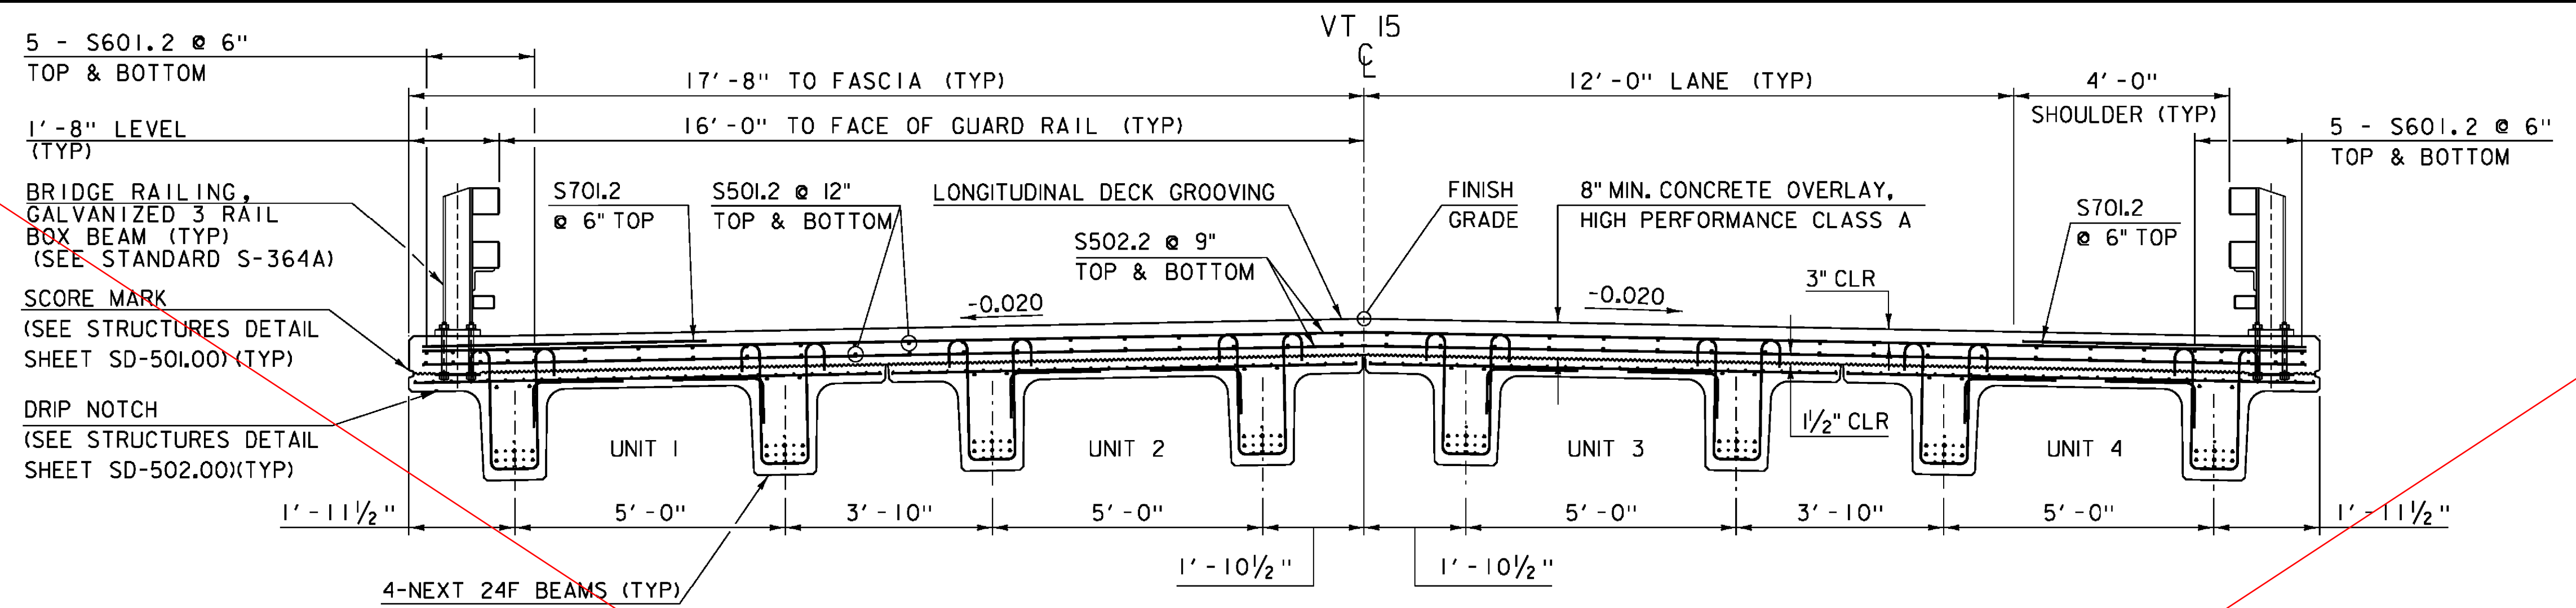

BRIDGE TYPICAL SECTION

SCALE: 1/2" = 1'-0"

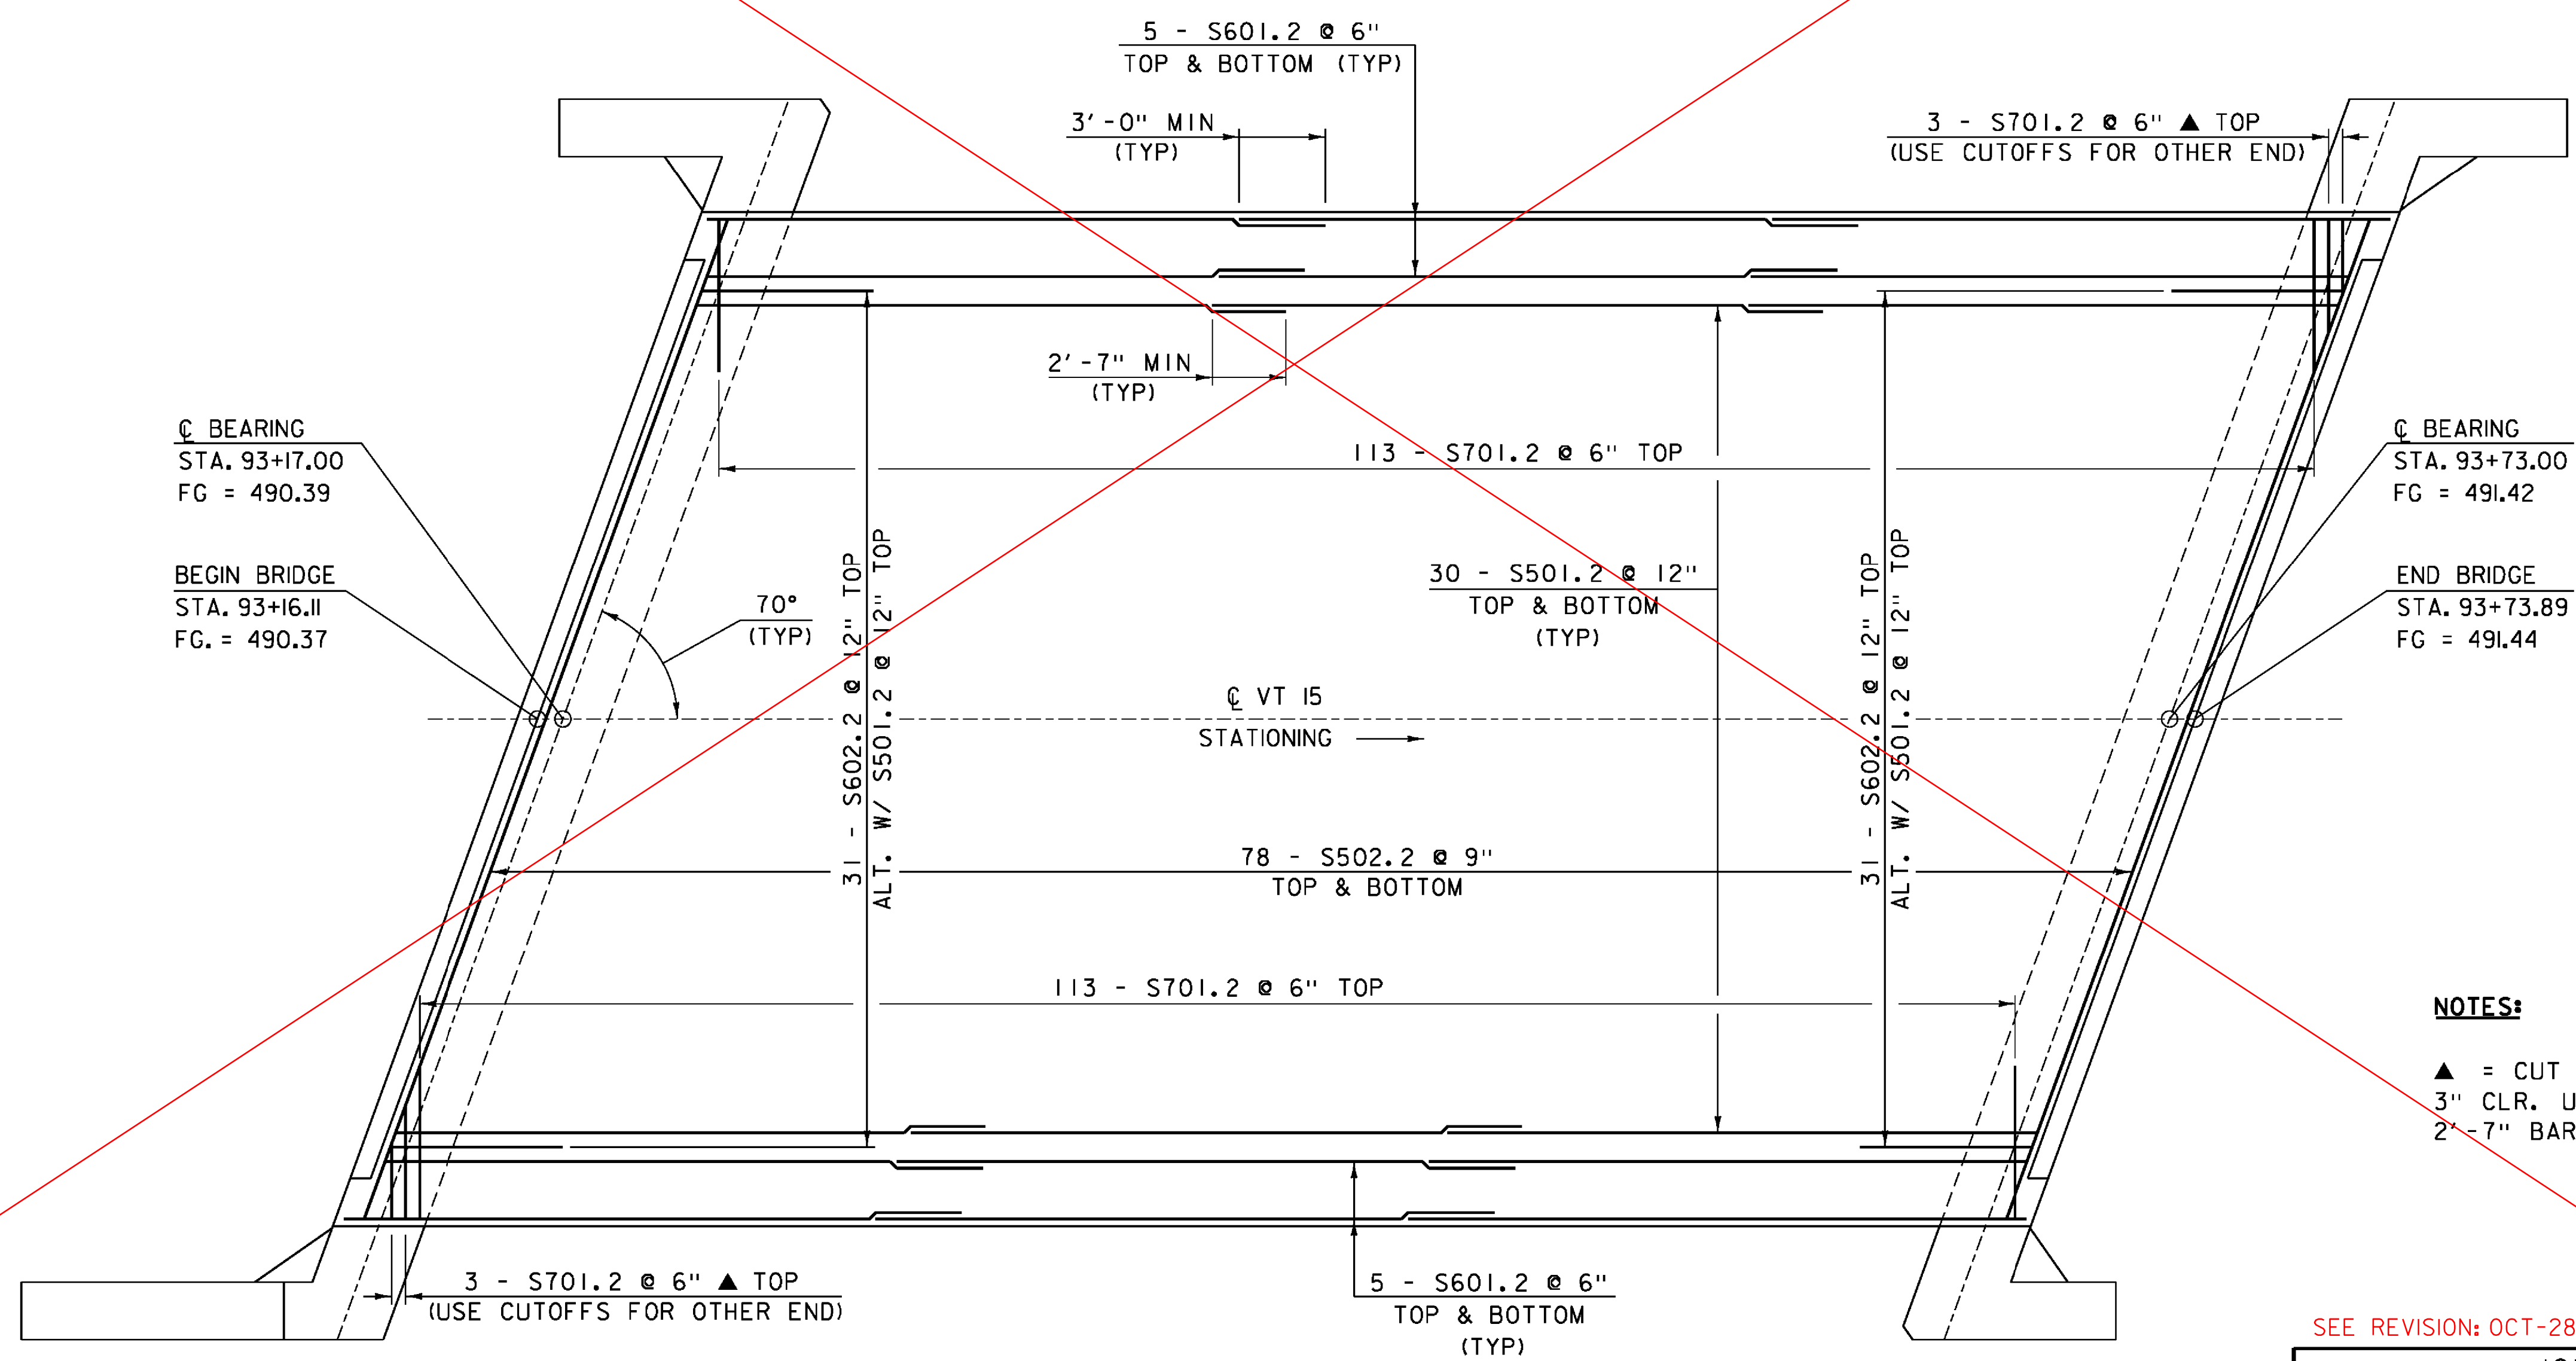

OVERLAY REINFORCING PLAN

SCALE: 1/4" = 1'-0"

SEE REVISION: OCT-28-2014

PROJECT NAME: JOHNSON
PROJECT NUMBER: BRF 030-2(26)

FILE NAME: s88bi93sup.dgn
PROJECT LEADER: C. CARLSON
DESIGNED BY: H. SALLS
BRIDGE DECK DETAILS

PLOT DATE: 10-JUN-2014
DRAWN BY: G. ROKES
CHECKED BY: H. SALLS
SHEET 27 OF 69