




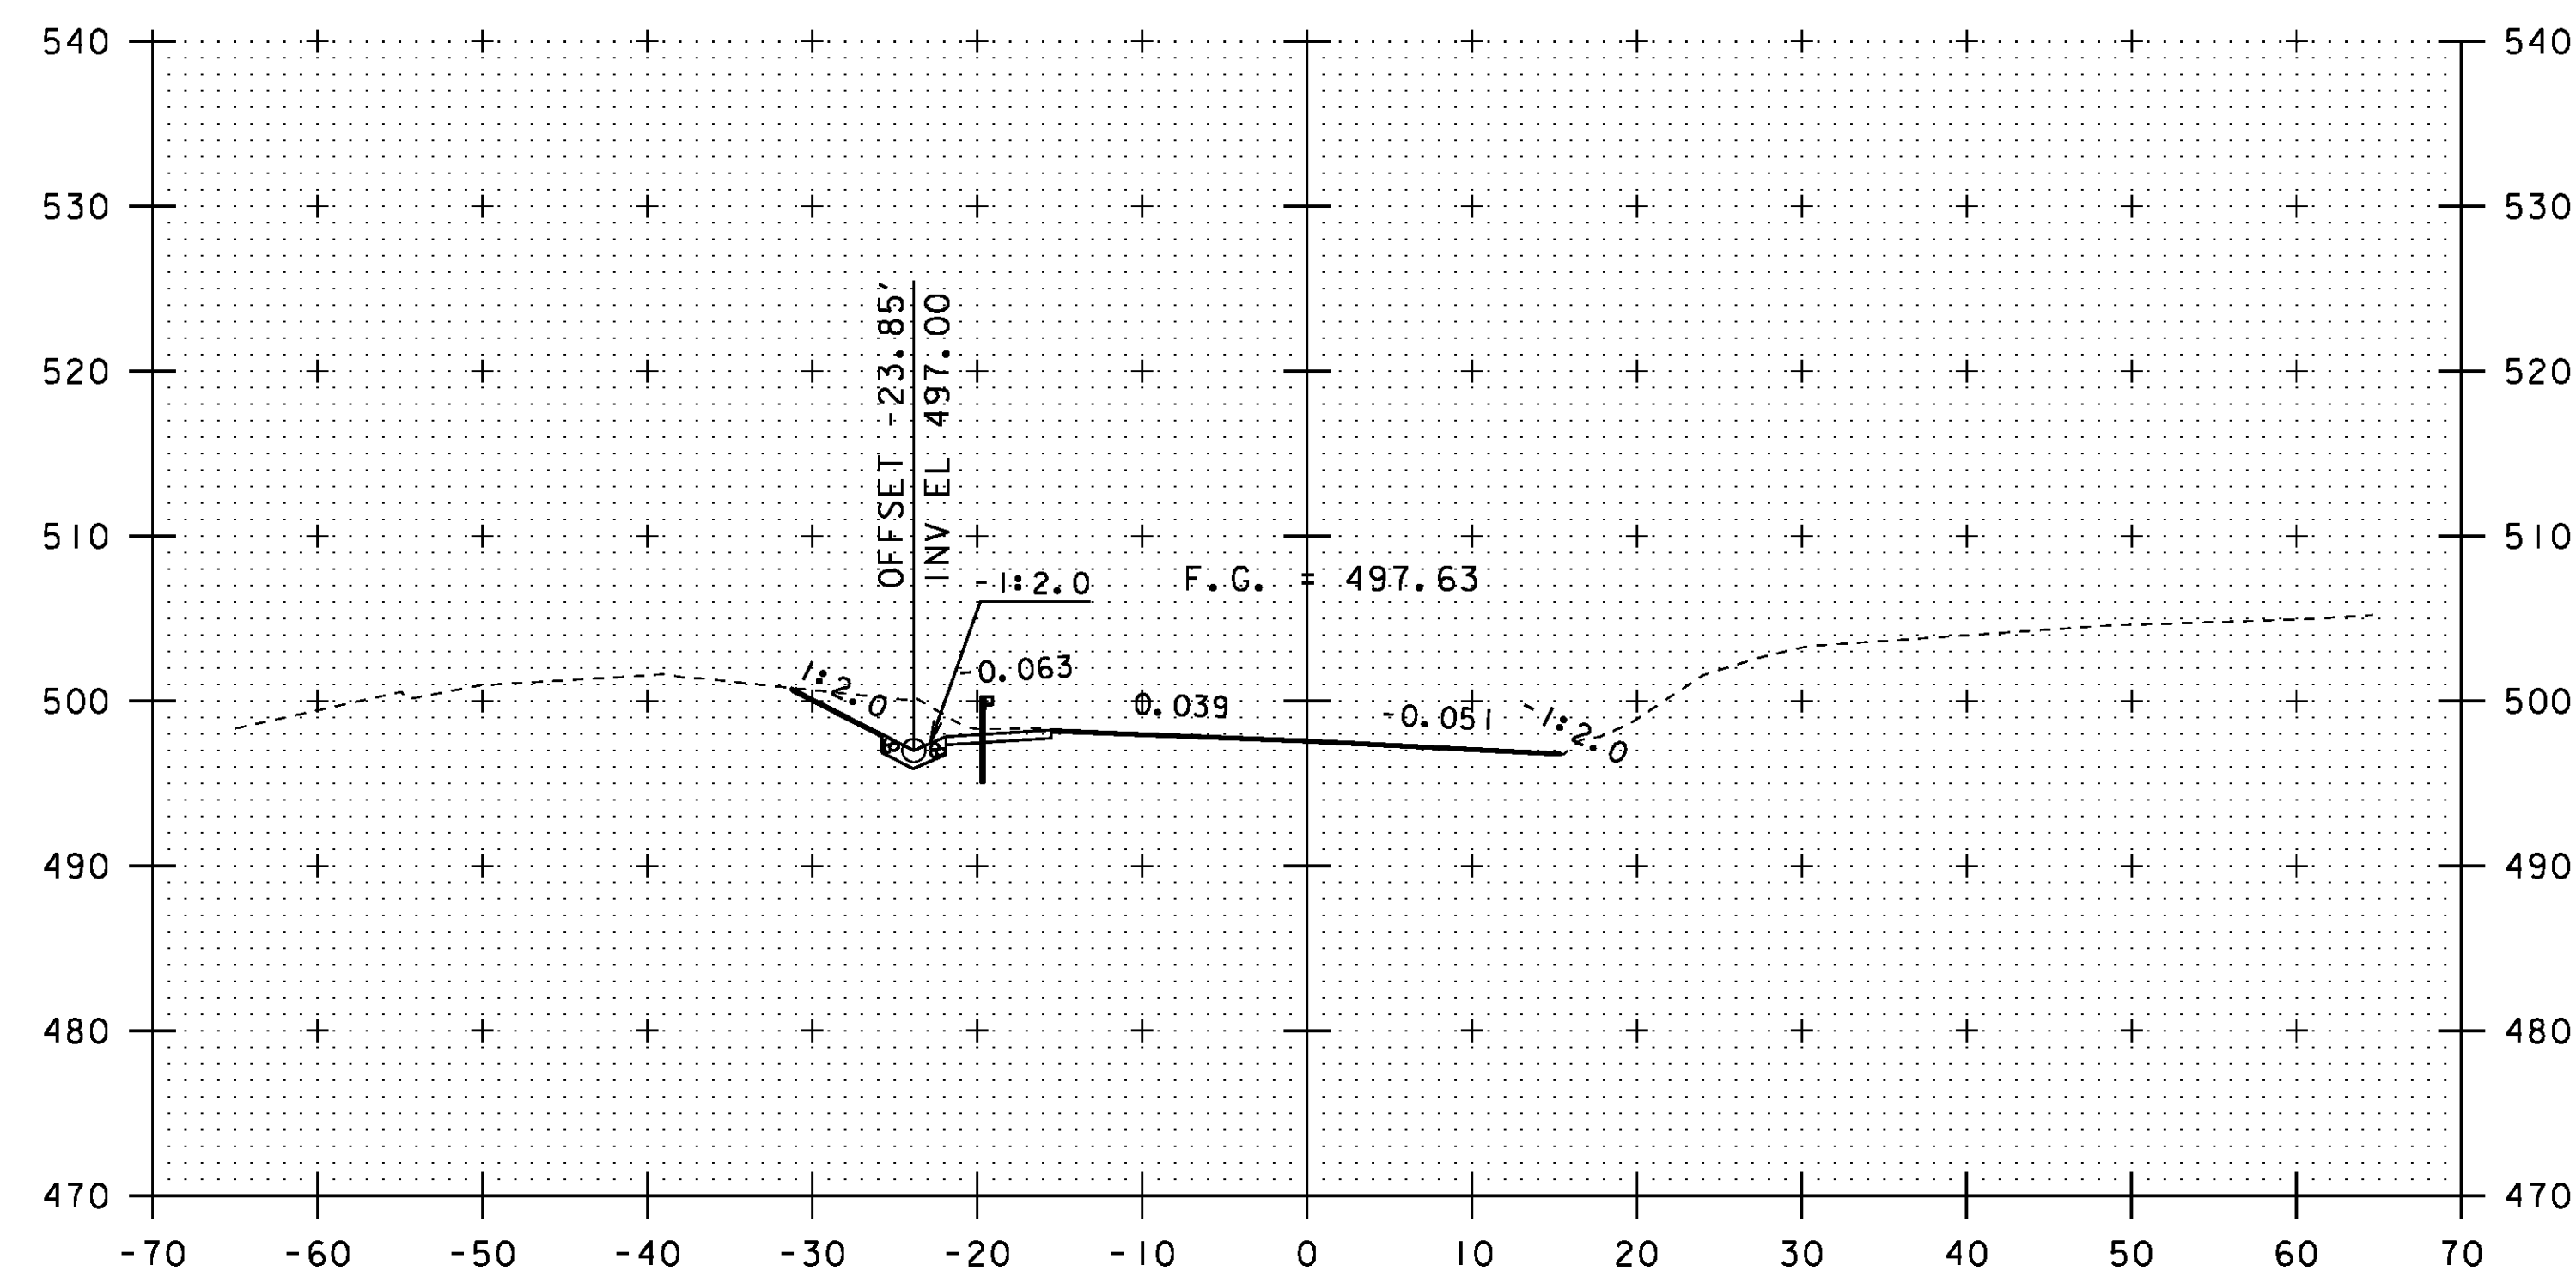


95+75

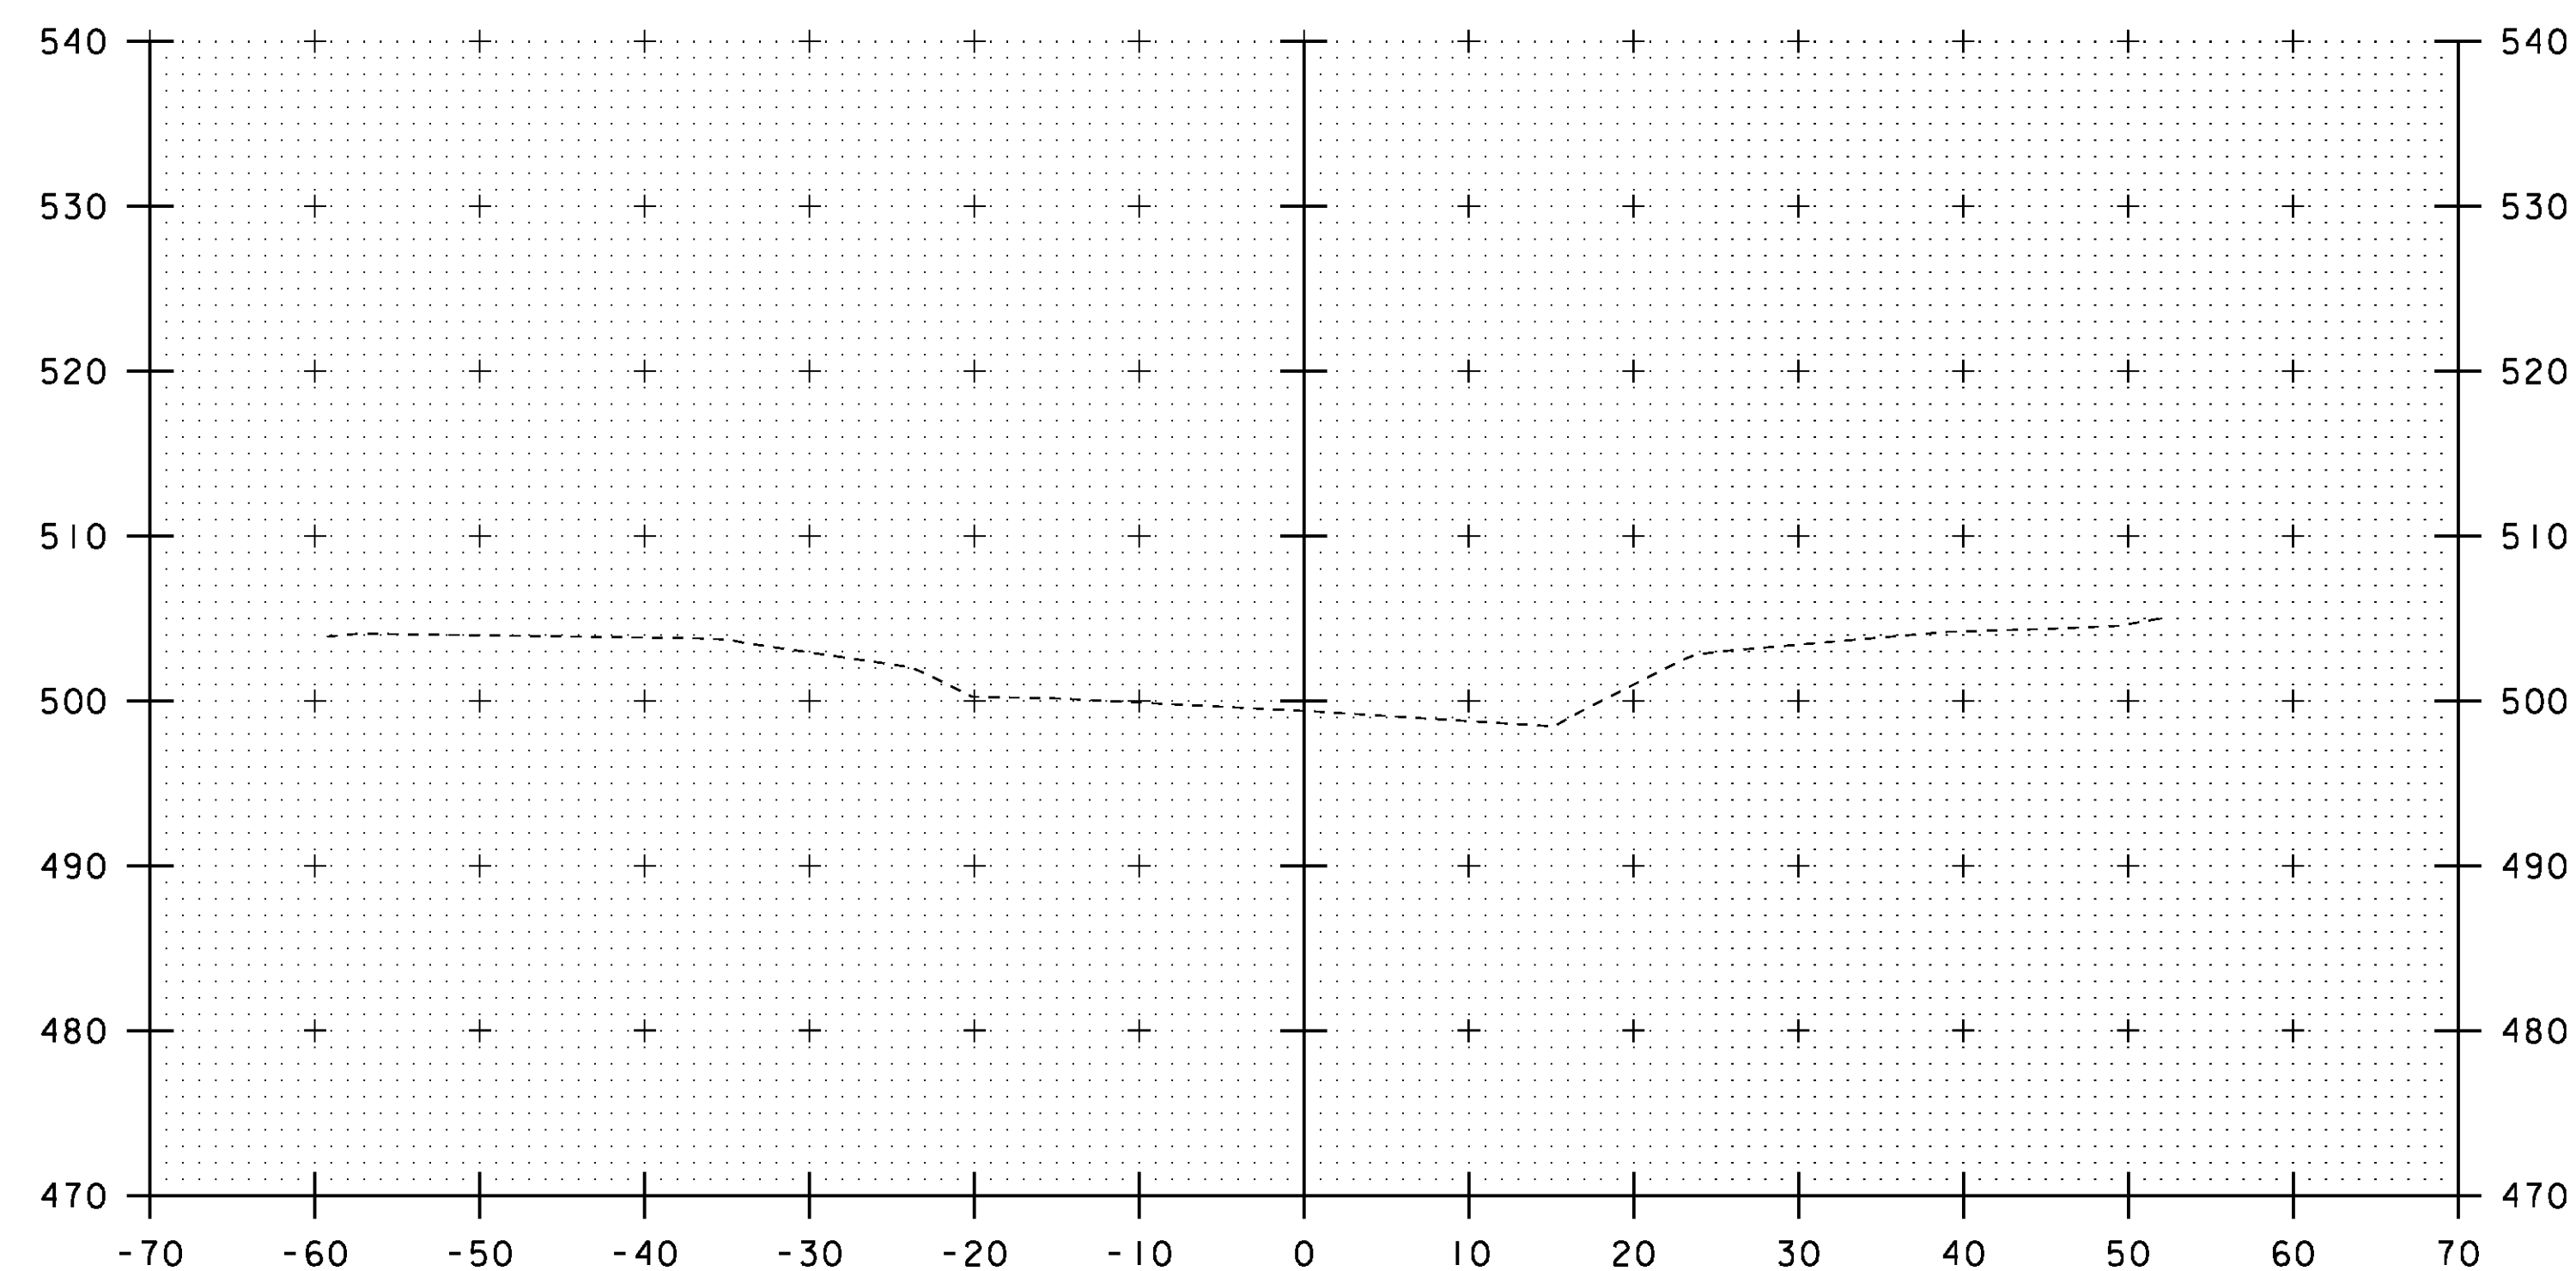

96+25

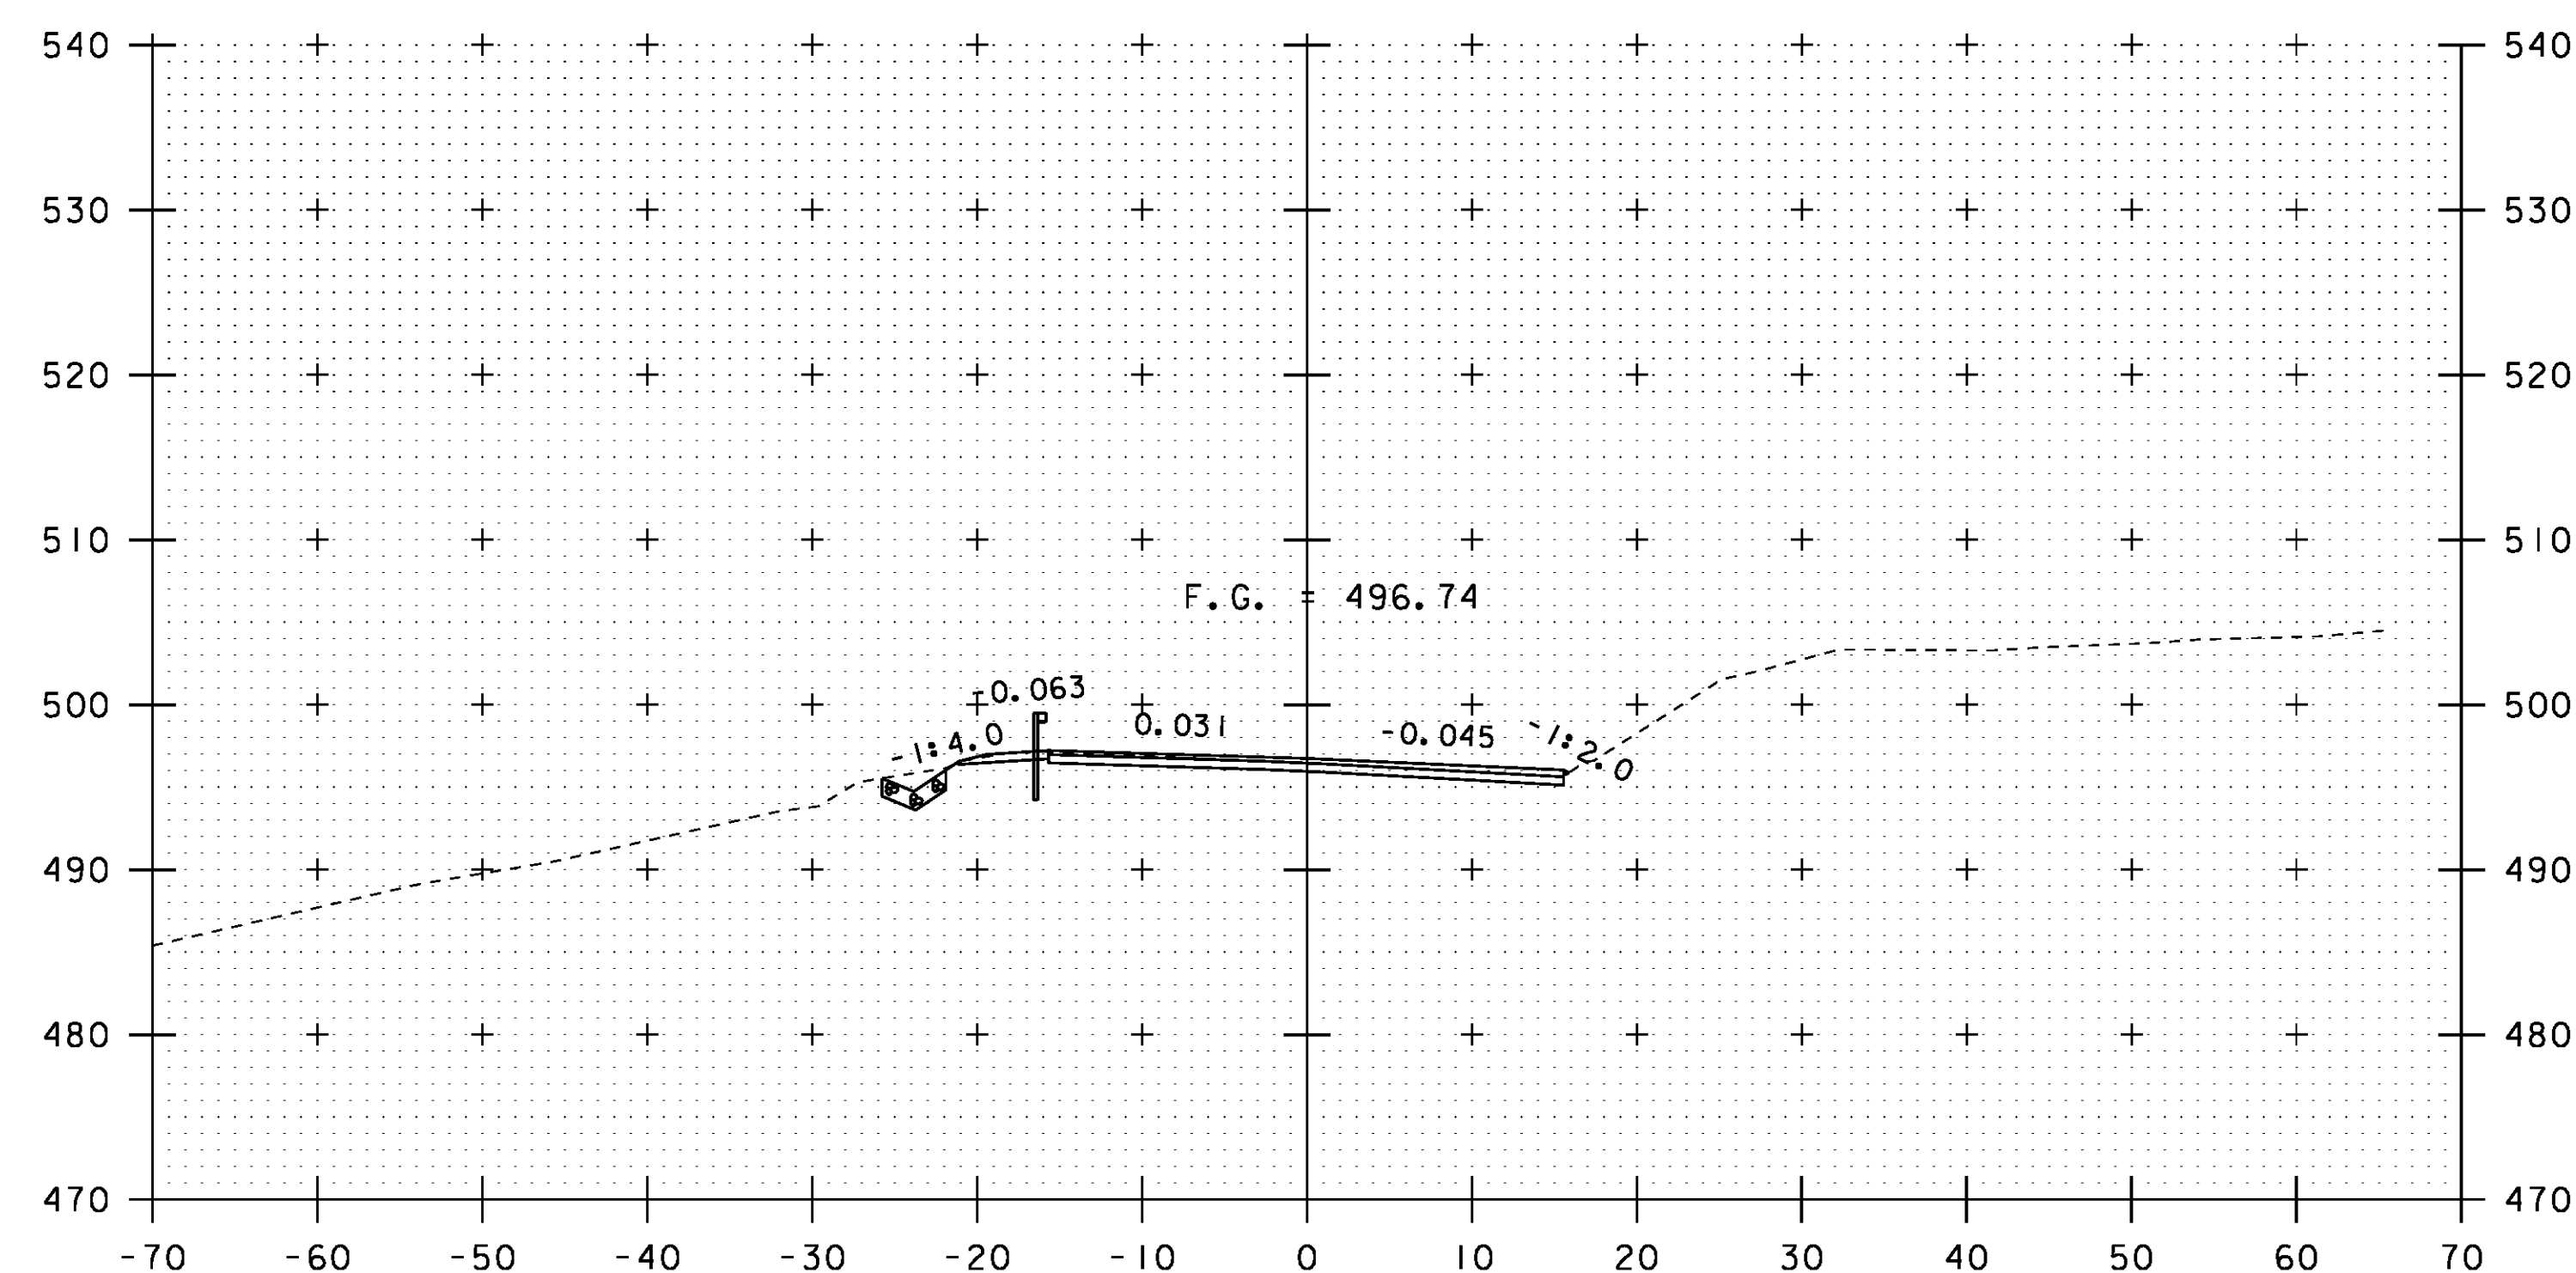

95+50

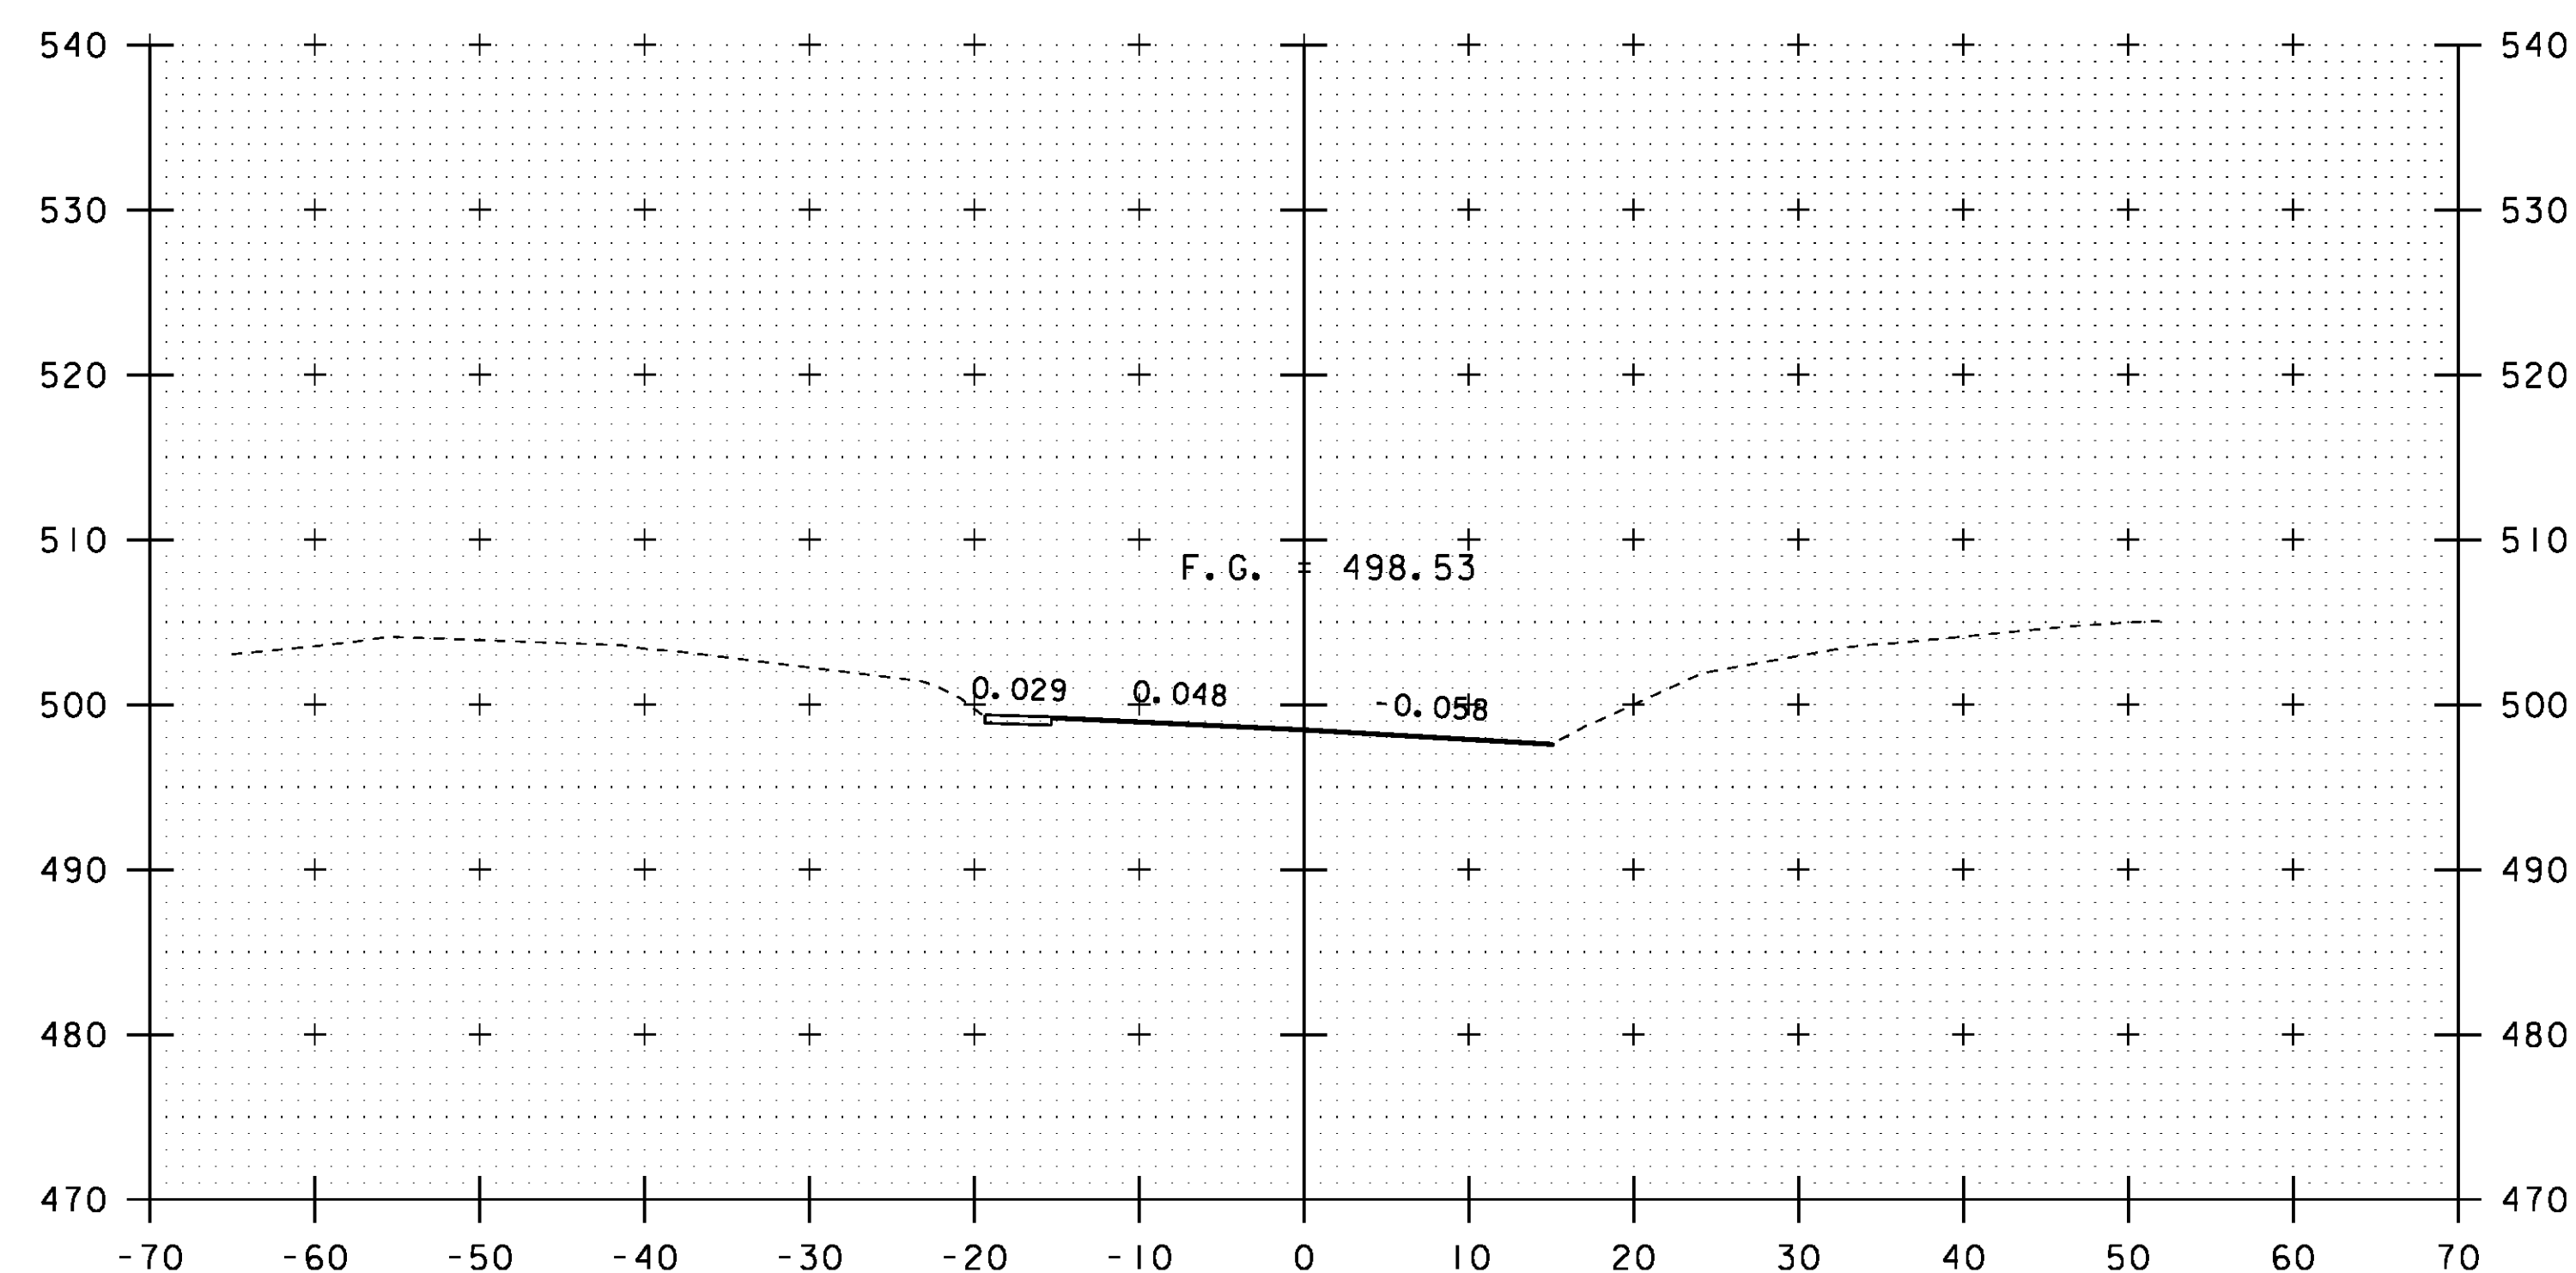

96+00

STA 95+50.0 LT - STA 96+00.0 LT
CONSTRUCT STONE-LINED DITCH, TYPE I

STA 96+00.00
END APPROACH
MATCH EXISTING

SCALE: 1" = 10'-0"

STA. 95+50 TO STA. 96+25

PROJECT NAME: JOHNSON
PROJECT NUMBER: BRF 030-2(26)

FILE NAME: s88bi93xsl.dgn
PROJECT LEADER: C. CARLSON
DESIGNED BY: H. SALLS
VT 15 CROSS SECTIONS (8)

PLOT DATE: 10-JUN-2014
DRAWN BY: G. ROY
CHECKED BY: H. SALLS
SHEET 49 OF 69