


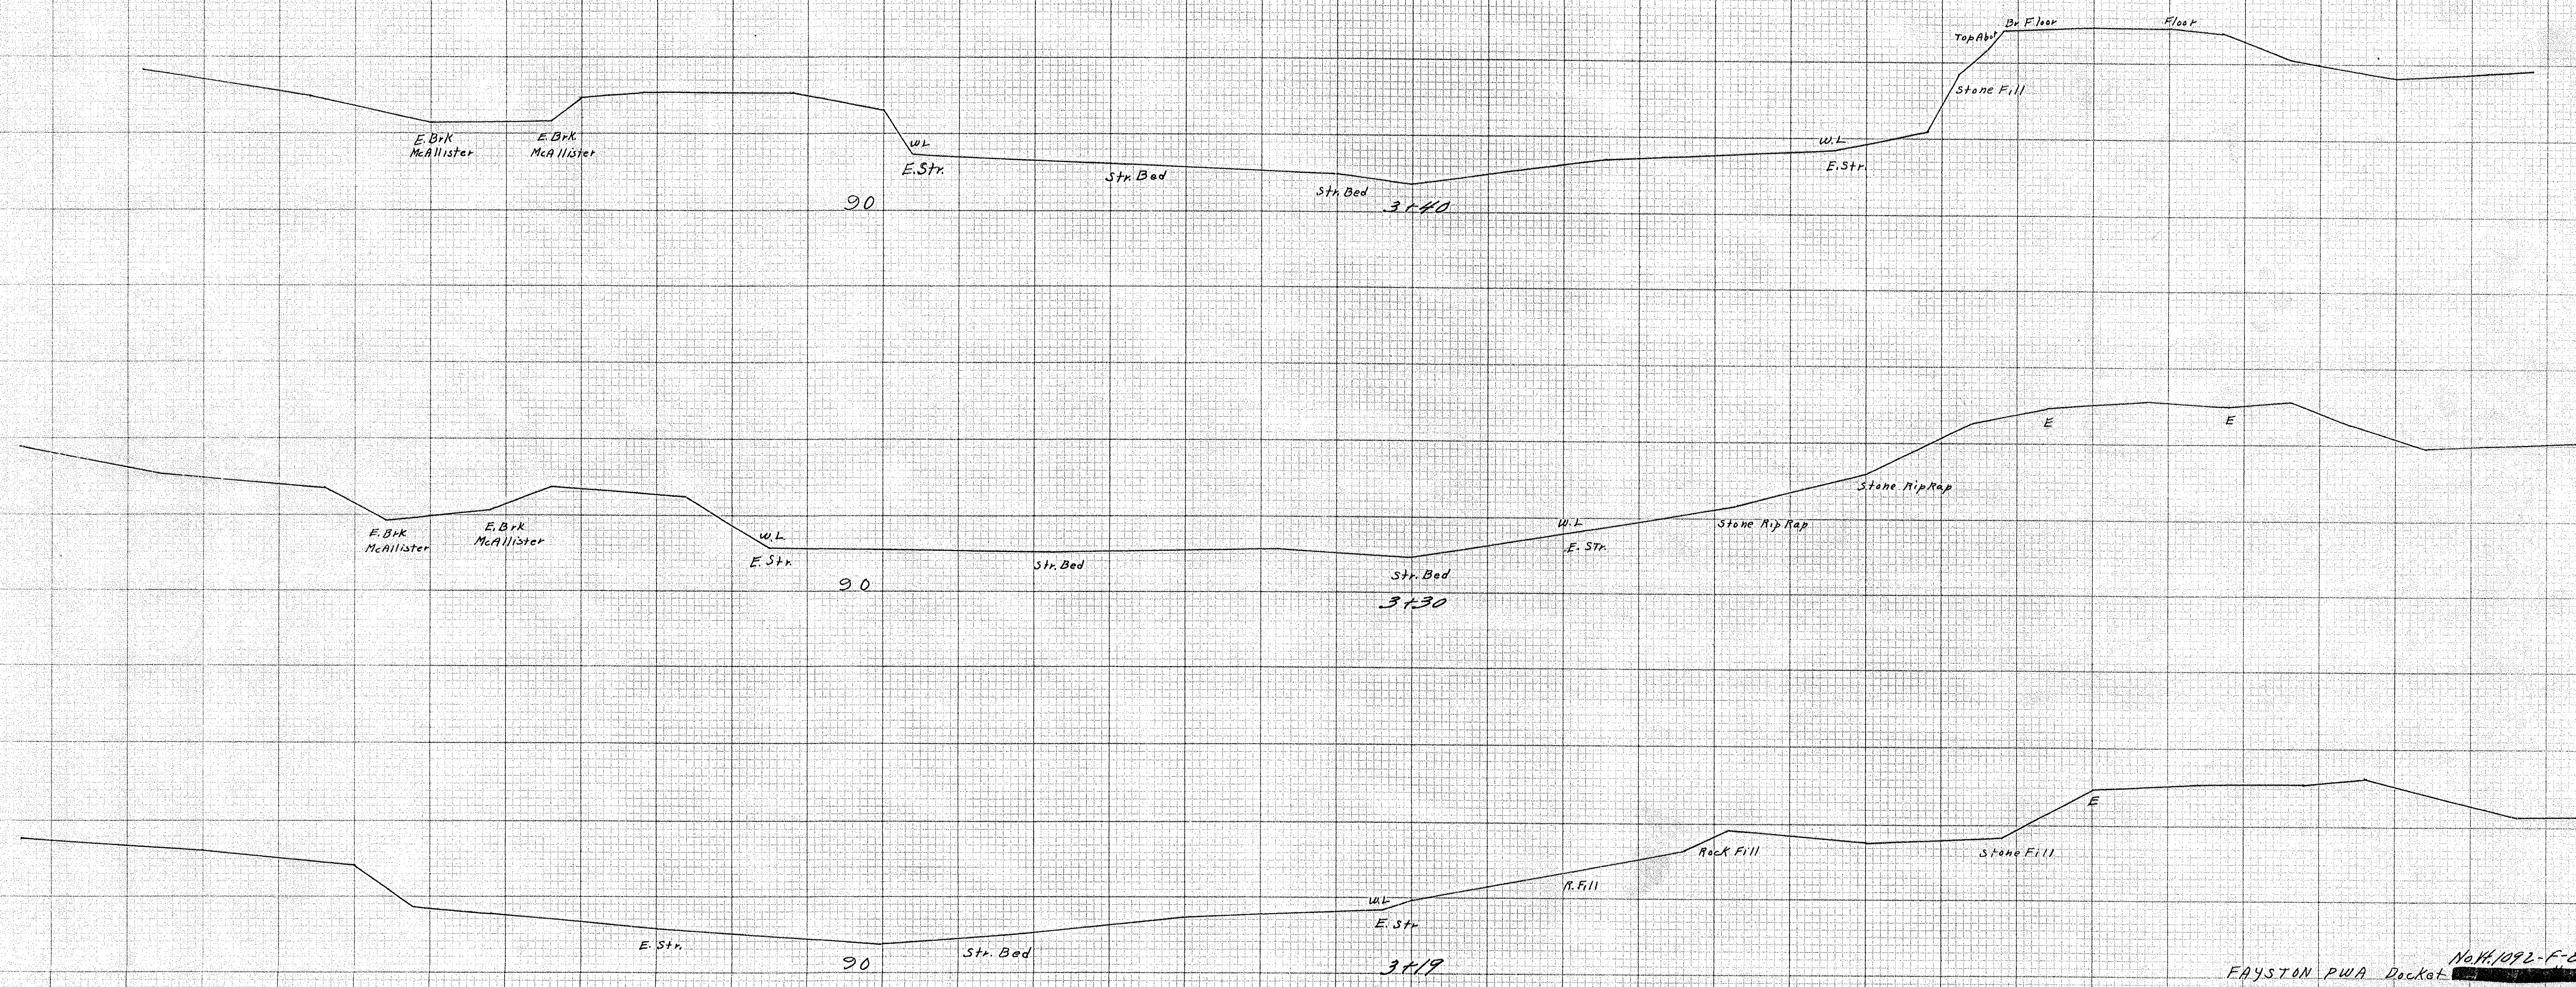

EAYSTON PWA Docket No. 1072-F-89
 LEVELS BY Colby
 SECTIONING BY Peck
 PLAN REVIEWED BY MRP
 EXAMINED BY
 SERIES F NO. FILED
 SHEET 13 OF 17

KEUFFEL & ESSER CO. NEW YORK

1/16" STANDARD MARK
 1/16" D. & 1/16" OFF
 CROSS SECTION 10 X 10
 1/16" D. & 1/16" OFF
 MADE IN U.S.A.

KEUFFEL & ESSER CO. NEW YORK

1/16" STANDARD MARK
 1/16" D. & 1/16" OFF
 CROSS SECTION 10 X 10
 1/16" D. & 1/16" OFF
 MADE IN U.S.A.