




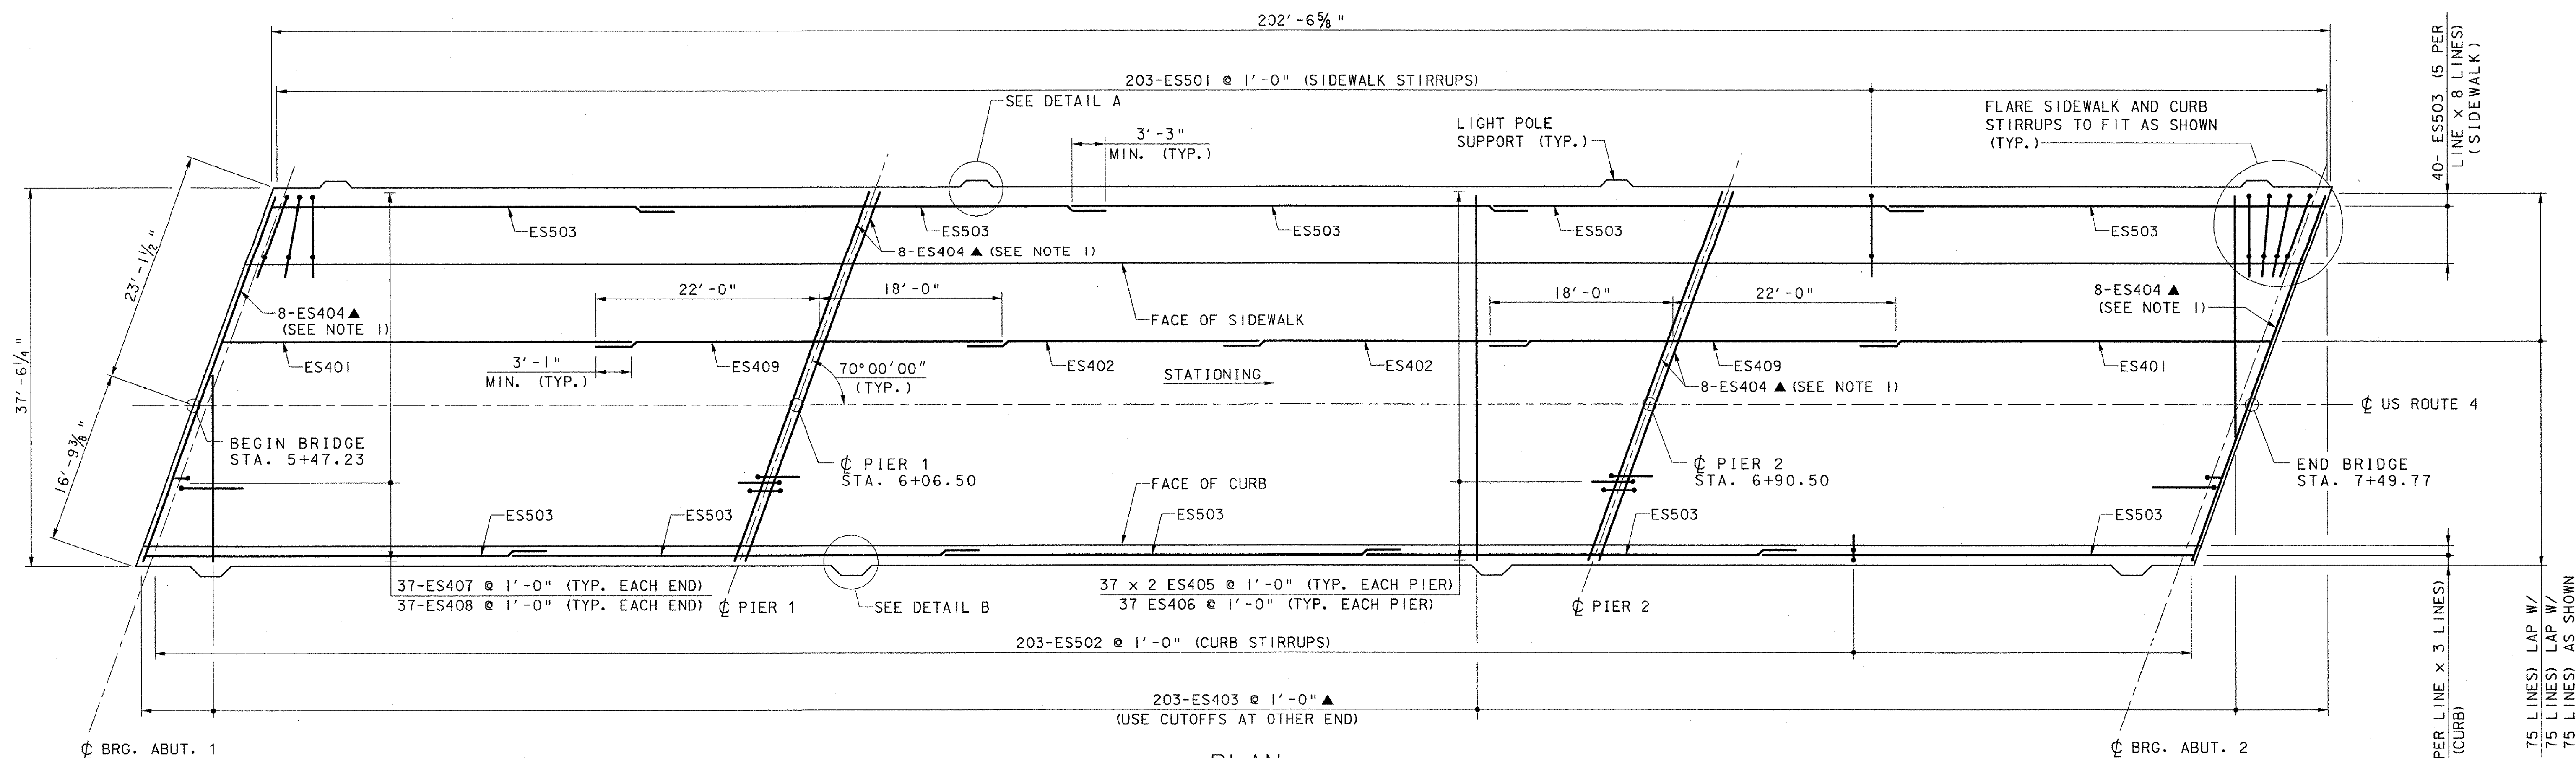

PLAN
SCALE 1/8" = 1'-0"

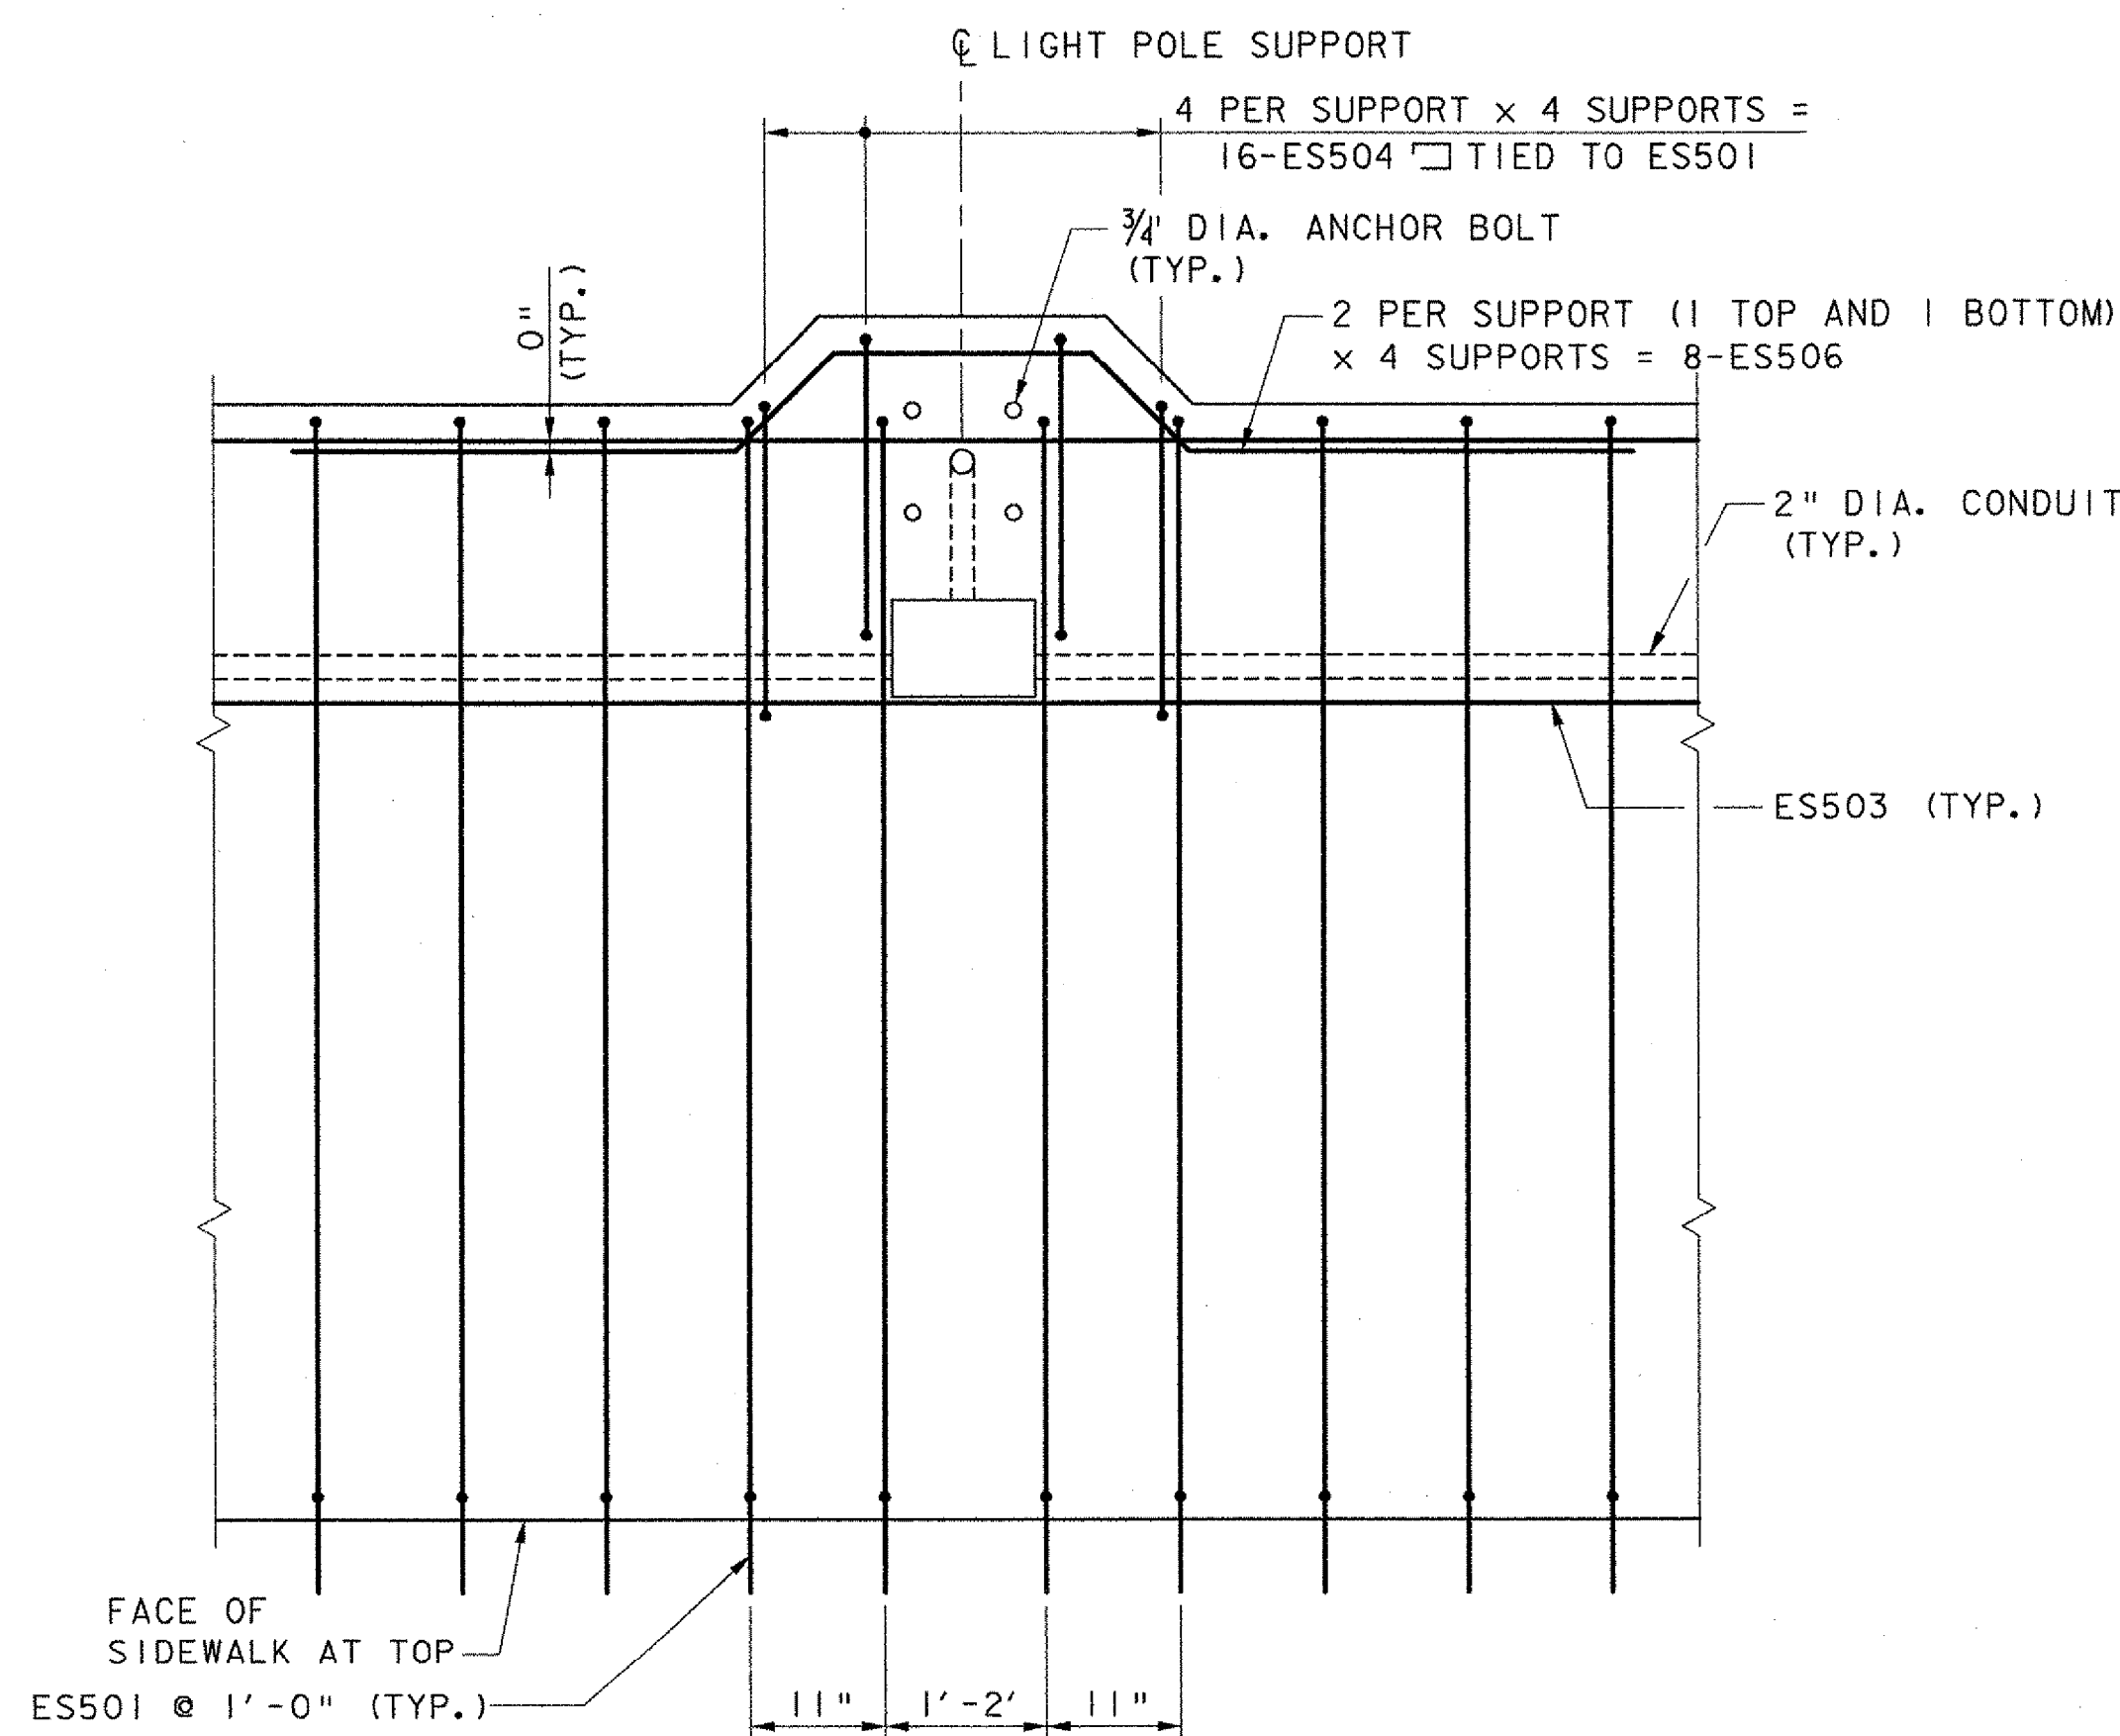

DETAIL A
SCALE 3/4" = 1'-0"

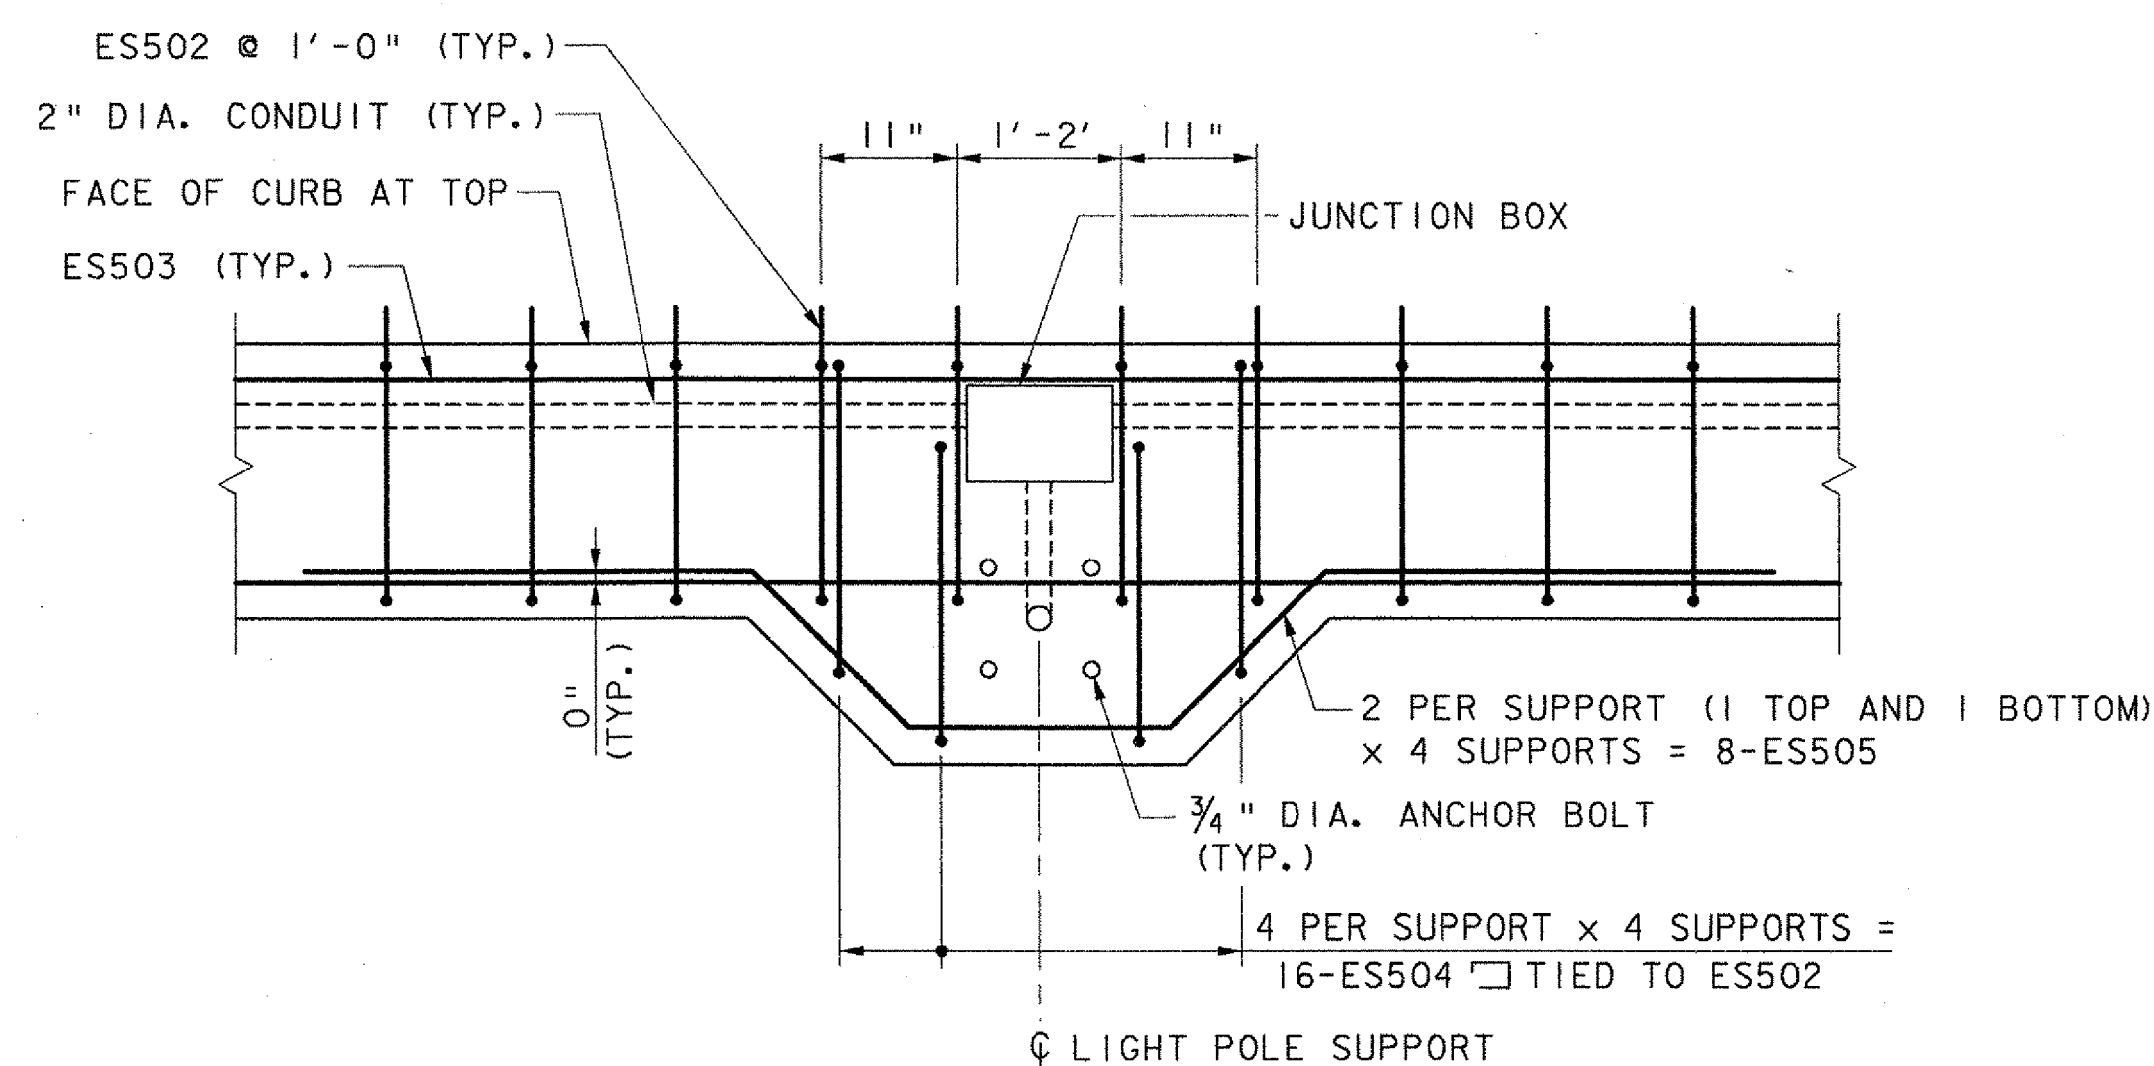

DETAIL B
SCALE 3/4" = 1'-0"

REINFORCING KEY

▲ DENOTES BARS TO BE CUT IN FIELD

NOTES:

- SEE SHEET 28 FOR REINFORCING DETAILS. CUT ES404 BARS TO FIT WITH UTILITY BLOCKOUT.
- SEE SHEET 26 FOR RAIL POST LAYOUT AND LIGHT POLE SUPPORT DETAILS.
- OVERLAY SHALL BE PLACED CONTINUOUSLY FROM ABUTMENT 1 END TO ABUTMENT 2 END.

STATE OF VERMONT
AGENCY OF TRANSPORTATION

Town Of	WOODSTOCK	Bridge No.	50
Highway No.	U.S. ROUTE 4	Log Sta.	
		Surv. Sta.	
U.S. ROUTE 4 OVER OTTAUQUECHEE RIVER			
OVERLAY REINFORCEMENT (1 OF 2)			
Designed By	K.G. KRETSCH	Drawn By	B.J. MASSE
Checked By	J.T. KLEIN	Bridge Design Supervisor	M.A. COLGAN
Date	10/06	Date	10/06
PROJECT	WOODSTOCK	PROJECT NO.	BHF 020-2 (32)
I.G.C. Info.		Bridge Sheet No.	ZJ028DK
		Sheet	27 of 71

VHB Vanasse Hangen Brustlin, Inc.