




PROJECT NAME:	BRATTLEBORO
PROJECT NUMBER:	BRO 2000 (17)

FILE NAME: 94J078\structures\sj078ris.l	PLOT DATE: 24-MAY-2004
PROJECT MANAGER: R. R. WHITCOMB	DRAWN BY: G. ROY
DESIGNED BY: G. ROY	CHECKED BY: T. SUMNER
	SHEET 47 OF 71

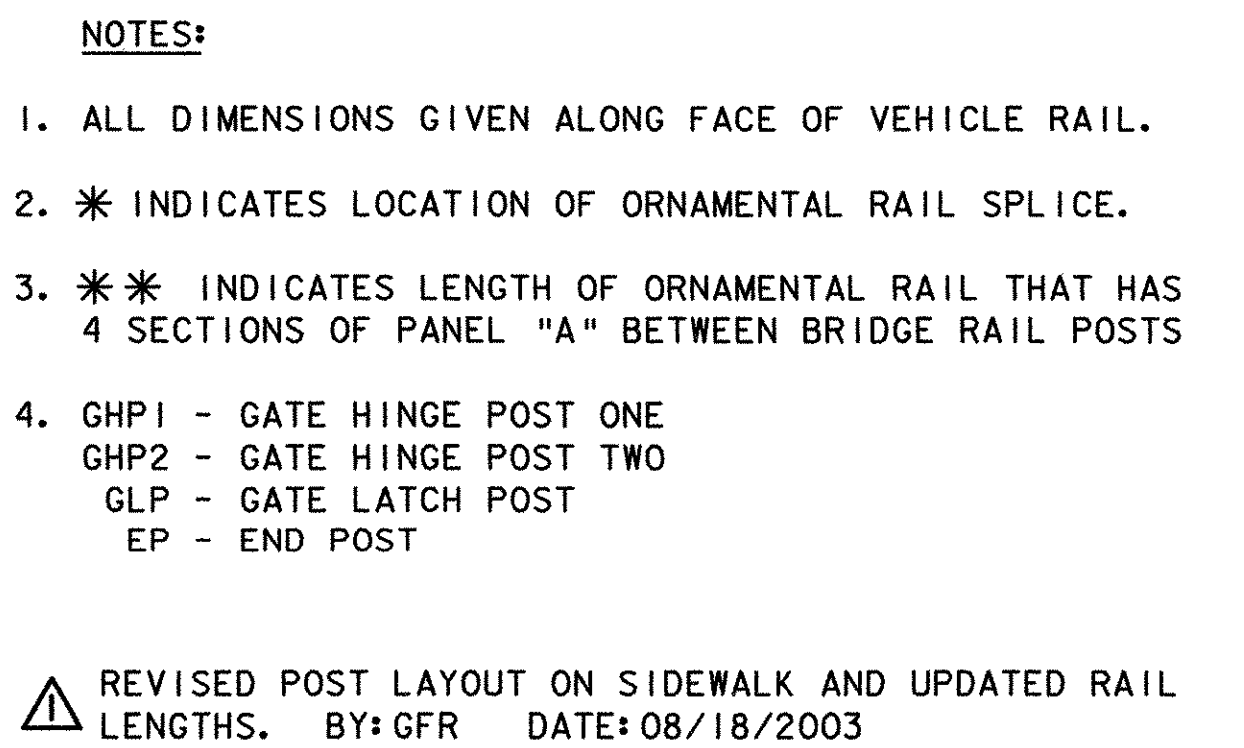