

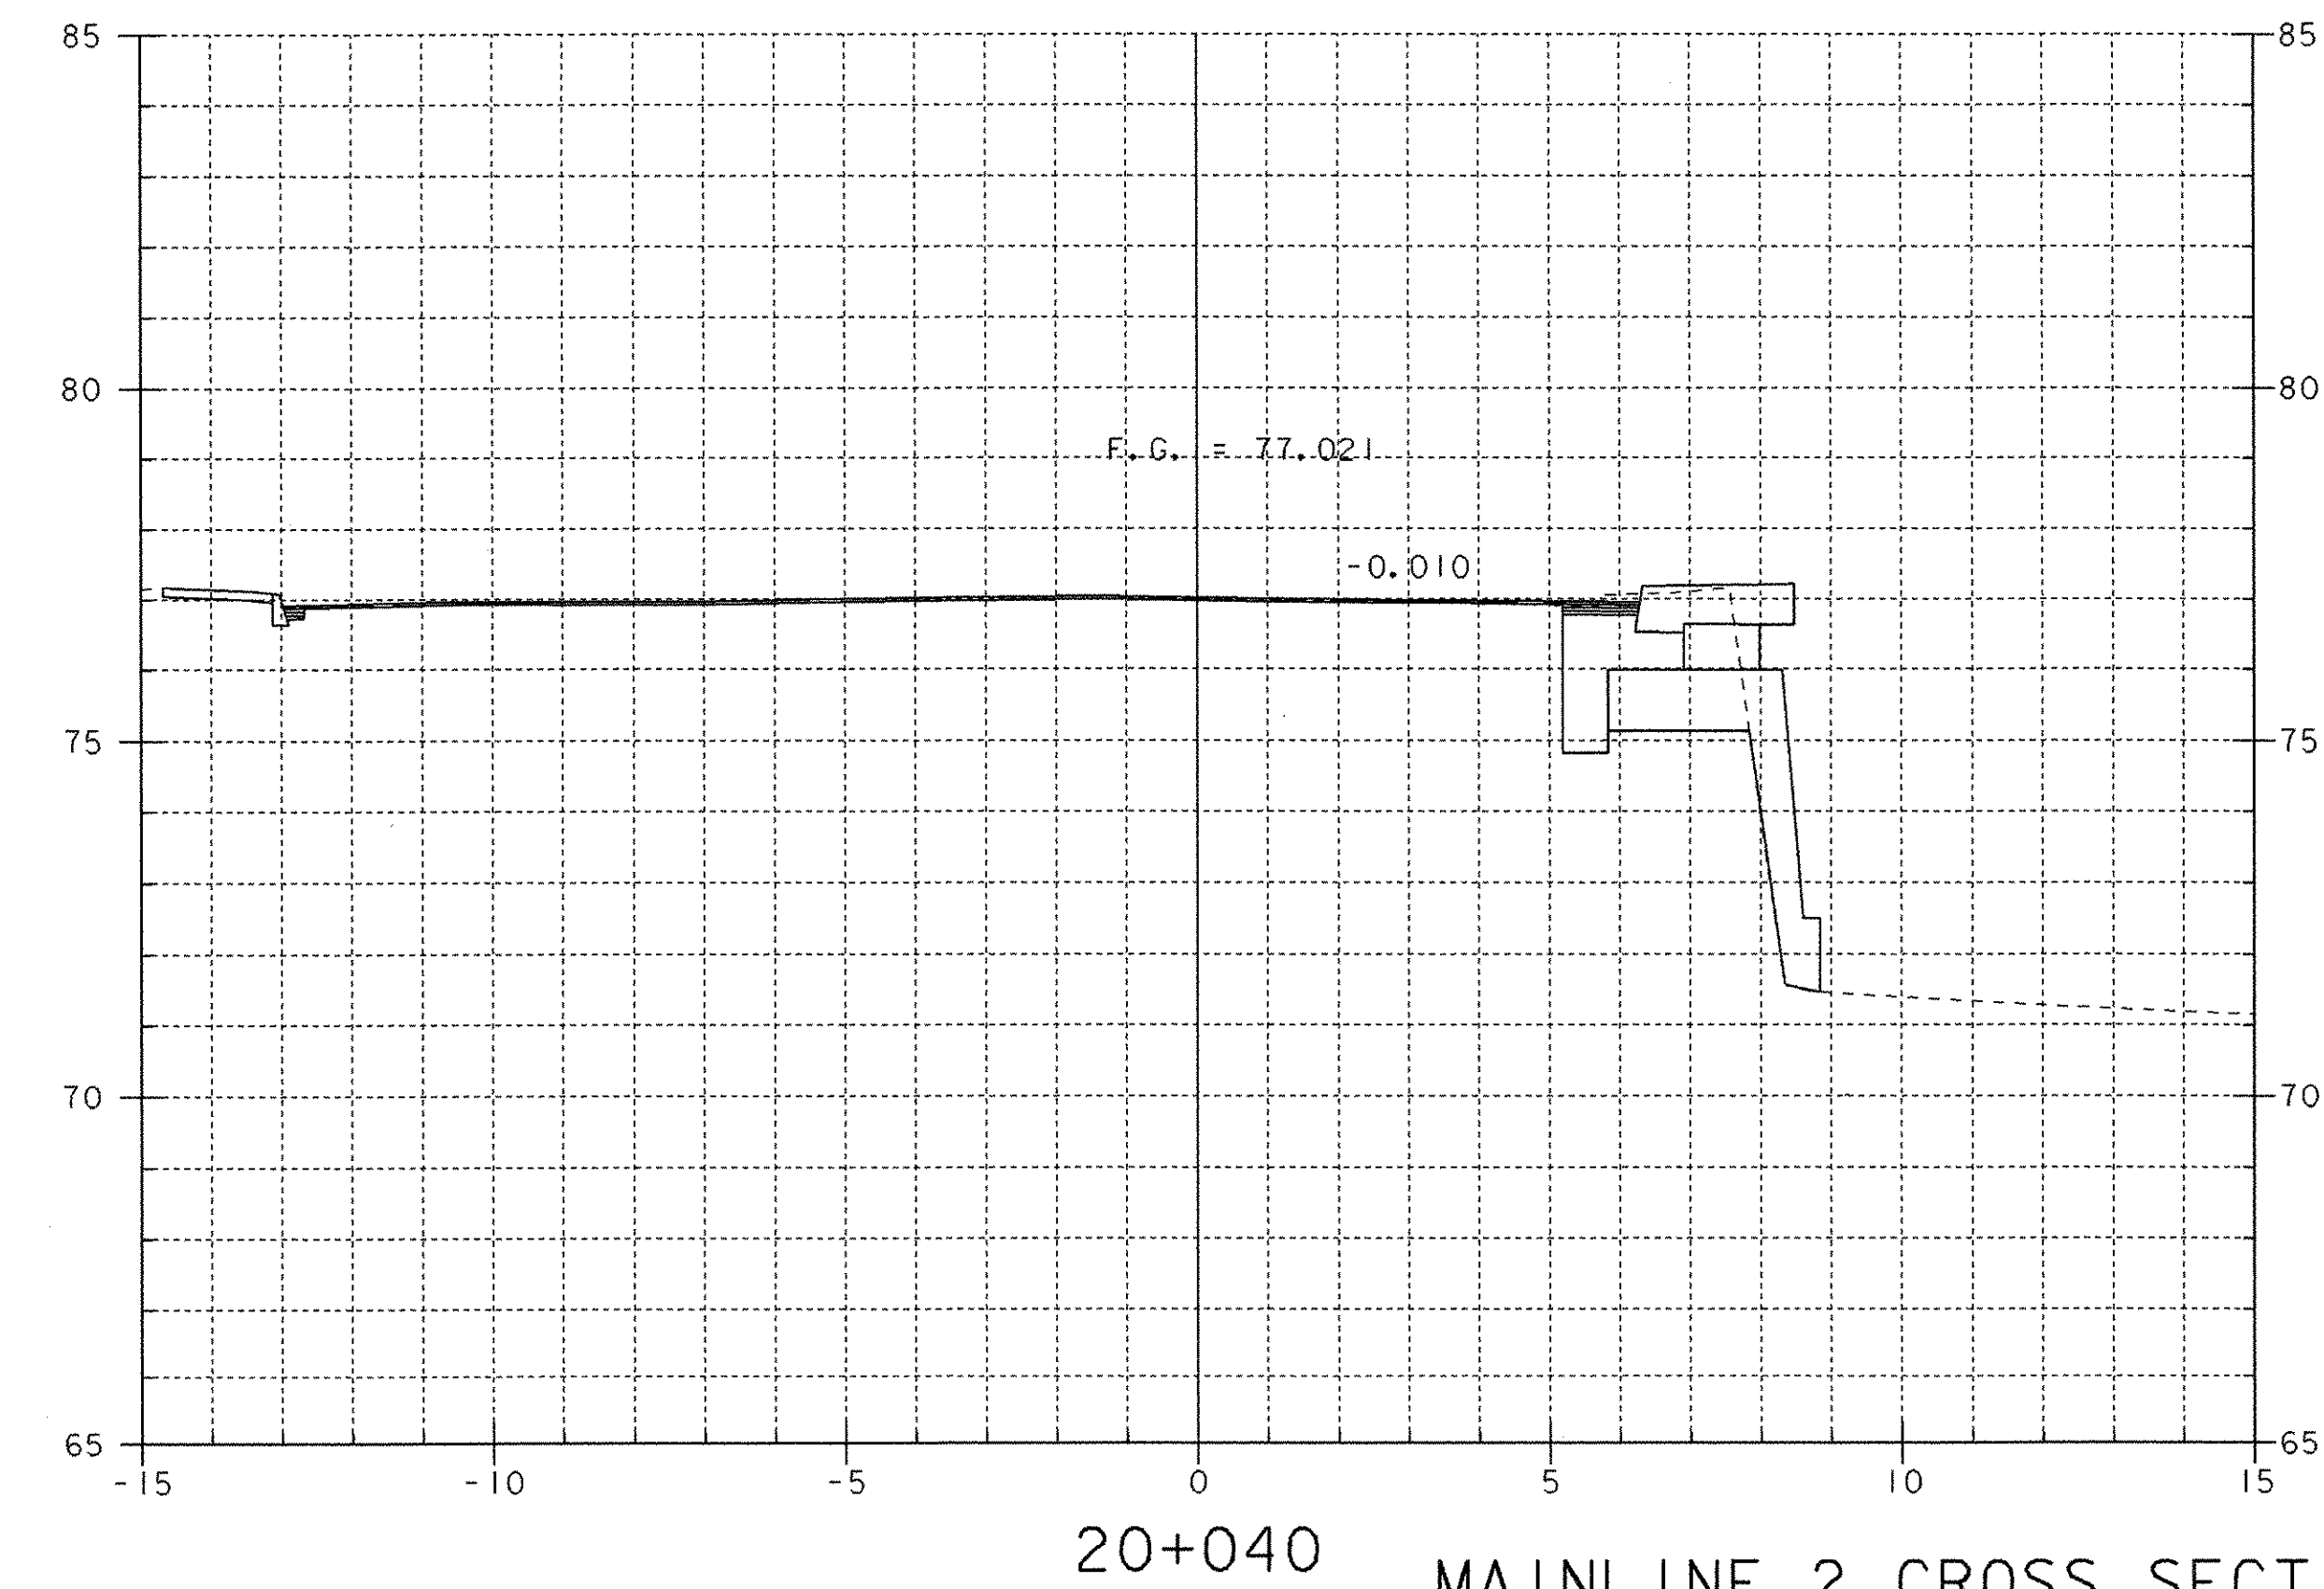
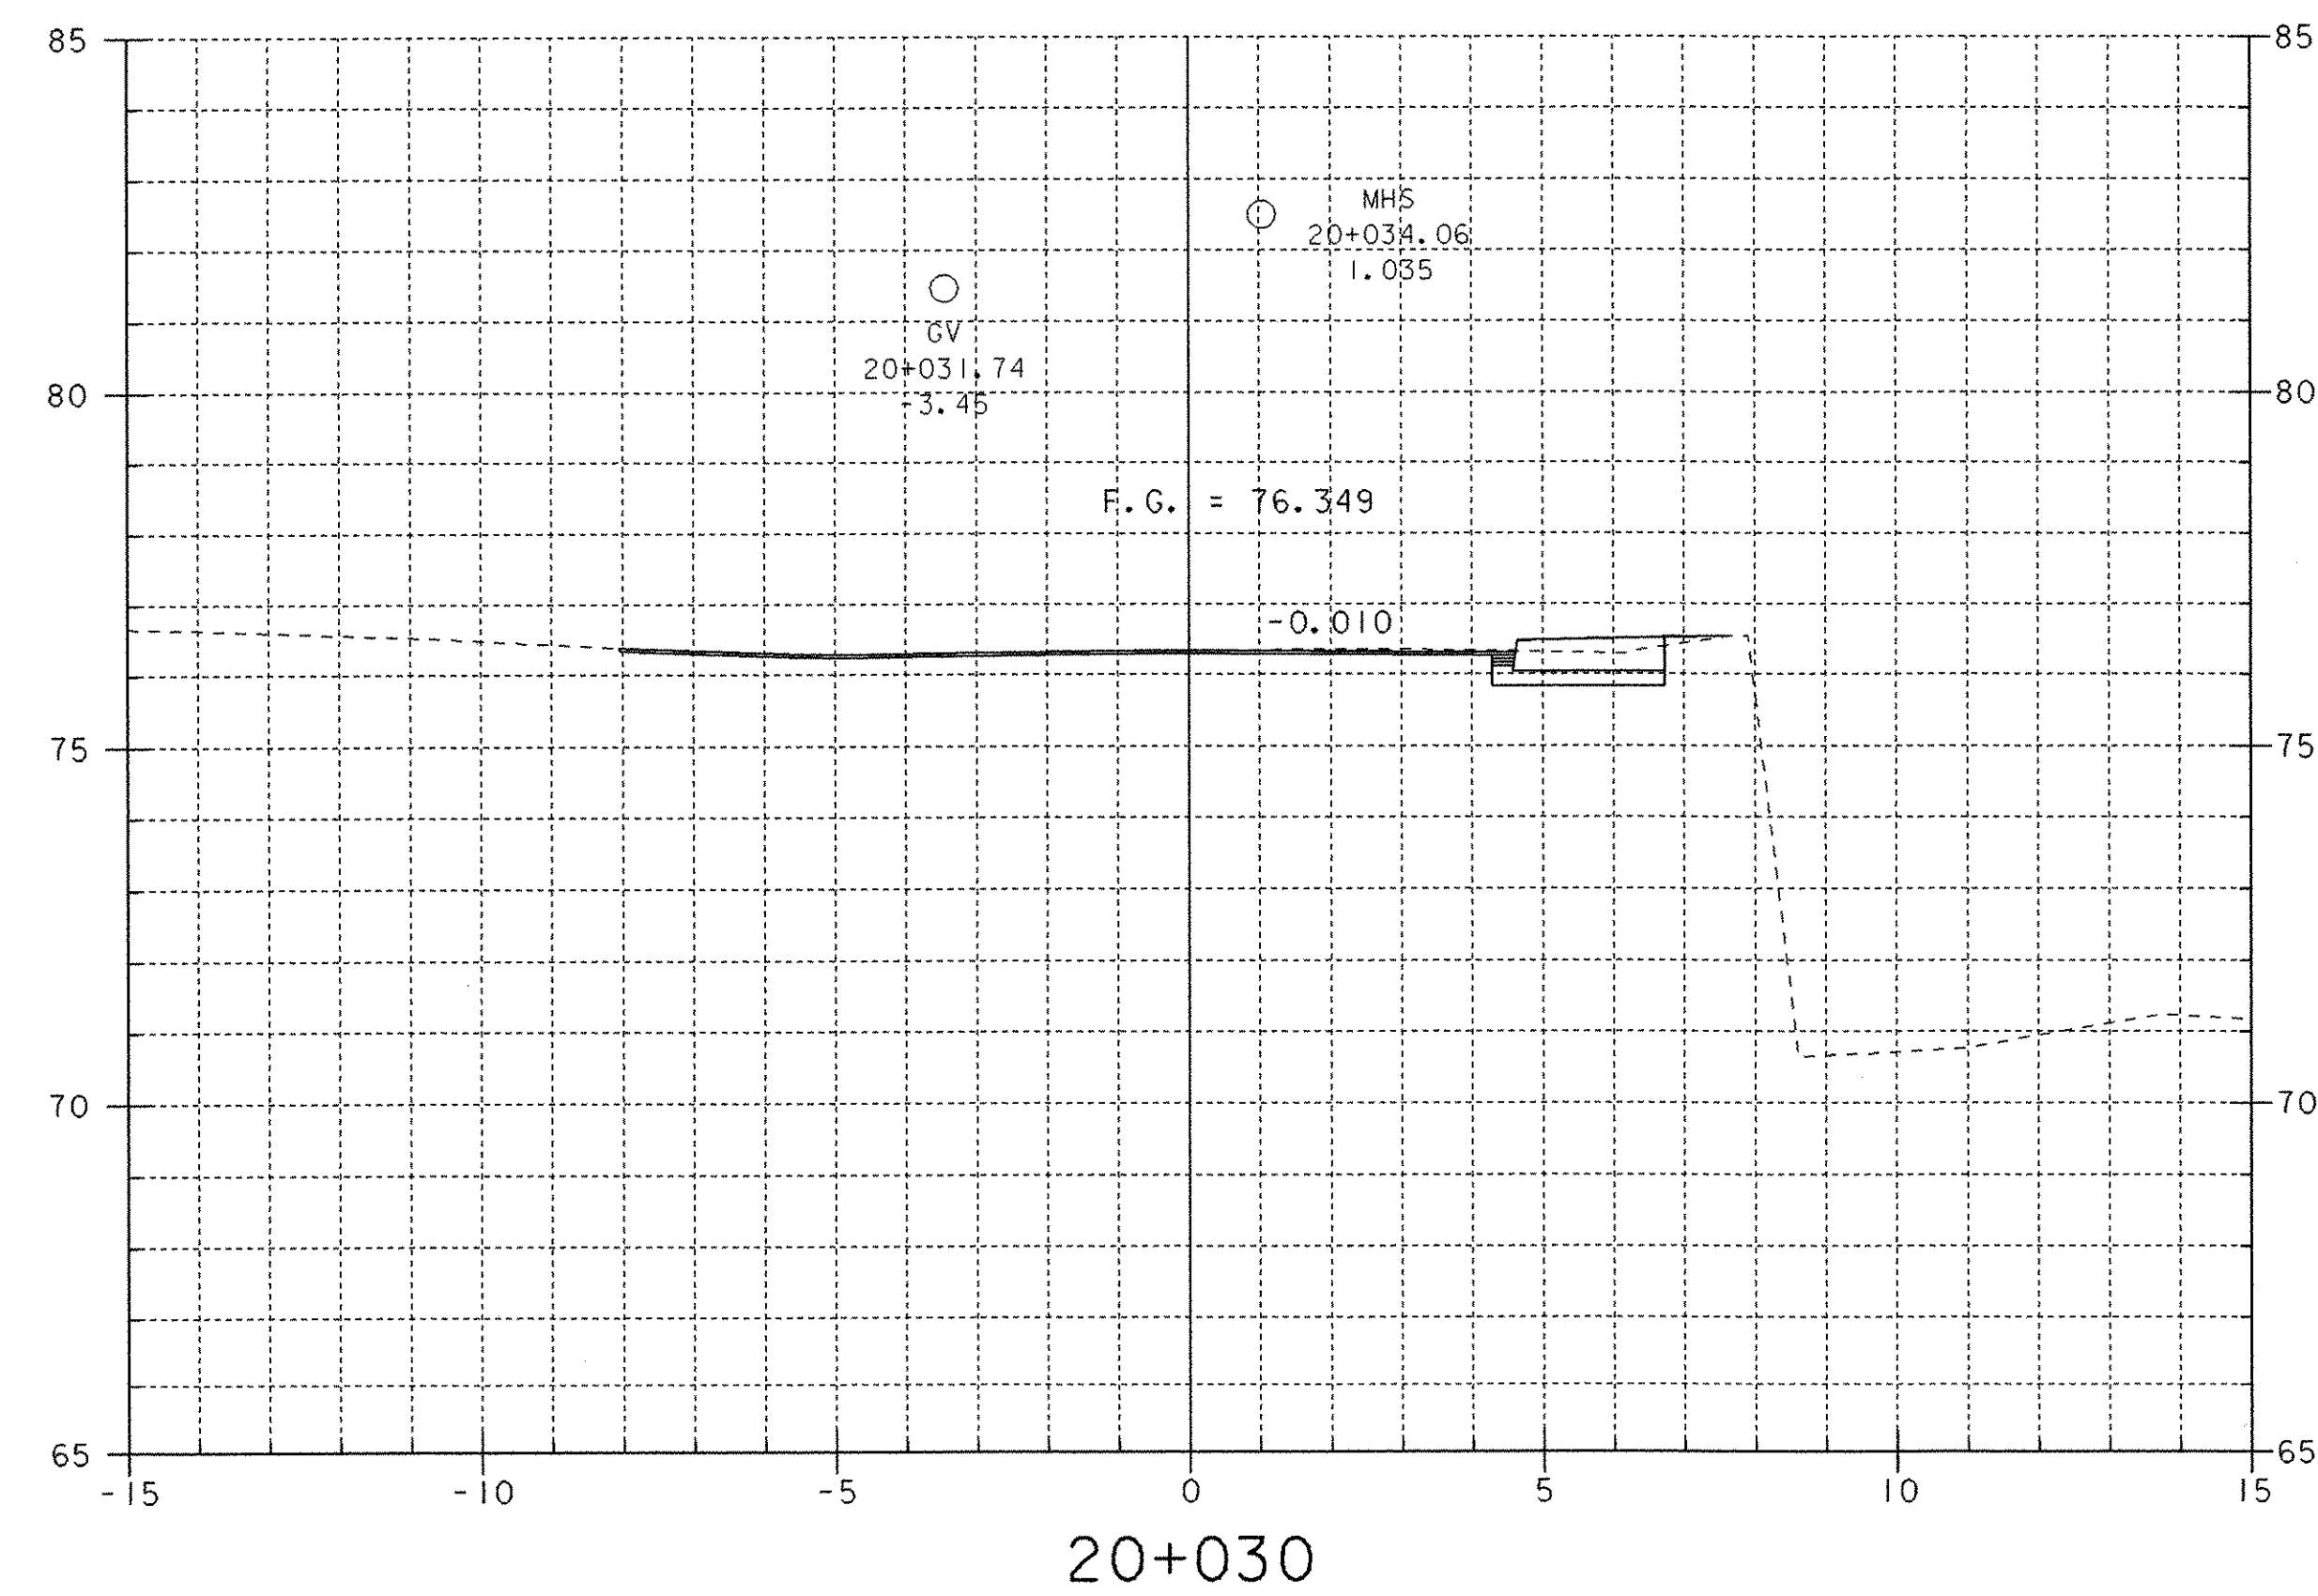
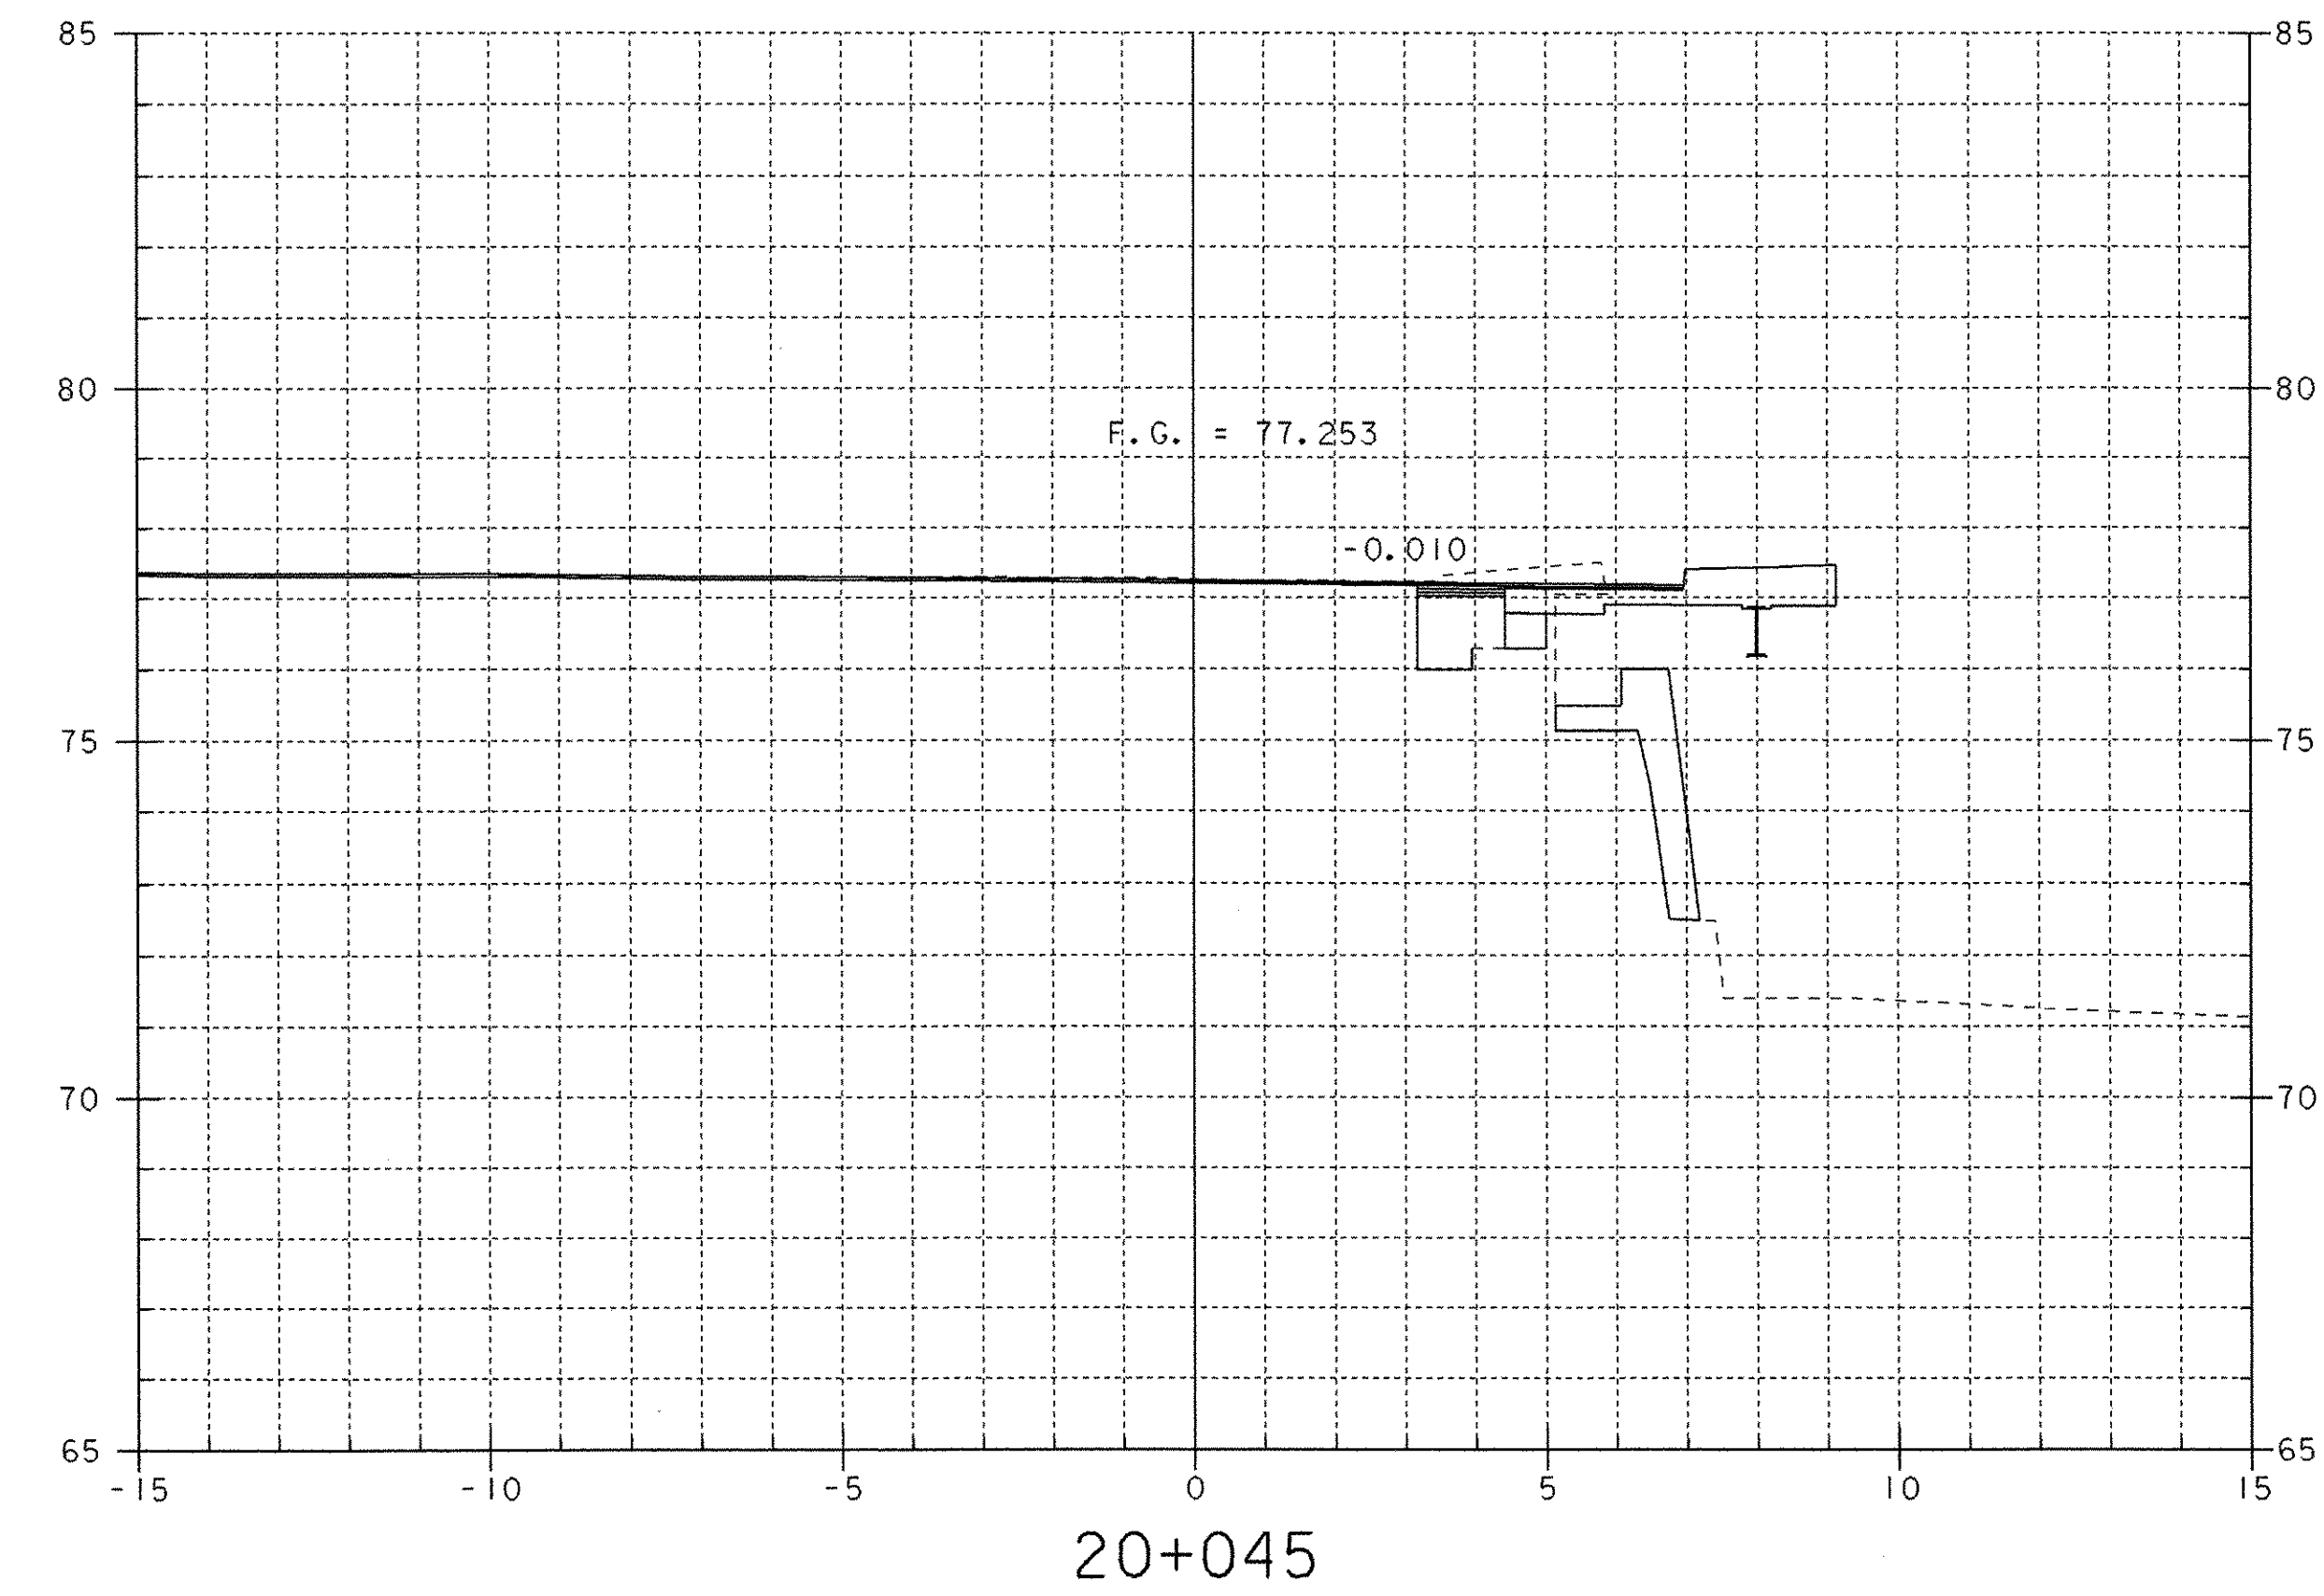


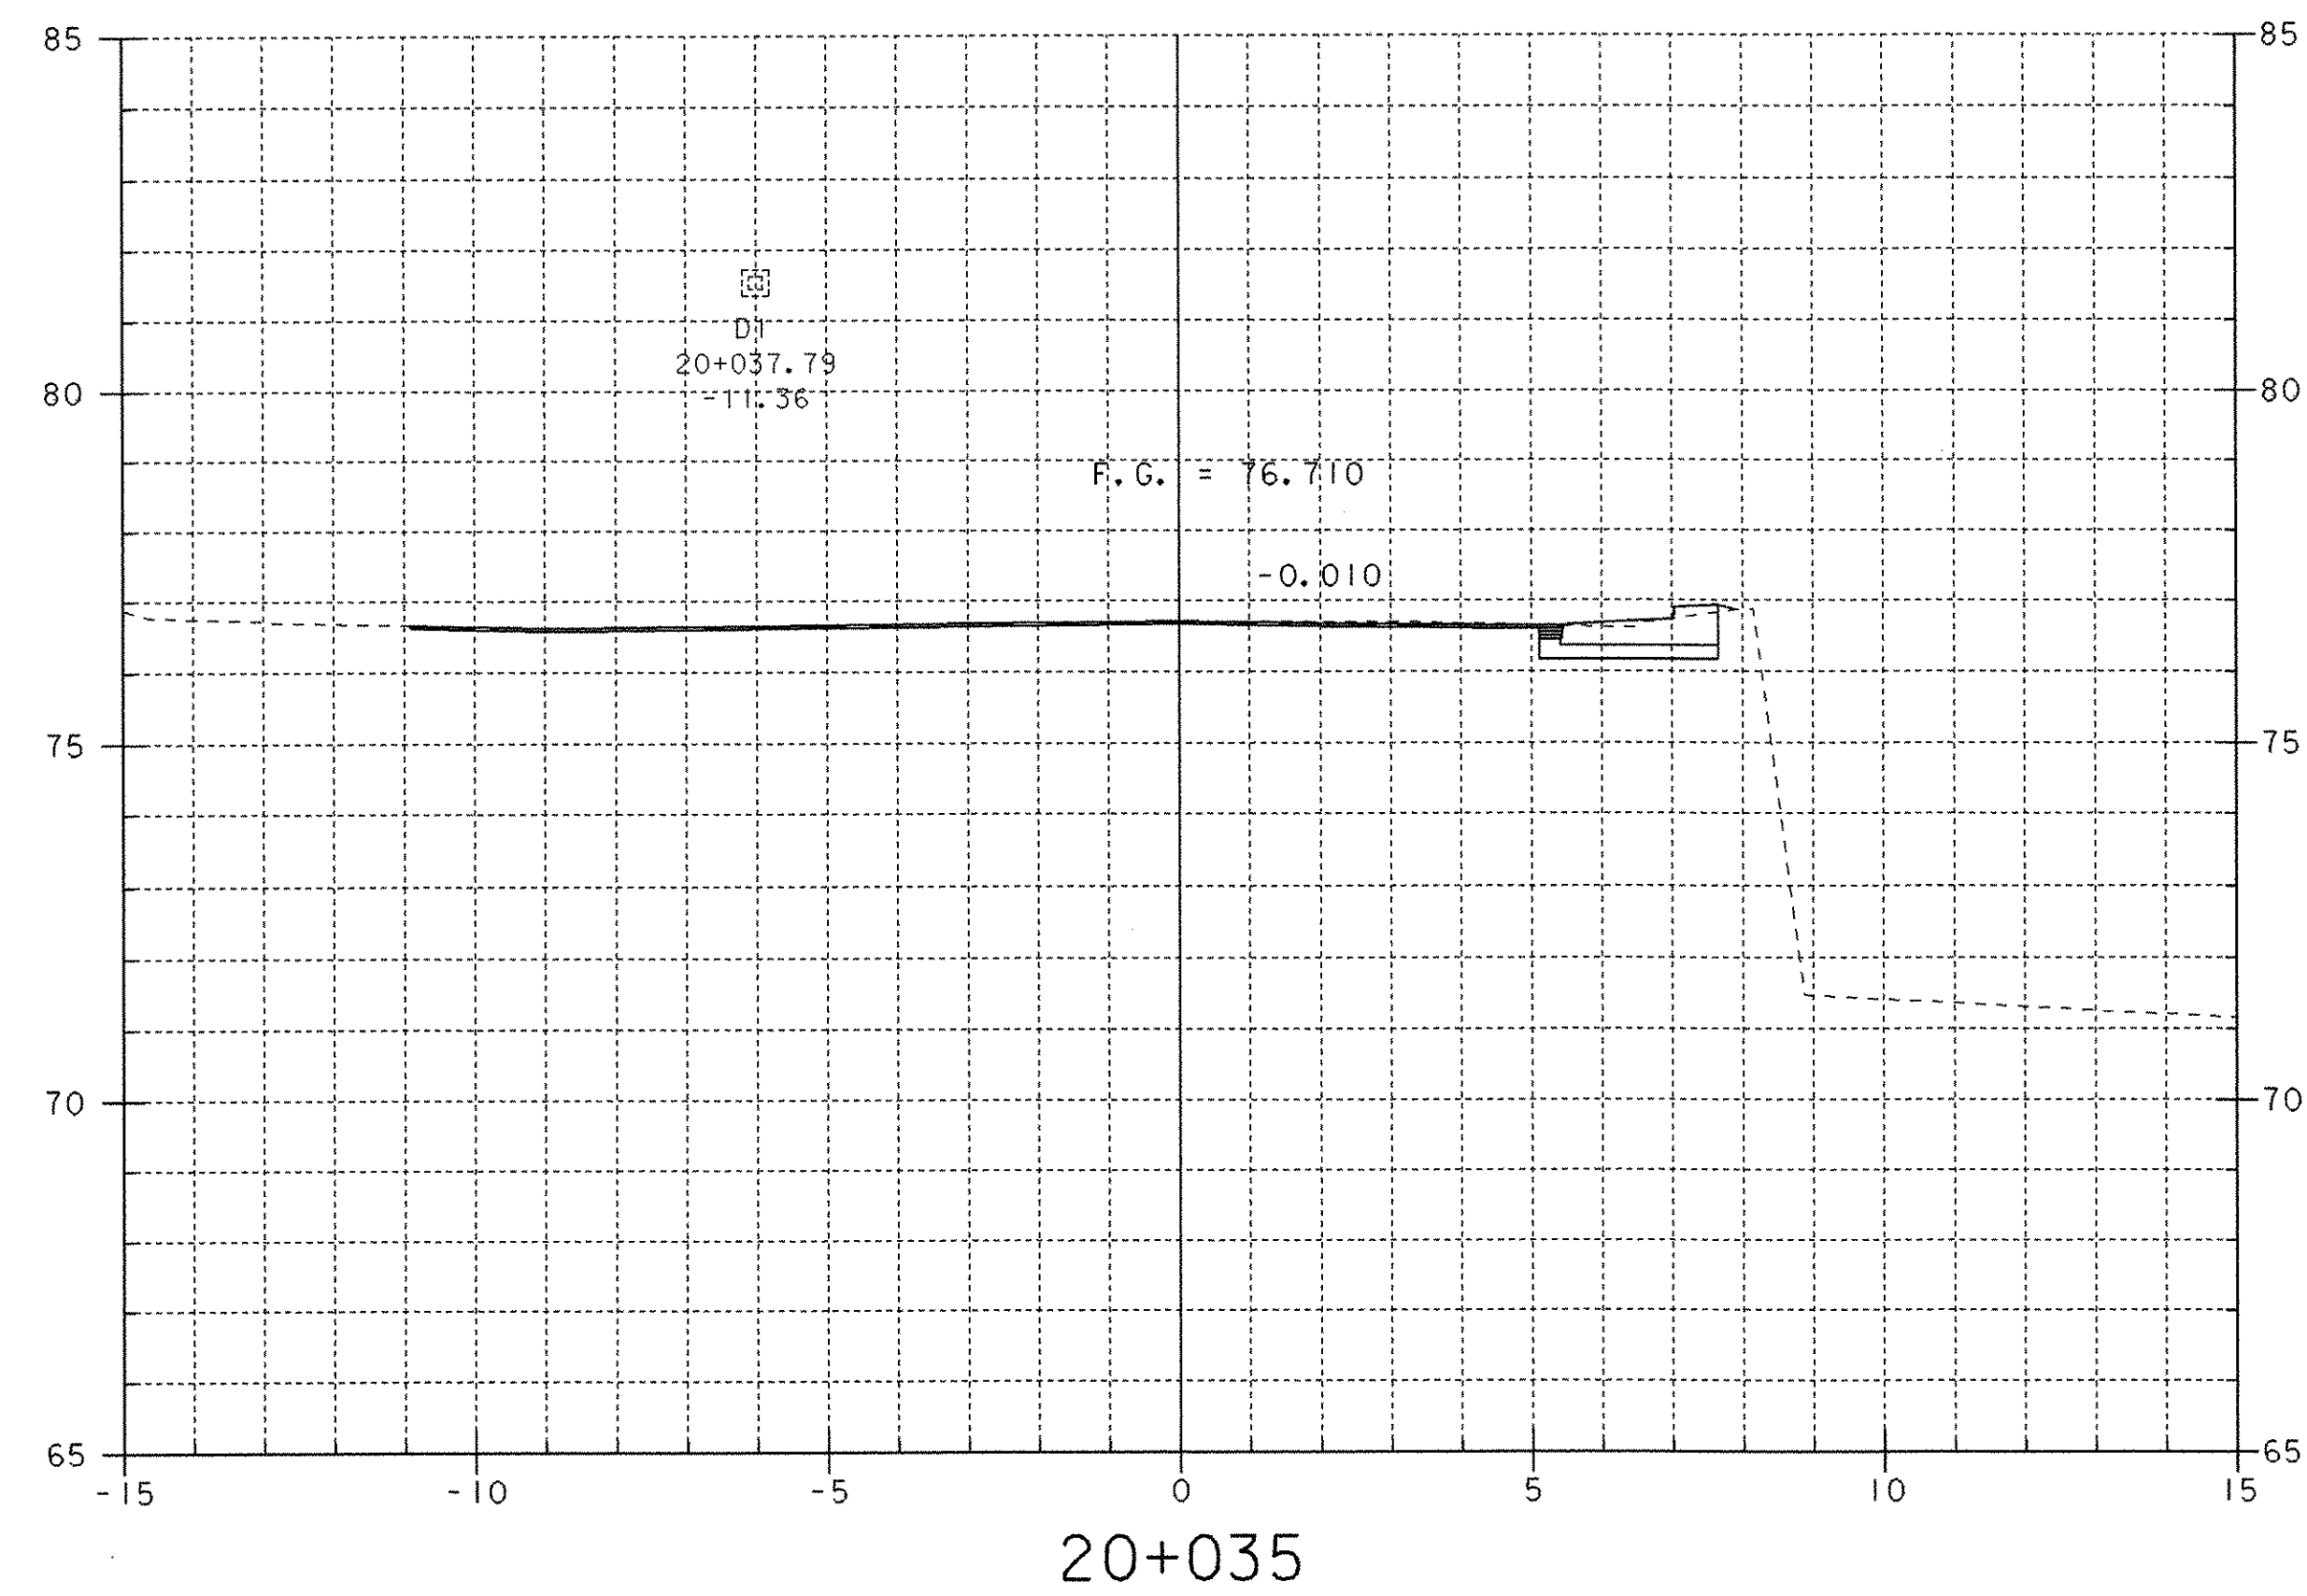

MAINLINE 2 CROSS SECTIONS (2)

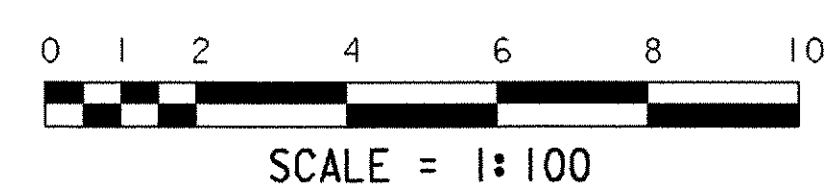

PROJECT NAME:	BRATTLEBORO	FILE NAME:	94j078\Structures\sj078m06.i	PLOT DATE:	06-FEB-2003
PROJECT NUMBER:	BHF 2000 (17)	PROJECT MANAGER:	R.R. WHITCOMB	DRAWN BY:	G. ROY
		DESIGNED BY:	G. ROY	CHECKED BY:	T. SUMNER
				SHEET	66 OF 71