

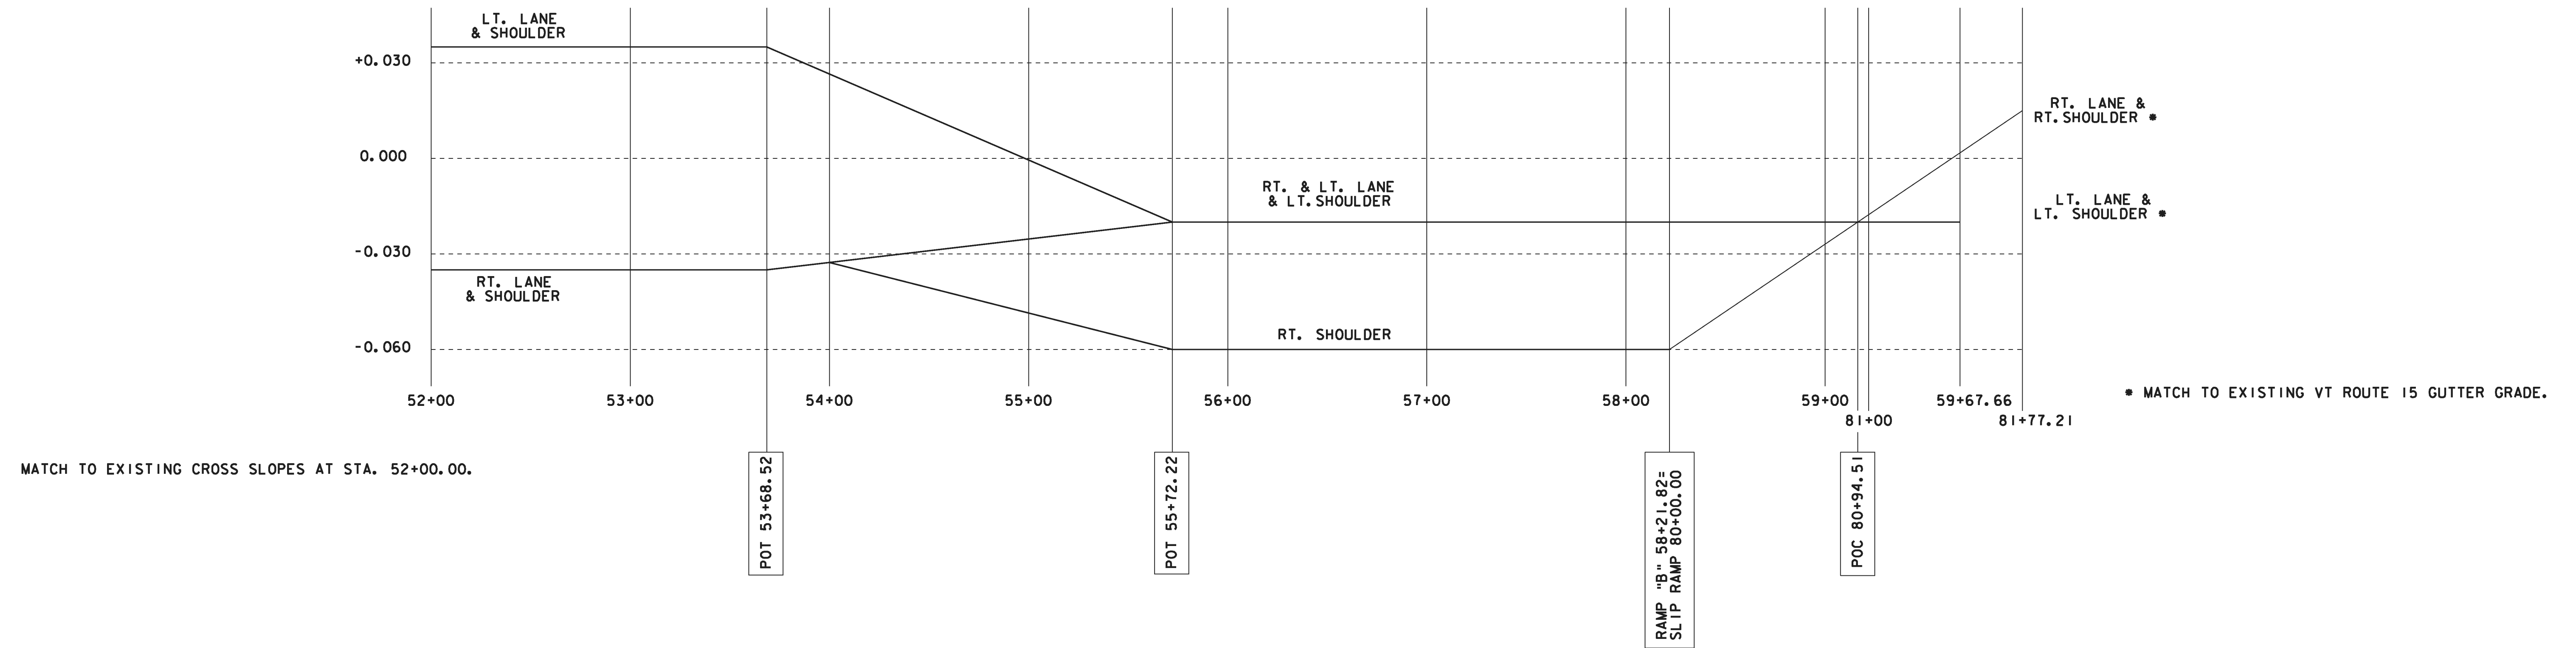
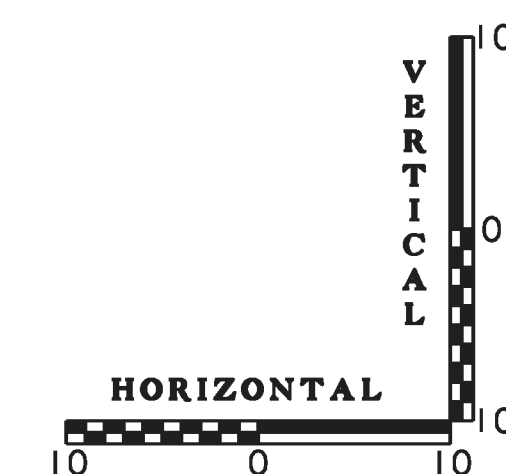


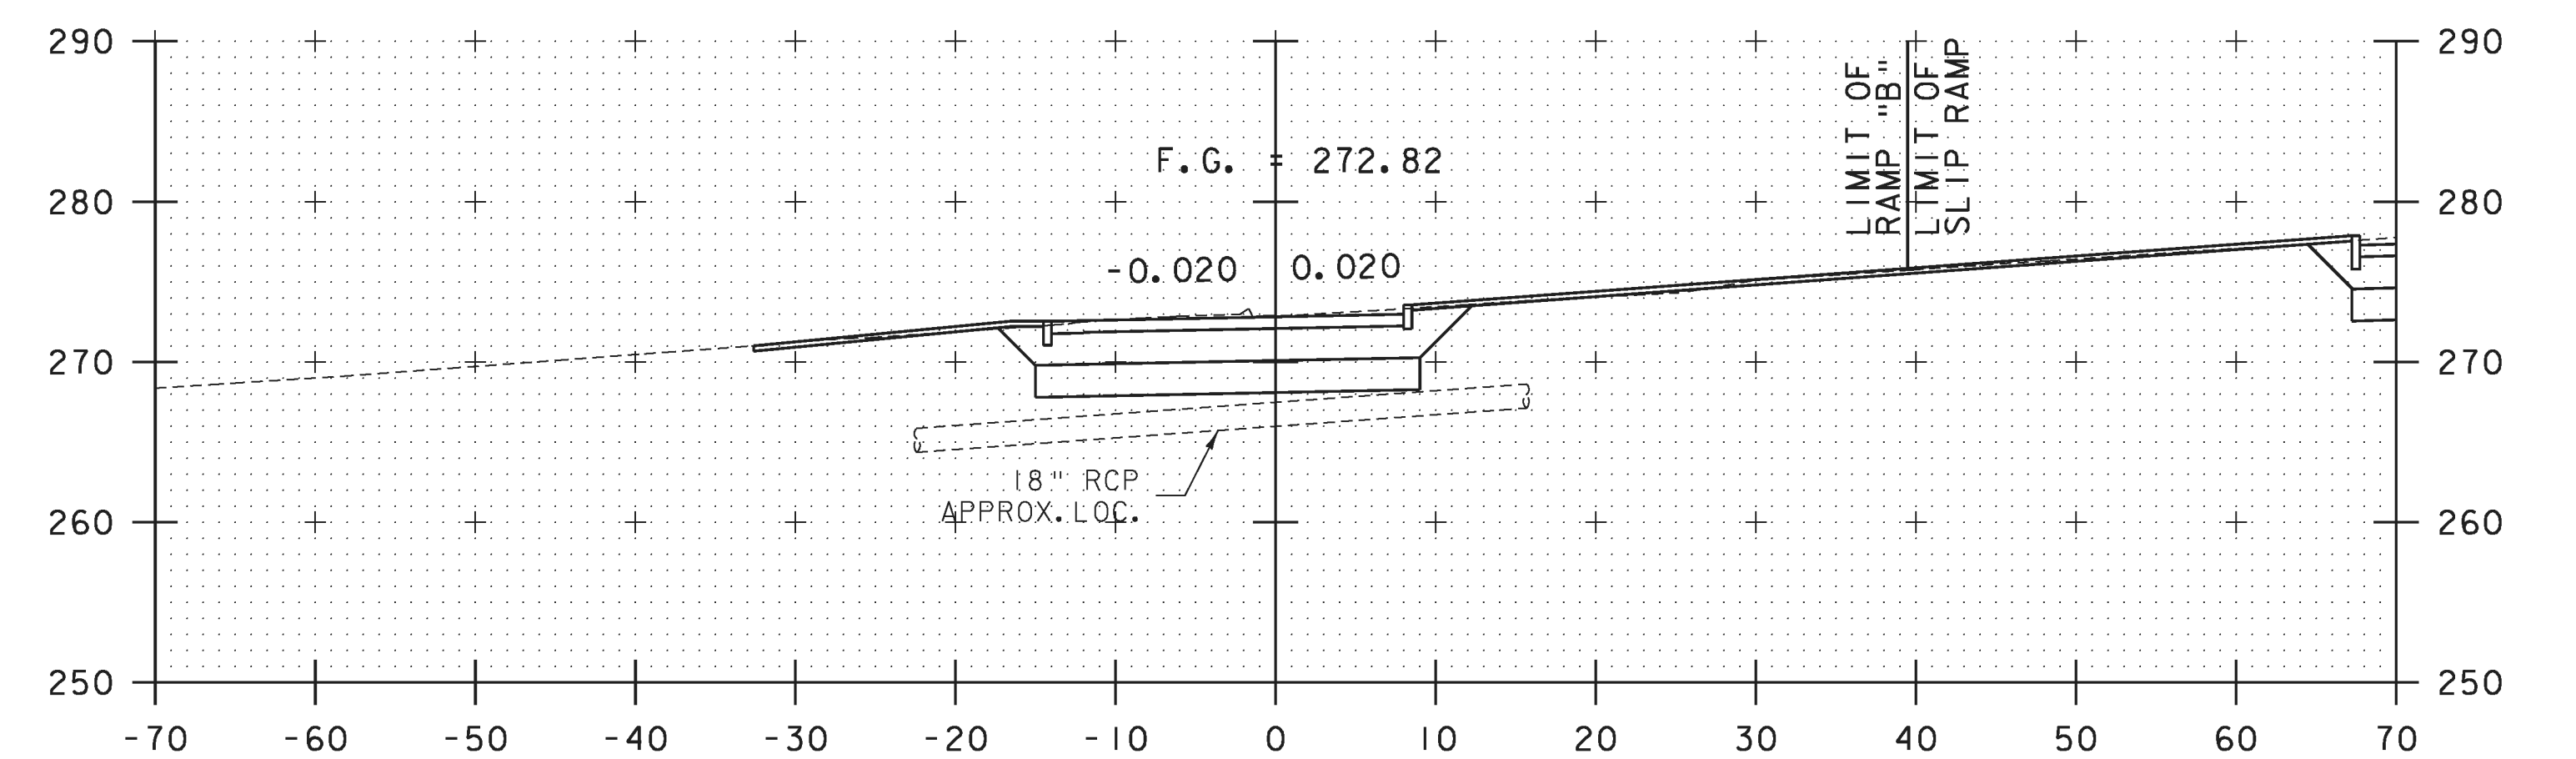

RAMP "B" AND SLIP RAMP BANKING DIAGRAM

HZ. SCALE 1" = 40'
VT. SCALE 1" = 0.025'

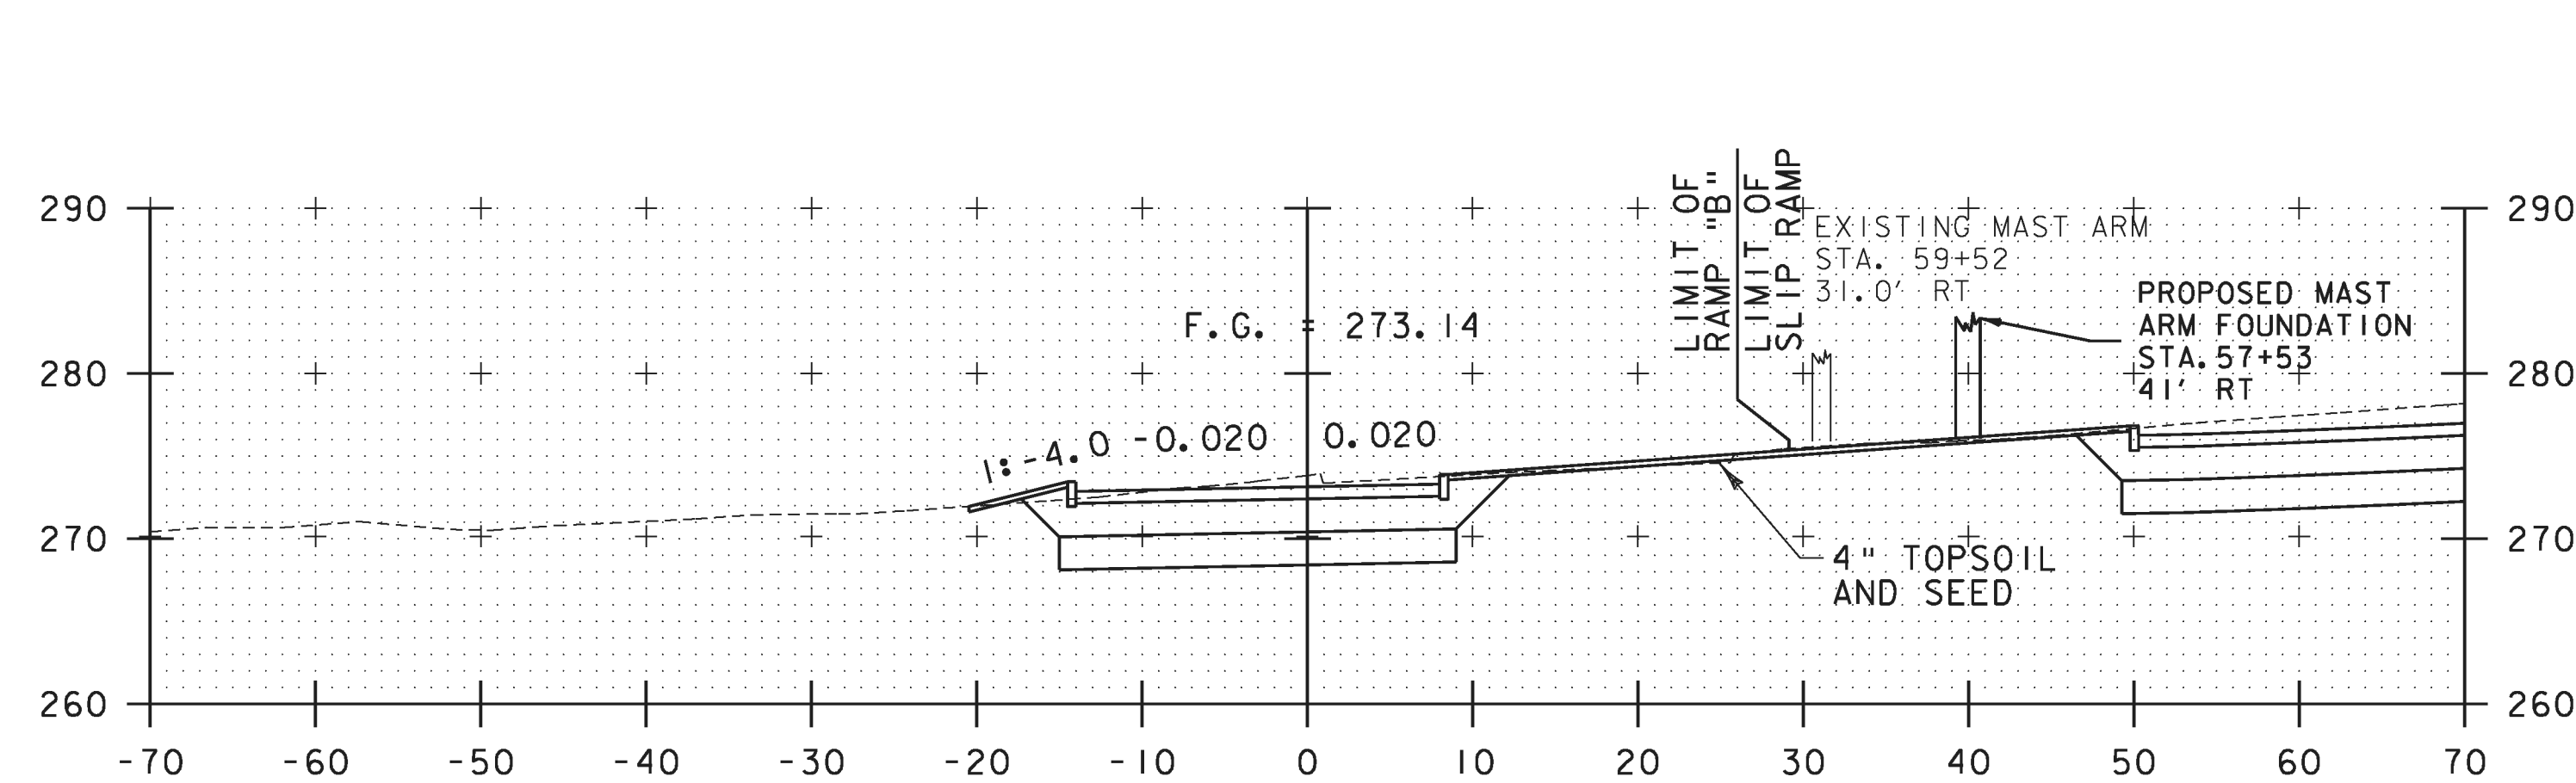

PROJECT NAME: WINOOSKI
PROJECT NUMBER: NH 089-3(65)

FILE NAME: z94a198xsl.dgn
PROJECT LEADER: KEN UPMAL
DESIGNED BY: T.BIGELOW
RAMP "B" CROSS SECTIONS SHEET 5

PLOT DATE: 2/22/2010
DRAWN BY: T.BIGELOW
CHECKED BY: E.ATKINS
SHEET 64 OF 67