



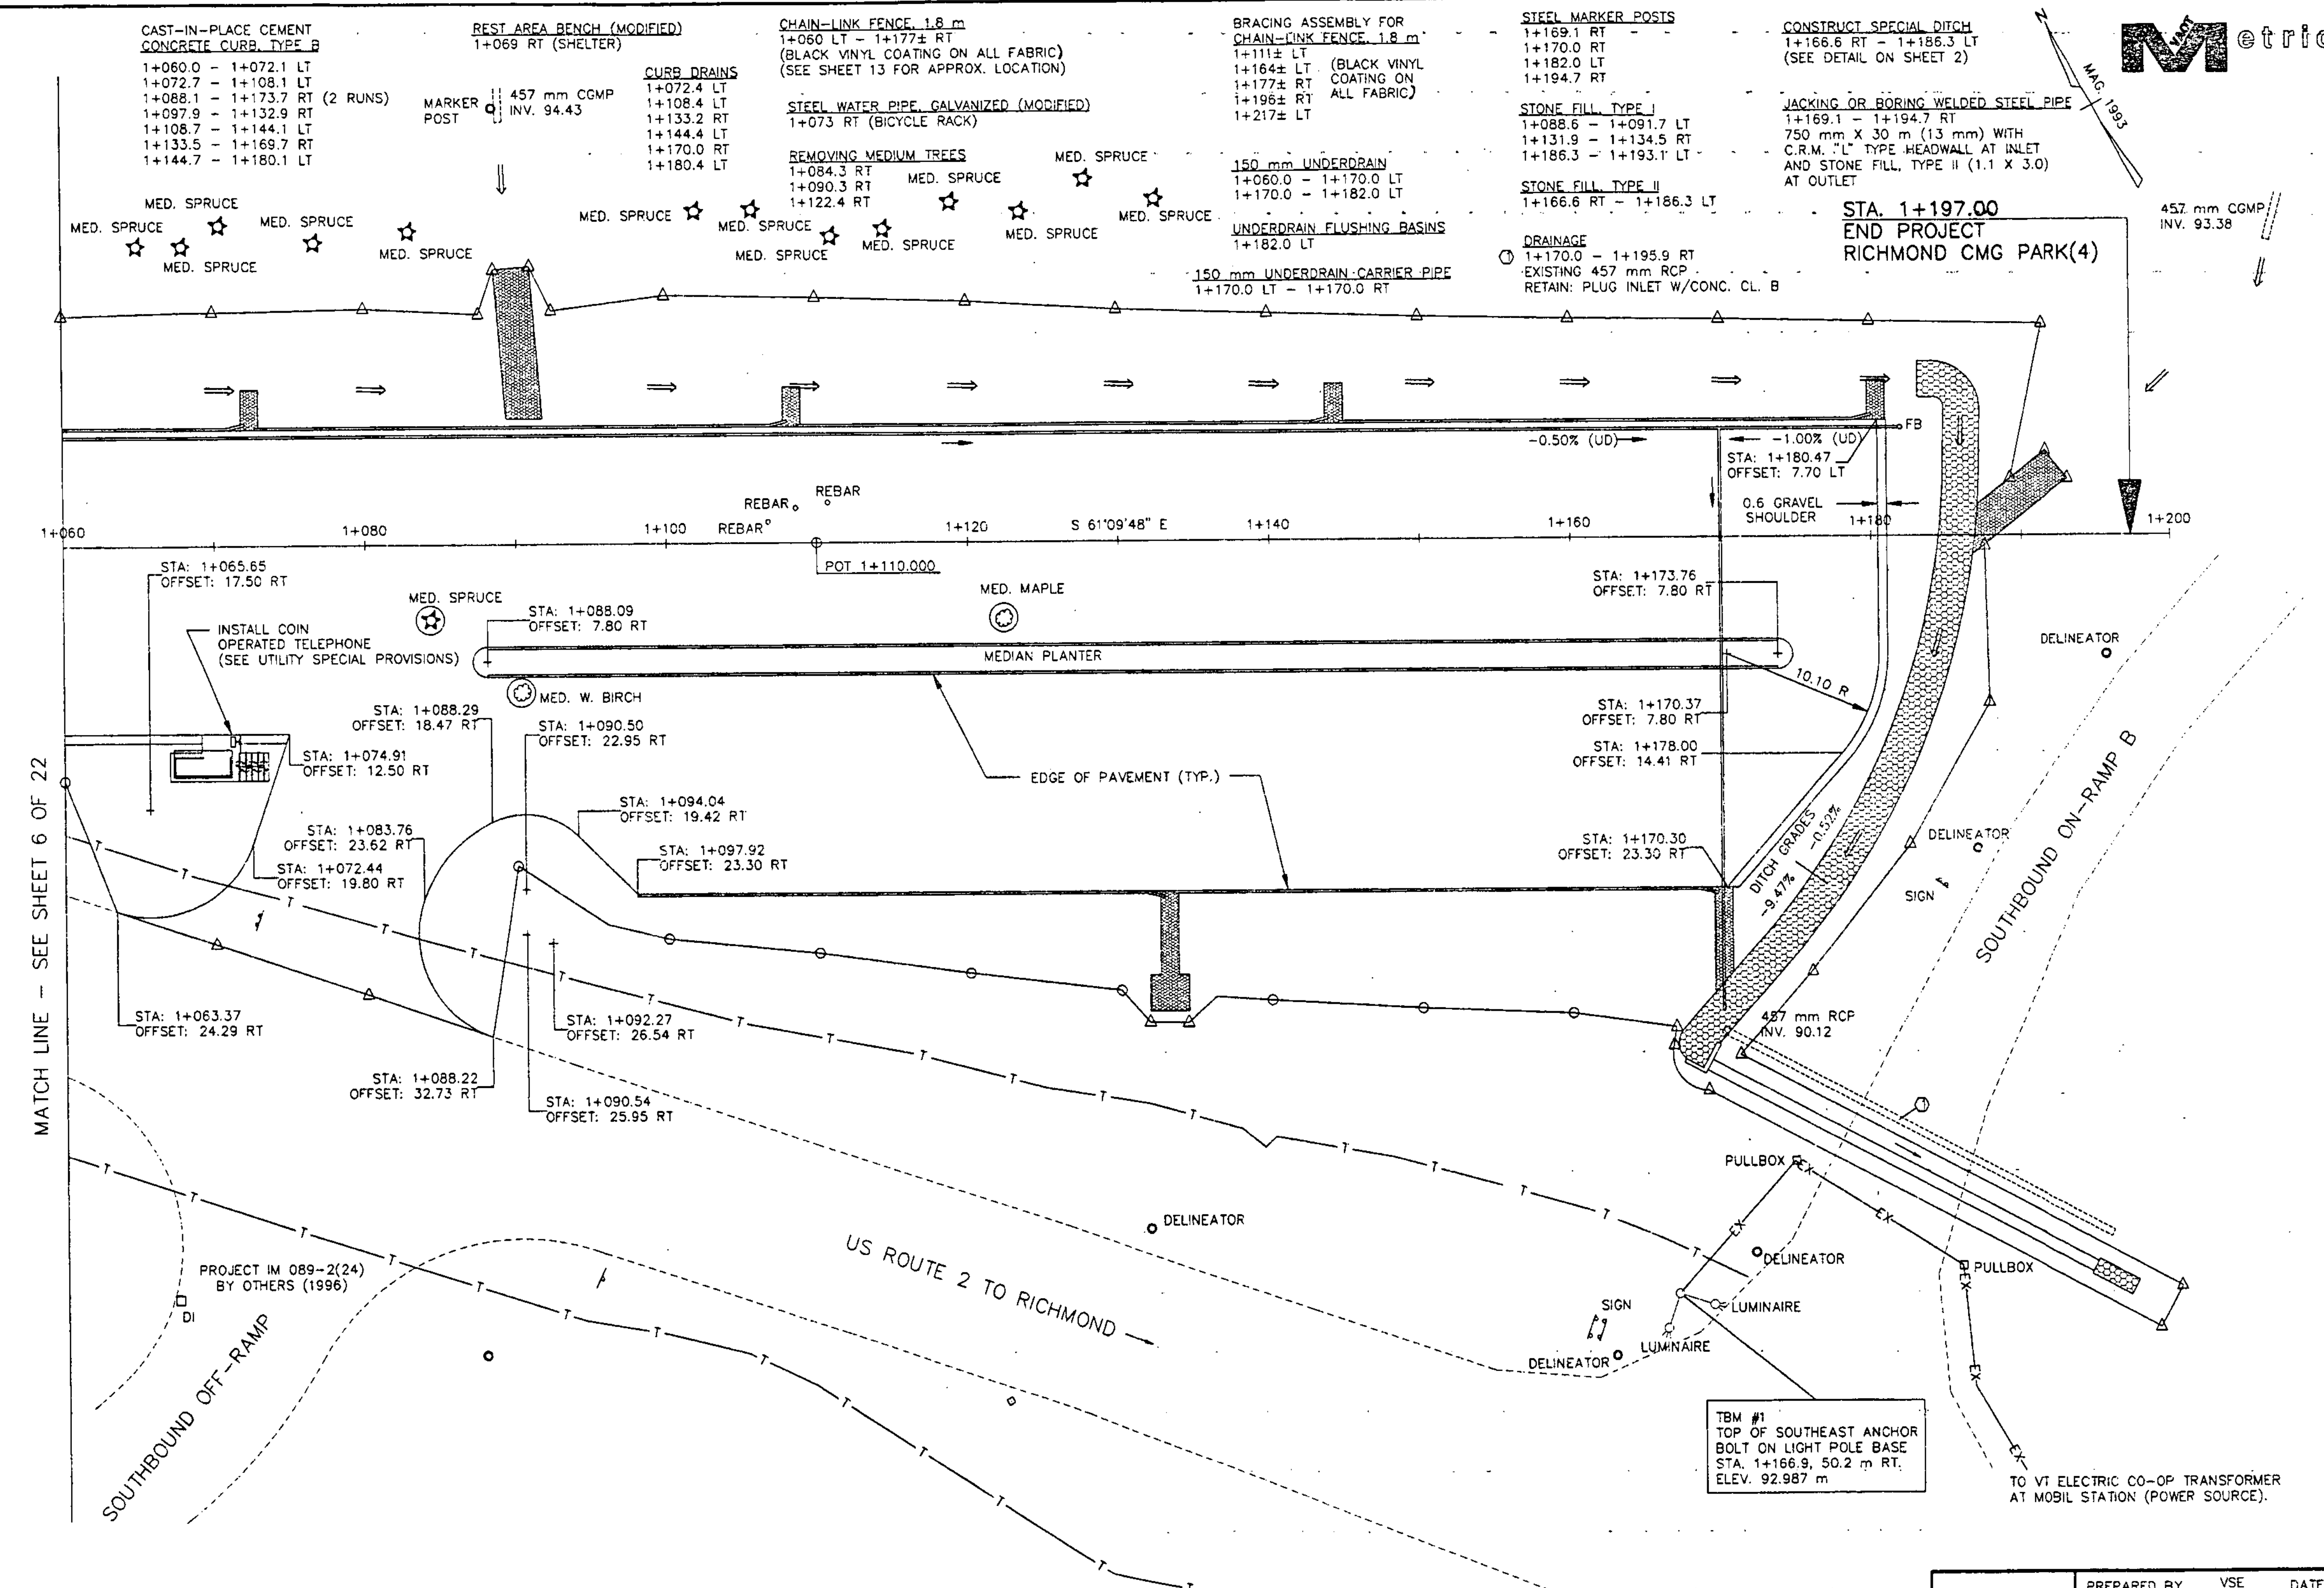

DATUM
VERTICAL NAVD88(meters)
HORIZONTAL N/A

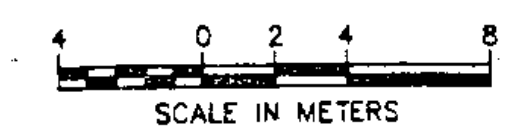

ALL DIMENSIONS IN METERS
UNLESS OTHERWISE NOTED

PROJECT
PLAN

PREPARED BY VSE DATE 11/95
CHECKED BY VSE DATE 11/95
DESIGN SUPERVISOR GAK DATE 11/95
PROJ. RICHMOND CMG PARK(4)
SHEET 7 OF 22 SHEETS