
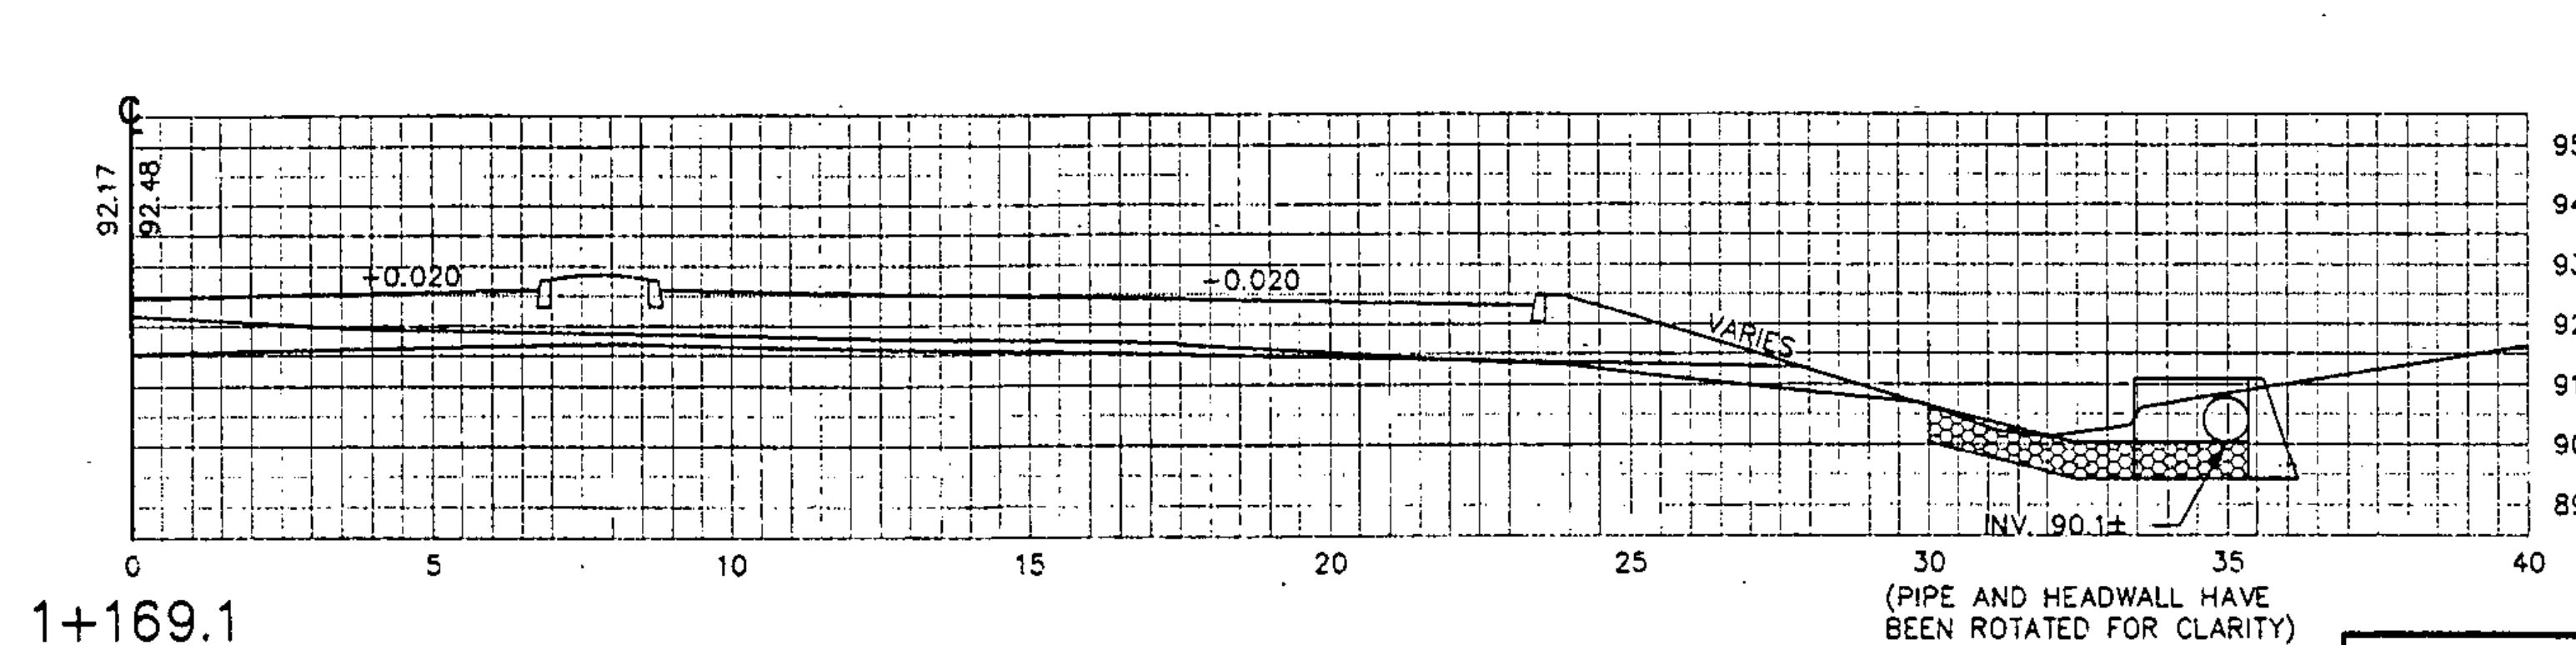
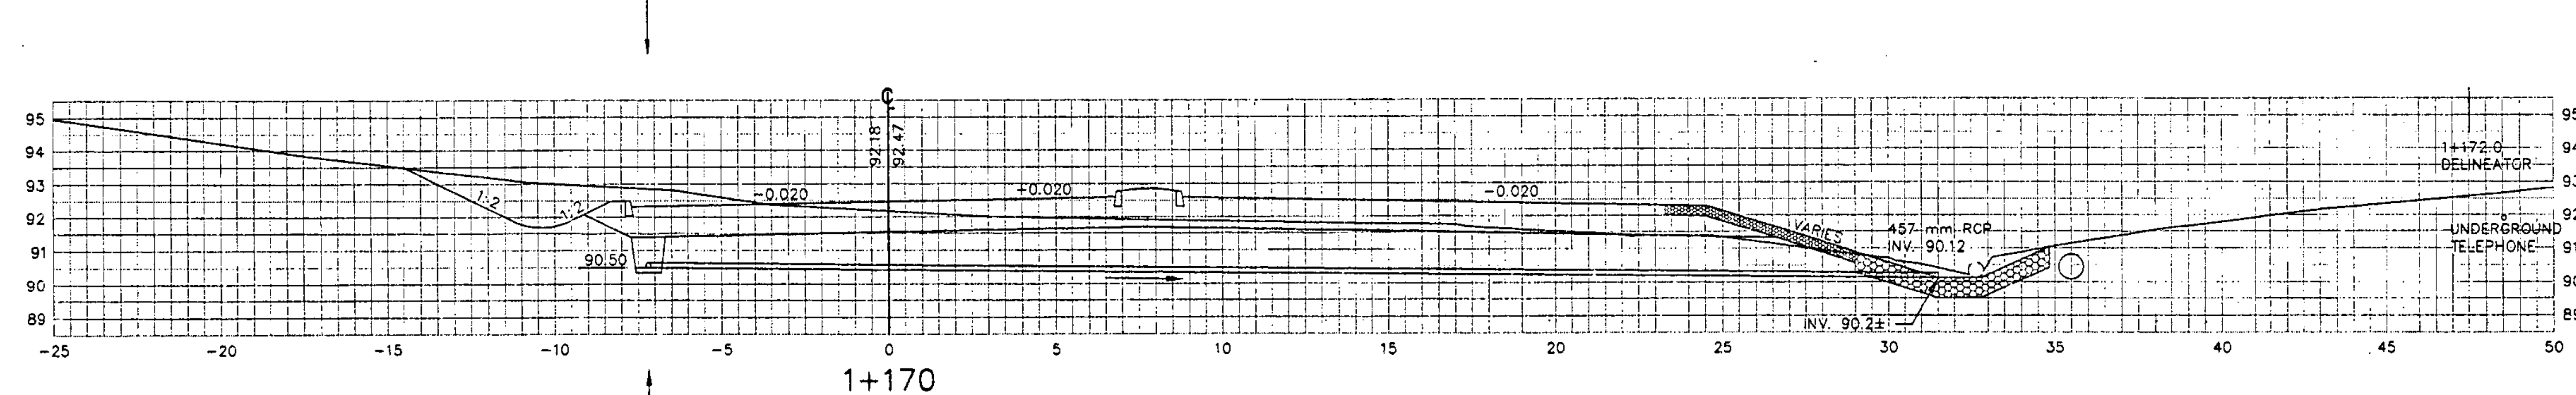
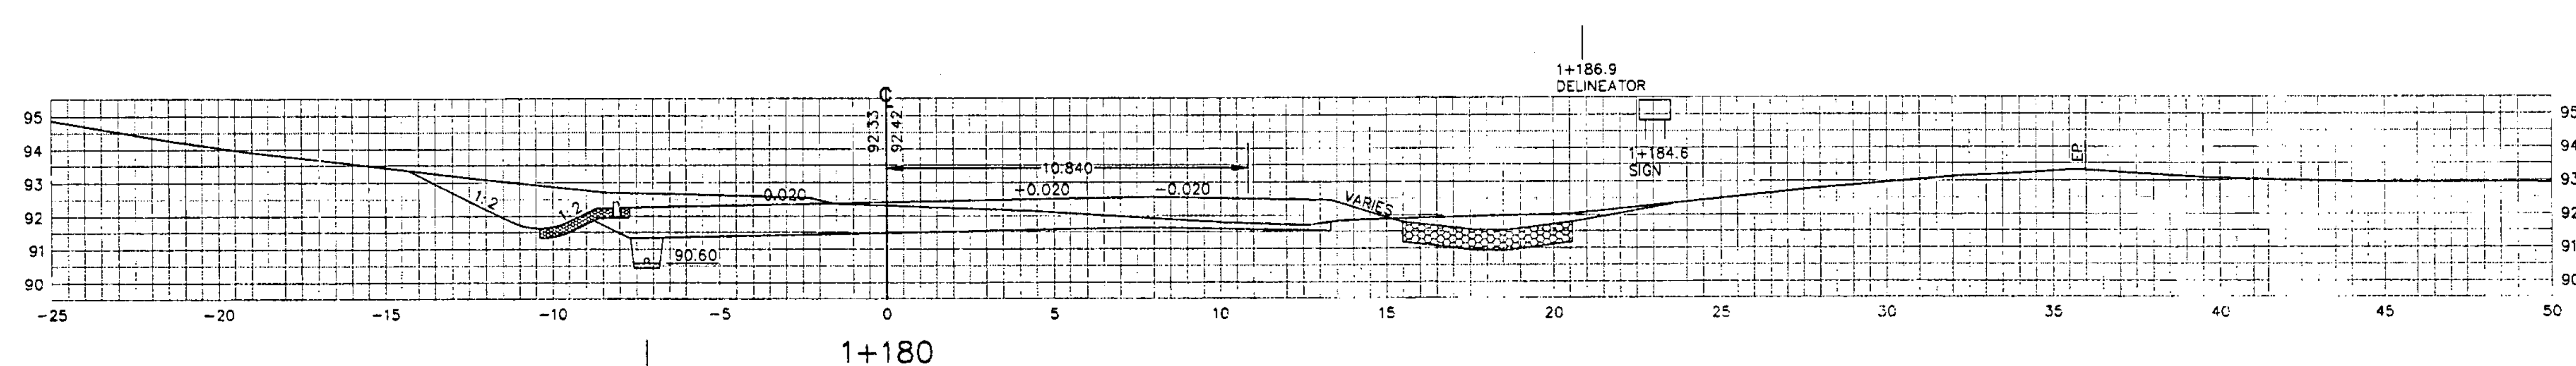
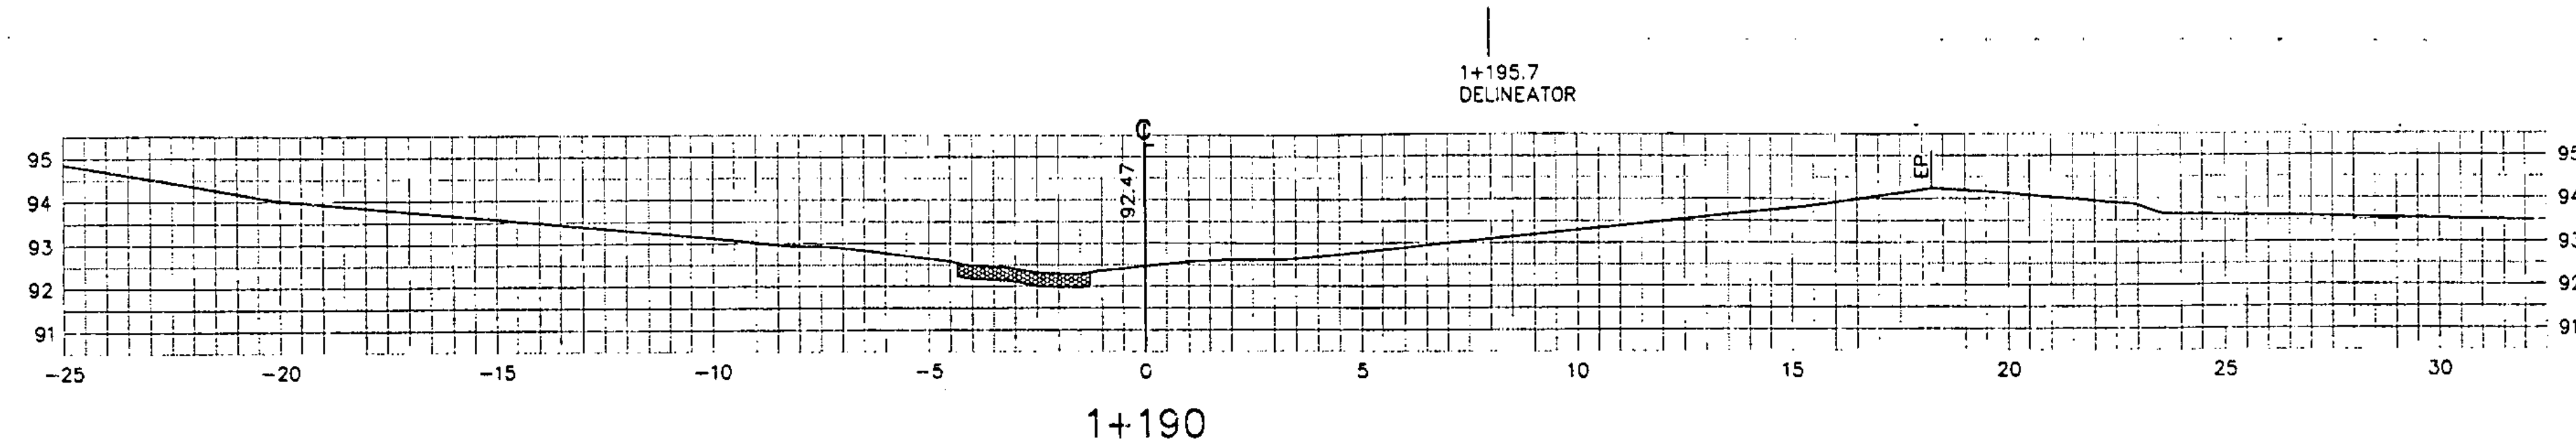


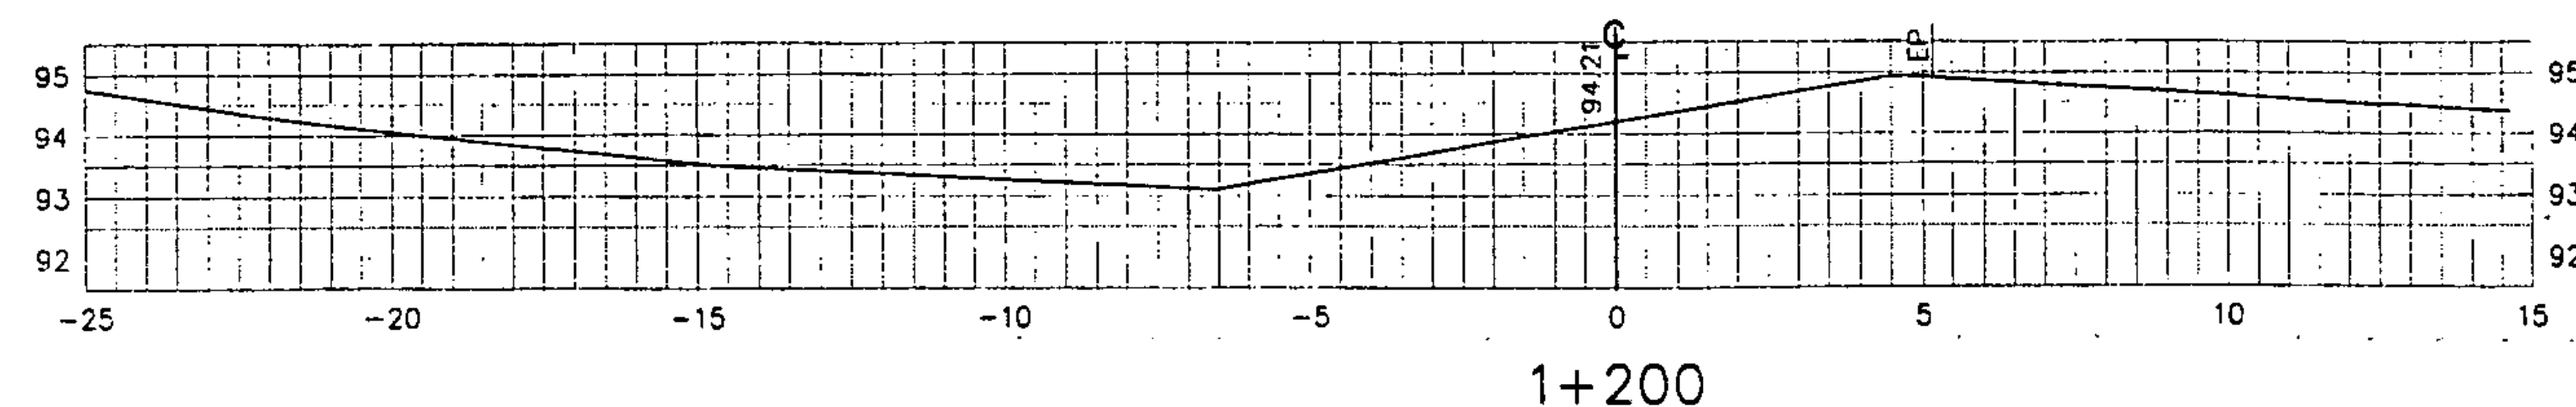

CROSS SECTIONS

FROM STA. 1+169.1 TO STA. 1+200
 SURVEY BY RDC DATE 12/93
 PROJ. RICHMOND CMG PARK(4)
 SHEET 22 OF 22 SHEETS

5 m