


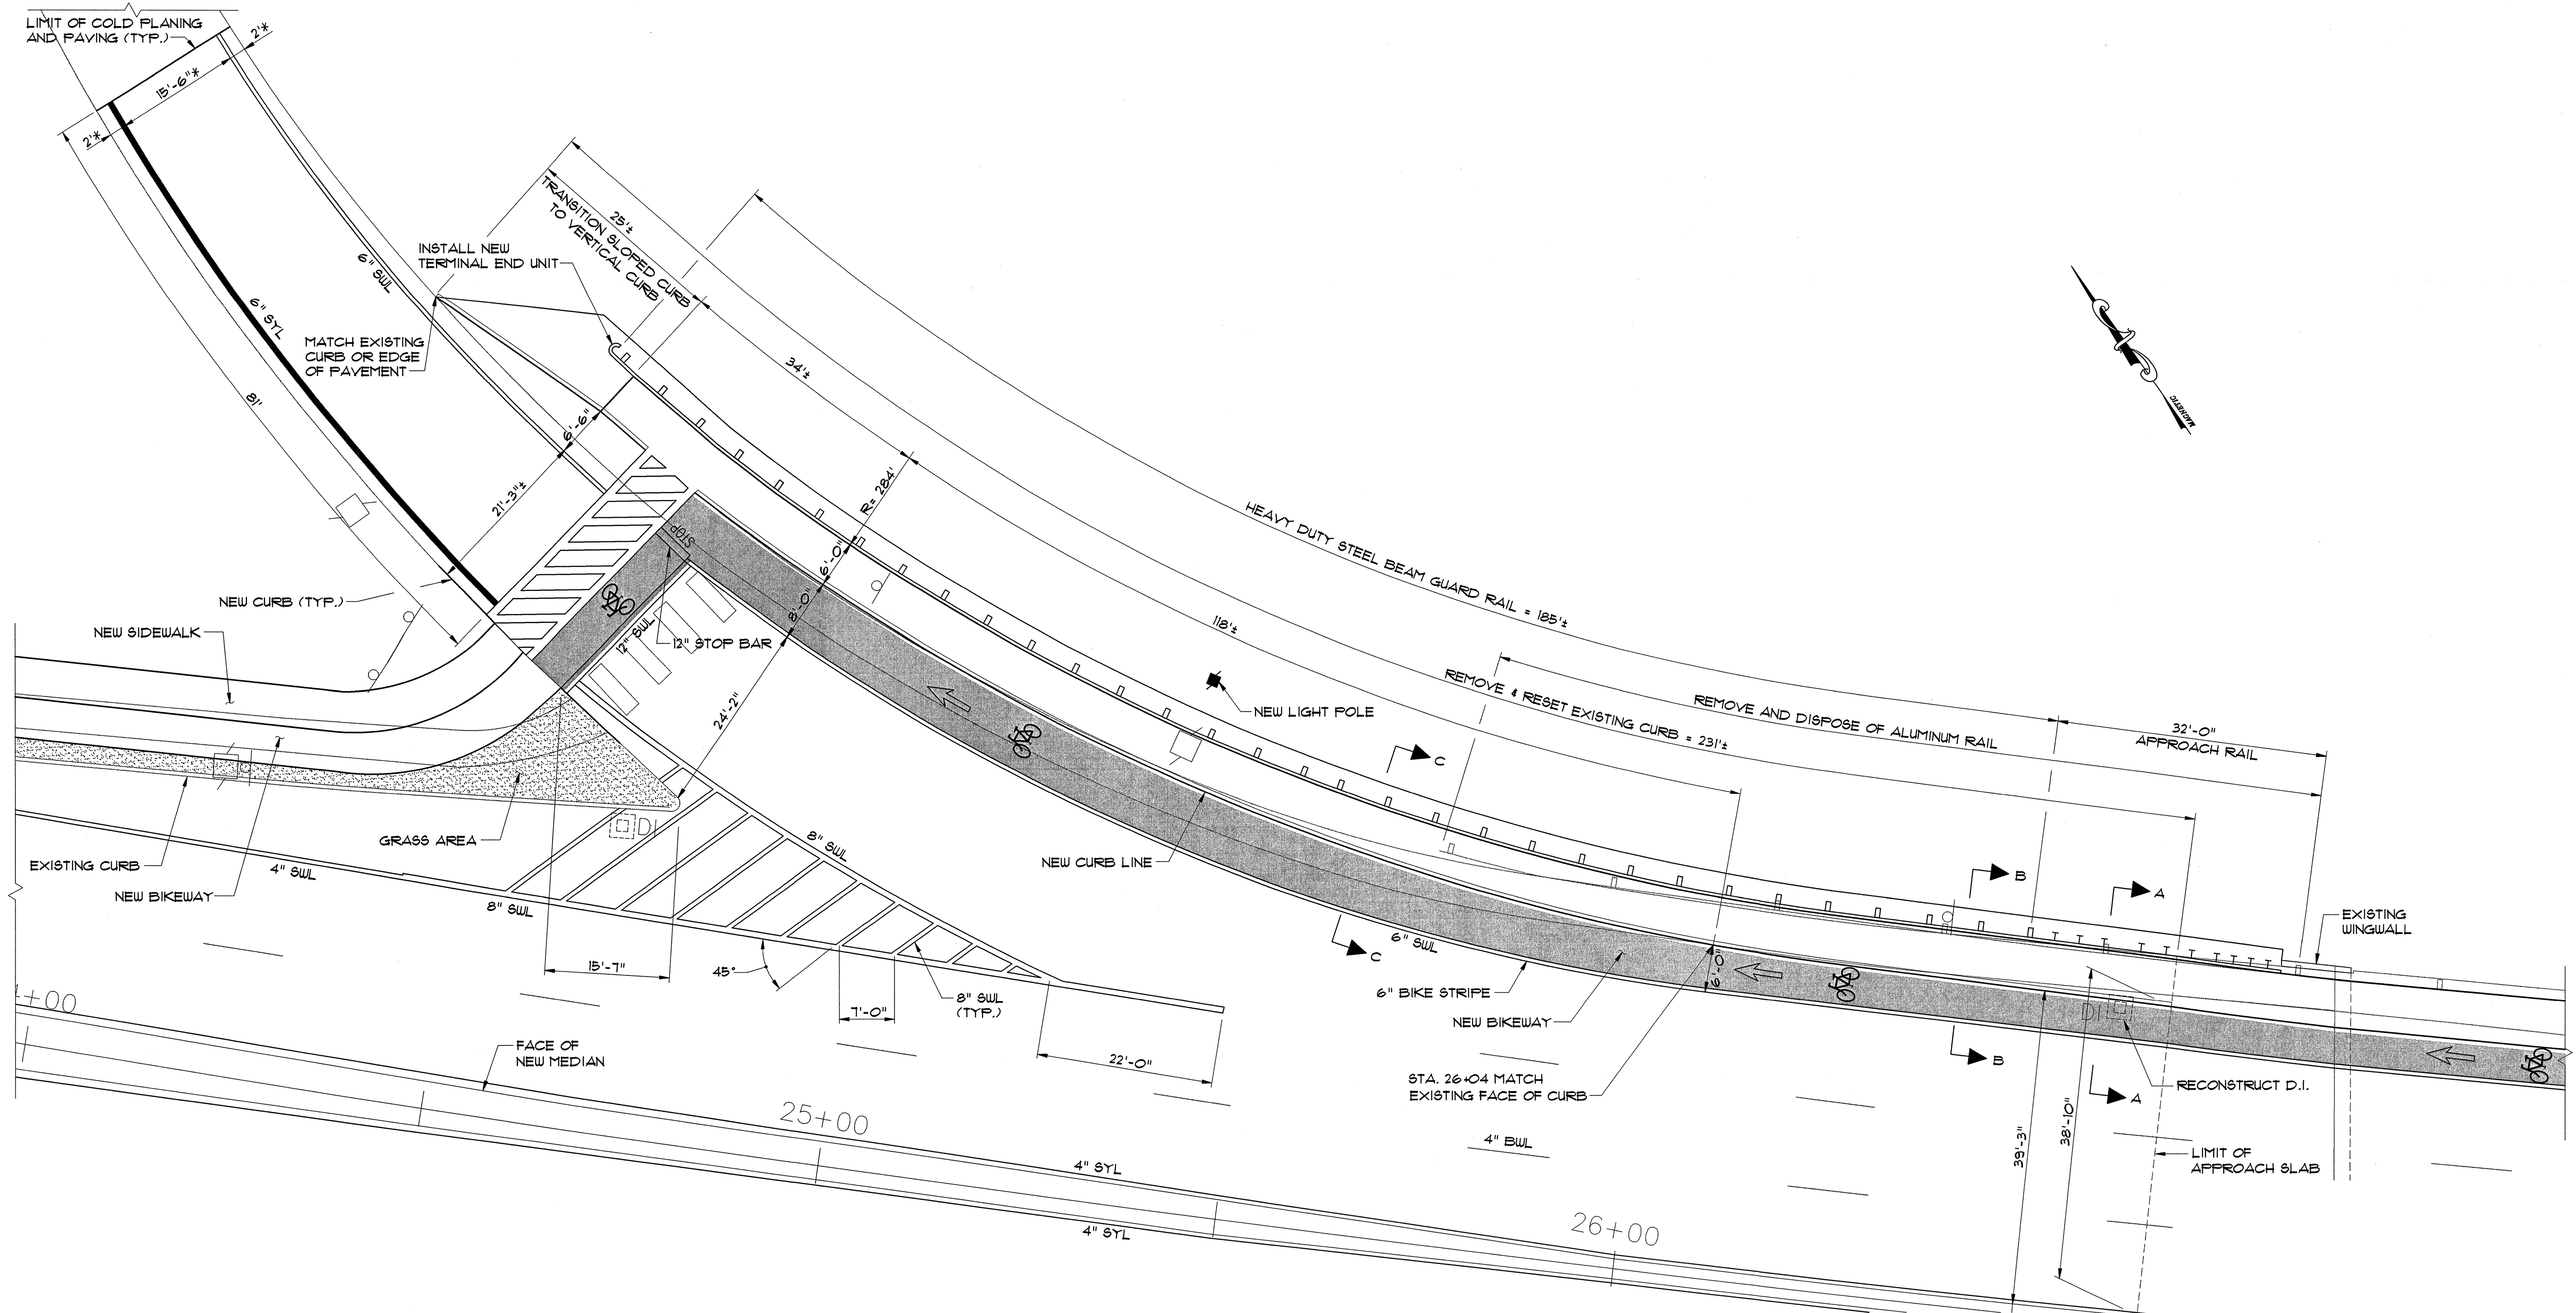

SHEET NOTES:

1. SEE SHEET 41 FOR LEGEND.
2. CURB AND PAVEMENT SHALL BE PLACED AS DIRECTED BY THE ENGINEER FROM LIMIT OF COLD PLANING ON RAMP TO NEW CROSSWALK SO THAT THE ROADWAY WILL DRAIN PROPERLY. THIS WORK SHALL BE SUBSIDIARY TO THE CURB AND PAVEMENT ITEMS.
3. PAVEMENT MARKINGS FOR BIKE SYMBOL AND ARROWS SHALL BE PAID FOR AS ITEM 646.50, "DURABLE LETTER OR SYMBOL." SEE SPECIAL PROVISIONS FOR DETAILS.
4. SEE SHEET 54 FOR SECTIONS A-A, B-B, AND C-C.
5. INFORMATION SHOWN ON THE PLANS IS BASED ON EXISTING DRAWINGS AND LIMITED SURVEY. THE CONTRACTOR SHALL FIELD VERIFY THE LAYOUT OF THE PROPOSED CURB, SIDEWALK, AND GUARD RAIL. ANY ADJUSTMENTS TO THE LAYOUT THAT ARE REQUIRED SHALL BE BROUGHT TO THE ATTENTION OF THE ENGINEER PRIOR TO EXCAVATION OR PAVEMENT/CURB REMOVAL. ALL COSTS FOR THIS WORK SHALL BE SUBSIDIARY TO ALL OTHER ITEMS IN THE CONTRACT.

* MATCH EXISTING PAVEMENT MARKINGS

RAMP D
SCALE: 1" = 10'

■ = INDICATES LIMIT OF ITEM 646.50. SEE SHEET 54 FOR TYPICAL DETAIL.

STRIPING LEGEND:

- SWL = SOLID WHITE LINE
- SYL = SOLID YELLOW LINE
- BWL = BROKEN WHITE LINE



STATE OF VERMONT			
AGENCY OF TRANSPORTATION			
Town Of SOUTH BURLINGTON		Bridge No. 68	
Highway No. U.S. 2		Log Sta.	
		Surv. Sta.	
U.S. 2 OVER I-89			
BIKEWAY PLAN RAMP D			
Designed By S.M. HODGDON		Drawn By E.J. MASSE	
Checked By T.S. BRYANT		Bridge Design Supervisor C.D. BAKER	
Date 2/00		Date 2/00	
PROJECT SOUTH BURLINGTON		PROJECT NO. STP BIKE (28)S	
VHB Cad Drawing No. 50363RAMP		Date 2/00	
Bridge Sheet No.		Sheet 50 of 75	

VANASSE HANGEN BRUSTLIN, INC.