

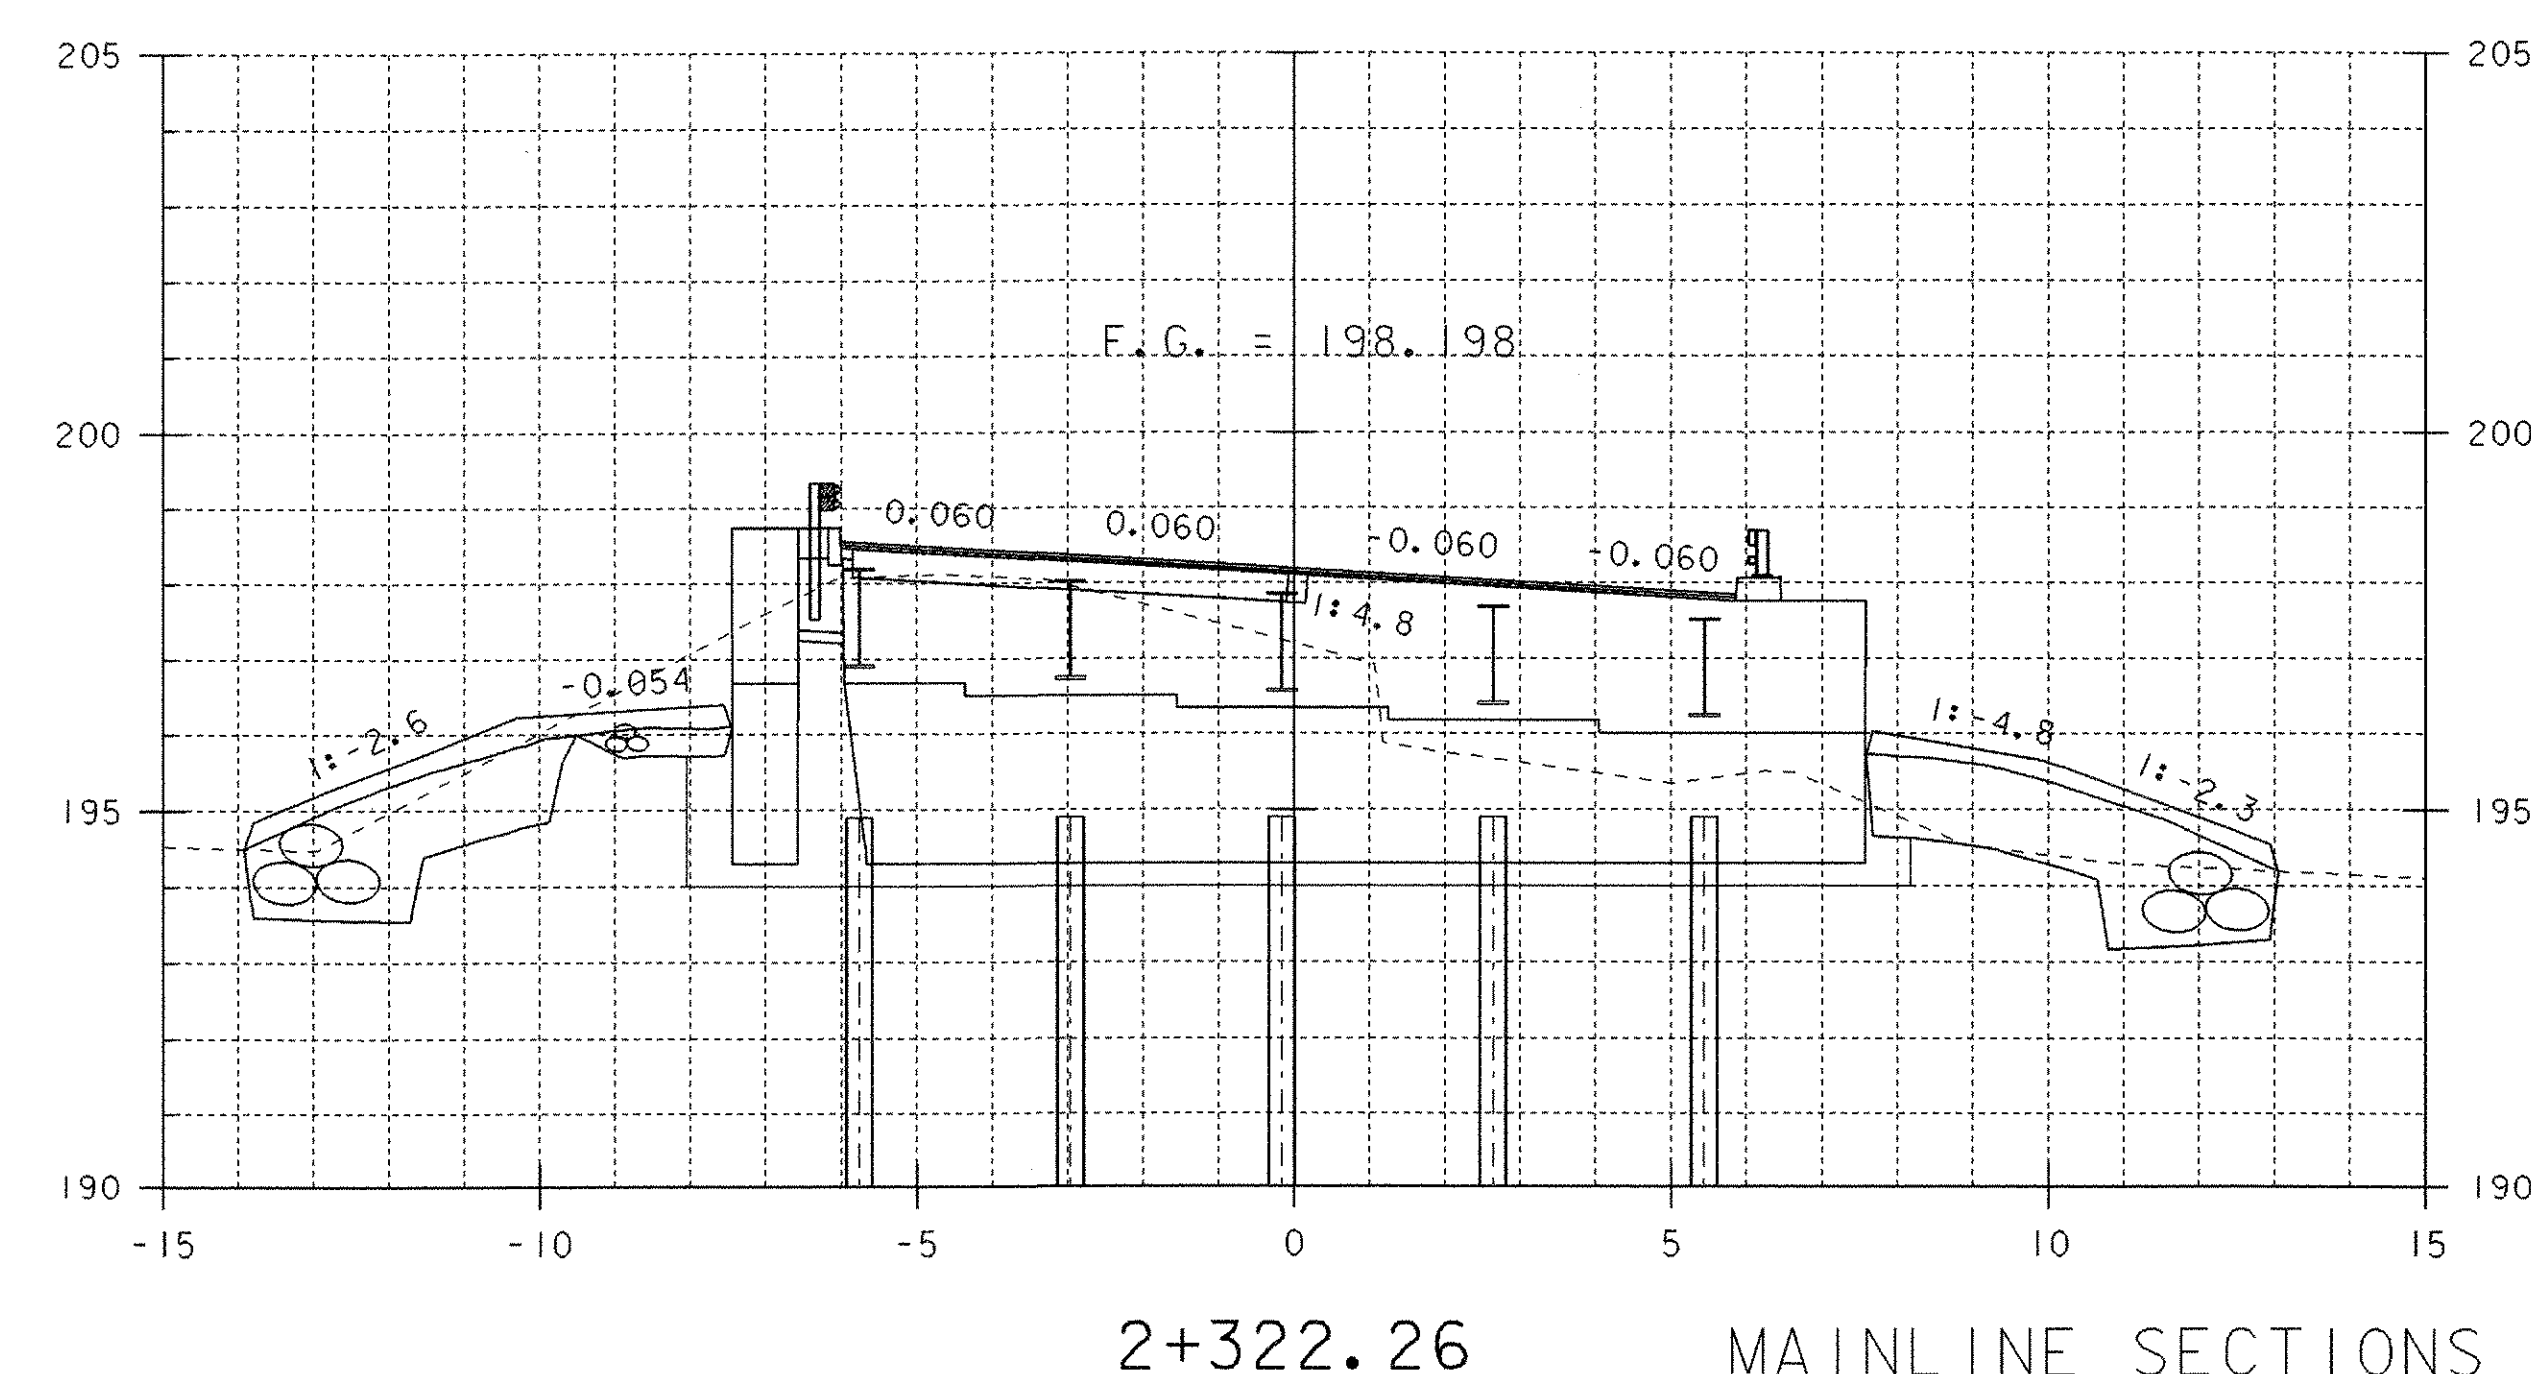
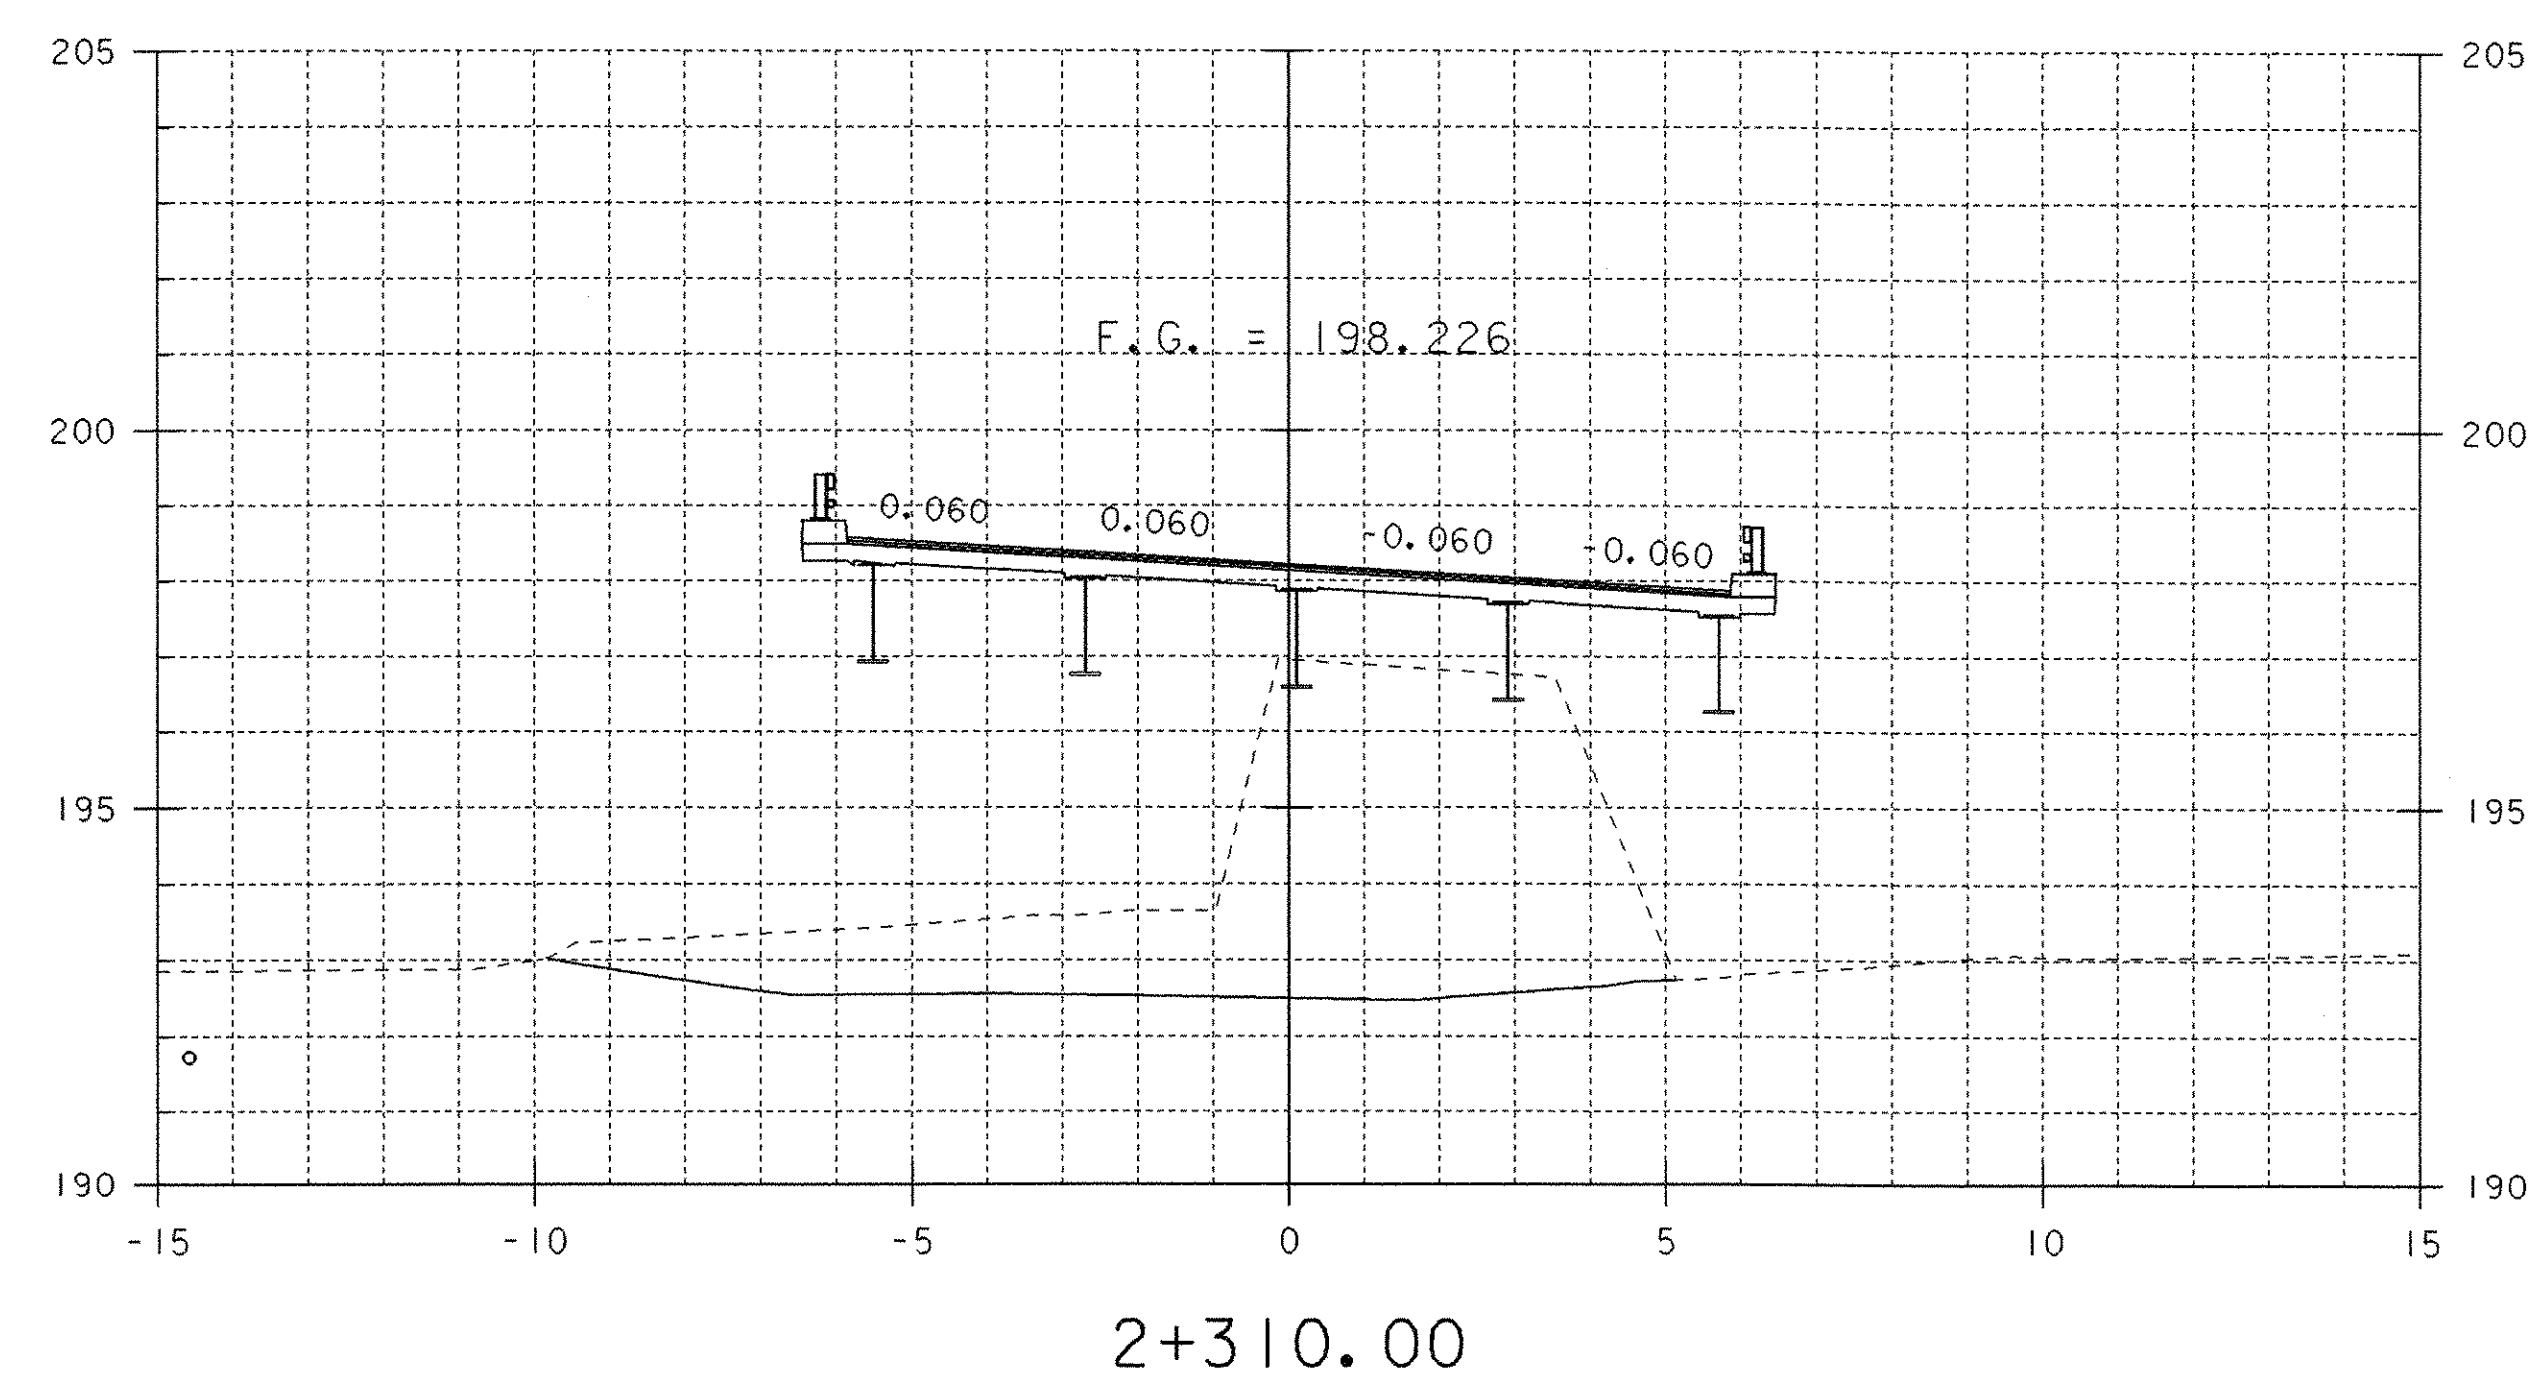
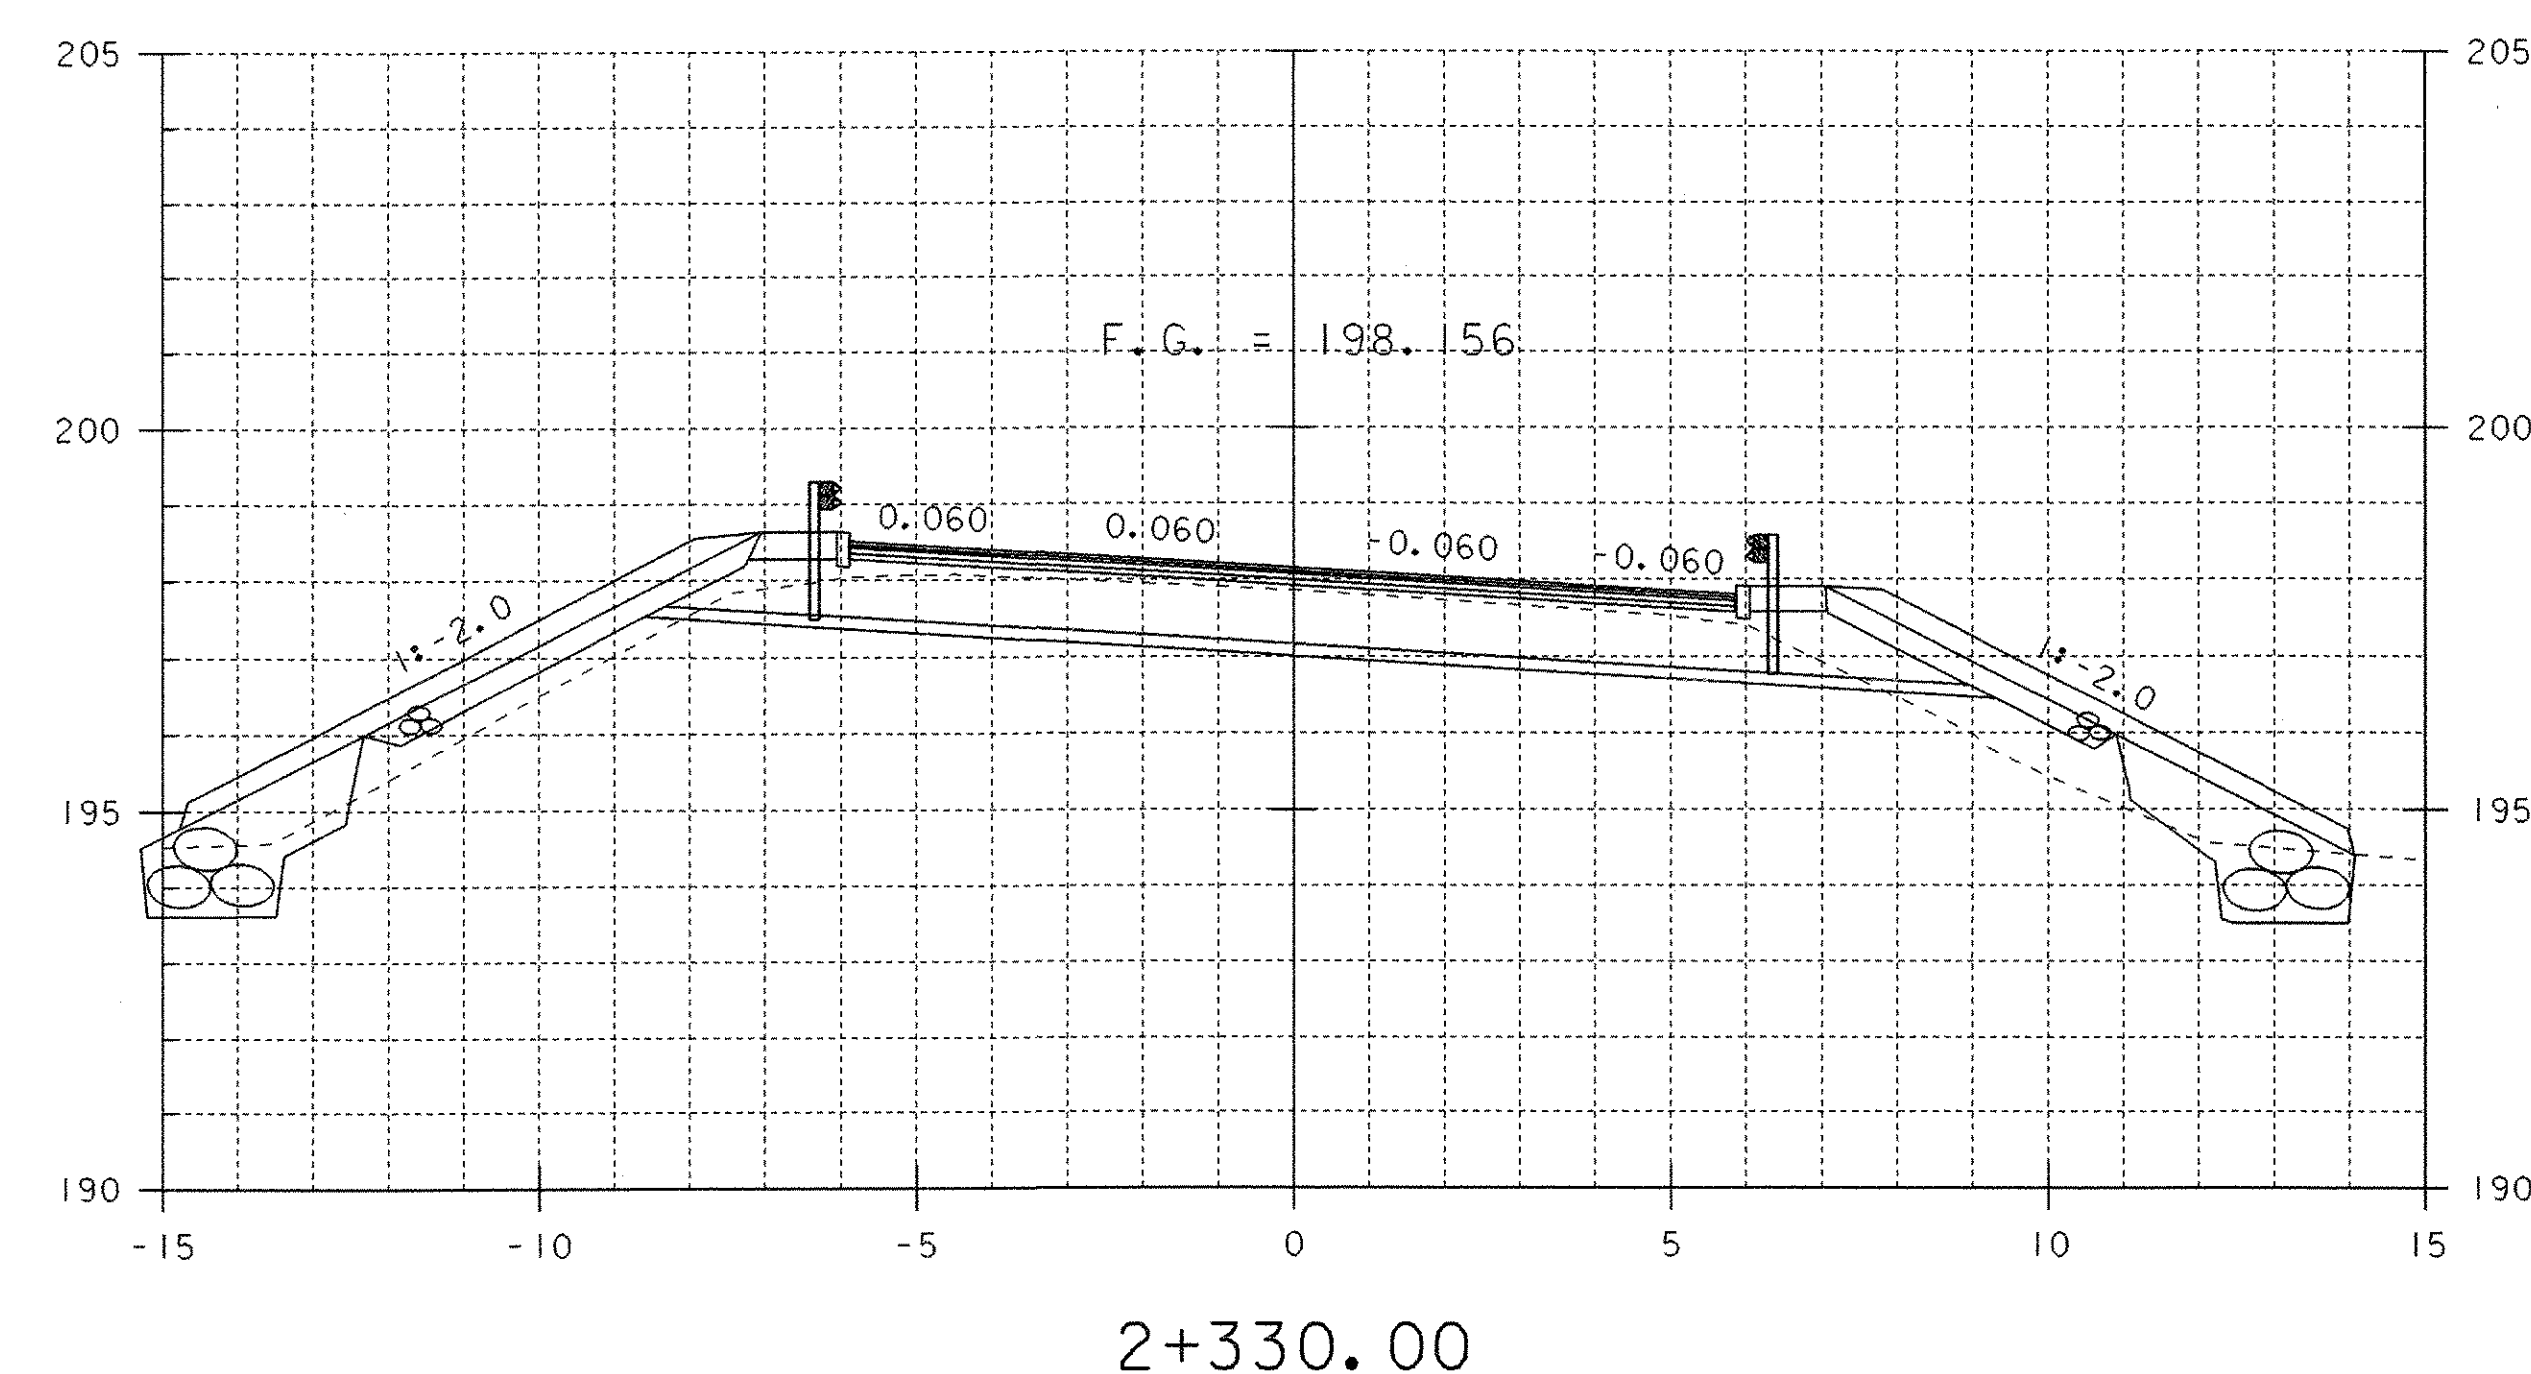


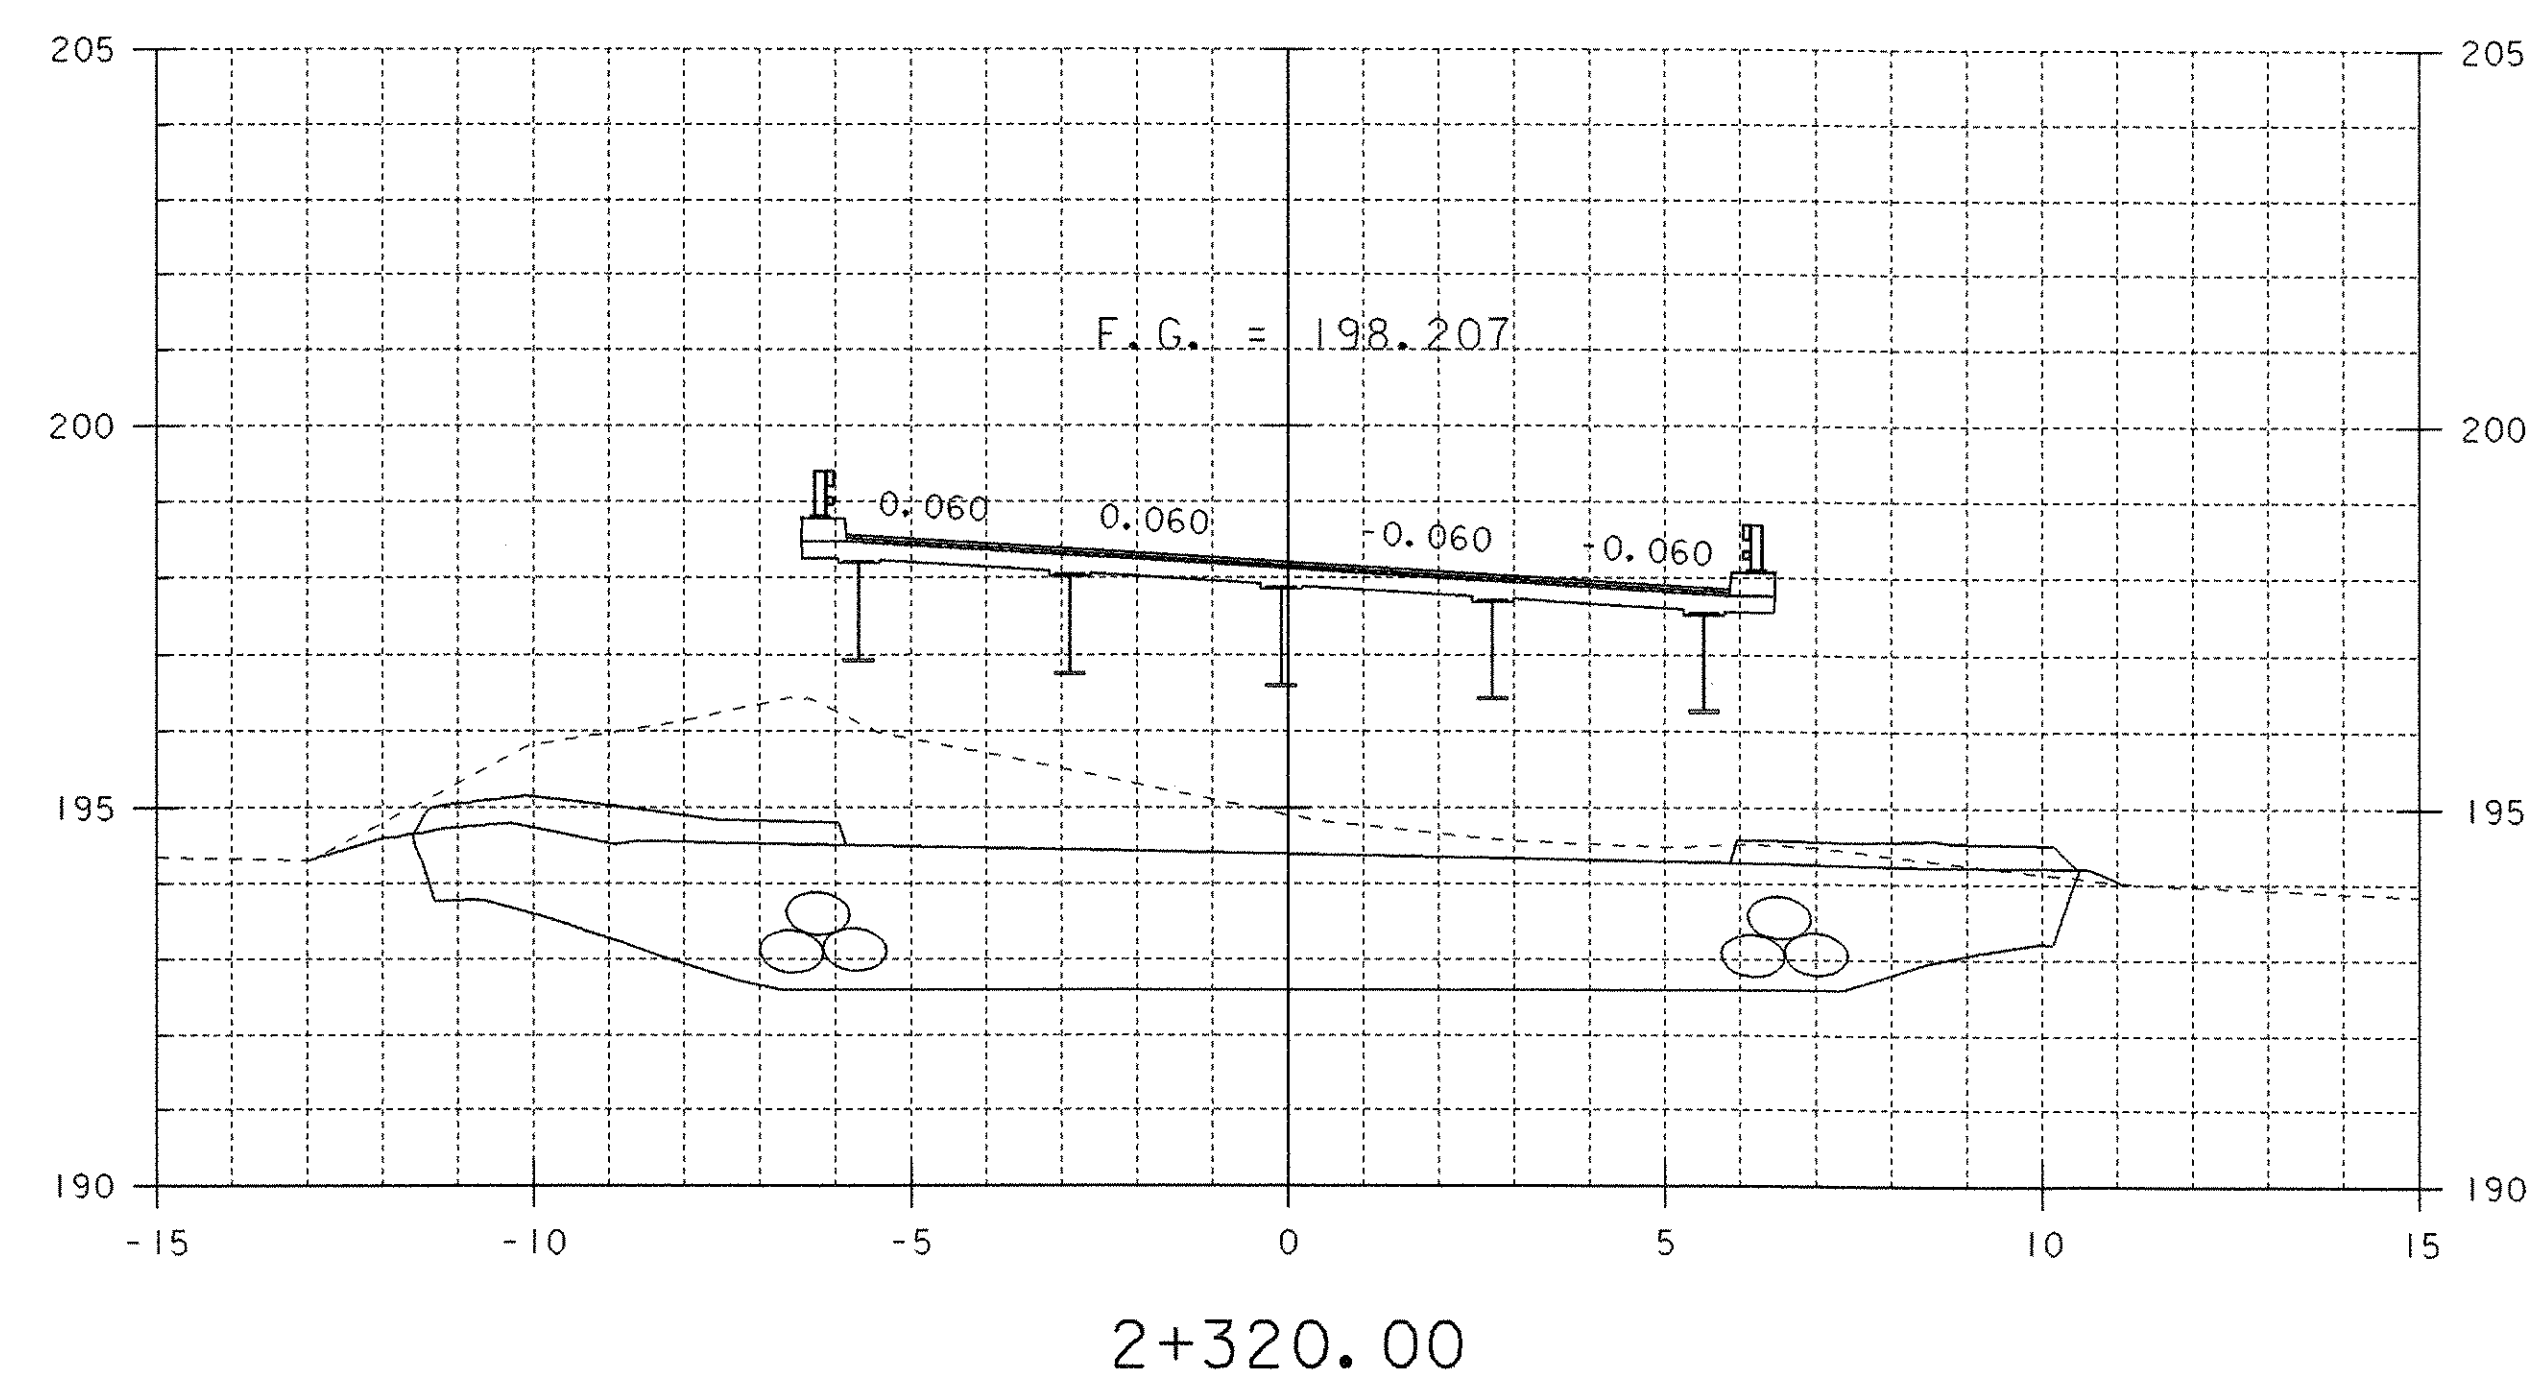

MAINLINE SECTIONS 5

2+322.256 END BRIDGE

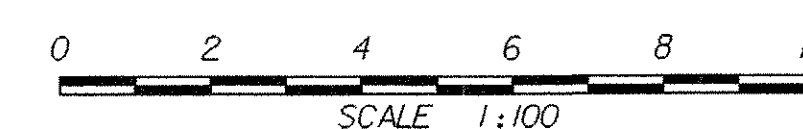

STA. 2+310 TO STA. 2+330

PROJECT NAME: RUTLAND TOWN
PROJECT NUMBER: BRF 019-3(48)

FILE NAME: 95b172/str/sb172xs2.dgn
PROJECT LEADER: R. WHITCOMB
DESIGNED BY: L. BULLOCK
sb172m05.1

PLOT DATE: 11-MAR-2008
DRAWN BY: L. BULLOCK
CHECKED BY: T. LACKEY
SHEET 65 OF 75