



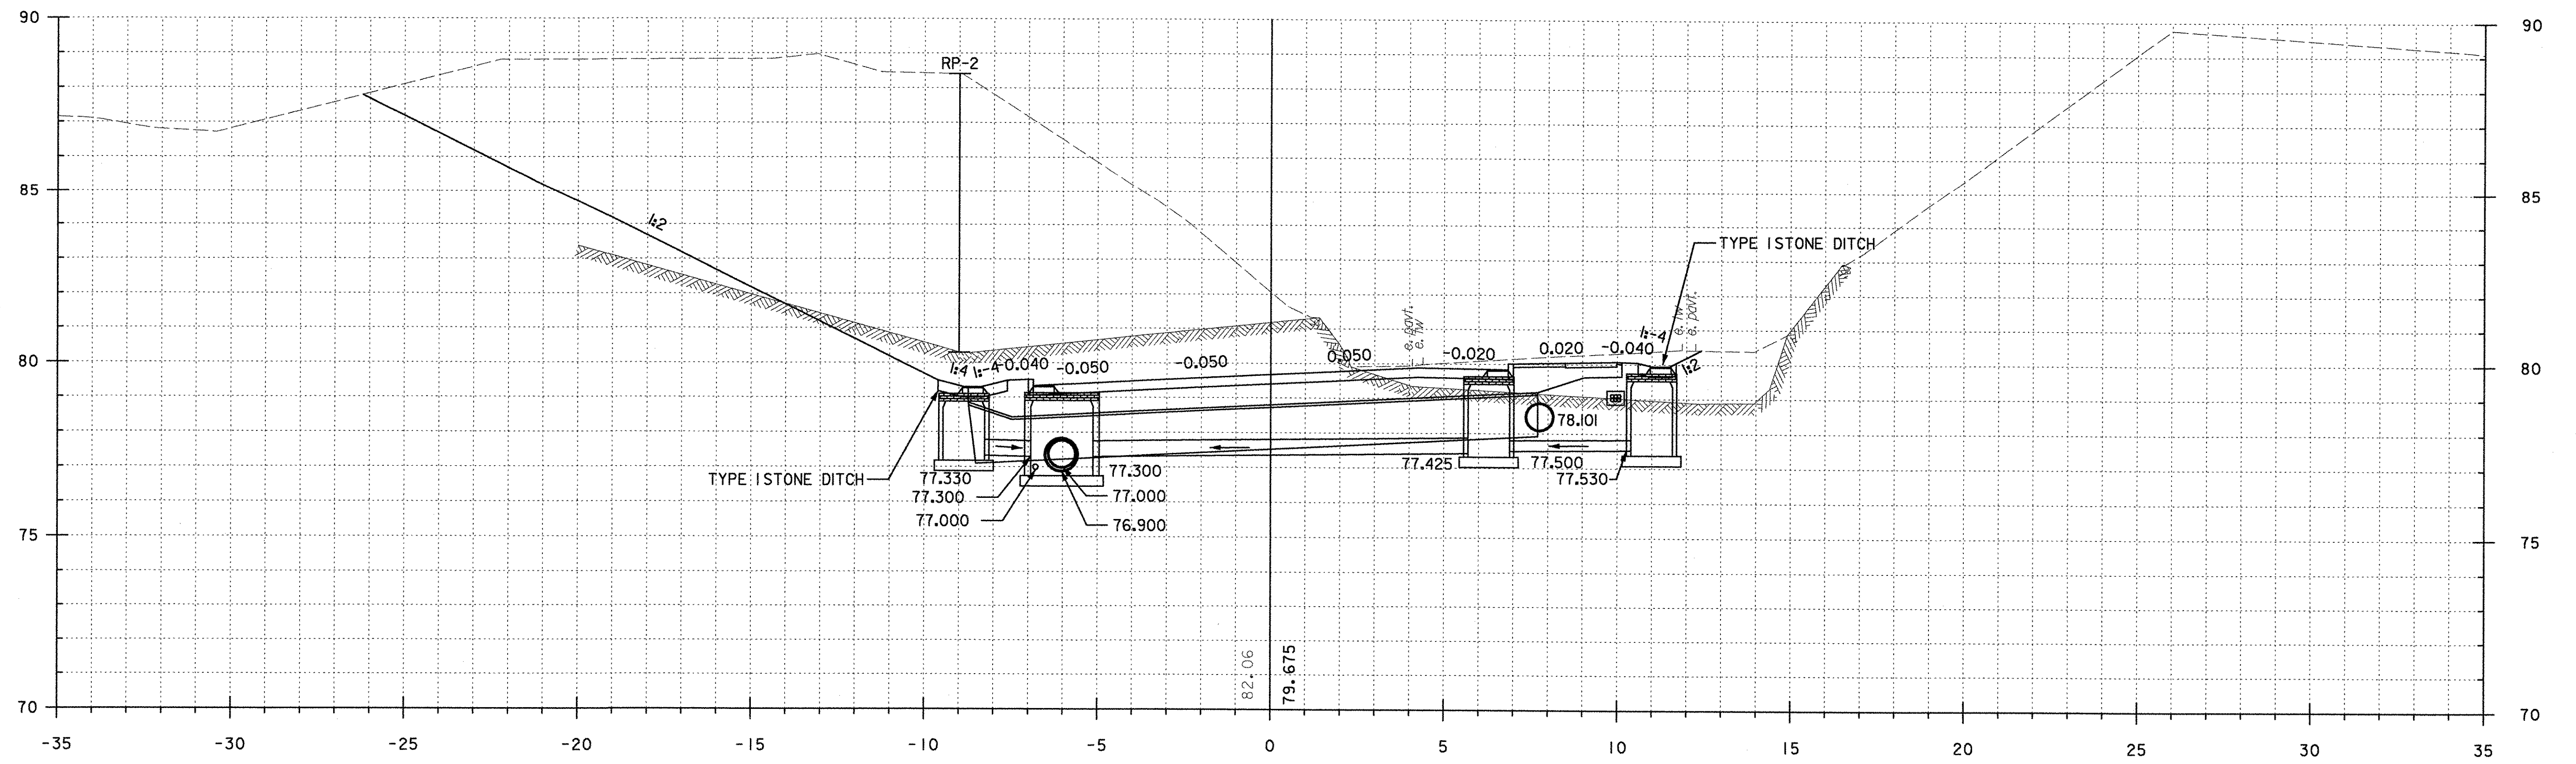

30+250.000

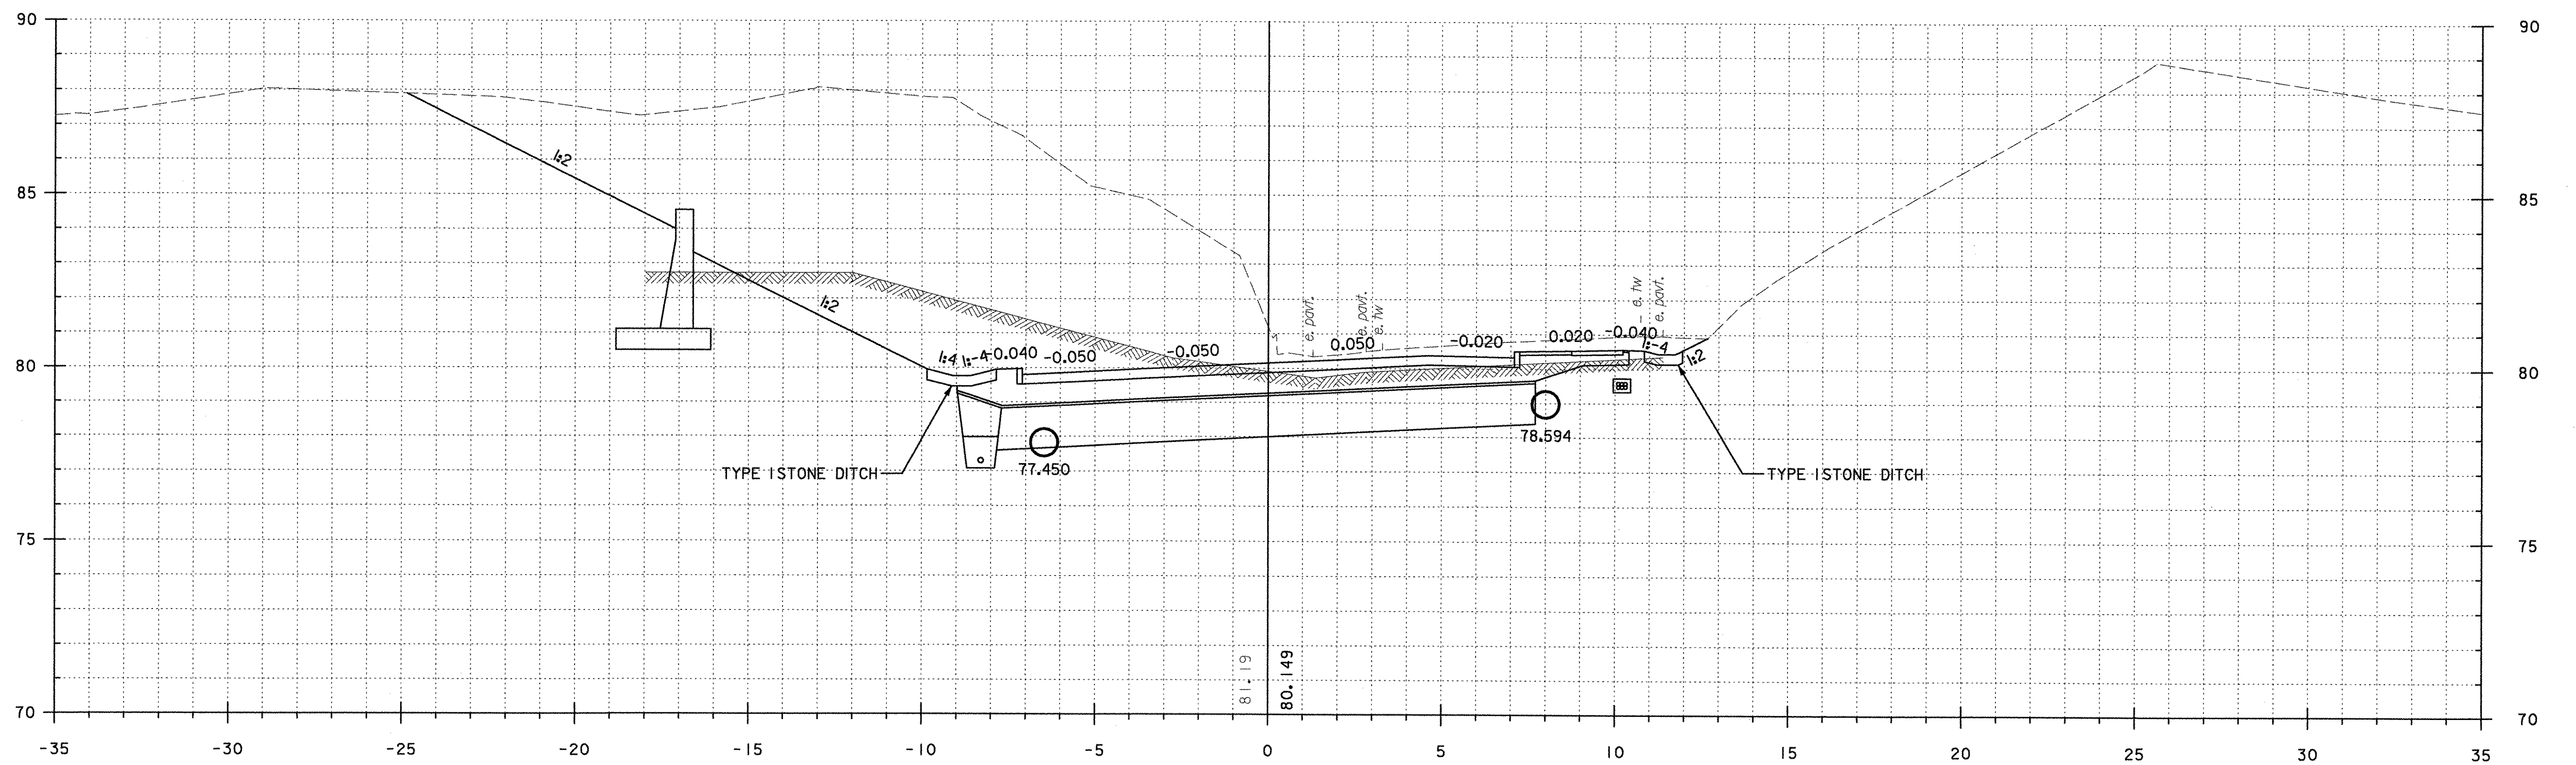

30+240.000