




RAILROAD CROSS SECTIONS

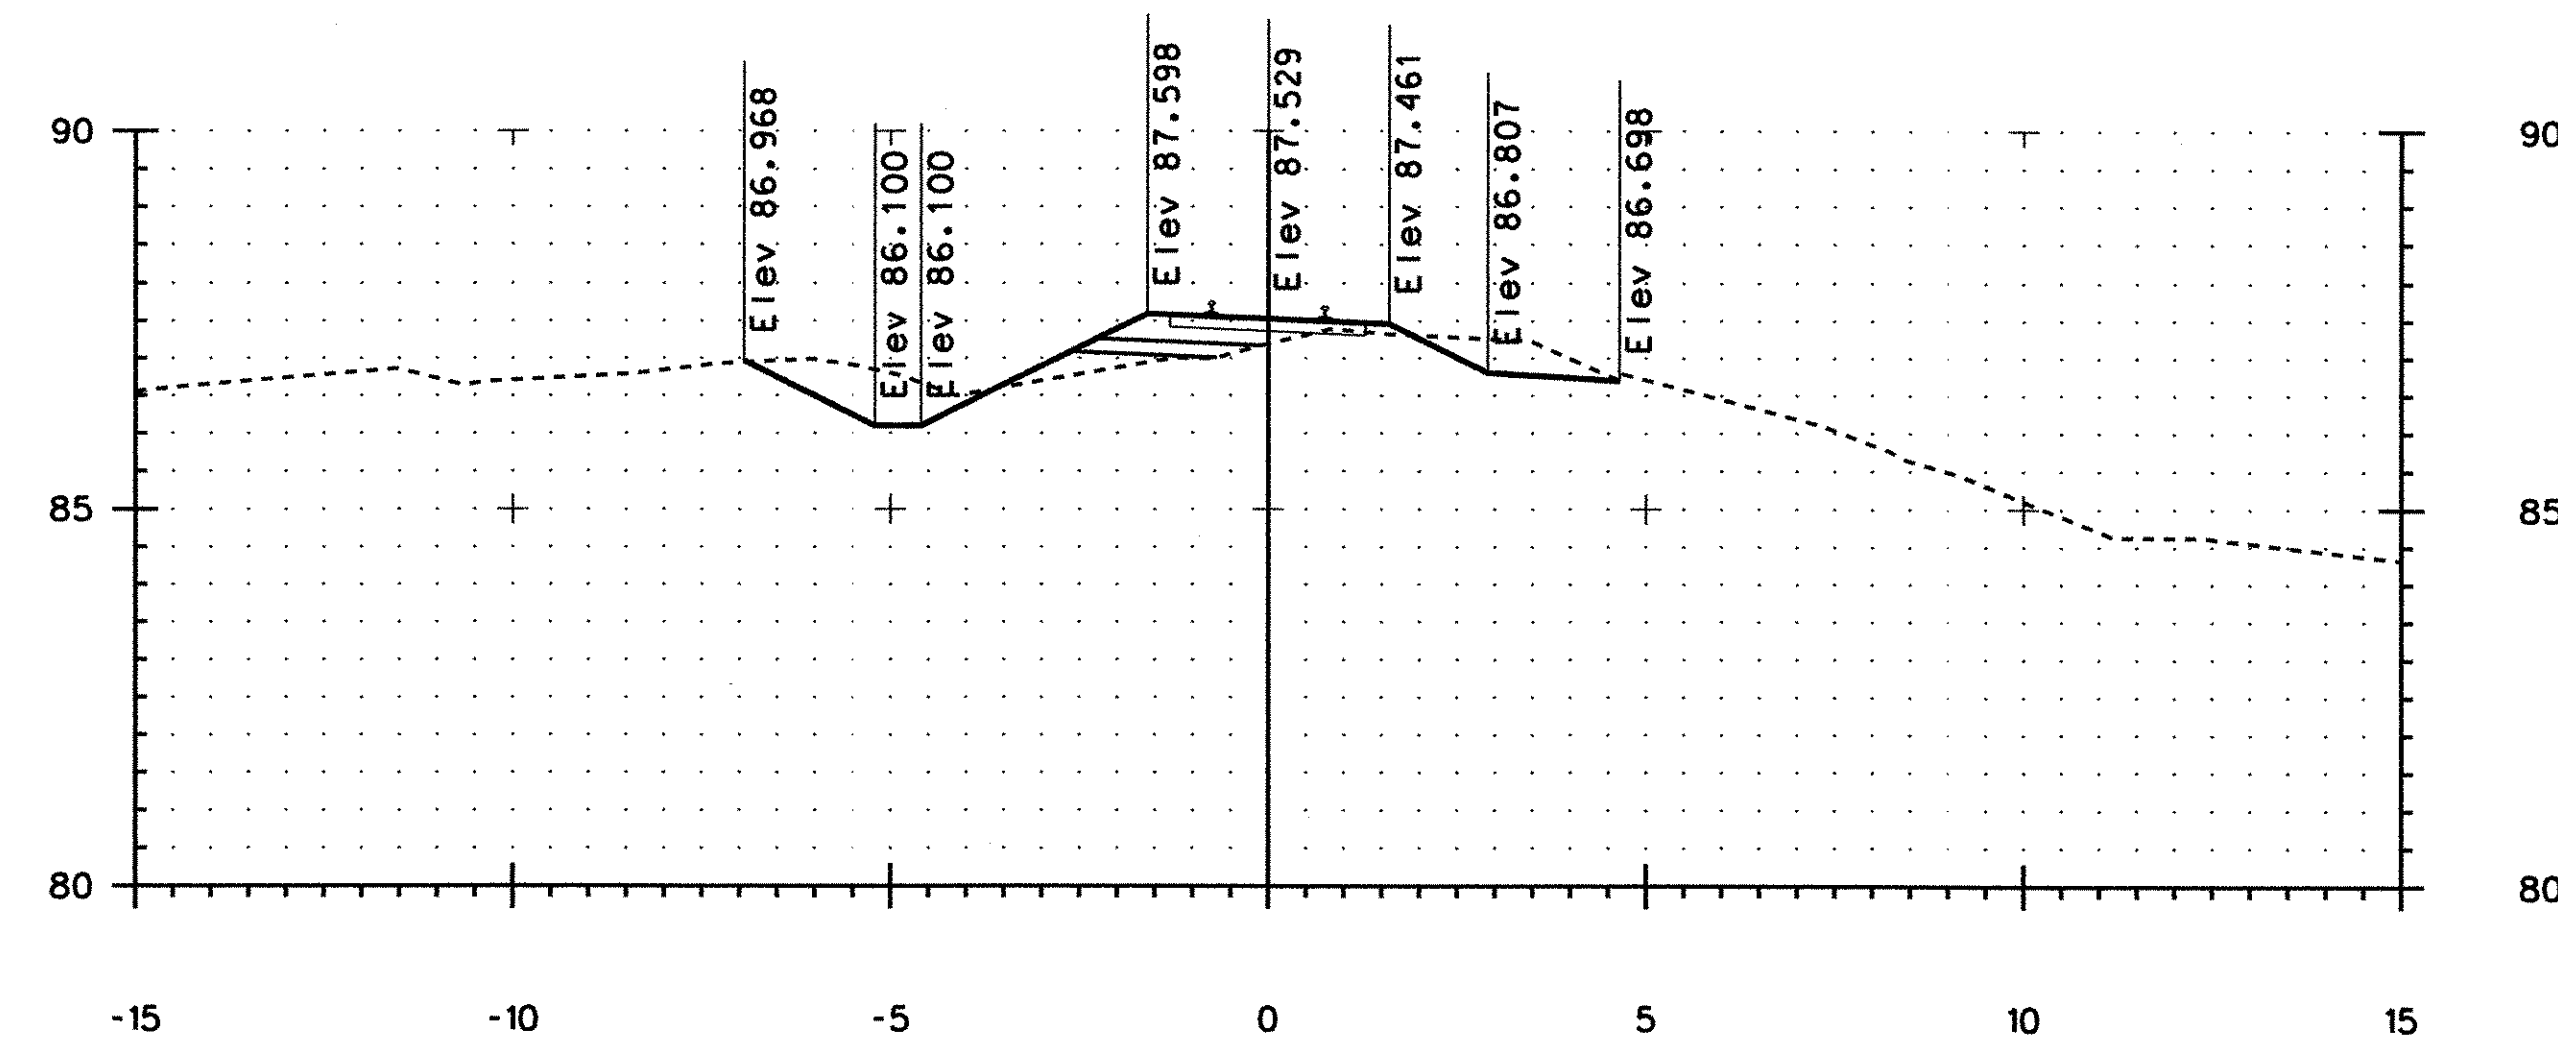

50+180.000

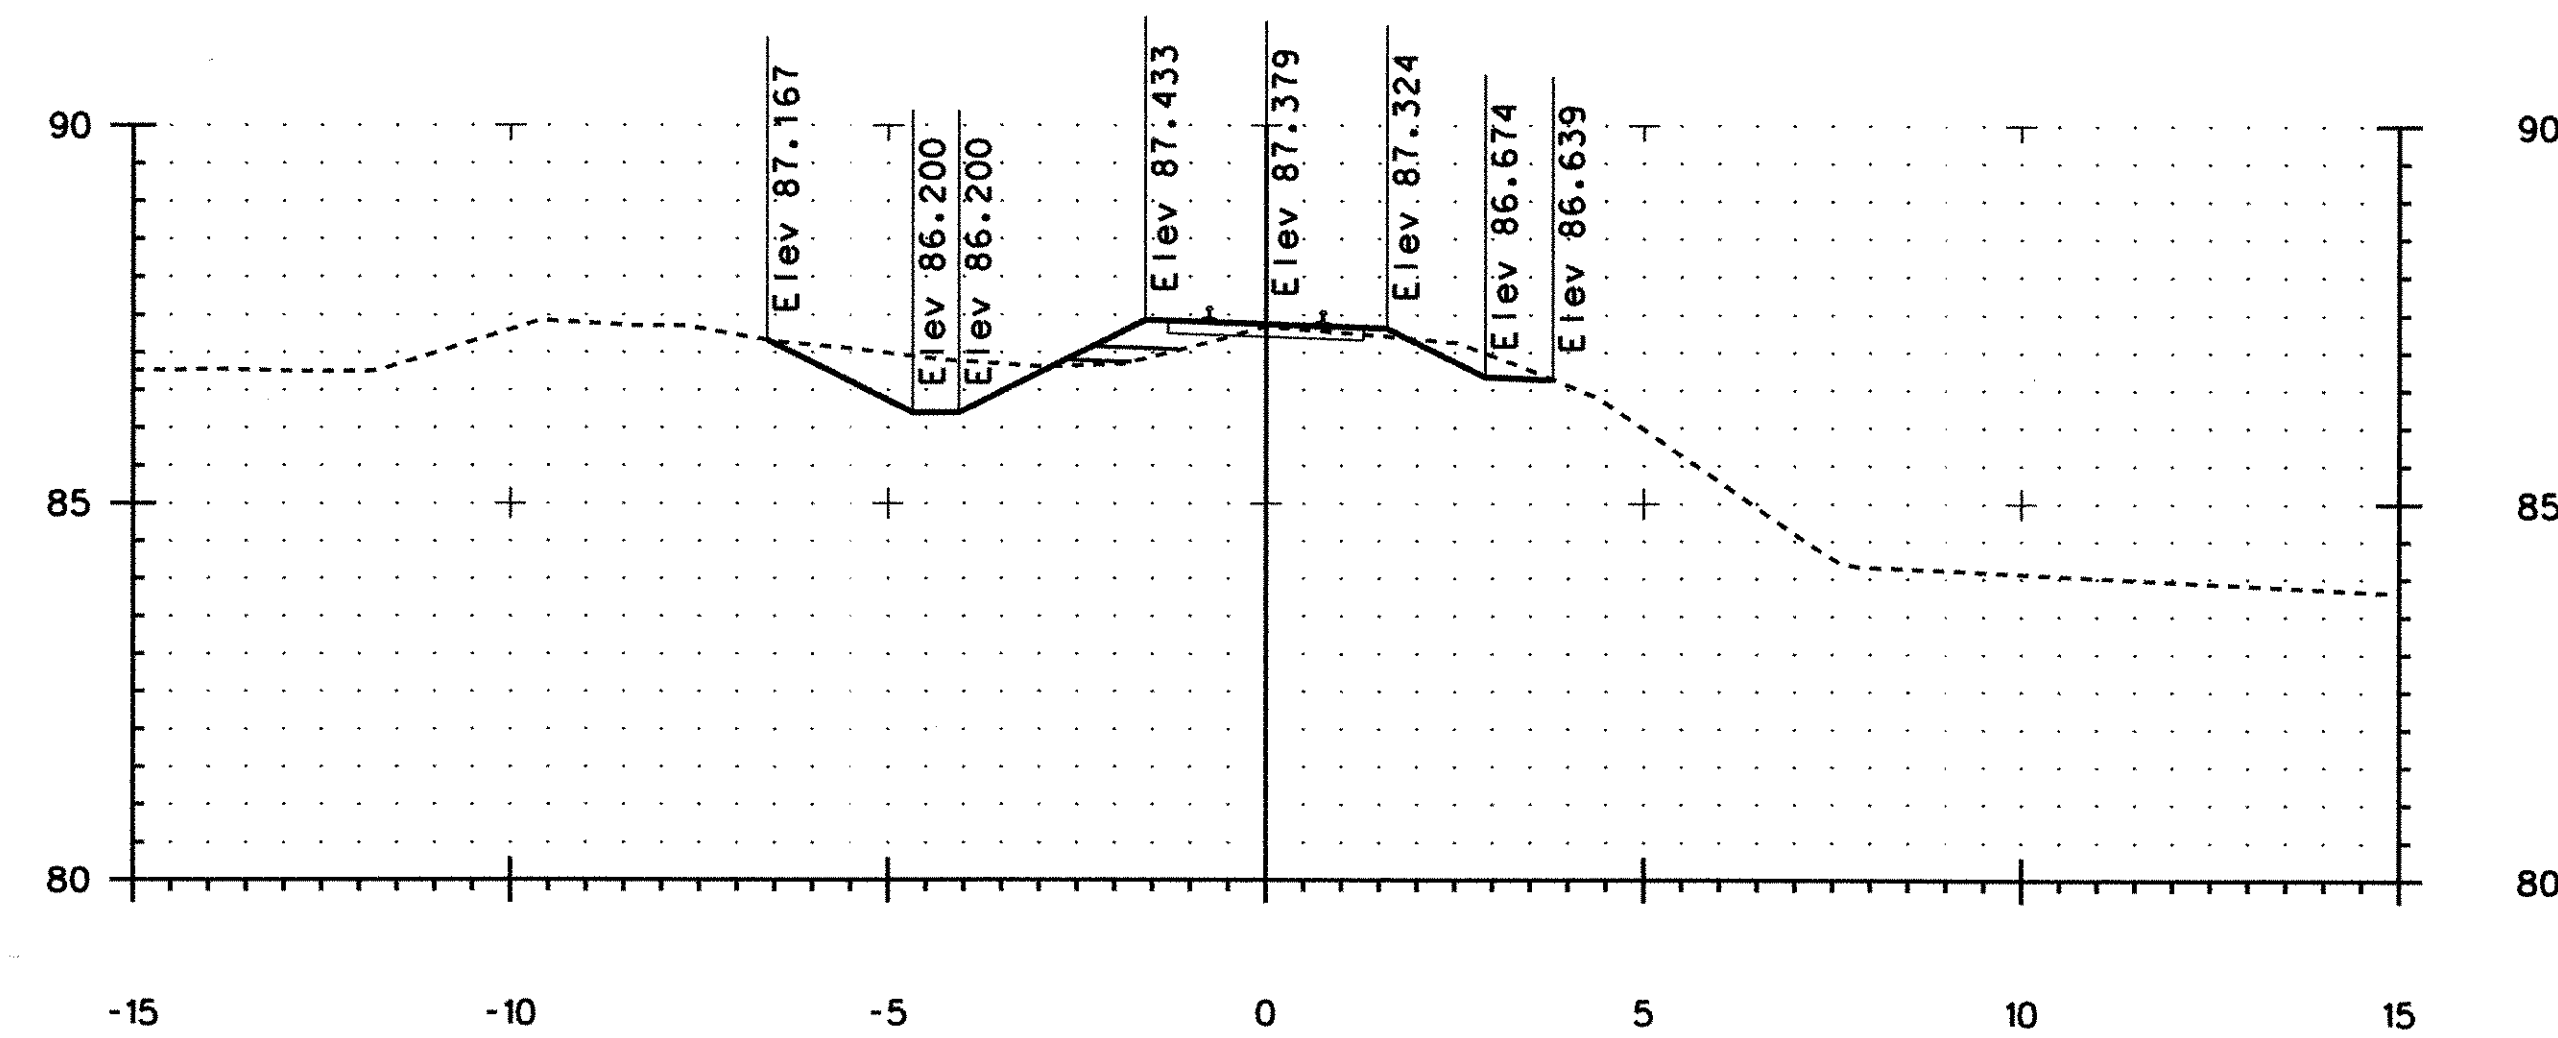

50+160.000

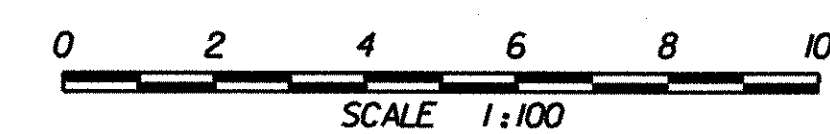

PROJECT: BRATTLEBORO		PROJECT NO.: NH 010-2(2)	
DESIGN FILE NAME: U:\99123-Brattleboro\dgn\zb270xs1.dgn		PLOT DATE: 7 AUG 2000	
IPARM FILE NAME:			
FROM STA: 50+160.000 TO STA: 50+180.000		SHEET: 120 OF 145	