



# RAILROAD CROSS SECTIONS

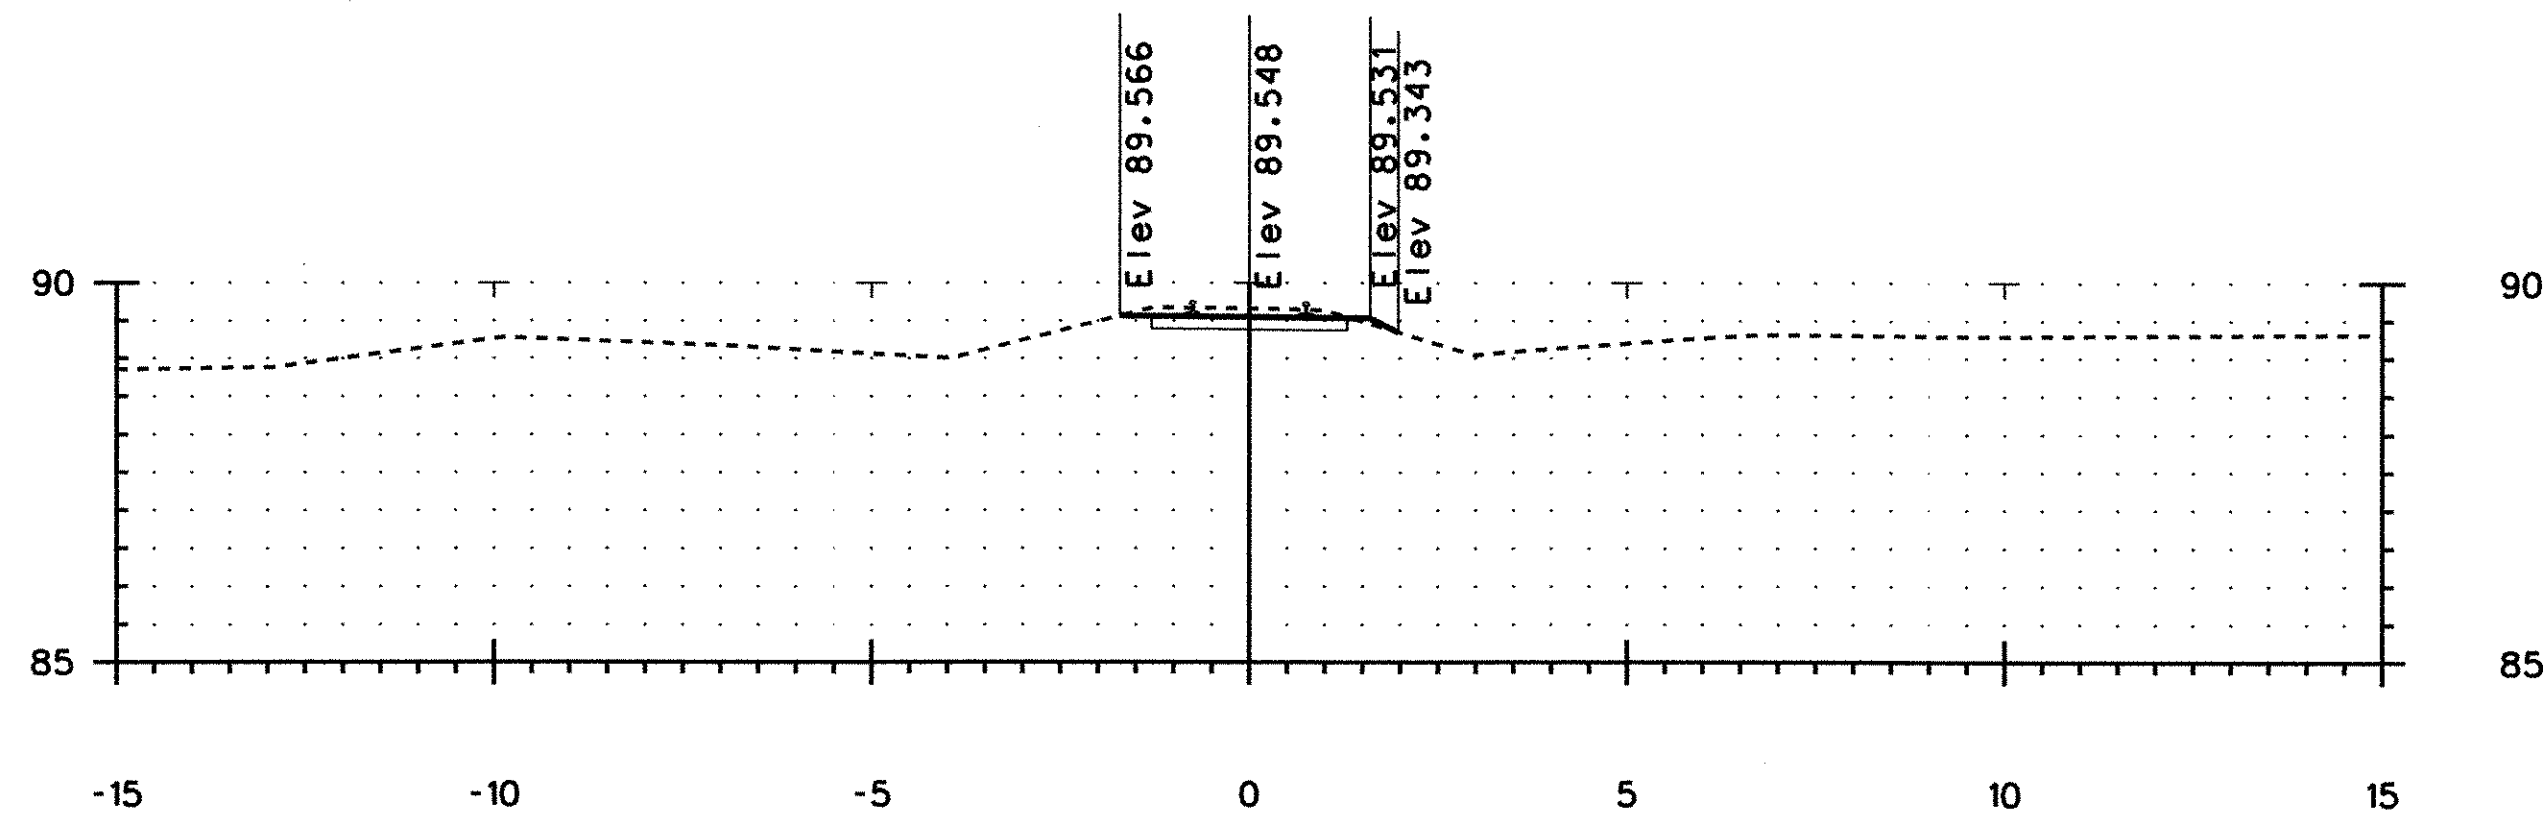

50+660.000

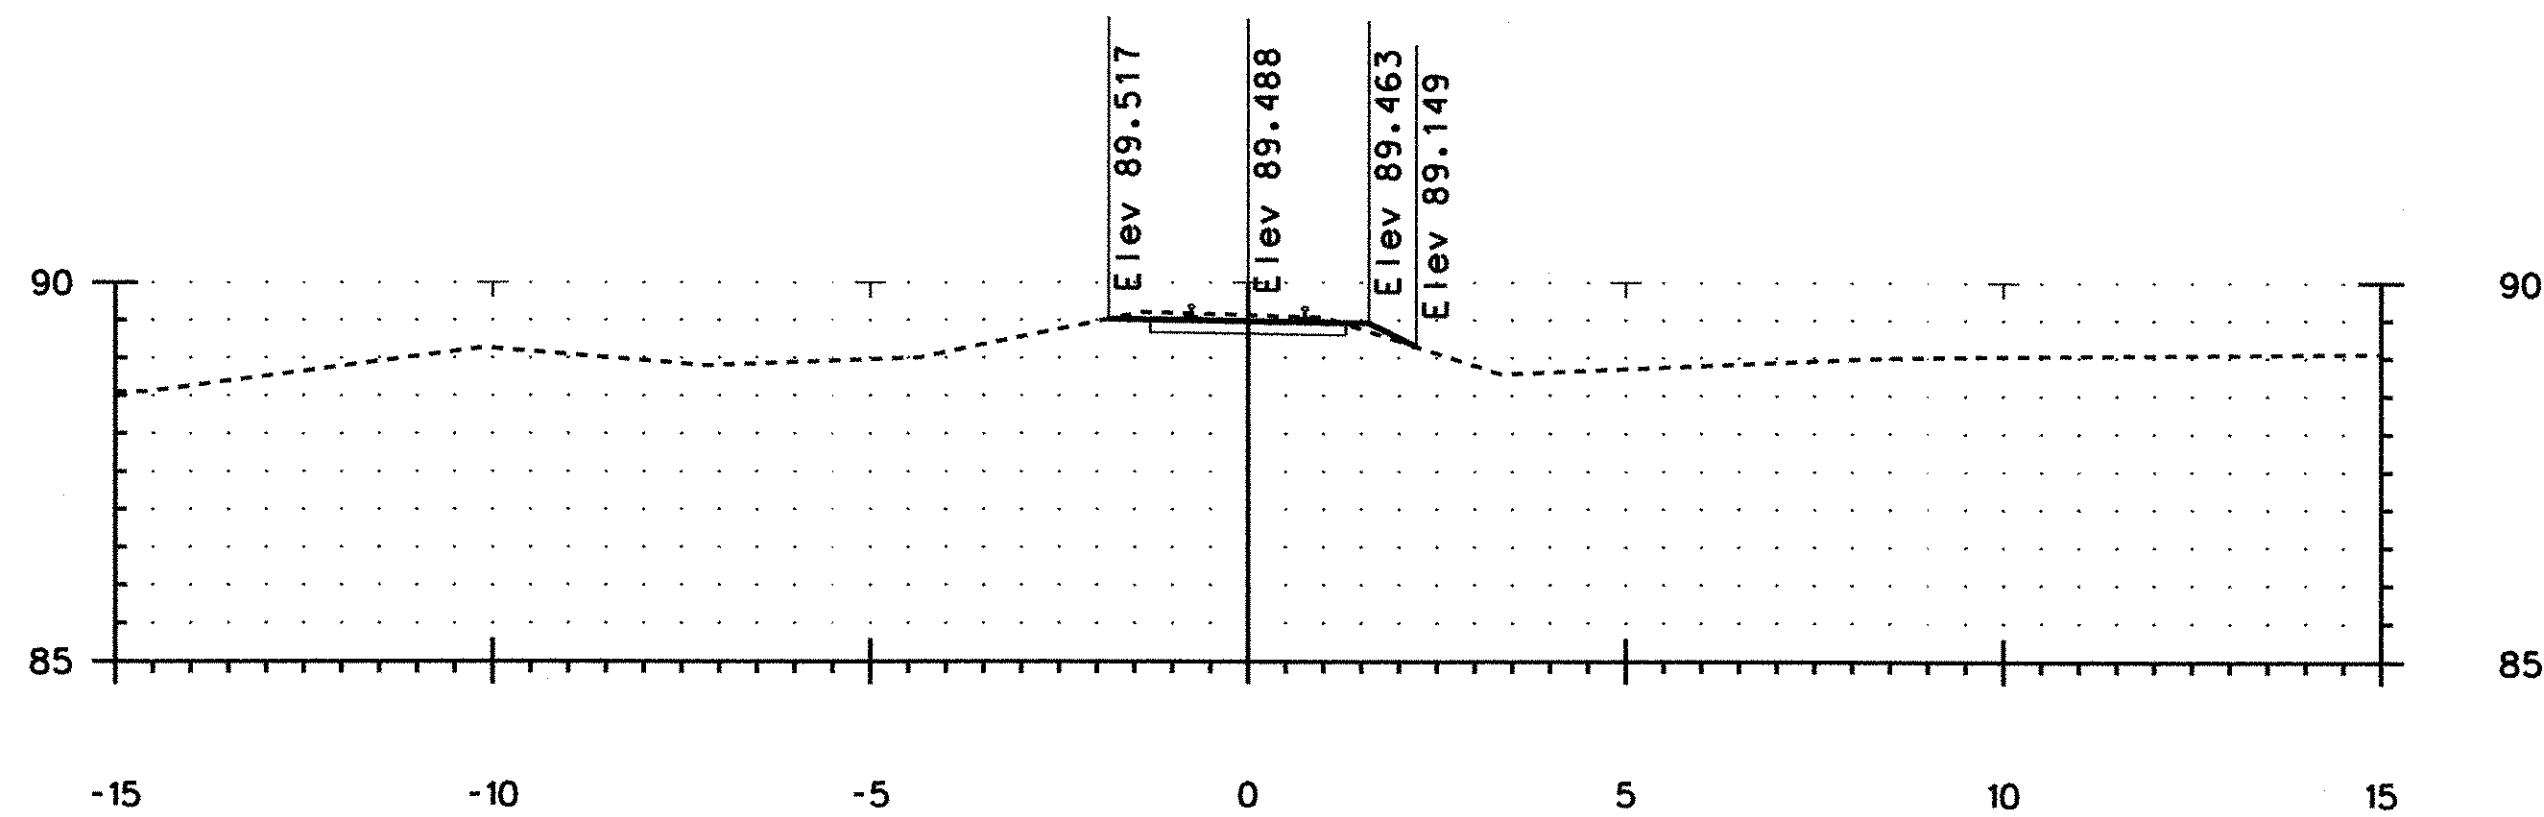

50+640.000



|                                                           |  |                          |  |
|-----------------------------------------------------------|--|--------------------------|--|
| PROJECT: BRATTLEBORO                                      |  | PROJECT NO.: NH 010-2(2) |  |
| DESIGN FILE NAME: U:\99123-Brattleboro\dgn\zb270xs1.dgn   |  | PLOT DATE: 10-02-2002    |  |
| IPARM FILE NAME:                                          |  |                          |  |
| FROM STA: 50+640.000 TO STA: 50+660.000 SHEET: 132 OF 145 |  |                          |  |