



SARGENT BROOK CROSS SECTIONS

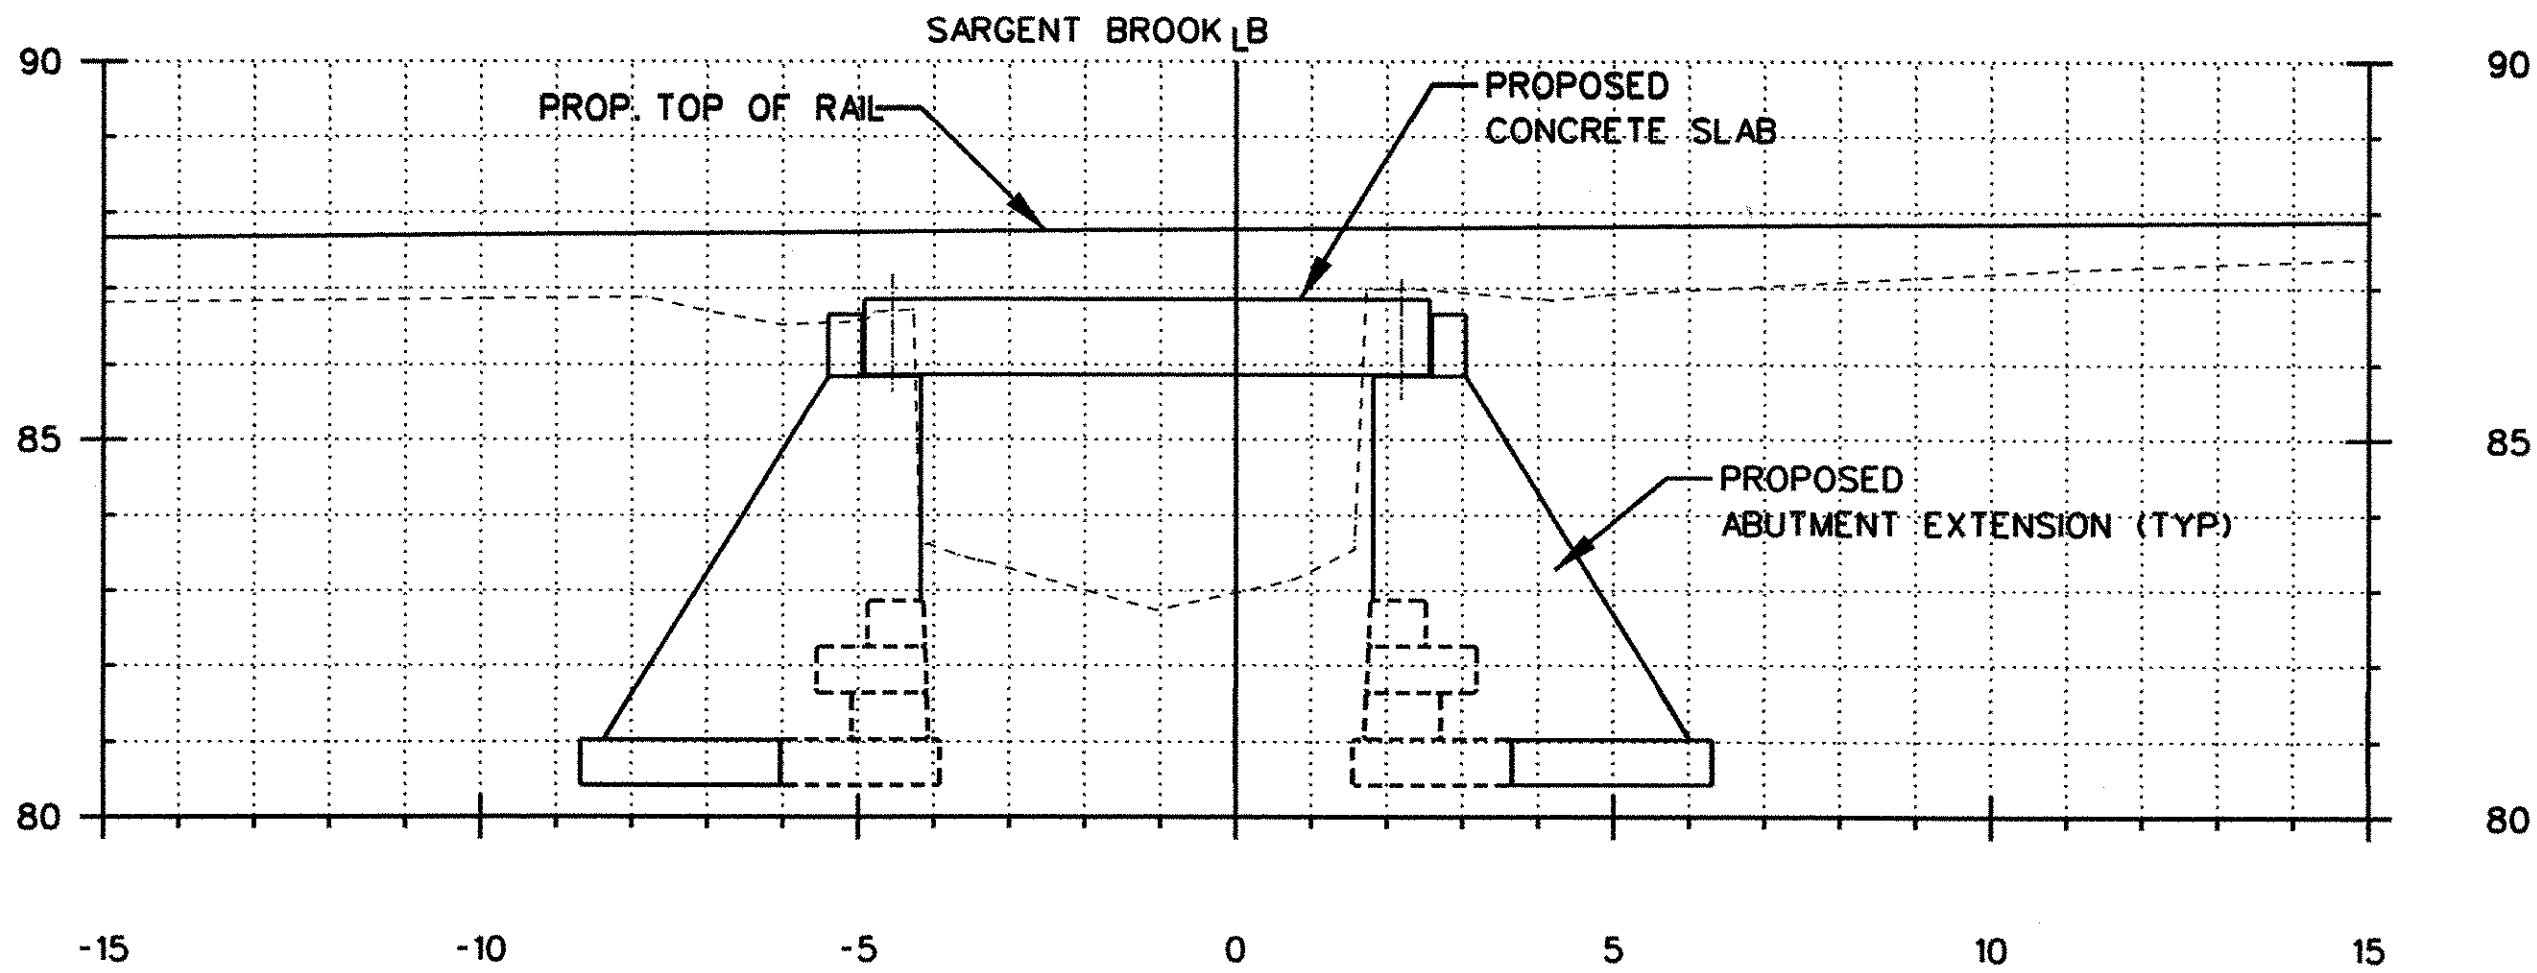

0+035.000

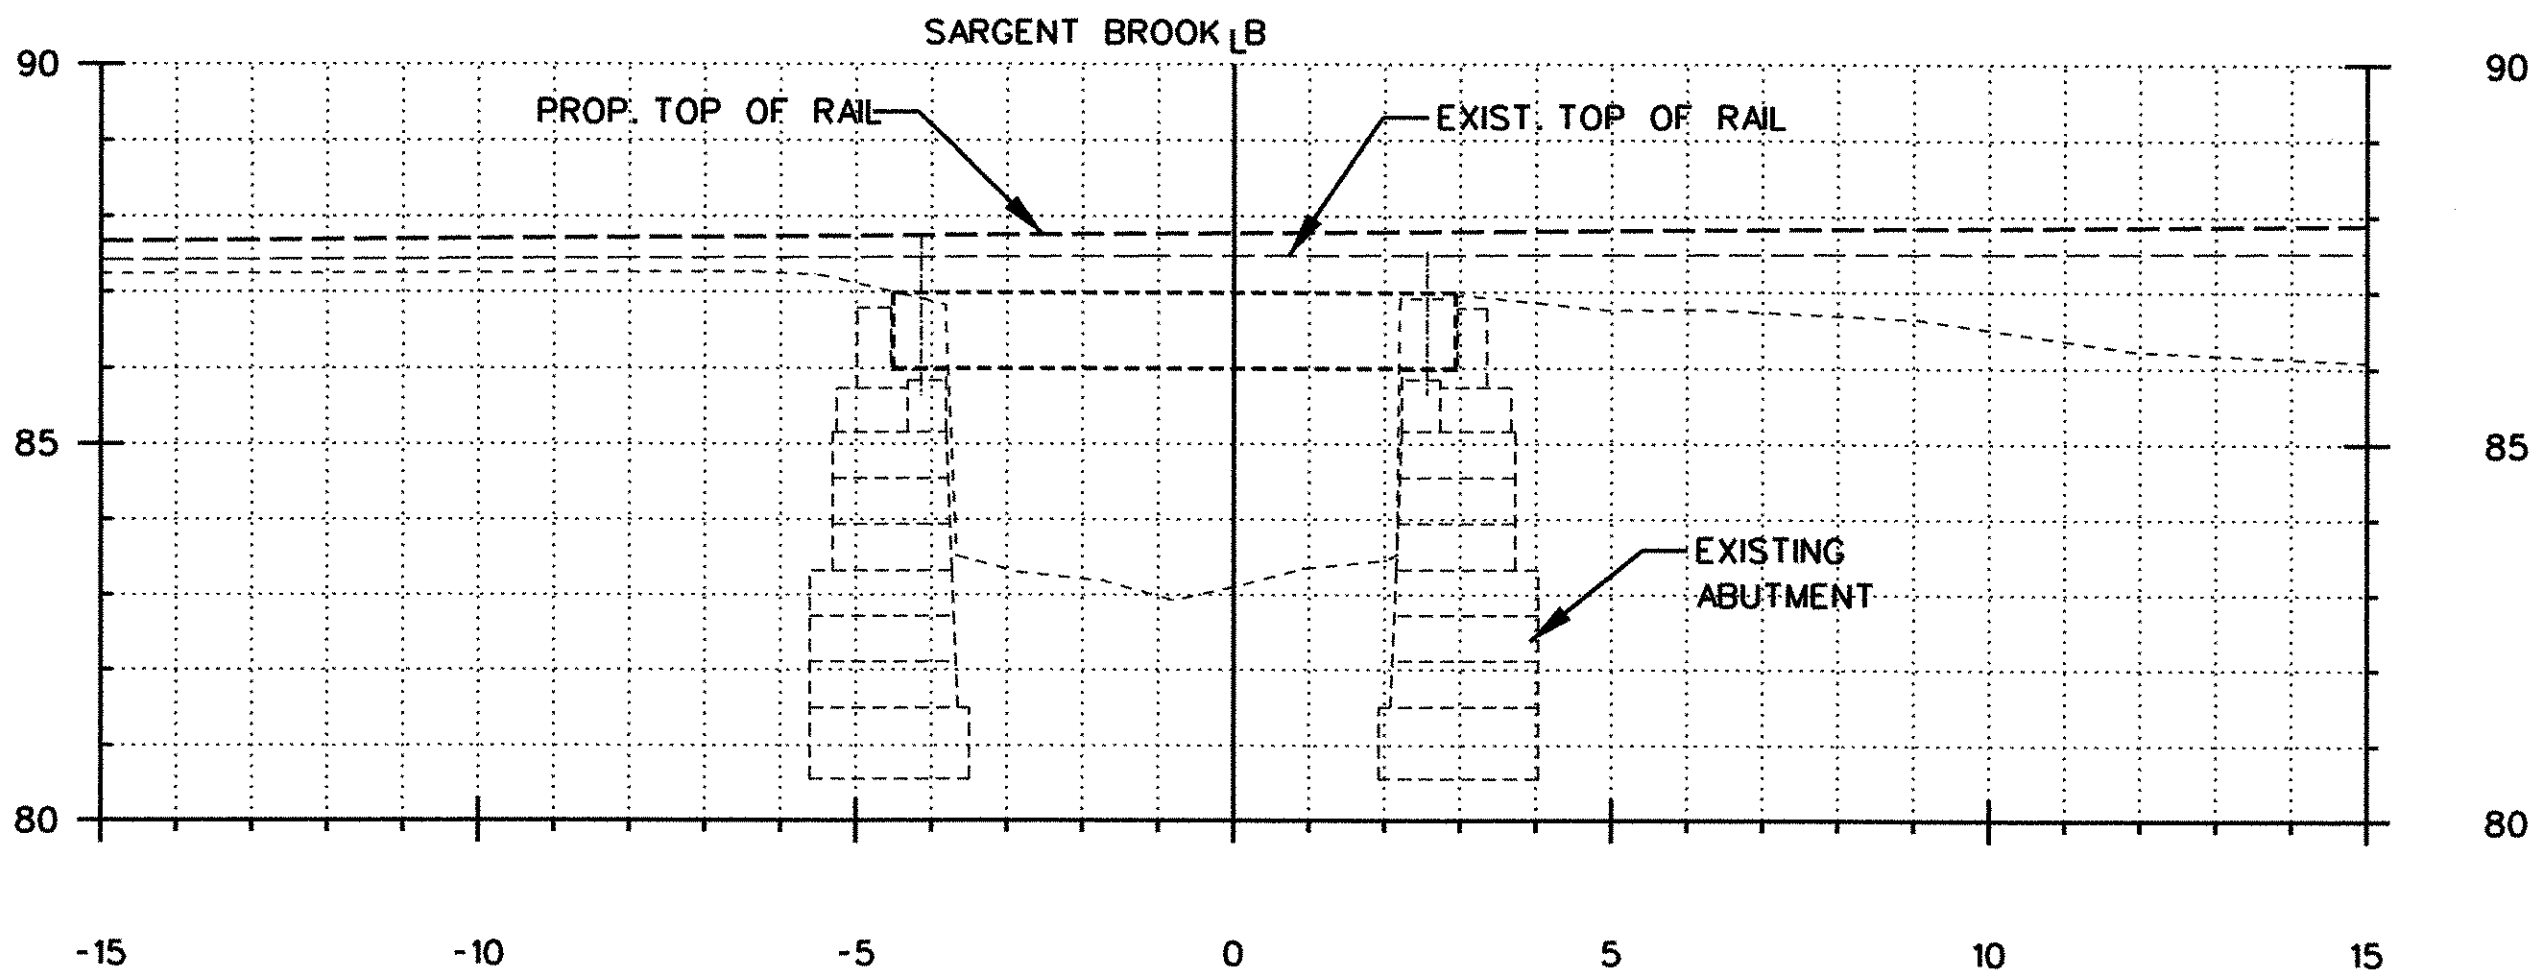

0+030.000



PROJECT: BRATTLEBORO		PROJECT NO. : NH 010-2(2)	
DESIGN FILE NAME: U:\99123-Brattleboro\dgn\zb270xs1.dgn		PLOT DATE: 10-02-2002	
IPARM FILE NAME:			
FROM STA: 0+030.000 TO STA: 0+035.000 SHEET: 135 OF 145			