



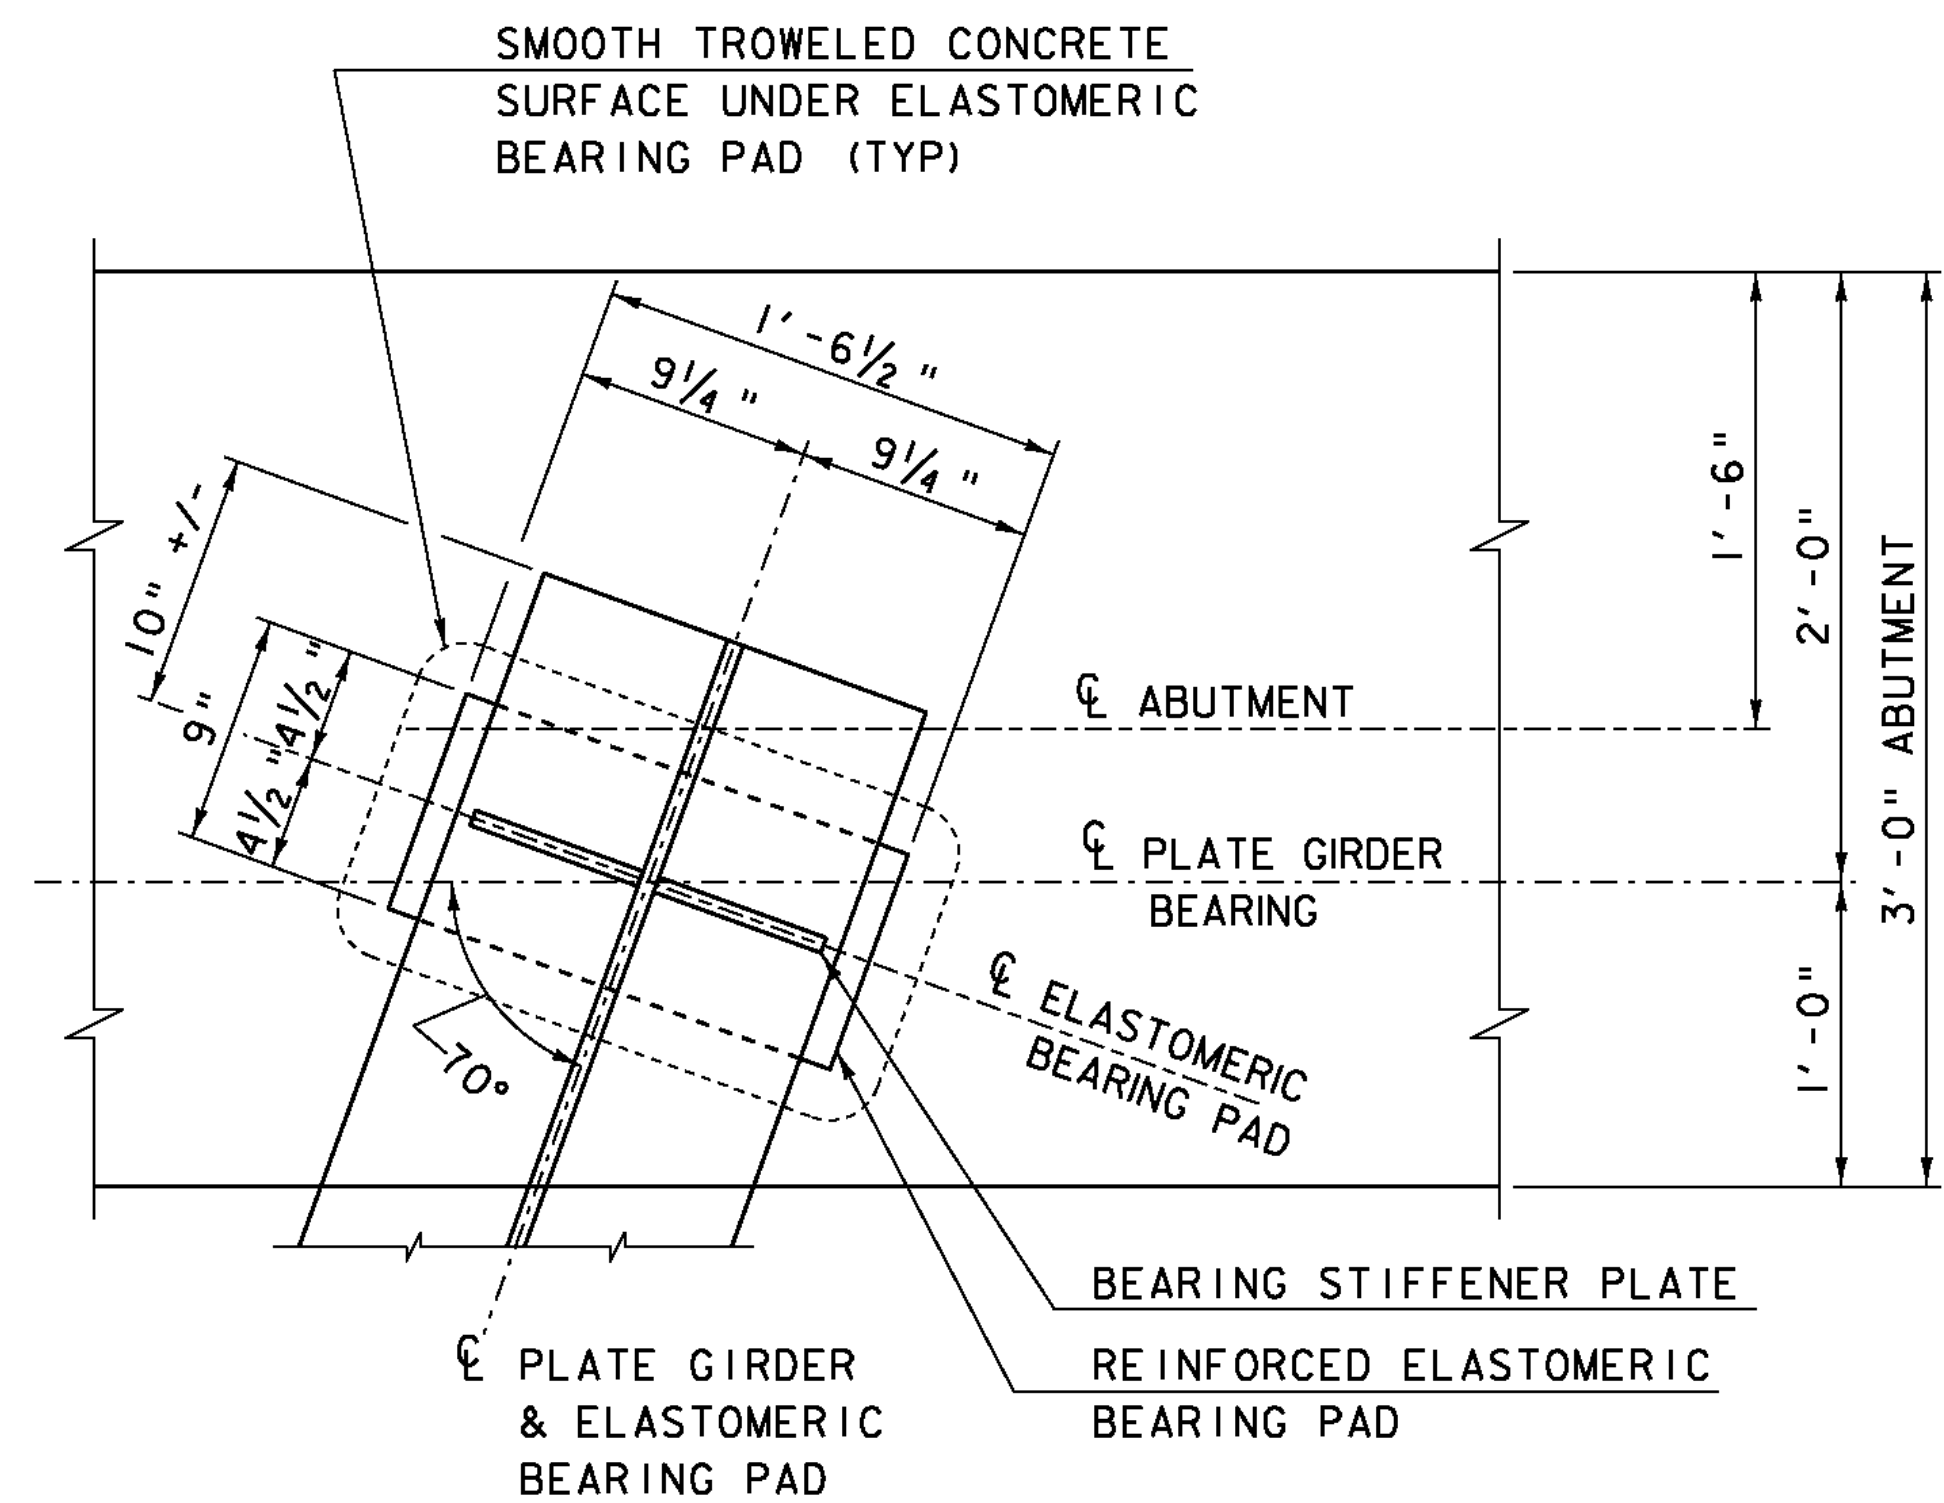


ABUTMENT 2 BEARING PLAN VIEW

SCALE 1/2" = 1'-0"

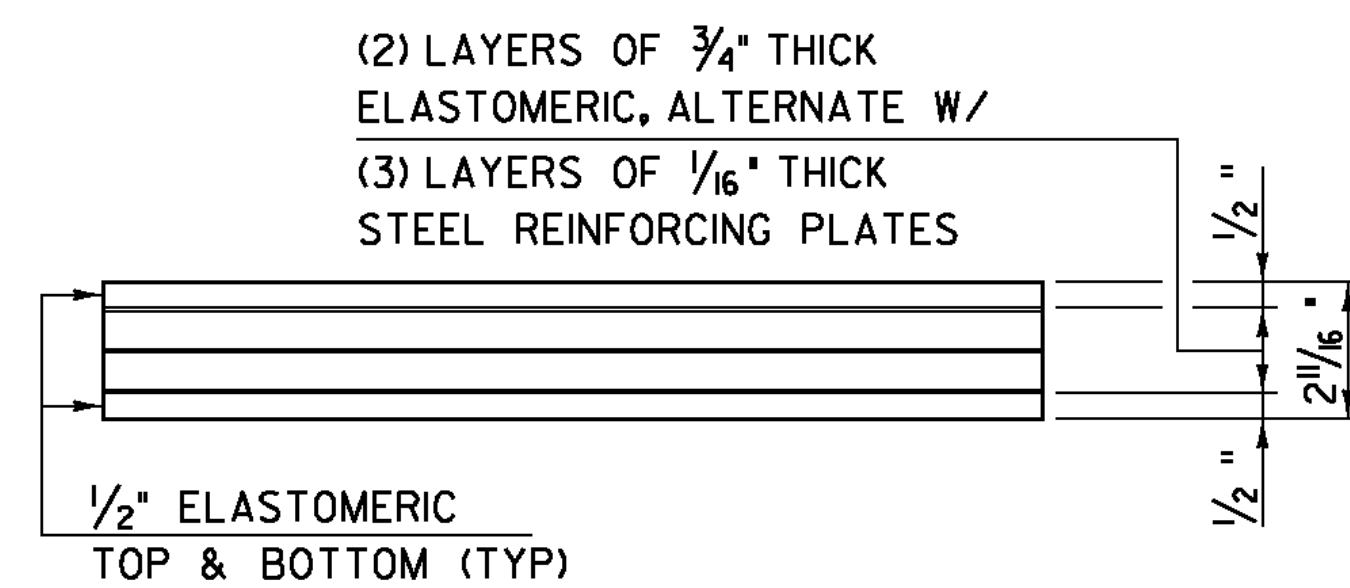

ABUTMENT 2
ELASTOMERIC BEARING MAKEUP

SCALE 3" = 1'-0"

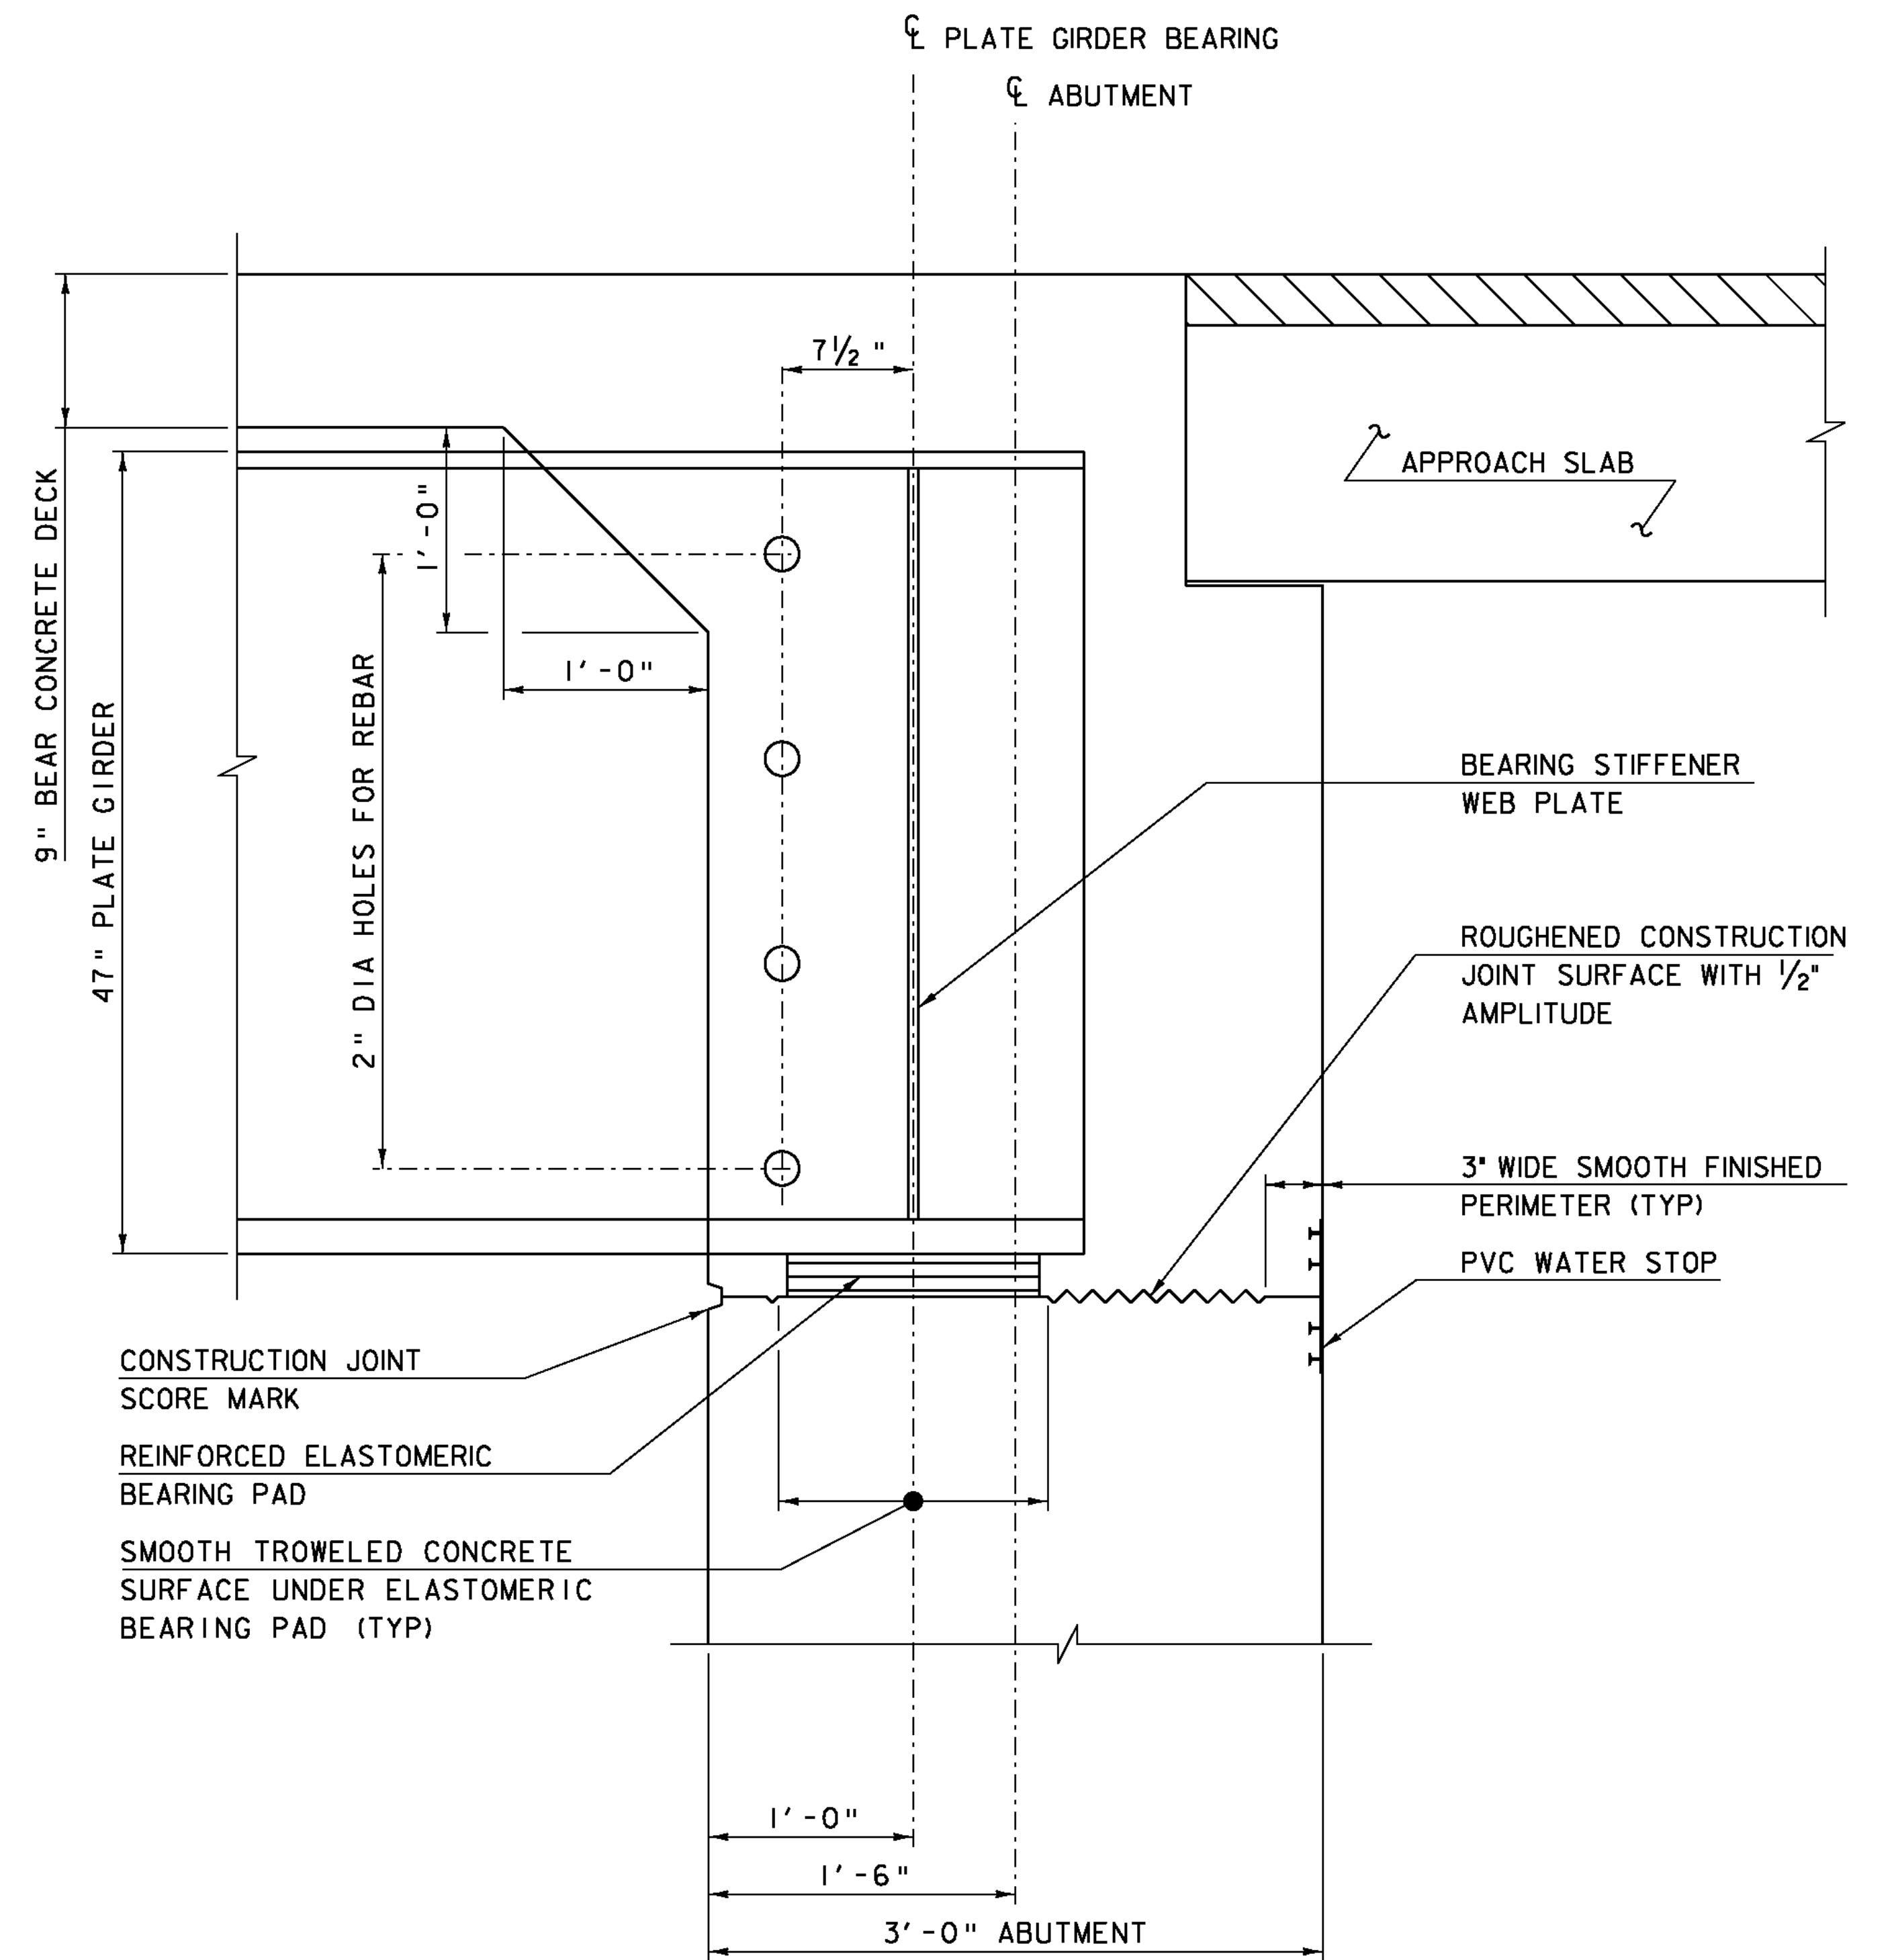

ABUTMENT 2 BEARING ELEVATION VIEW

SCALE 1/2" = 1'-0"

PROJECT NAME: BETHEL
PROJECT NUMBER: BHF 024I (30)

FILE NAME: s95c002brg.dgn
PROJECT LEADER: M. EVANS-MONGEON
DESIGNED BY: U. STANLEY
ABUTMENT 2 BEARING DETAILS

PLOT DATE: 31-AUG-2011
DRAWN BY: M. LONGSTREET
CHECKED BY: U. STANLEY
SHEET 47 OF 64