



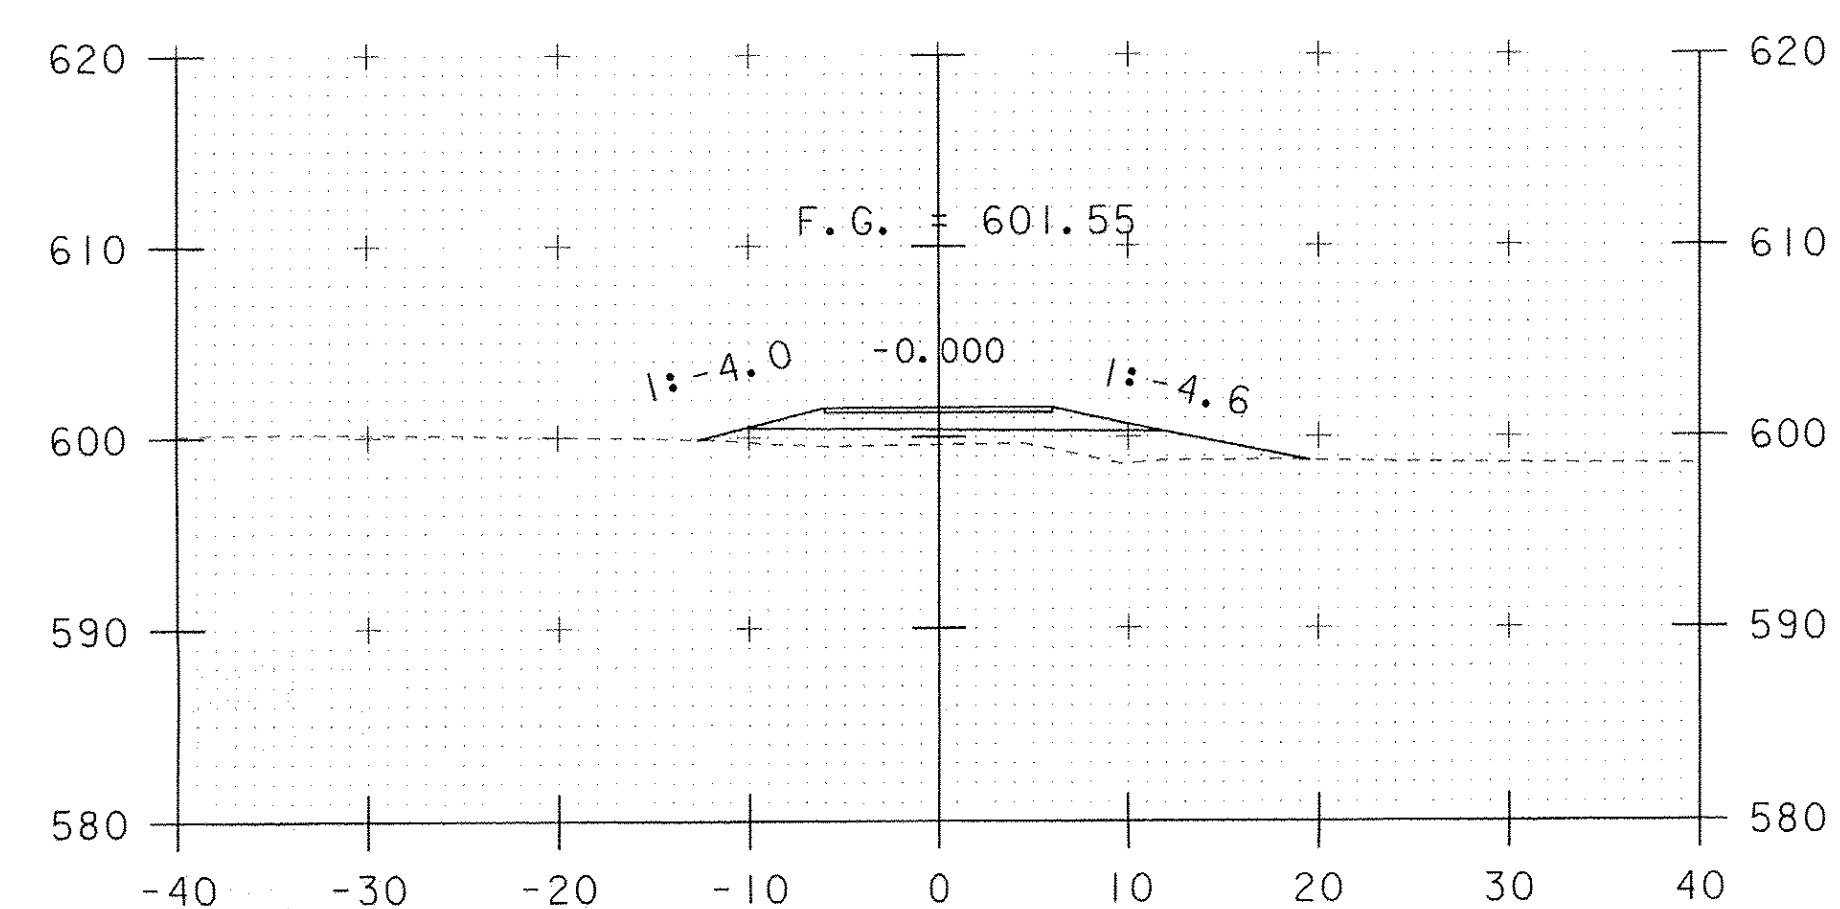

SHOULDER VT ROUTE 12
SEE MAINLINE SECTIONS
STA. 103+50.00

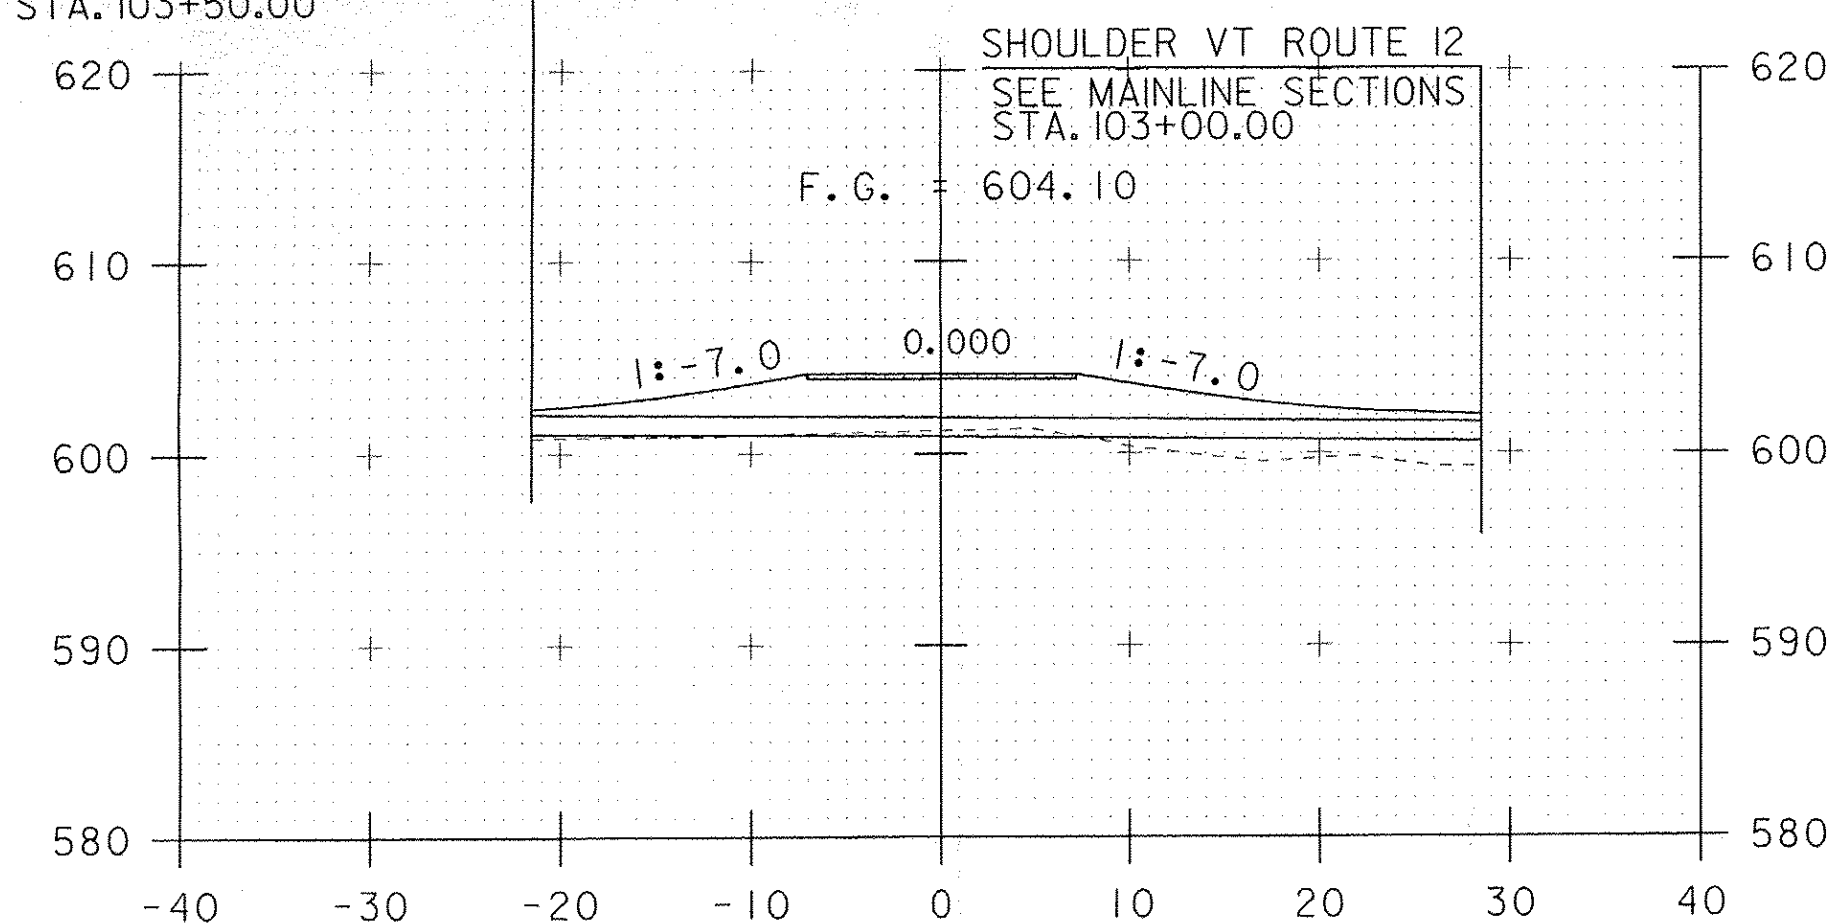

SHOULDER VT ROUTE 12
SEE MAINLINE SECTIONS
STA. 103+00.00

PROJECT NAME: BETHEL
PROJECT NUMBER: BHF 0241(30)

FILE NAME: sc002xs.dgn
PROJECT LEADER: M. EVANS-MONGEON
DESIGNED BY: U. STANLEY
DRIVE SECTIONS AT 103+28.50 RT

PLOT DATE: 31-AUG-2011
DRAWN BY: U. STANLEY
CHECKED BY: G. ROKES
SHEET 62 OF 64