

TEMPORARY AND DURABLE 4" YELLOW LINE

STA. 24+00 TO 27+46 SOLID LT & RT
STA. 24+68 DOUBLE SOLID RT (RAMP B)
(WITH EDGE LINE BREAKS FOR STREETS,
TOWN HIGHWAYS & CROSSWALKS)

TEMPORARY AND DURABLE 4" WHITE LINE

STA. 24+00 TO 27+46 SOLID LT & RT
STA. 24+68 SOLID RT (RAMP B)
(WITH EDGE LINE BREAKS FOR STREETS,
TOWN HIGHWAYS & CROSSWALKS)

TEMPORARY & DURABLE 24" STOP BAR


STA. 24+68 RT (RAMP B)

TEMPORARY & DURABLE LETTERS OR SYMBOL

STA. 24+68 RT "STOP"

REMOVING SIGNS

AS SHOWN - 4

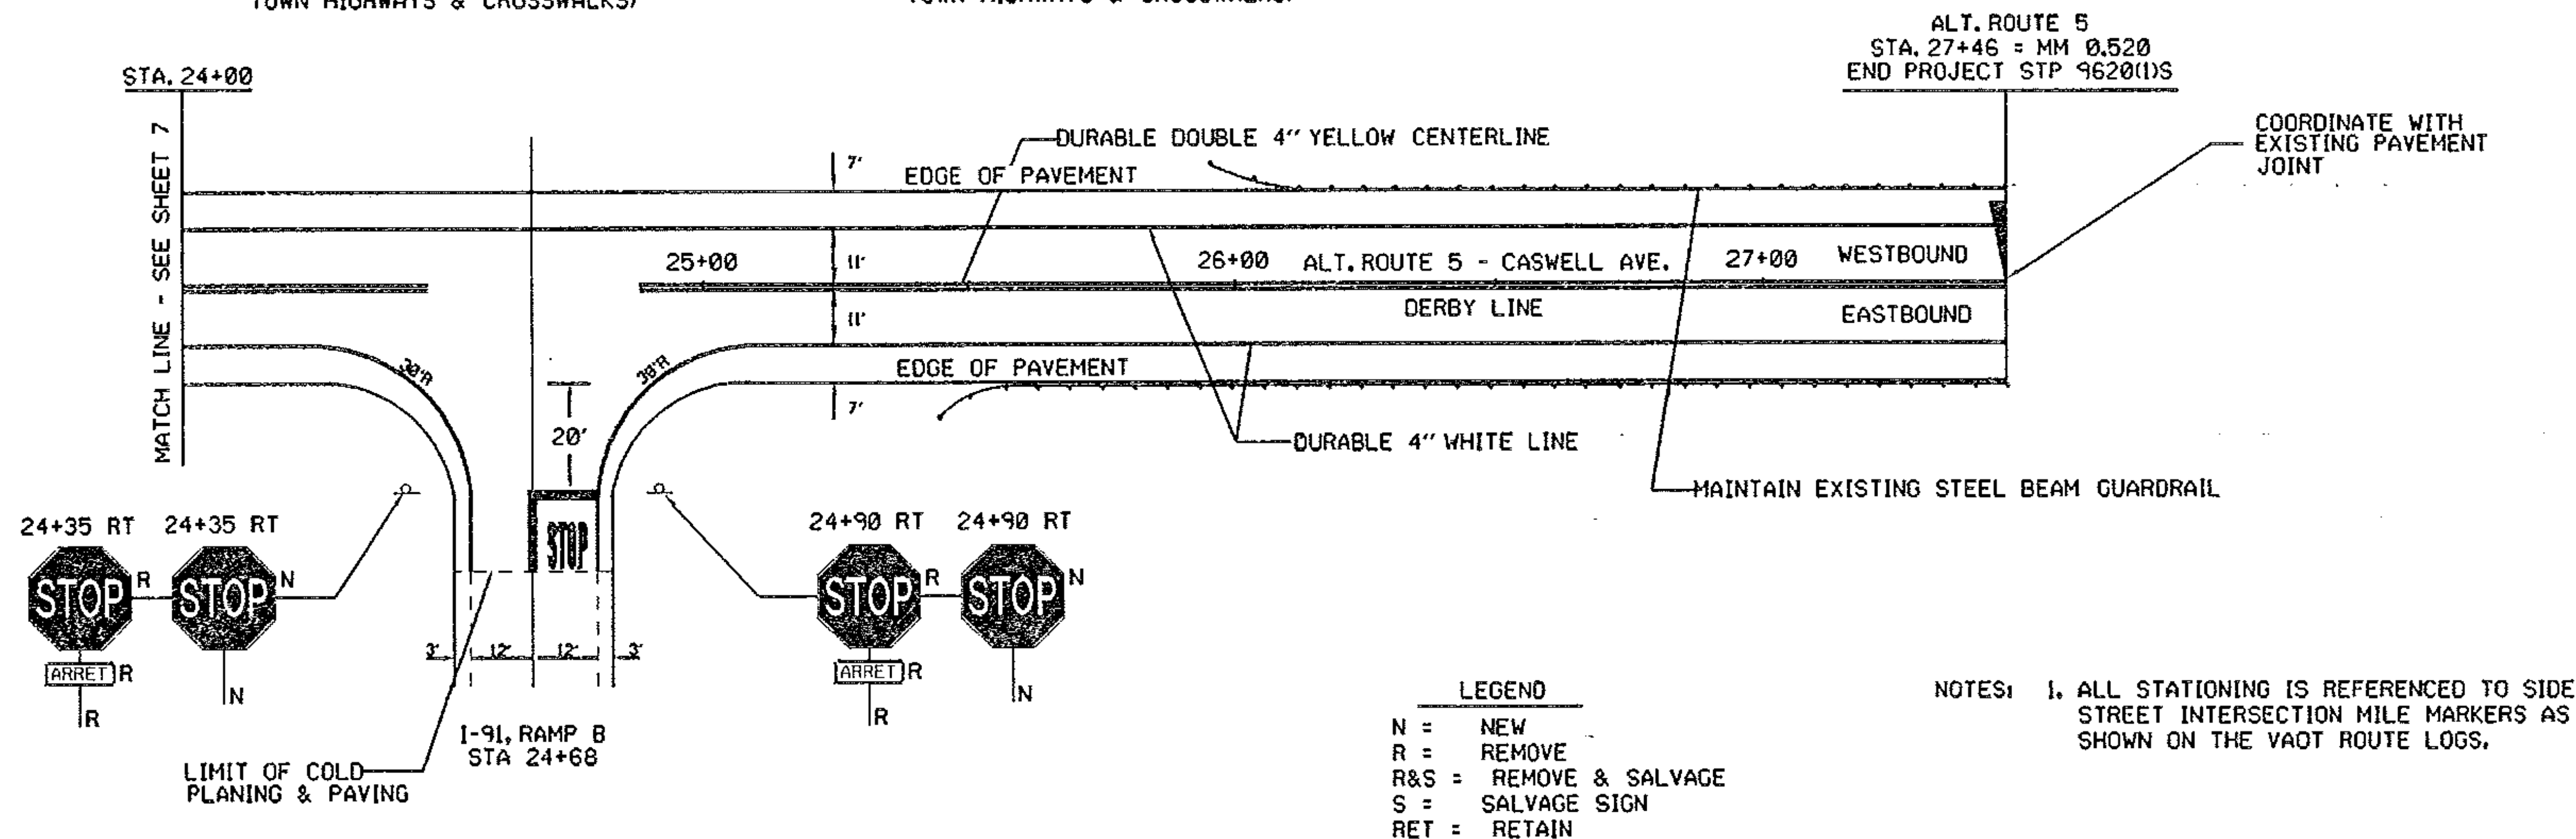

DATUM
VERTICAL N/A
HORIZONTAL N/A

PAVING PROJECT LAYOUT

DESIGNED BY BCE/HJW DATE 1-96
DRAWN BY C.E.A., INC. DATE 1-96
DESIGN FILE NO. /pave/95c054/pc054.dgn
PRF FILE pc05413.1 DATE PLOTTED 3-APR-1996
PROJ. NAME DERBY LINE
PROJ. NO. STP 9620(1)S
SHEET 8 OF 12 SHEETS