

STATE OF VERMONT AGENCY OF TRANSPORTATION





PROPOSED IMPROVEMENT CLASS I TOWN HIGHWAY VILLAGE OF NORTH BENNINGTON COUNTY OF BENNINGTON VT. ROUTE 67A

BEGINNING AT MILE MARKER 2.134 = STA. 3+434.340 AND EXTENDING NORTHERLY
ALONG VT. ROUTE 67A FOR A DISTANCE OF 1903.854 m (1.183 MILES) TO MILE MARKER
3.317 = STA. 5+338.194

LENGTH OF ROADWAY 1903.854 m (1.183 MILES)
LENGTH OF PROJECT 1903.854 m (1.183 MILES)

WORK TO BE PERFORMED UNDER THIS PROJECT INCLUDES COLD PLANING, RESURFACING WITH A SHIM / LEVELING COURSE
AND WEARING COURSE, SHOULDER RECONSTRUCTION, NEW SIDEWALK AND CURB, NEW RETAINING WALL CONSTRUCTION,
NEW PAVEMENT MARKINGS, NEW SIGNS, DRAINAGE IMPROVEMENTS AND INCIDENTAL ITEMS.

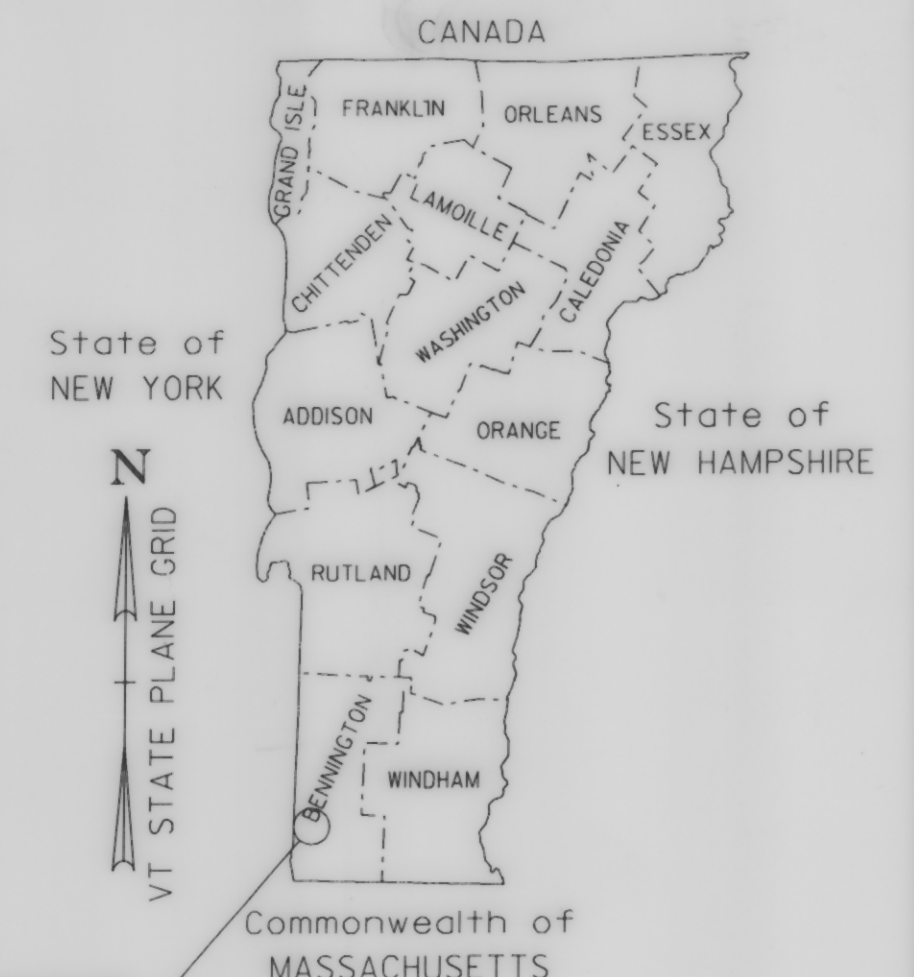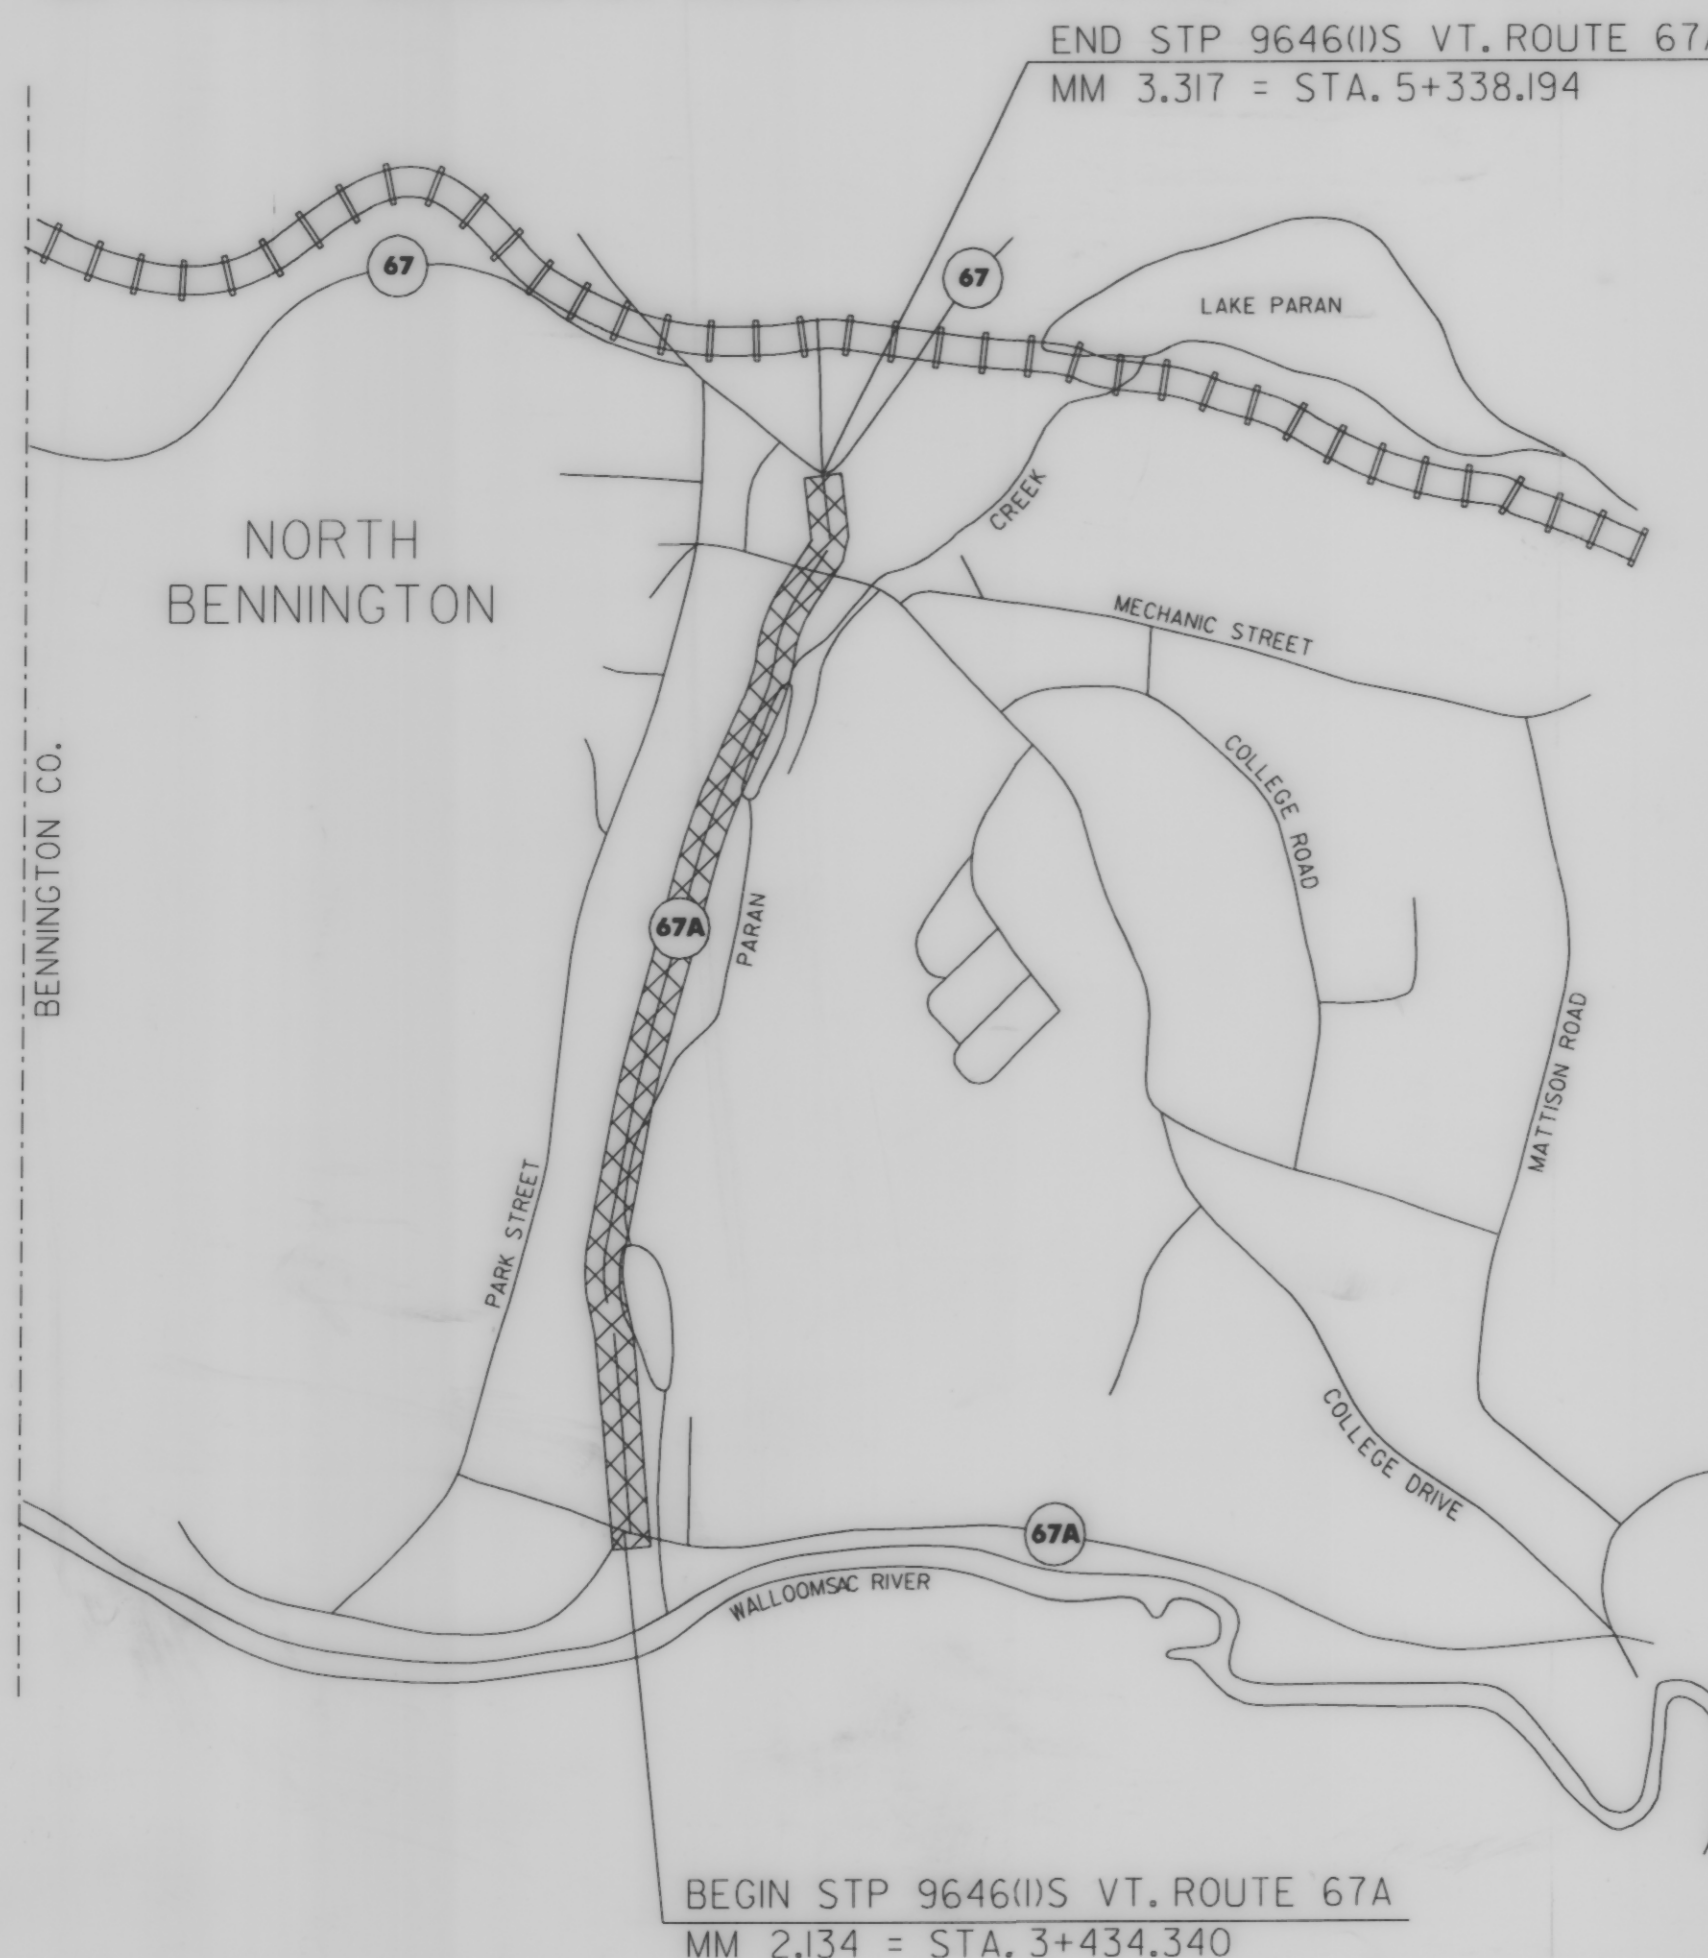

PROJECT LOCATION
STP 9646(1)S

TRAFFIC DATA

VT. ROUTE 67A:
(BEGIN PROJECT TO MM 3.224)

2004 ADT = 6700
2004 DHV = 750
2014 ADT = 7100
2014 DHV = 790

2004 ~ 2014 CUM. ESALS = 768,000
2004 ~ 2014 CUM. ESALS = 1,771,000

VT. ROUTE 67A:
(MM 3.224 TO END PROJECT)

2004 ADT = 7300
2004 DHV = 810
2014 ADT = 7800
2014 DHV = 860

2004 ~ 2014 CUM. ESALS = 841,000
2004 ~ 2014 CUM. ESALS = 1,947,000

BITUMINOUS CONCRETE PAVEMENT SUPERPAVE MIXTURE DESIGN CRITERIA

DESIGN LANE / DESIGN LIFE ESAL	973,500
DESIGN NUMBER OF GYRATIONS	75
PERFORMANCE GRADED ASPHALT BINDER	PG 64-28

RECORD PLANS	
CONTRACTOR:	PETRICCA CONSTRUCTION CO. - PITTSFIELD, MA
RESIDENT ENGINEER:	RON LEMAIRE
CONSTRUCTION BEGAN:	JULY 16, 2006
CONSTRUCTION COMPLETE:	JUNE 14, 2007
RECORD PLANS BY:	RON LEMAIRE & JUDY GILMORE
I HEREBY CERTIFY THAT ALL THE CONSTRUCTION REQUIRED BY THIS SET OF DRAWINGS HAS BEEN ACCOMPLISHED AS INDICATED HEREIN.	
BY	RESIDENT ENGINEER
DATE	01/30/08
NOTE: Any further information concerning final quantities, amounts or other details relative to this project may be found in Central Files in the electronic archives.	



PLANS PREPARED BY



CLOUGH HARBOUR & ASSOCIATES LLP
111 Winners Circle, PO Box 5269, Albany, NY 12205
www.cloughharbour.com

BY *Dale E. Gozalkowski*

SURVEYED BY : L.R.S.C.
SURVEYED DATE : 4/2003

DATUM
VERTICAL N/A
HORIZONTAL NAD 83 (1996)

CONVENTIONAL SIGNS

COUNTY LINE	---
TOWN LINE	---
LIMITS OF ACCESS	---X---
POINT OF ACCESS	X
FENCE LINE	---X---
STONE WALL	---
TRAVELED WAY	---
GUARD RAIL	---
RAILROAD	---
SURVEY LINE	---
CULVERT	---
POWER POLE	---
TELEPHONE POLE	---
TREES	---
CONTROL OF ACCESS	---
PROPERTY LINE	---
R.O.W. TAKING LINE	---
SLOPE RIGHTS	---
TOP OF CUT	---
TOE OF SLOPE	---

THESE PLANS ARE SUBJECT TO SUCH ENGINEERING
CHANGES AS MAY BE REQUIRED BY THE FEDERAL HIGHWAY
ADMINISTRATION OR THE DIRECTOR OF PROGRAM
DEVELOPMENT.

CONSTRUCTION IS TO BE CARRIED ON IN ACCORDANCE
WITH THESE PLANS AND THE STANDARD SPECIFICATIONS
FOR CONSTRUCTION DATED 2001, AS APPROVED BY THE
FEDERAL HIGHWAY ADMINISTRATION ON JANUARY 4, 2001
FOR USE ON THIS PROJECT, INCLUDING ALL SUBSEQUENT
REVISIONS AND SUCH REVISED SPECIFICATIONS AND
SPECIAL PROVISIONS AS ARE INCORPORATED IN THESE
PLANS.



UNLESS NOTED OTHERWISE
STATIONS ARE IN KILOMETERS
ELEVATIONS ARE IN METERS
DIMENSIONS ARE IN MILLIMETERS

DIRECTOR OF PROGRAM DEVELOPMENT

APPROVED *Rubal Johnson* DATE 4-21-06

PROJECT MANAGER :

PROJECT NAME : NORTH BENNINGTON
PROJECT NUMBER : STP 9646 (1) S

SHEET 1 OF 151 SHEETS