

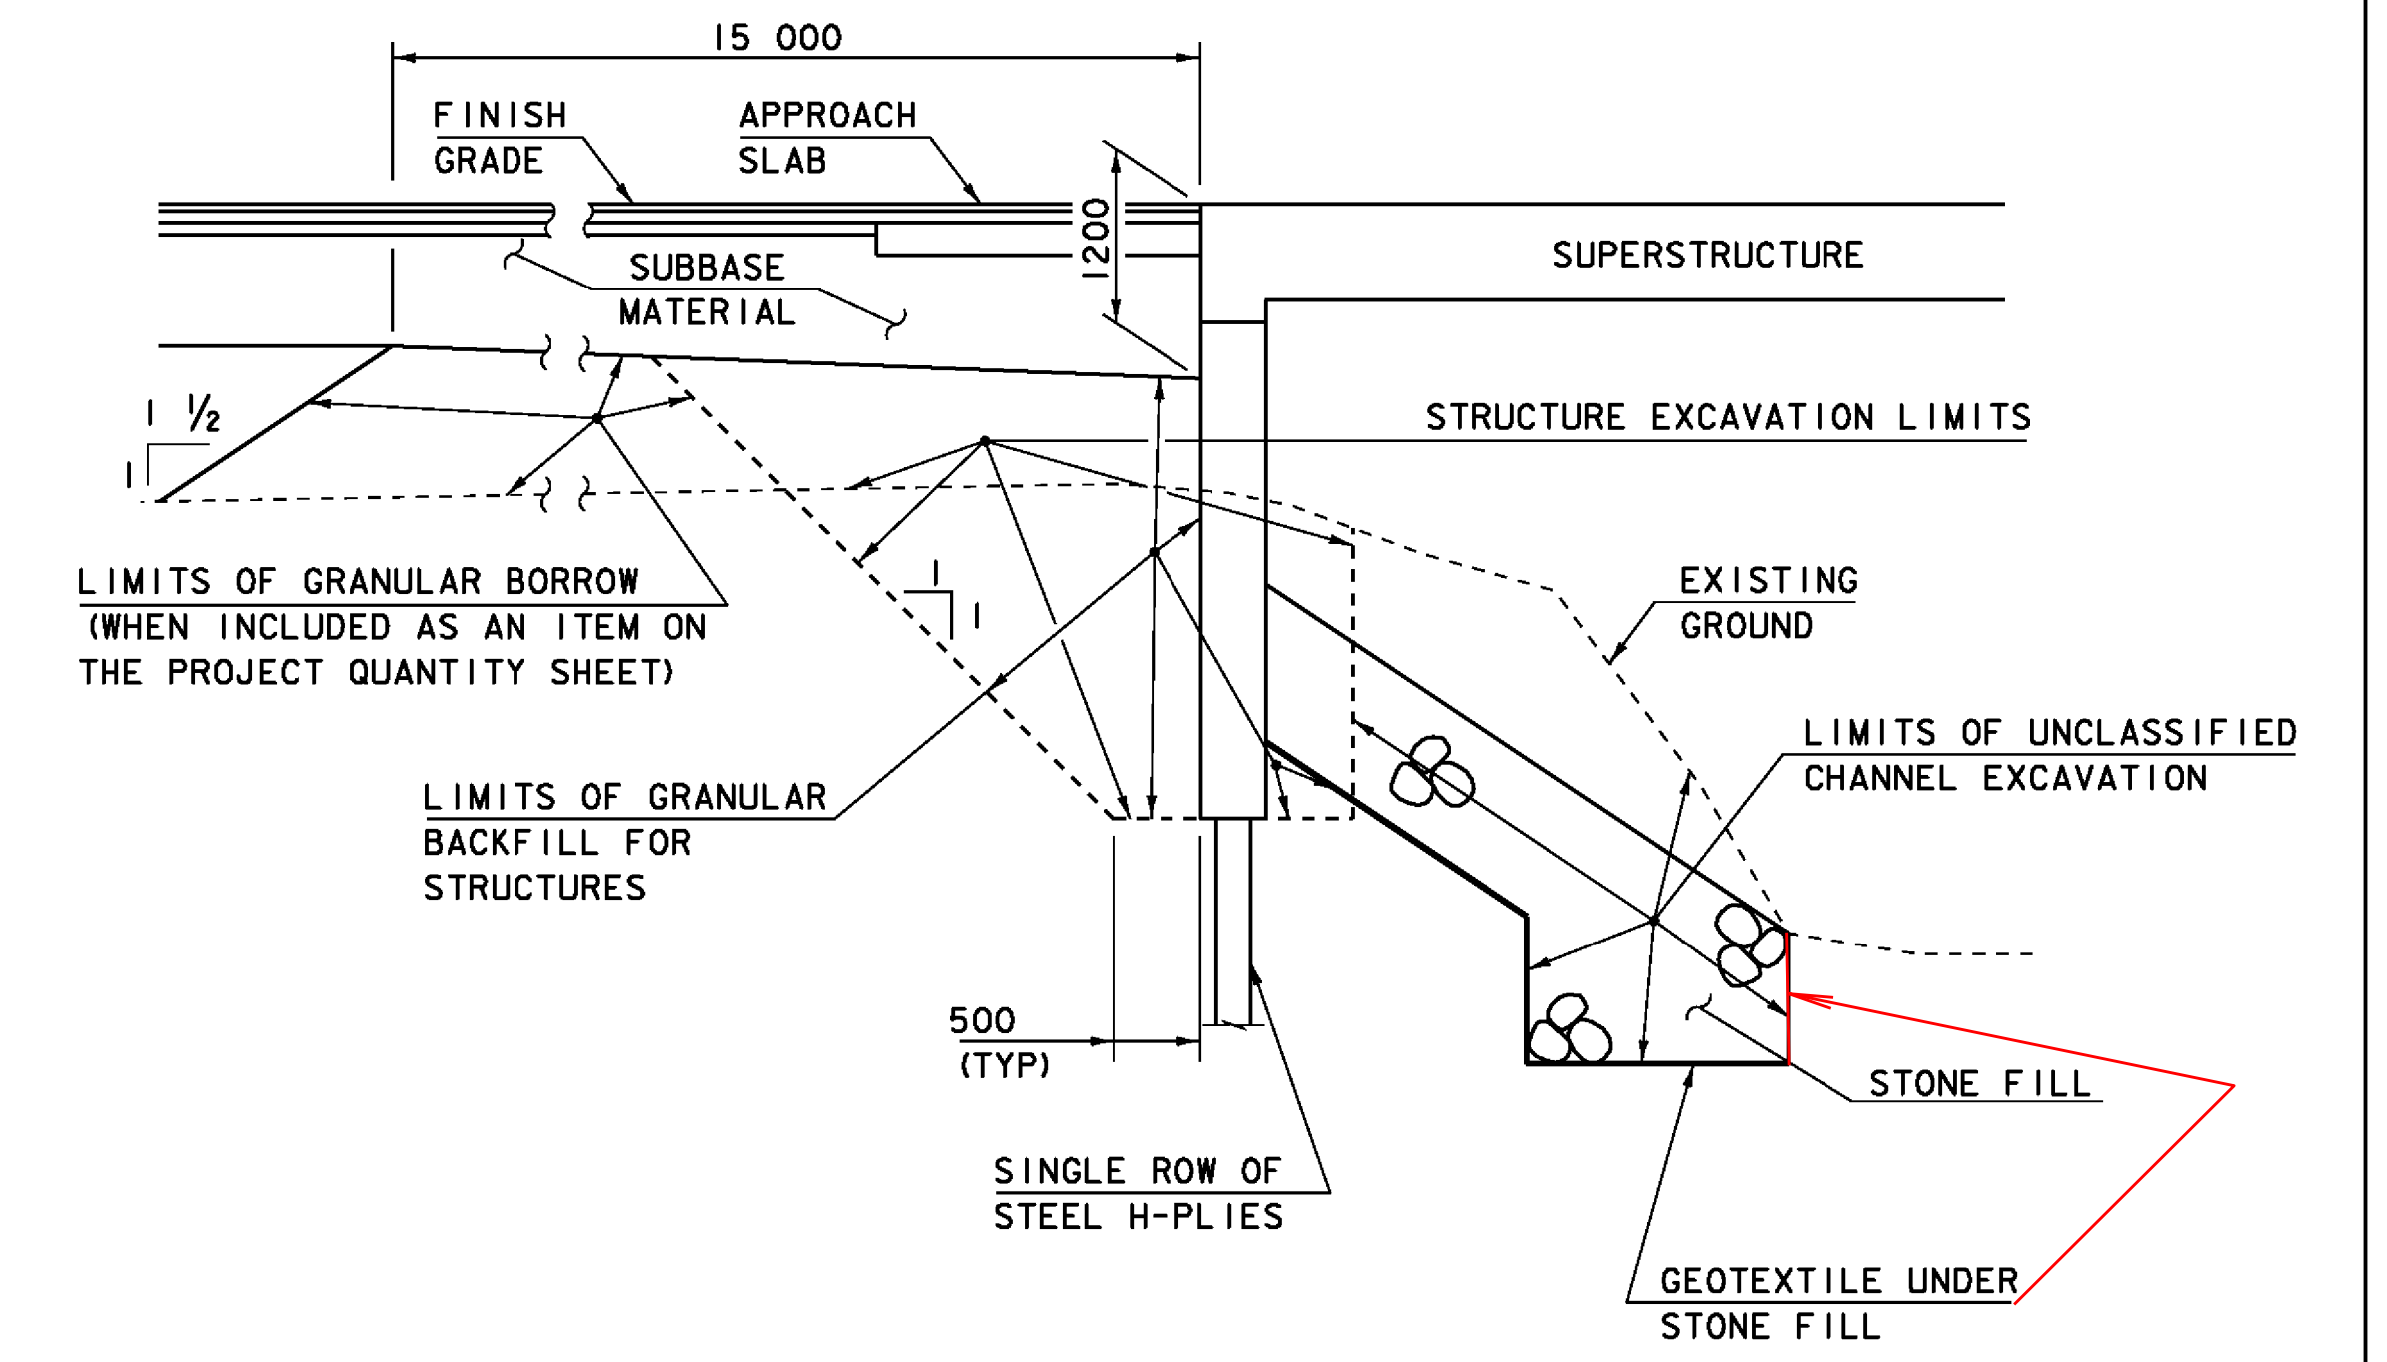


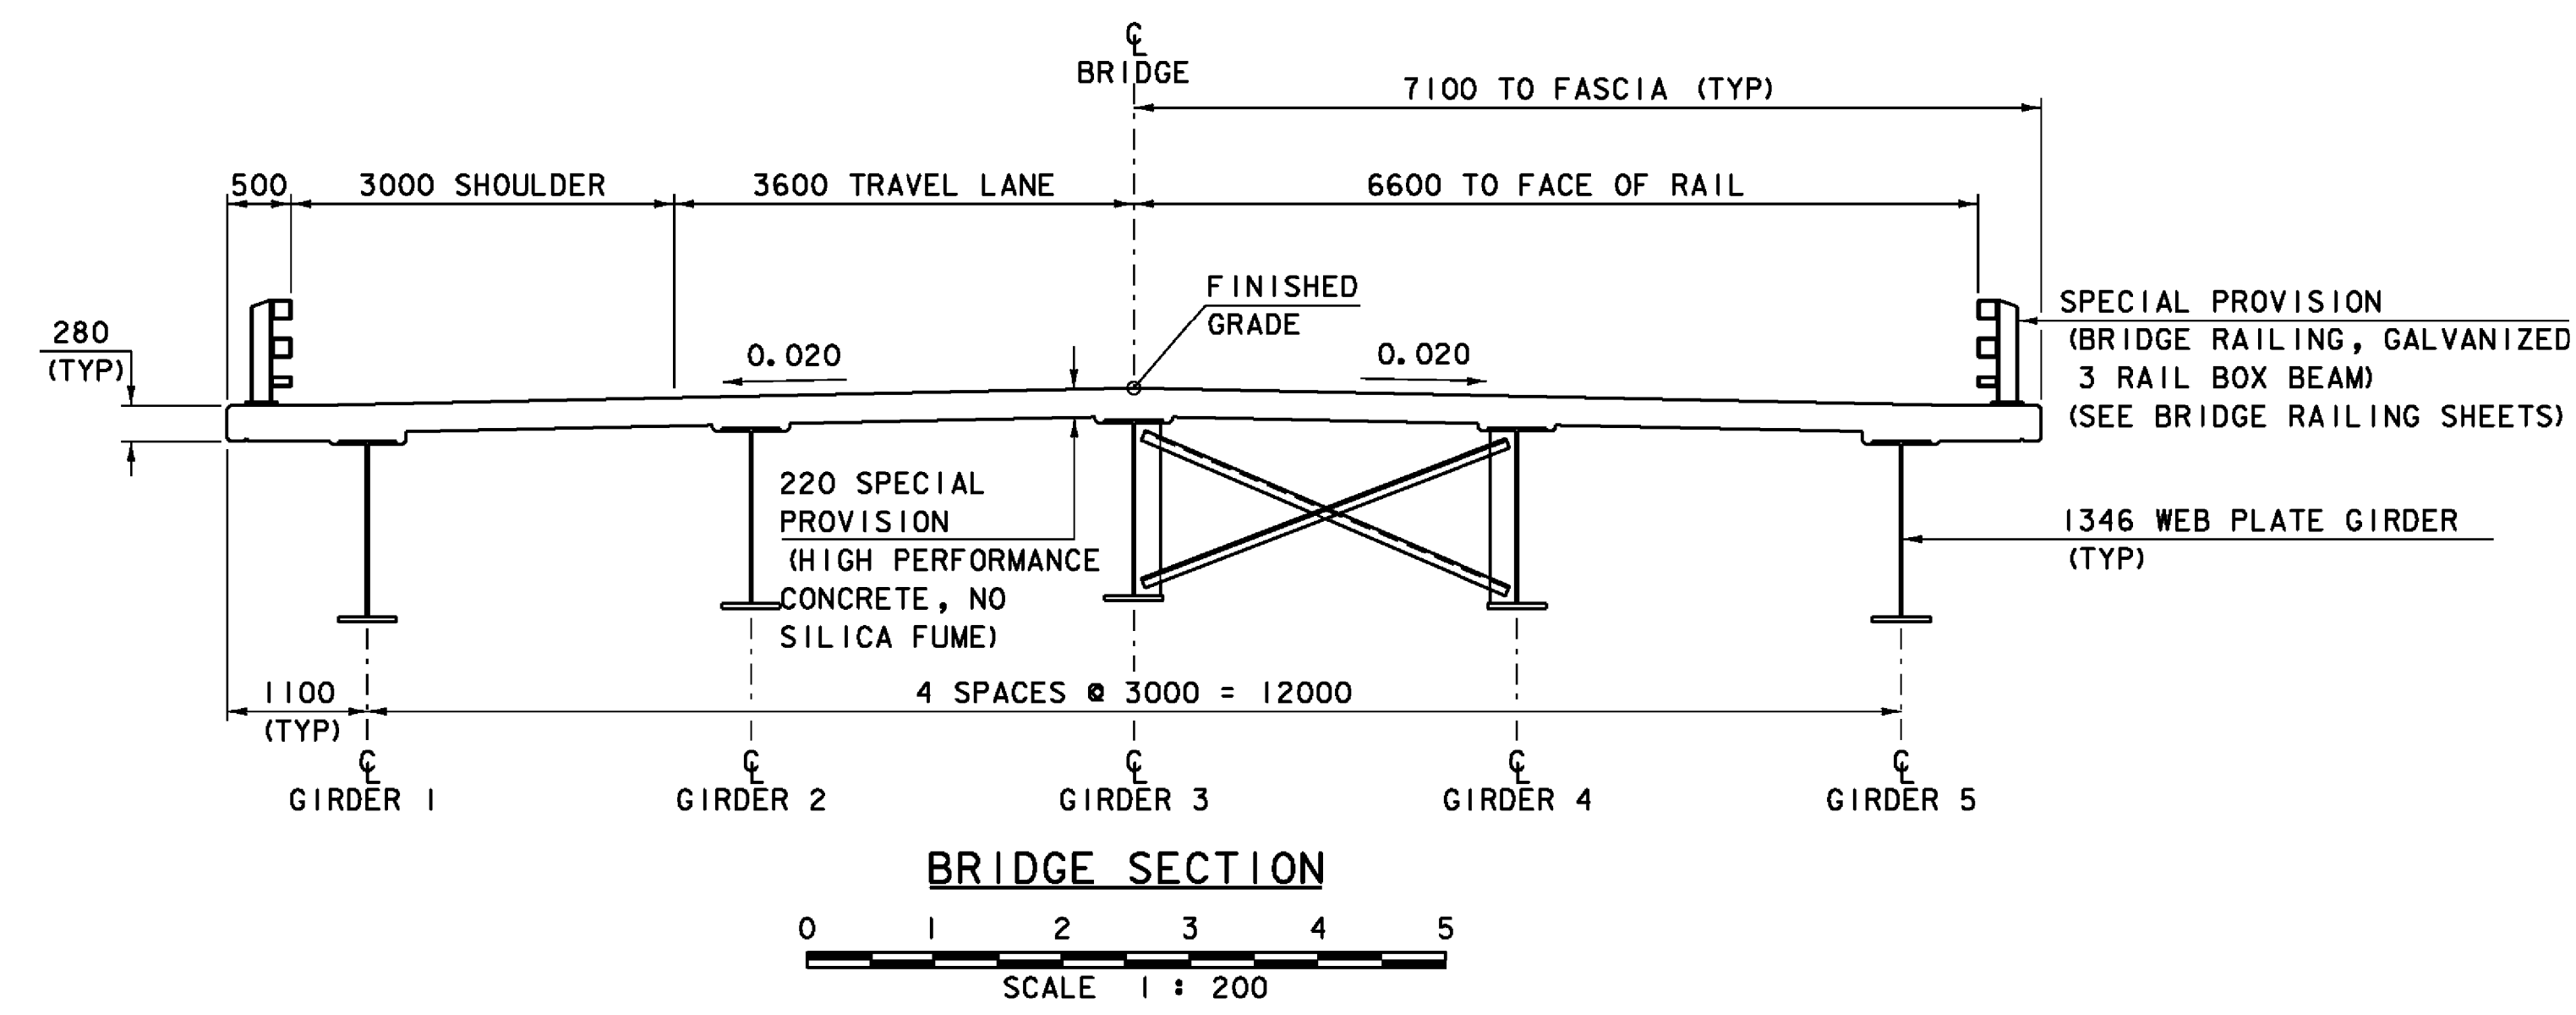

ACTUAL LIMITS OF STRUCTURE EXCAVATION SHALL BE DETERMINED BY THE CONTRACTOR. HOWEVER, ONLY THE EXCAVATION BETWEEN THE LIMITS SHOWN WILL BE PAID FOR UNDER THE ITEM 204.25 "STRUCTURE EXCAVATION". EXCAVATION BY THE CONTRACTOR OUTSIDE OF THESE LIMITS WILL BE AT THE EXPENSE OF THE CONTRACTOR.

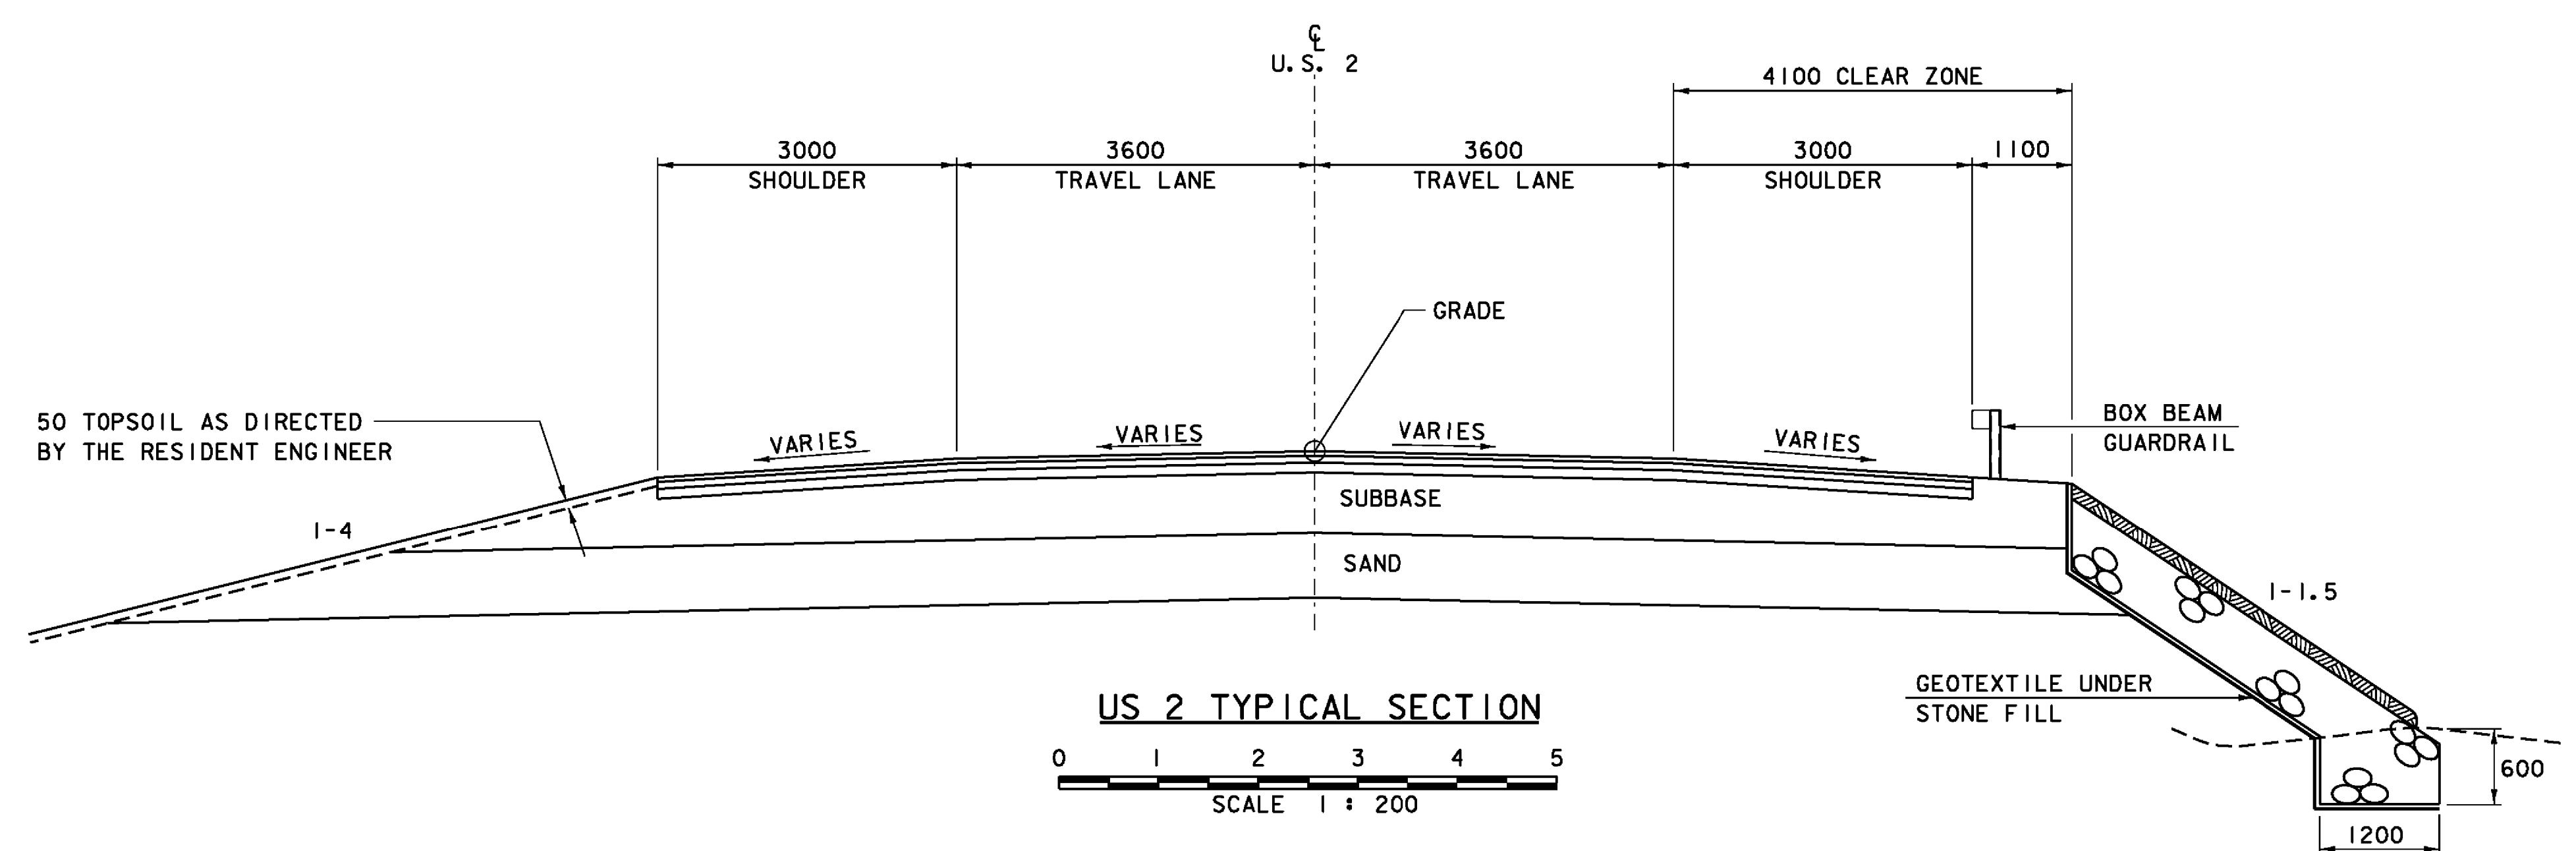


45 SUPERPAVE BITUMINOUS CONCRETE PAVEMENT (TYPE IIIIS)
 75 SUPERPAVE BITUMINOUS CONCRETE PAVEMENT (TYPE IIS)
 85 SUPERPAVE BITUMINOUS CONCRETE PAVEMENT (TYPE IIS)
 600 SUBBASE OF DENSE GRADED CRUSHED STONE
 500 SAND BORROW

NOTE: NUMBER OF GYRATION (N_{DESIGN}) = 75
 FOR PG GRADE SEE SECTION 490 OF THE GENERAL SPECIAL PROVISIONS

ROADWAY BUILT AS DESIGNED

NOTE:
 ALL SLOPES STEEPER THAN 1-2 SHALL HAVE A 600 BLANKET OF STONE FILL, TYPE II. THE STONE FILL BLANKET SHALL BE COVERED WITH A 300 LAYER OF GRUBBING MATERIAL, FERTILIZED, LIMESTONED, SEEDED AND MULCHED.

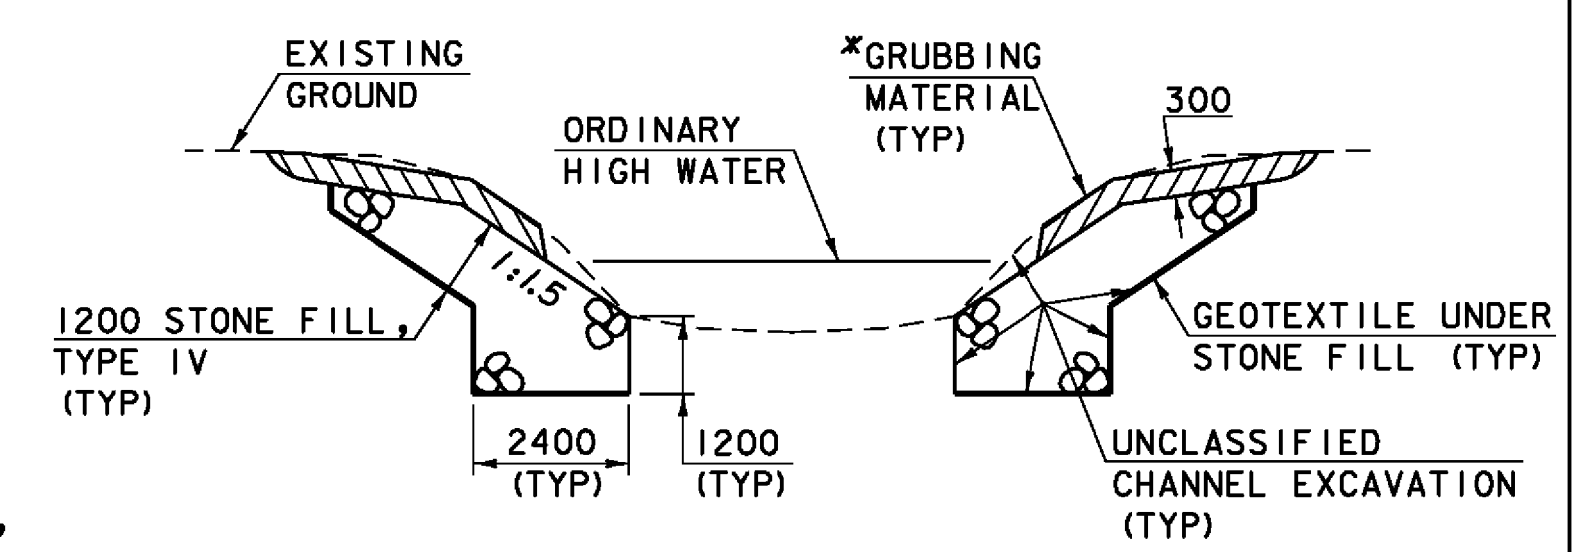

*GRUBBING MATERIAL SHALL NOT BE PLACED ON THE STONE FILL IN THE AREA UNDER THE BRIDGE. WHENEVER CHANNEL SLOPE INTERSECTS ROADWAY SUBBASE, GRUBBING MATERIAL SHALL BEGIN AT THE BOTTOM OF SUBBASE.

MATERIAL ITEM	TOLERANCE
PAVEMENT	±5 mm TOTAL THICKNESS
BASE COURSE	±10 mm
SUBBASE	±30 mm
SAND BORROW	±30 mm

PROJECT: EAST MONTPELIER	PROJECT NO.: BRF 028-3(36)
DESIGN FILE NAME: /98b254/str/sb254typ.dgn	PLOT DATE: 13-FEB-2009
IPARM FILE NAME: sb254typ.i	DRAWN BY: R. PELLETT
DESIGNED BY: J. LACROIX	CHECKED BY: J. LACROIX
SQUAD LEADER: K. HIGGINS	SHEET: 7 OF 68
TYPICAL SECTIONS	