



DATUM
VERTICAL NGVD 1929
HORIZONTAL

- NOTES:
1. UNDERGROUND UTILITY LOCATIONS ARE PLOTTED BASED ON THE BEST AVAILABLE INFORMATION. LOCATIONS SHOULD BE VERIFIED BY THE CONTRACTOR BEFORE WORK.
 2. SEE PLAN NOTES DRAWING NO. 1 FOR PLAN NOTES AND GENERAL NOTES.

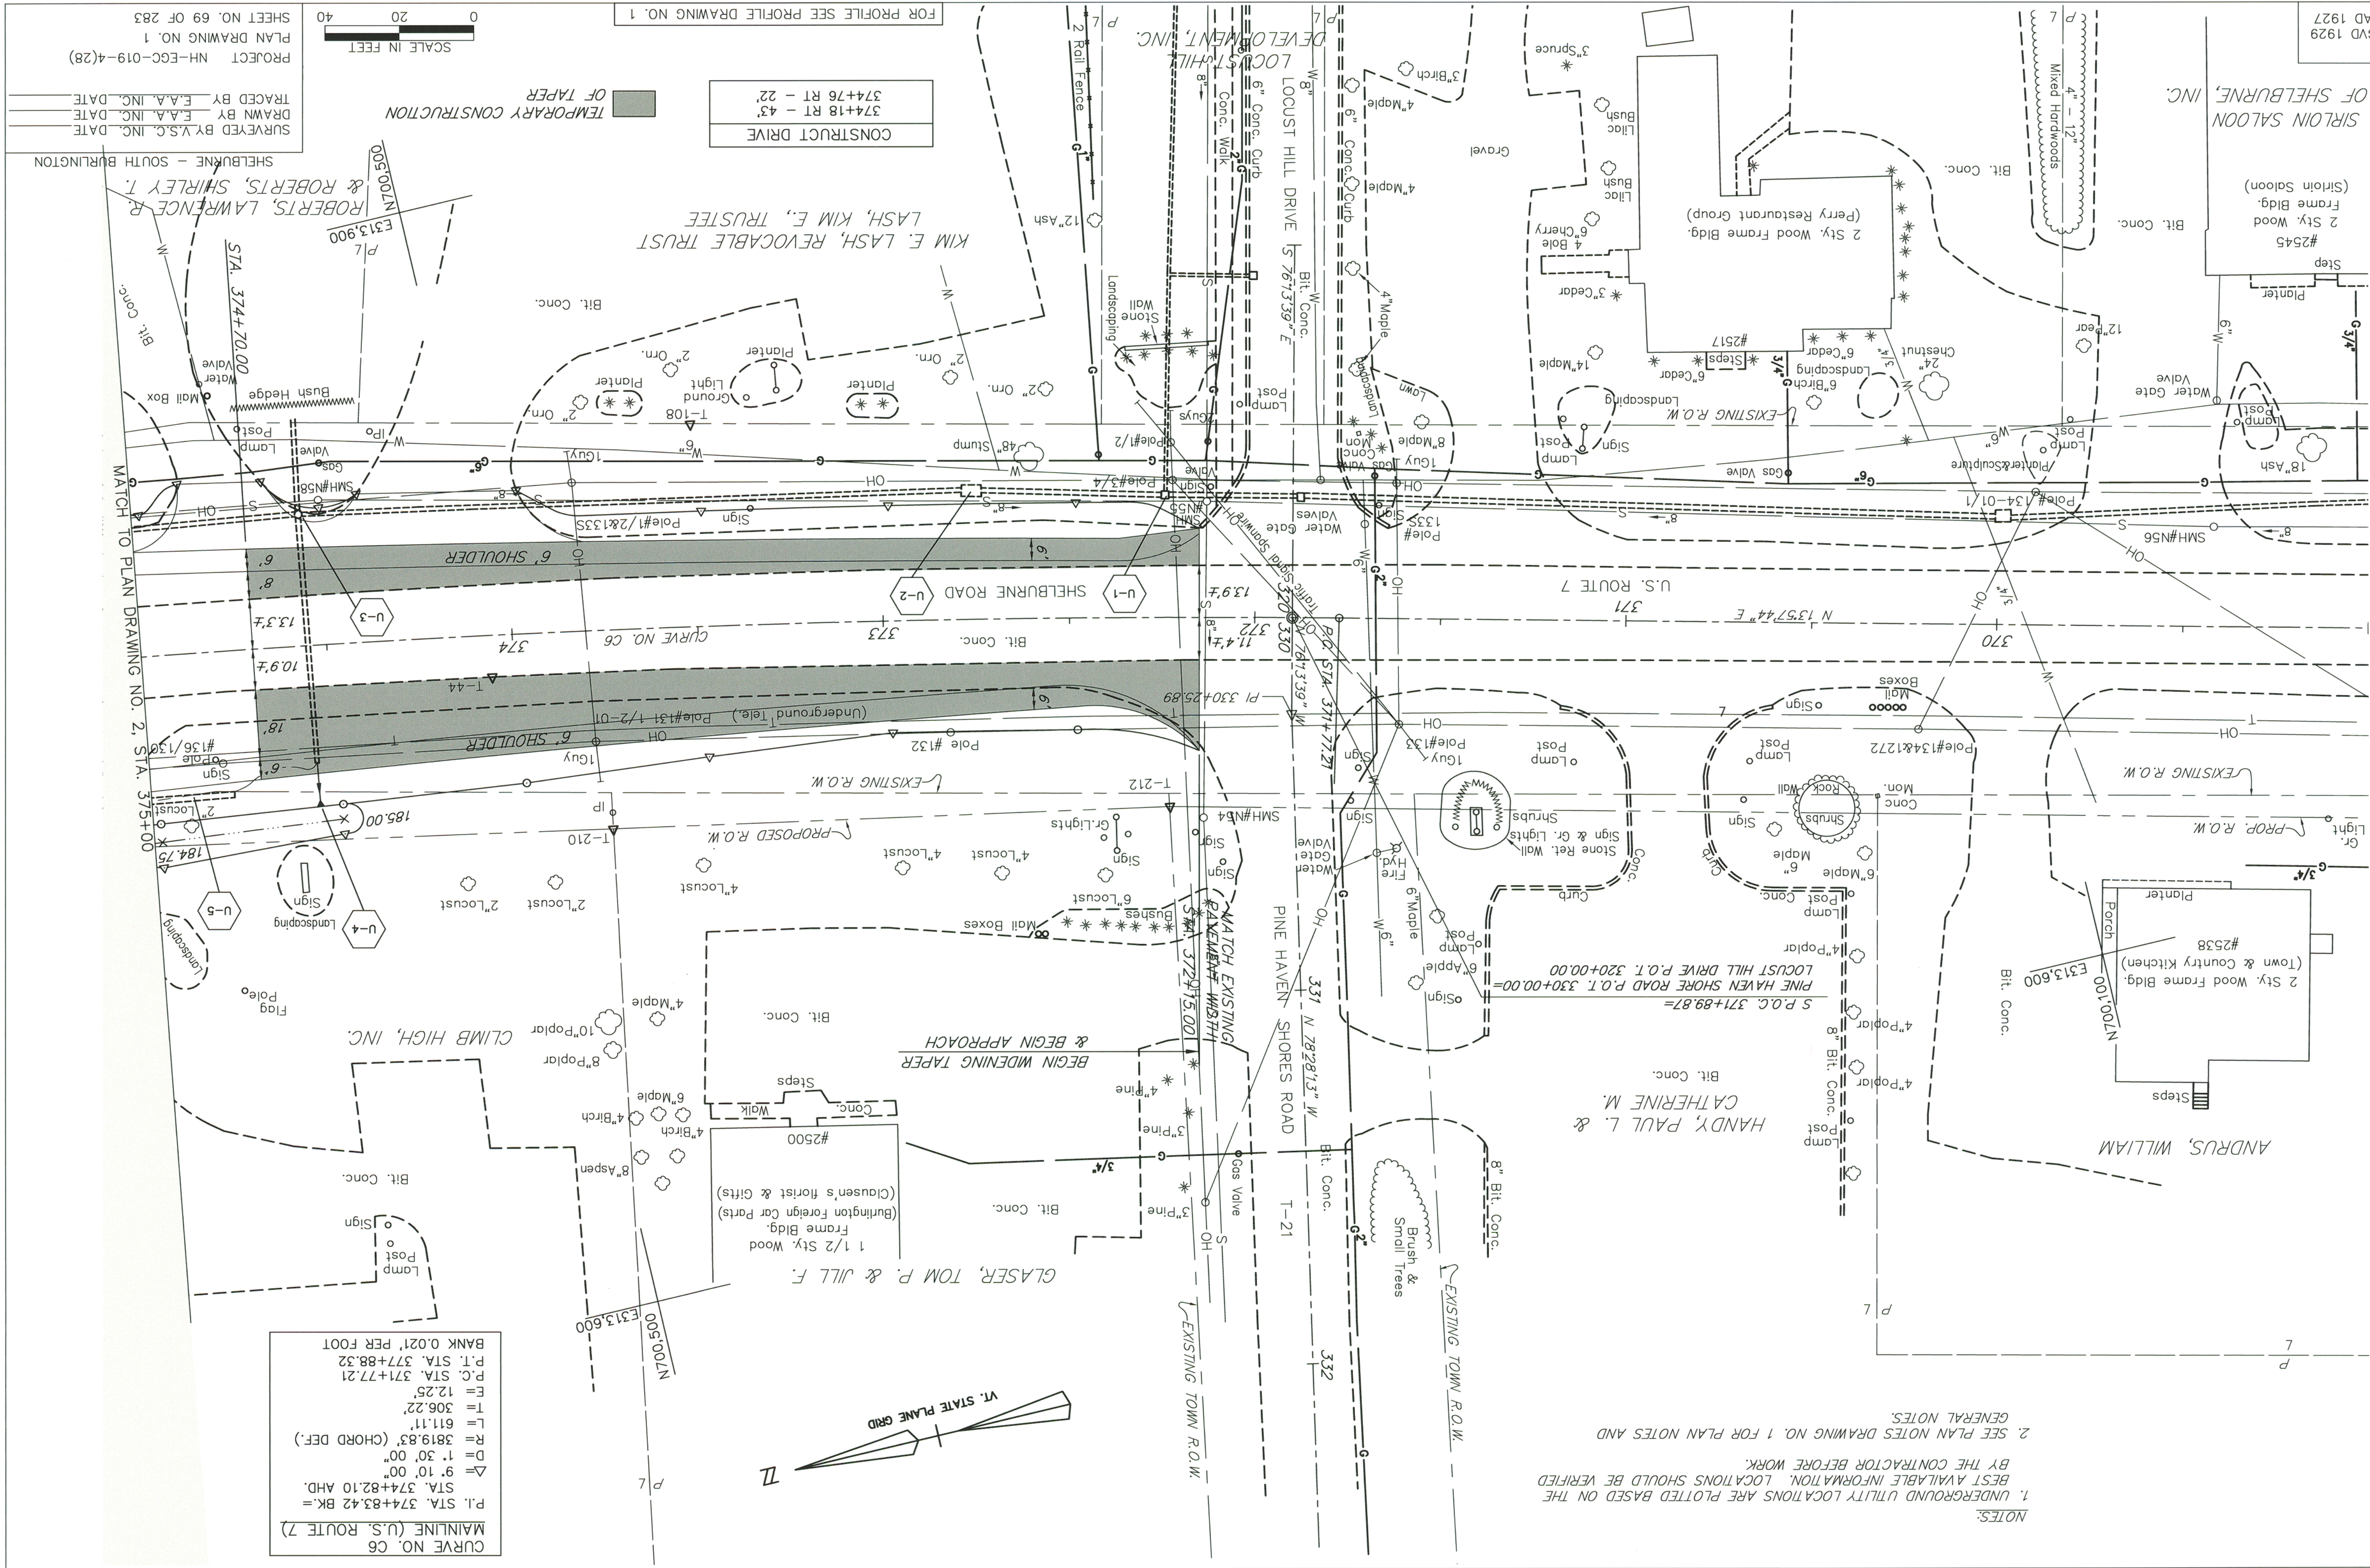

CURVE NO. C6
MAINLINE (U.S. ROUTE 7)
P.I. STA. 374+83.42 BK.=
STA. 374+82.10 AHD.
D= 9' 10" 00"
R= 3819.83' (CHORD DEF.)
L= 611.11'
T= 306.22'
E= 12.25'
P.C. STA. 374+77.21
P.T. STA. 374+88.32
BANK 0.021' PER FOOT

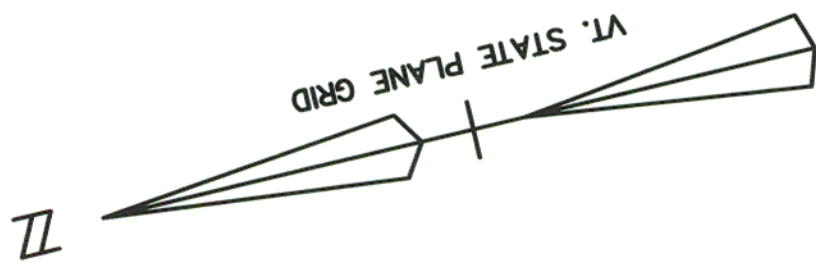

CONSTRUCT DRIVE
374+76 RT - 22'
374+18 RT - 43'

TEMPORARY CONSTRUCTION
OF TAPER

SCALE IN FEET
0 20 40

PROJECT NH-EGC-019-4(28)
PLAN DRAWING NO. 1
SHEET NO. 69 OF 283

SURVEYED BY S.S.C. INC. DATE
DRAWN BY E.A.A. INC. DATE
TRACED BY E.A.A. INC. DATE

SHELBOURNE - SOUTH BURLINGTON