

DATUM
VERTICAL NGVD 1929
HORIZONTAL NAD 1927

- NOTES:
1. UNDERGROUND UTILITY LOCATIONS ARE PLOTTED BASED ON THE BEST AVAILABLE INFORMATION. LOCATIONS SHOULD BE VERIFIED BY THE CONTRACTOR BEFORE WORK.
 2. SEE PLAN NOTES DRAWING NO. 1 FOR PLAN NOTES AND GENERAL NOTES.
 3. VERIZON UNDERGROUND TELEPHONE (STA. 396+50 - STA. 405+50 RT) TO REMAIN.

AS-BUILT LEGEND

- WATER AS-BUILTS
- SEWER AS-BUILTS
- DRAINAGE AS-BUILTS
- ELECTRICAL AS-BUILTS
- PAVEMENT OTHER
- AS-BUILTS

DEMOLITION & DISPOSAL OF:

- D96 @ 402+50, LT (SIGN*)
- D128 @ 400+13, LT (LIGHTS 3*)
- TO 402+01, LT (FLAGPOLE & BASE)
- D137 @ 403+75, LT (FLAGPOLE & BASE)
- * - REMOVED BY OTHERS AS OF JAN. 2003

- AS-BUILT REVISIONS
1. 3/3/06 UTILITIES & PAVEMENT NOTES UPDATED
 2. 8/9/06 STORM DRAIN NOTES UPDATED

PORTLAND CEMENT
CONCRETE SIDEWALK - 8"

399+12 - 399+61 LT
402+55 - 403+04 LT

PORTLAND CEMENT
CONCRETE SIDEWALK - 5"

399+00 - 405+00 RT
399+61 - 402+55 LT
403+04 - 405+00 LT

CONSTRUCT DRIVE

399+32 RT - 16"
399+36 LT - 35"
402+79 LT - 35"

PORTLAND CEMENT
CONCRETE SIDEWALK - 5"
(MEDIAN WIDTH 4-6 FT.)

402+44 TO 405+00


SCALE IN FEET

0 20 40


PROJECT NH-EGC-019-4(28)
PLAN DRAWING NO. 6
SHEET NO. 74 OF 283

SURVEYED BY V.S.C. INC. DATE
DRAWN BY E.A.A. INC. DATE
TRACED BY E.A.A. INC. DATE

SHELburnE - SOUTH BURLINGTON

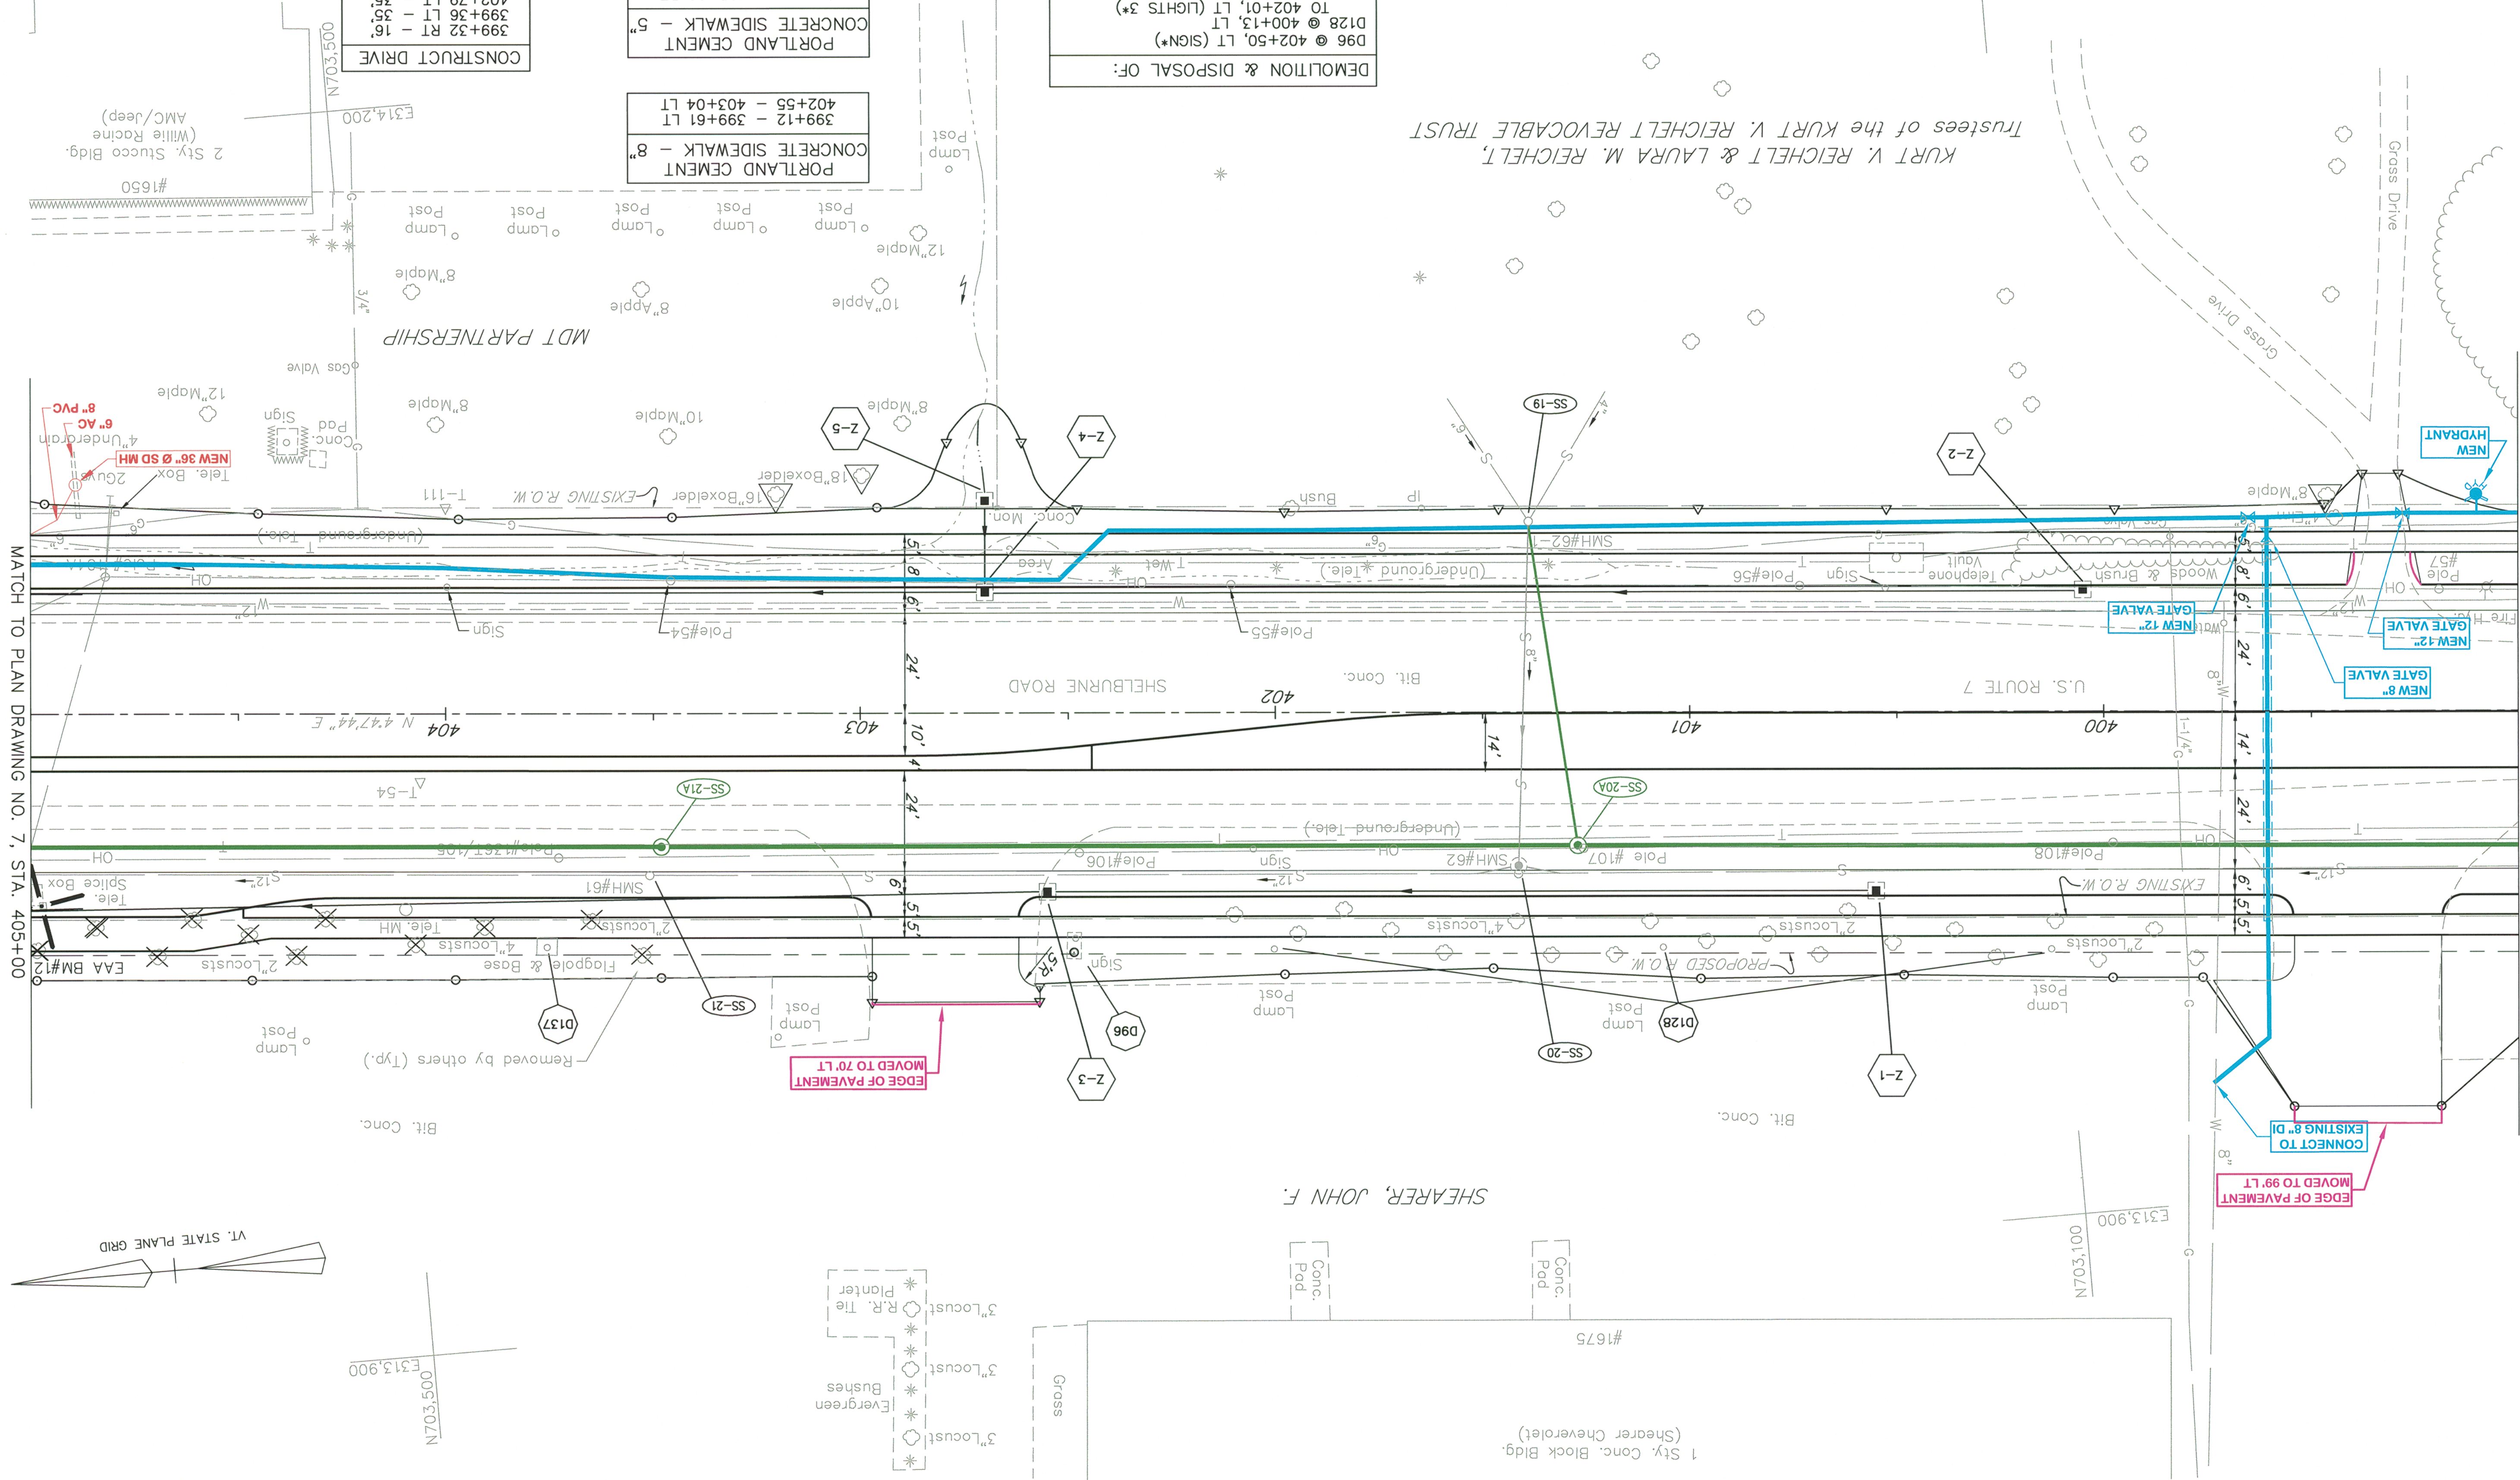

SHEARER, JOHN F.

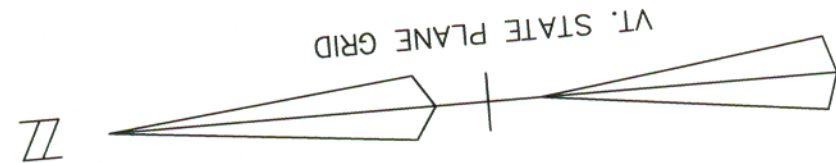

E313,900
N703,500

3" Locust
3" Locust
3" Locust
R.R. Tie
Planter
Evergreen
Bushes

1 Sty. Conc. Block Bldg.
(Shearer Chevrolet)

#1675

Conc. Pod

Conc. Pod

Gross

EDGE OF PAVEMENT
MOVED TO 99' LT

CONNECT TO
EXISTING 8" DI

EDGE OF PAVEMENT
MOVED TO 70' LT

Bit. Conc.

Removed by others (Typ.)

Lamp Post

2" Locusts

2" Locusts

MATCH TO PLAN DRAWING NO. 5, STA. 399+00

MATCH TO PLAN DRAWING NO. 7, STA. 405+00