


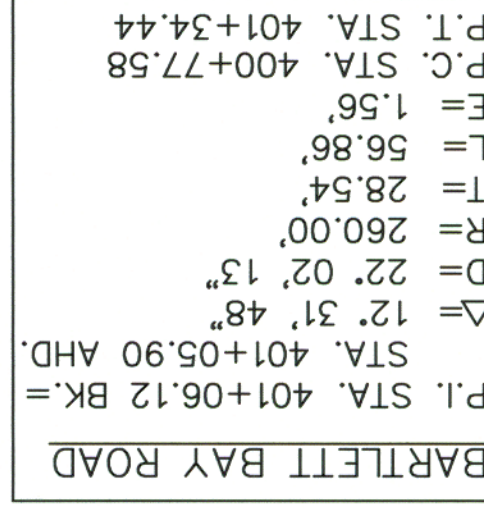

DEMOLITION & DISPOSAL OF:

0306	GR. MT. DR. 390+90 LT (CONC. PAD)
0303	41+00+00, LT (SIGN*)
0305	405+50, LT (SIGN*)
0318	GR. MT. DR. 391+20 TO 391+70, RT (3 LAMP POSTS)
0338	(REMOVE AND RESET)
0340	408+55, LT (SIGN*)
0308	409+20, LT (SIGN)
* - REMOVED BY OTHERS AS OF JAN. 2003	

24' (2) T - 35' R1 - 35' T - 35' R1 - 35' T - 35' R1 - 35'	CONSTRUCT SIDEWALK RAMP	405+34, LT 405+34, RT 405+59, RT 406+28, RT 406+28, LT 405+55, LT	1 1 1 1 1 1 2	NO. DATE DESCRIPTION 1. 3/3/06 UTILITIES, PAY. & CURB UPDATES	AS-BUILT REVISIONS BARTLETT BAY ROAD 405+96.25 LT GREEN MOUNTAIN DRIVE 405+96.25 RT	SURVEYED BY V.S.C. INC. DATE DRAWN BY E.A.A. INC. DATE TRACED BY E.A.A. INC. DATE	PROJECT NH-EGC-019-4(28) PLAN DRAWING NO. 7 SHEET NO. 75 OF 283
	PORTLAND CEMENT CONCRETE SIDEWALK - 8"	409+32 - 409+81 RT 408+55 - 409+03 LT 409+45 - 409+83 LT 410+60 - 410+98 LT					