

DATUM
VERTICAL NGVD 1929
HORIZONTAL NAD 1927

JUGHANDLE H
P.I. STA. 410+50.06 BK.=
Δ= 18' 38' 33"
D= 18' 47' 08"
R= 305.00'
T= 50.06'
L= 99.24'
E= 4.08'
P.C. STA. 410+00.00
P.T. STA. 410+99.24

PORTLAND CEMENT
CONCRETE SIDEWALK - 8"
417+15 - 417+53 LT
418+60 - 418+98 LT
420+65 - 421+14 LT

AS-BUILT LEGEND		
WATER AS-BUILTS		
SEWER AS-BUILTS		
DRAINAGE AS-BUILTS		
ELECTRICAL AS-BUILTS		
PAVEMENT OTHER		
AS-BUILTS		

CONSTRUCT SIDEWALK RAMP		
TYPE		
1	411+79, RT (JUGHANDLE H)	
2	411+79, LT (JUGHANDLE H)	

PORTLAND CEMENT CONCRETE SIDEWALK - 5"		
417+00 - 420+33 RT		
421+33 - 423+00 RT		
417+00 - 417+15 LT		
418+60 - 418+65 LT		
417+53 - 420+65 LT		
421+14 - 423+00 LT		
JUGHANDLE H 411+59 - 411+63 RT		


AS-BUILT REVISIONS
1. NO DATE DESCRIPTION
2. 8/9/06 IRRIGATION ADDED
3. 3/3/06 SEWER, ELEC. & DRAIN EDITS

PORTLAND CEMENT
CONCRETE SIDEWALK - 5"
(MEDIAN WIDTH 4-6 FT.)
421+00 TO 423+00

DEMOLITION & DISPOSAL OF:
D85 @ 417+95, LT (SIGN* & PLANTER*)
D86 @ 419+25, LT (SIGN & LP)
D88 @ 422+83, RT (ELECTRICAL PANEL)
D102 @ 419+90, LT (SIGN* & 2 GLS*)
D139 @ 421+20, LT (SIGN*)
* - REMOVED BY OTHERS AS OF JAN. 2003


PROJECT F-EGC-019-4(19)
PLAN DRAWING NO. 9
SHEET NO. 77 OF 283
SURVEYED BY S.S.C. INC. DATE
DRAWN BY E.A.A. INC. DATE
TRACED BY E.A.A. INC. DATE
SHELburne - SOUTH BURLINGTON

SCALE IN FEET
0 20 40

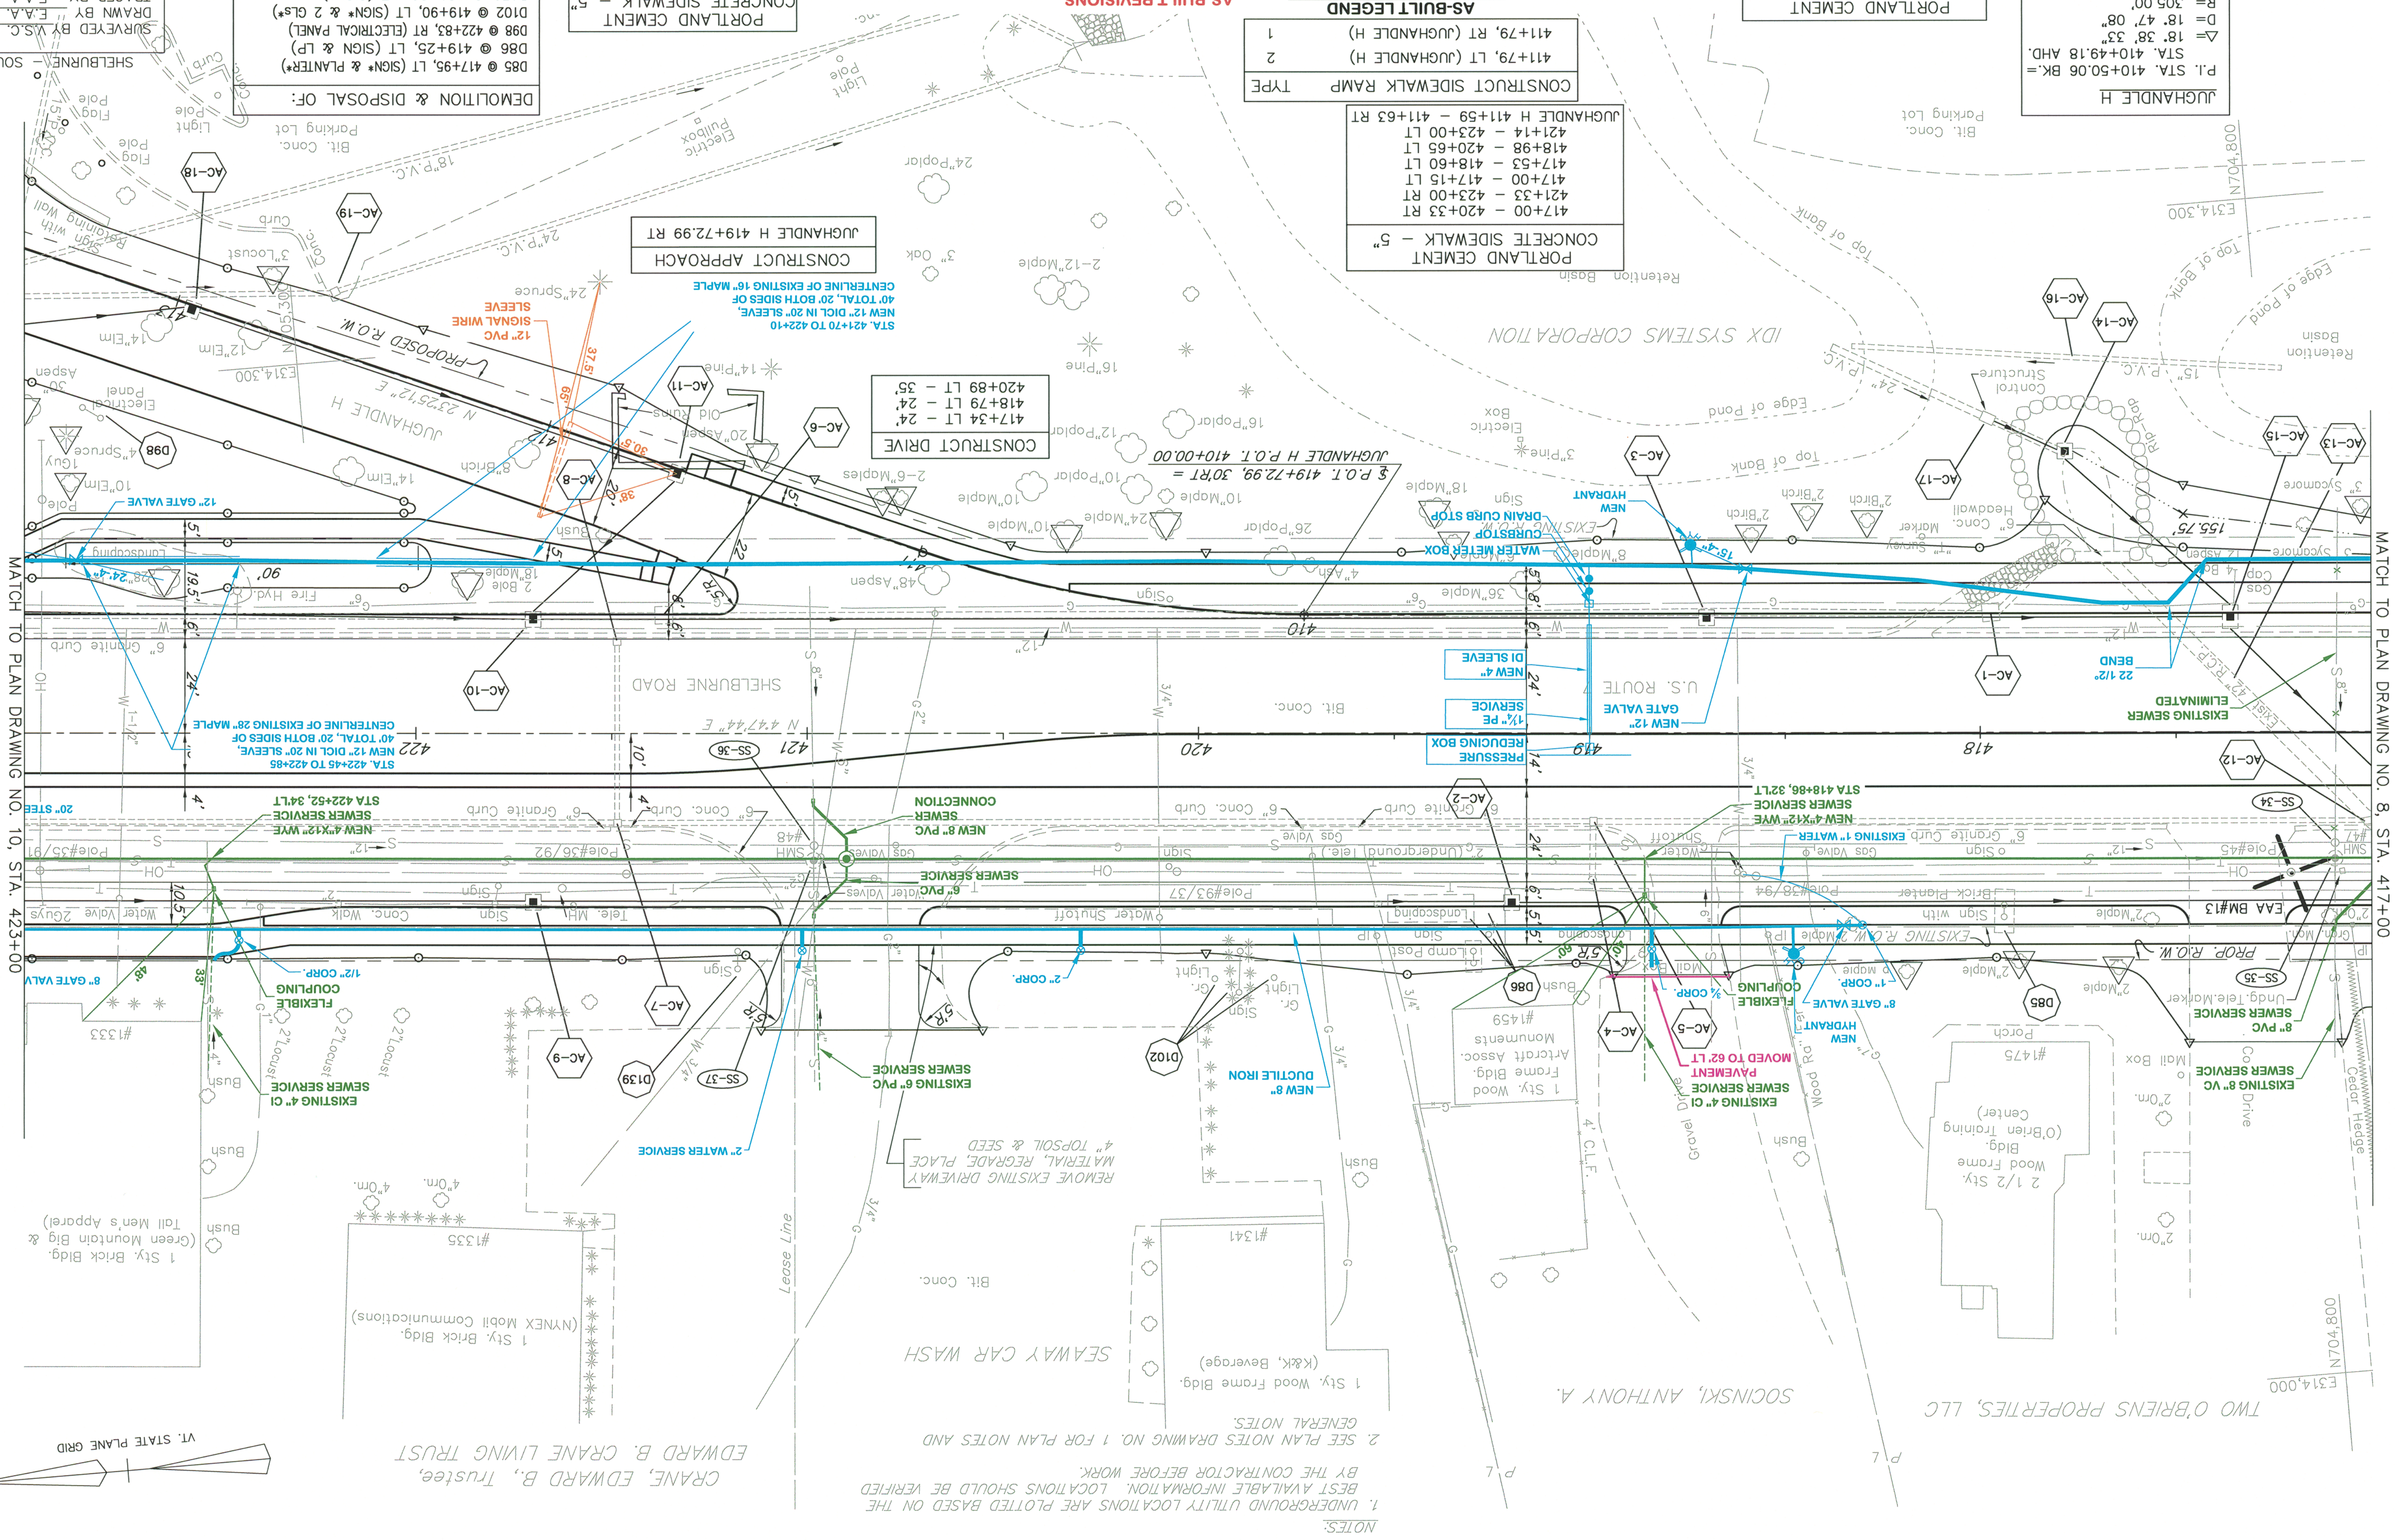

NOTES:
1. UNDERGROUND UTILITY LOCATIONS ARE PLOTTED BASED ON THE BEST AVAILABLE INFORMATION. LOCATIONS SHOULD BE VERIFIED BY THE CONTRACTOR BEFORE WORK.
2. SEE PLAN NOTES DRAWING NO. 1 FOR PLAN NOTES AND GENERAL NOTES.

CRANE, EDWARD B., Trustee,
EDWARD B. CRANE LIVING TRUST

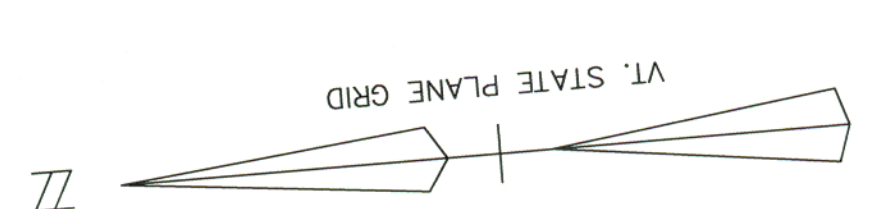

MATCH TO PLAN DRAWING NO. 8, STA. 417+00

MATCH TO PLAN DRAWING NO. 10, STA. 423+00