

DATUM
VERTICAL NGVD 1927
HORIZONTAL

MATCH TO PLAN DRAWING NO. 9, STA. 423+00

MATCH LINE
Pole#4/12
HOLMES ROAD
P.O.T. 432+30.00
END APPROACH CONSTR.

AS-BUILT LEGEND
WATER AS-BUILTS
SEWER AS-BUILTS
DRAINAGE AS-BUILTS
ELECTRICAL AS-BUILTS
PAVEMENT OTHER
AS-BUILTS

CONSTRUCT SIDEWALK RAMP TYPE
423+34, LT
423+59, RT
424+14, LT
424+31, RT
428+09, RT
428+31, LT
424+31, RT

DEMOLITION & DISPOSAL OF:
D87 @ 425+23, LT (SIGN & BOX)
(SIGN, CONC. PAD, PLANTER* & 5 LAMP POSTS*)
* - REMOVED BY OTHERS AS OF JAN. 2003


NO. DATE REVISIONS
1. 3/3/06 SEWER, DRAINAGE & ELEC. EDITS

PORTLAND CEMENT
CONCRETE SIDEWALK - 8"
426+50 - 427+00 RT
426+72 - 427+21 LT

PORTLAND CEMENT
CONCRETE SIDEWALK - 5"
423+00 - 423+59 RT
424+10 - 426+50 RT
427+00 - 428+12 RT
423+00 - 423+37 LT
424+10 - 426+72 LT
427+21 - 428+95 LT

PROJECT F-EGC-019-4(19)
PLAN DRAWING NO. 10
SURVEYED BY V.S.C. INC. DATE
DRAWN BY E.A.A. INC. DATE
TRACED BY E.A.A. INC. DATE
SHELburne - SOUTH BURLINGTON

SCALE IN FEET
0 20 40

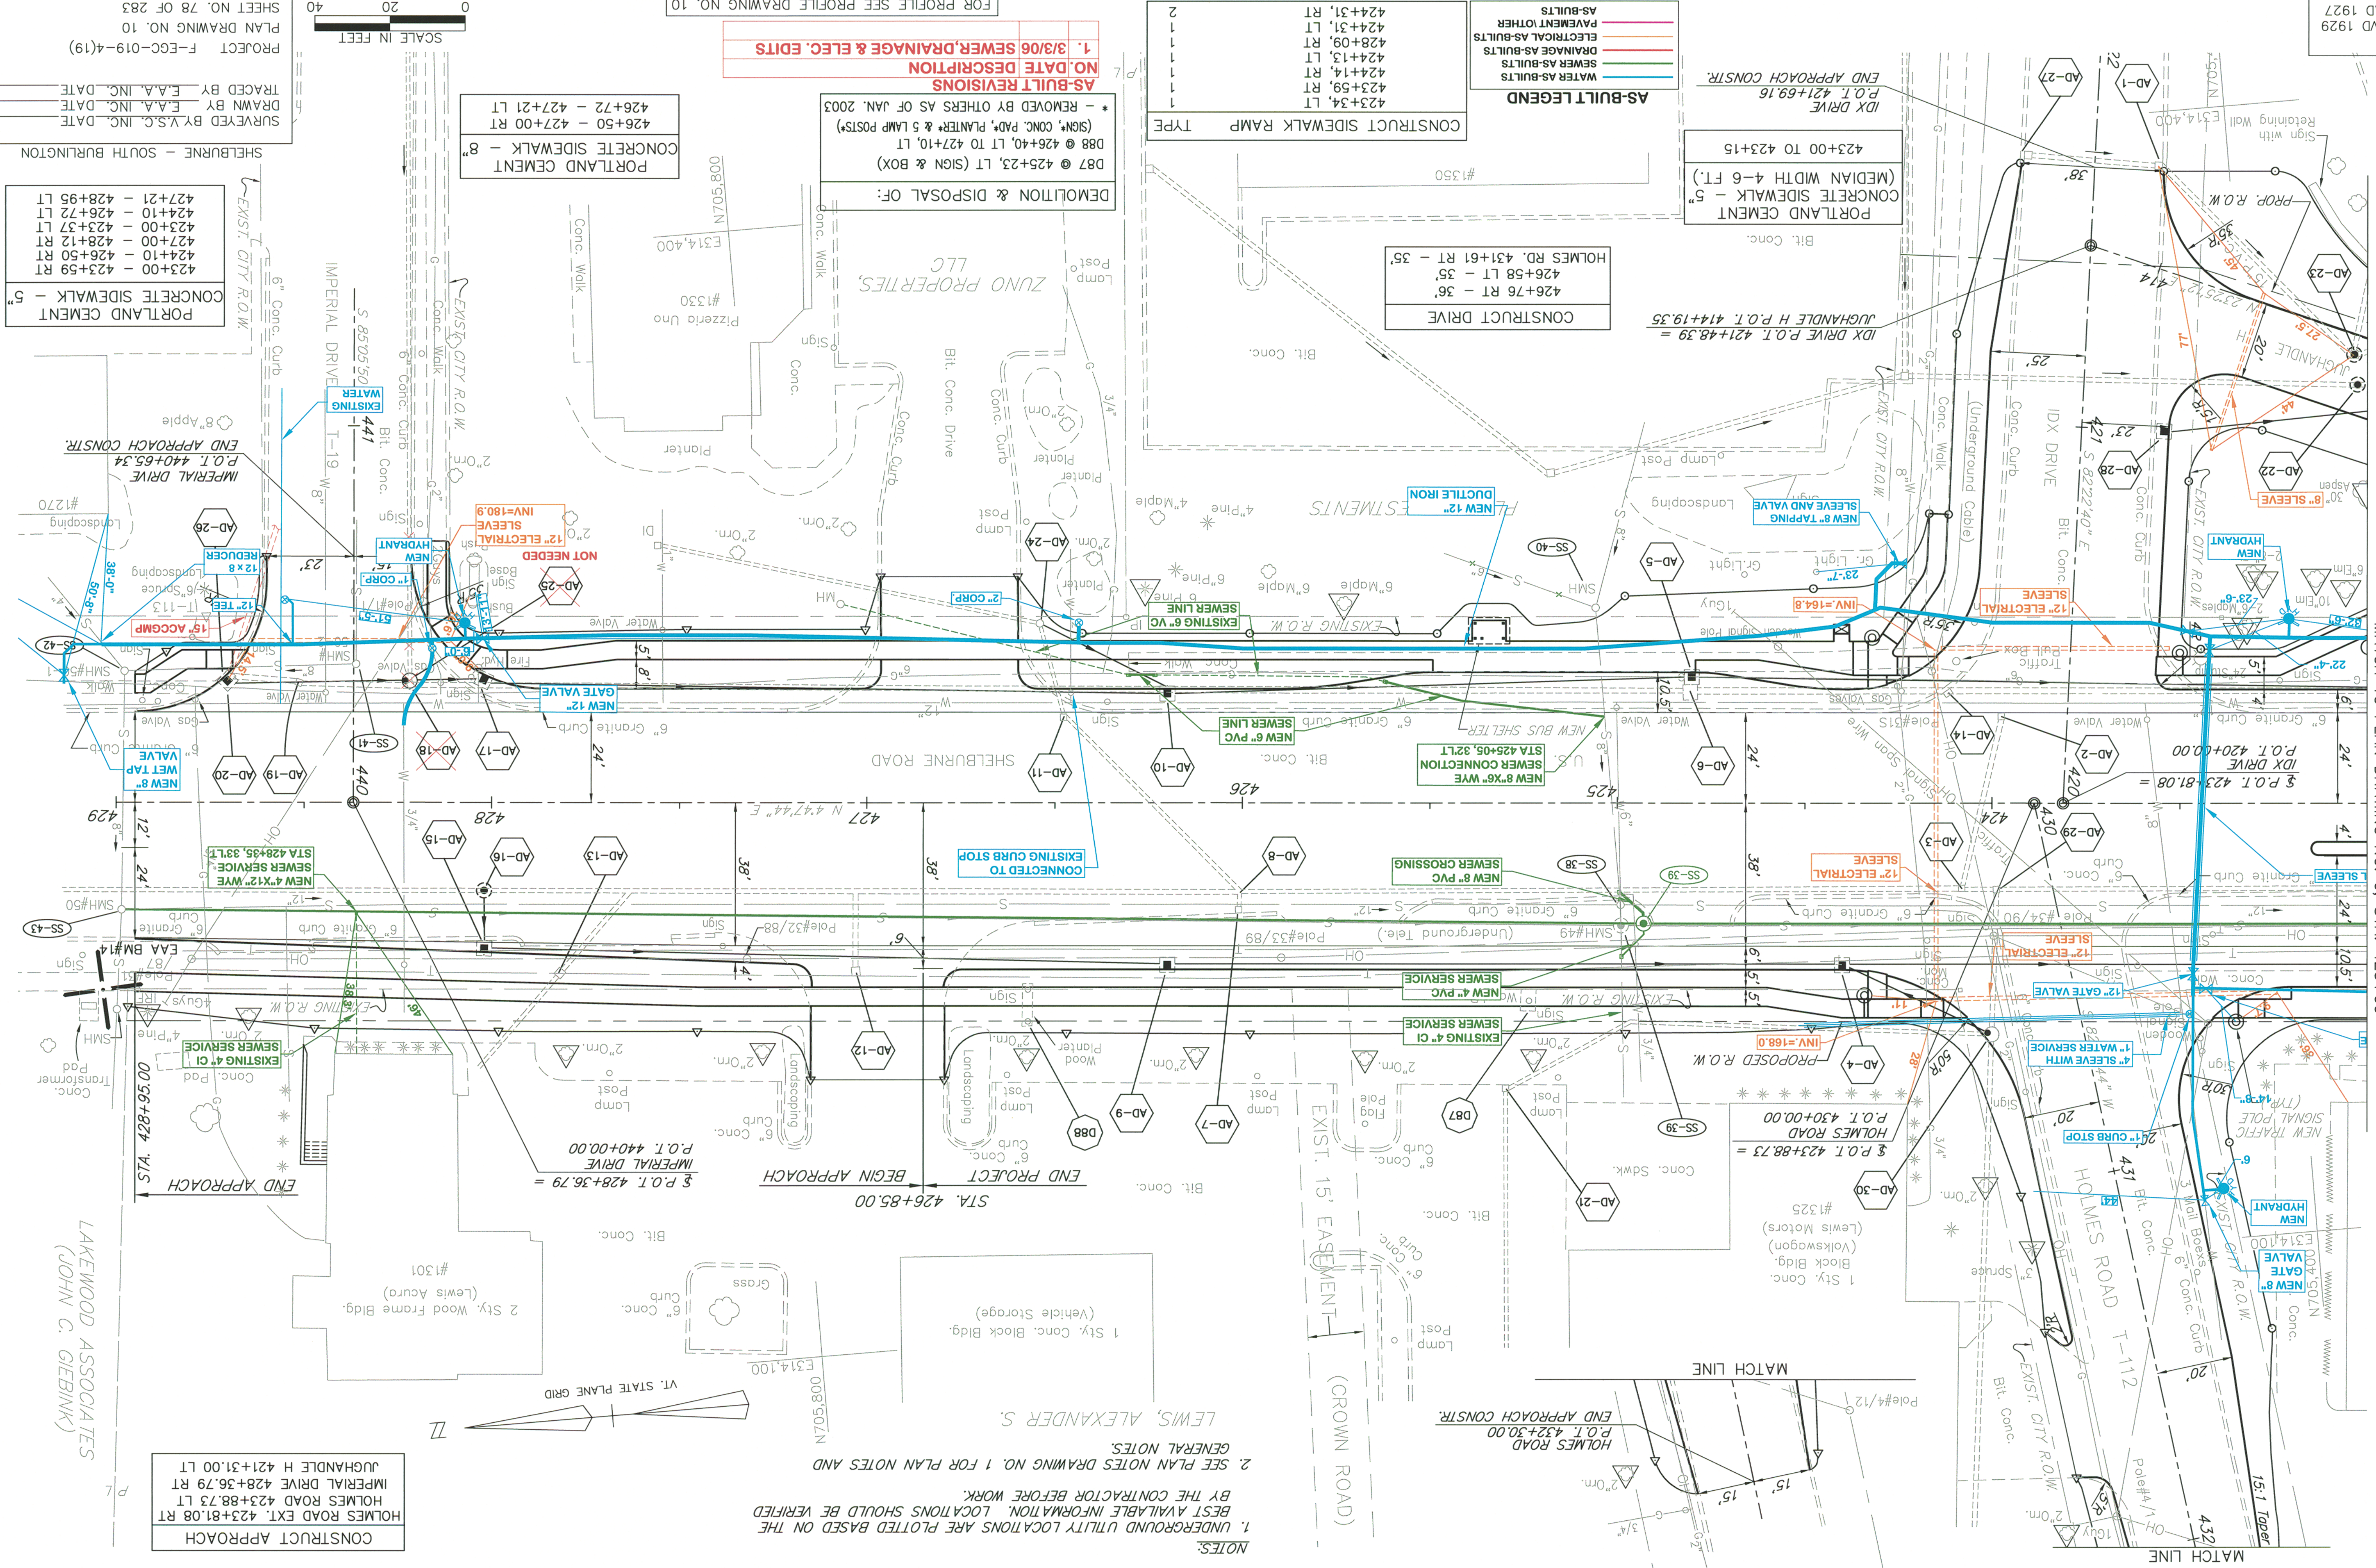

NOTES:
1. UNDERGROUND UTILITY LOCATIONS ARE PLOTTED BASED ON THE BEST AVAILABLE INFORMATION. LOCATIONS SHOULD BE VERIFIED BY THE CONTRACTOR BEFORE WORK.
2. SEE PLAN NOTES DRAWING NO. 1 FOR PLAN NOTES AND GENERAL NOTES.

LEWIS, ALEXANDER S.

LAKEWOOD ASSOCIATES
(JOHN C. GEBINK)

CONSTRUCT APPROACH
HOLMES ROAD EXT. 423+81.08 RT
IMPERIAL DRIVE 428+36.79 RT
JUGHANDLE H 421+31.00 LT