
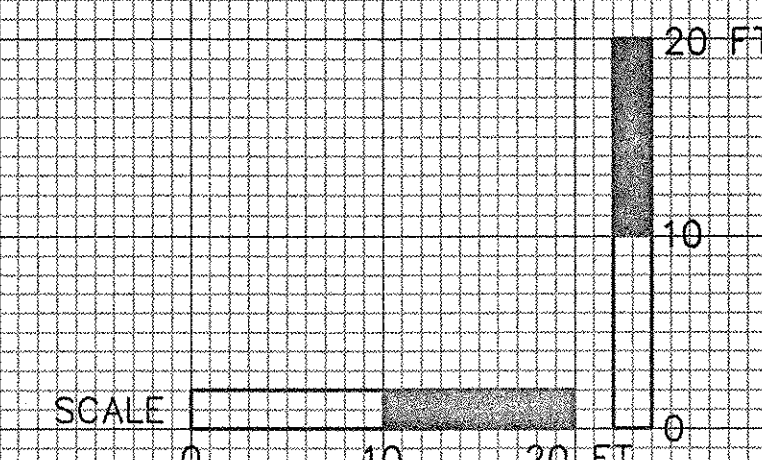


DATUM ELEV = 170.00

DATUM ELEV = 170.00

DATUM ELEV = 170.00

DATUM ELEV = 170.00

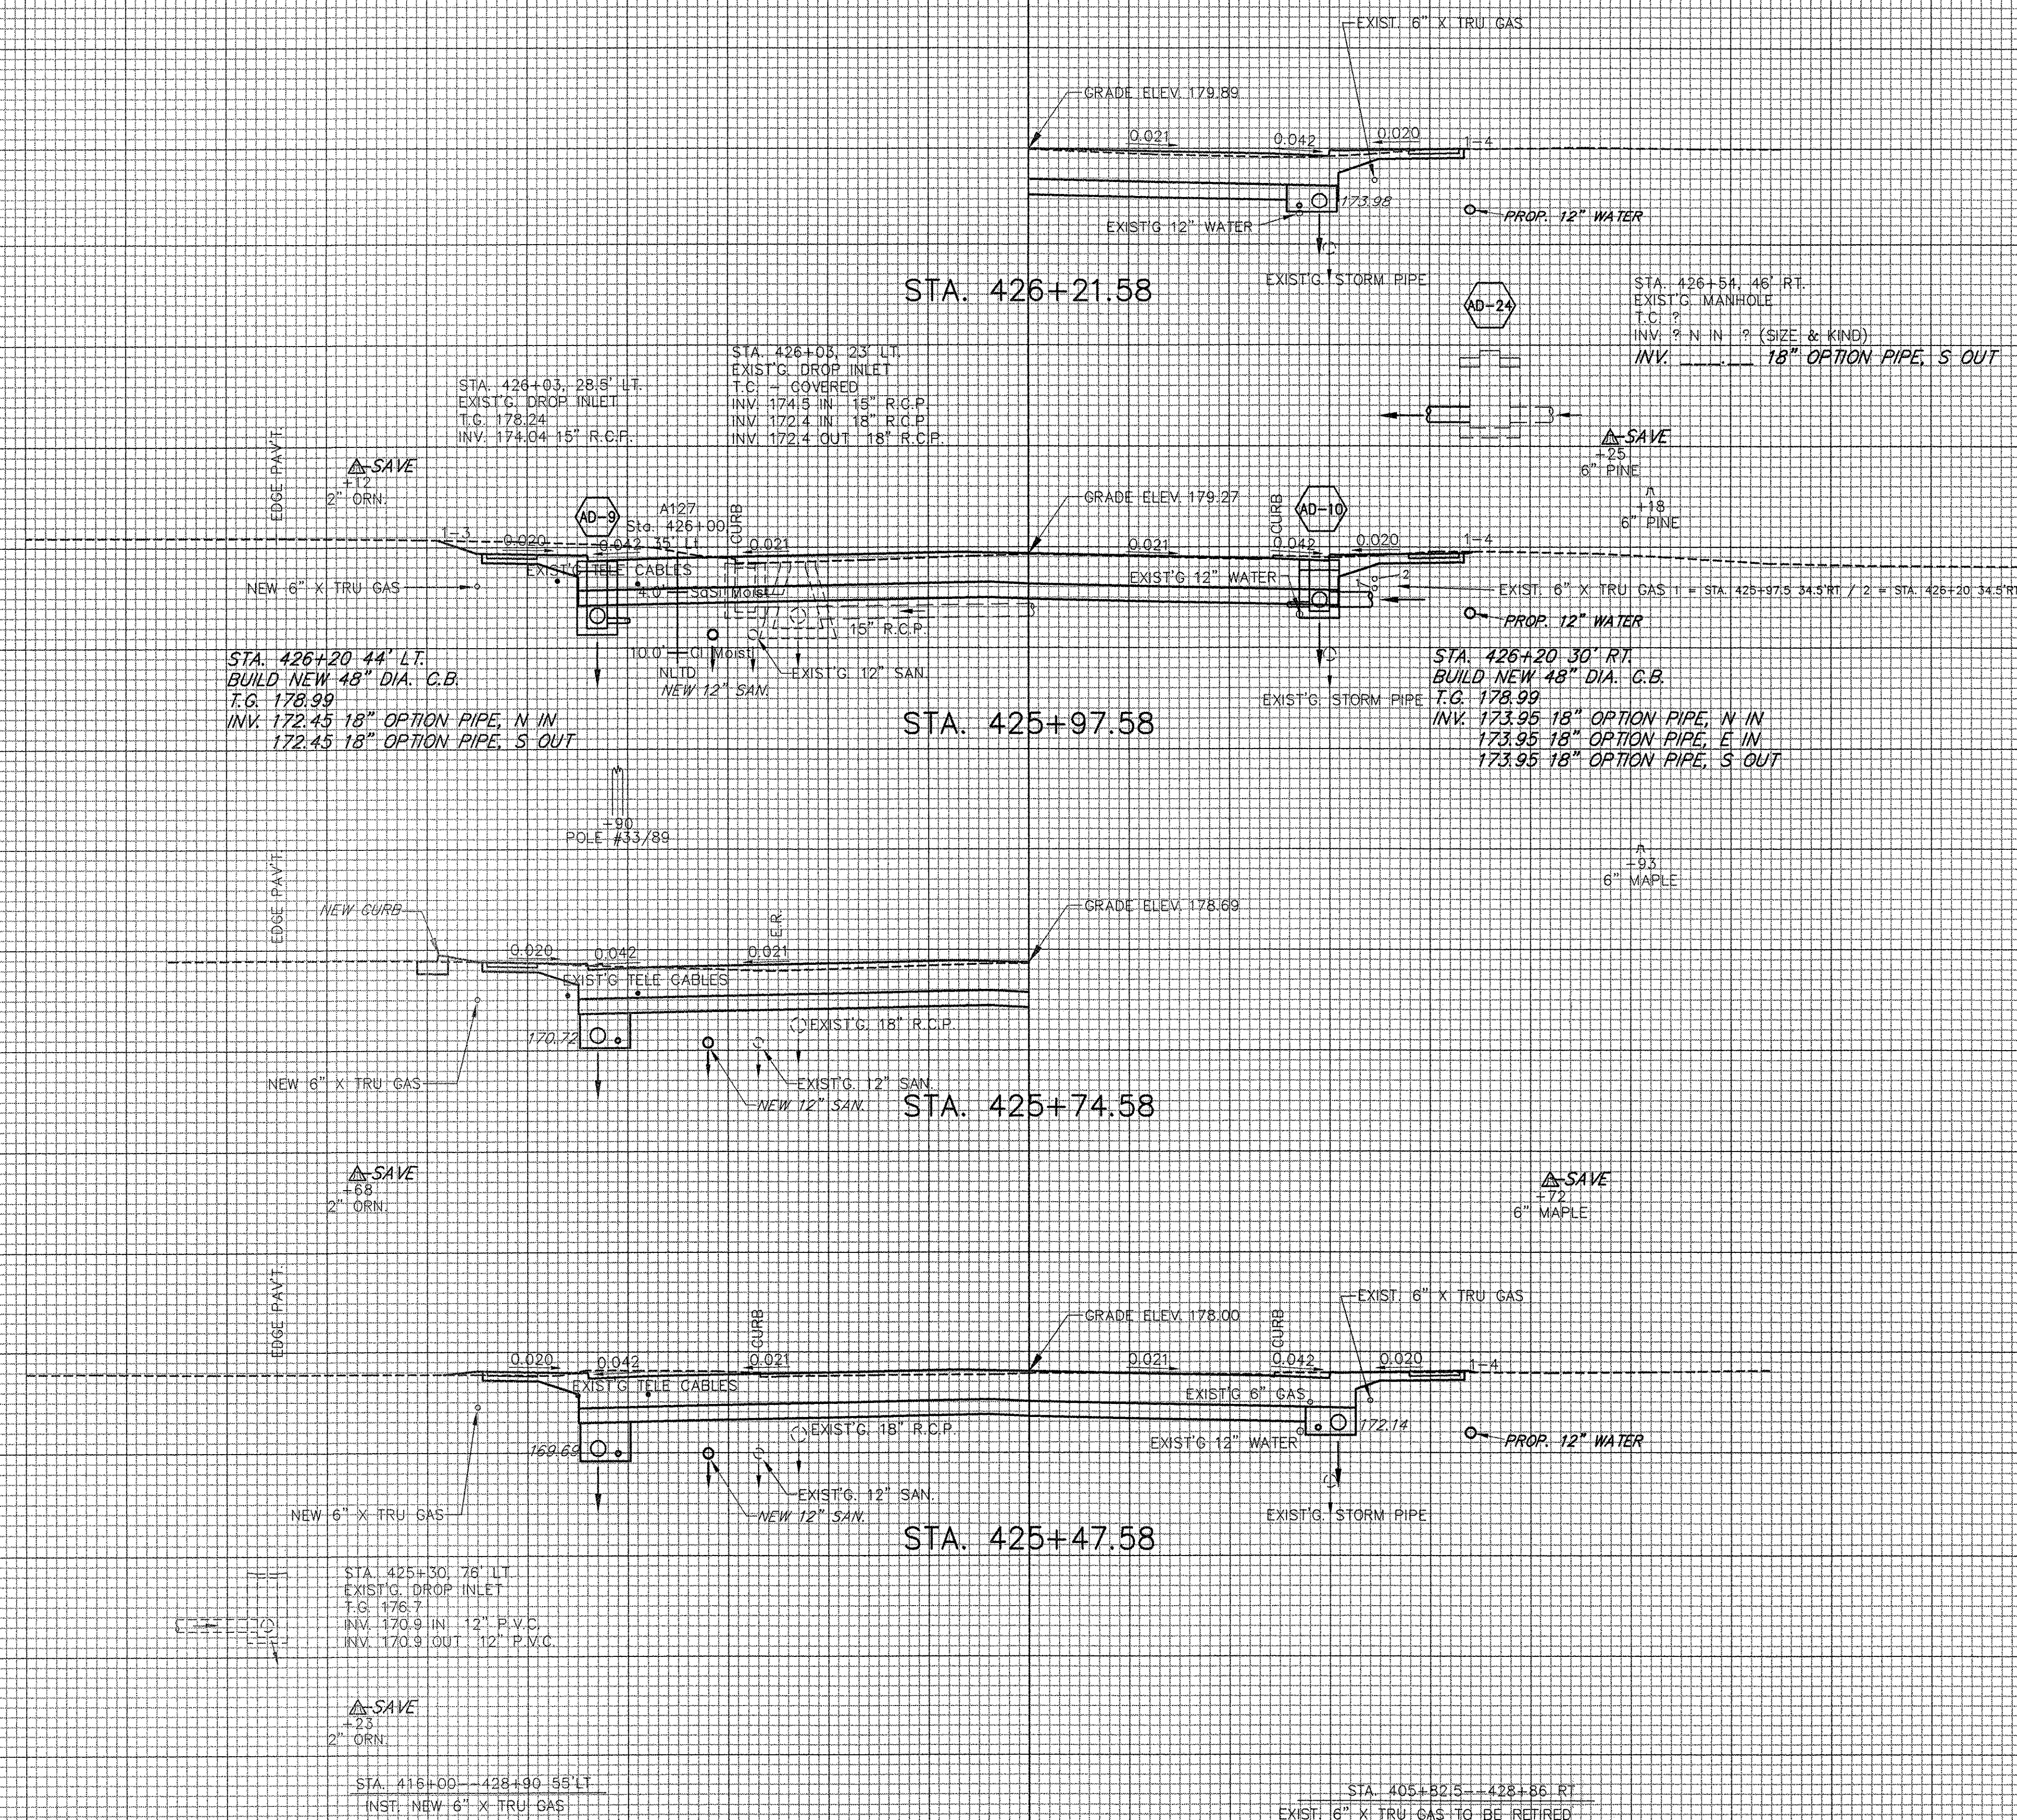

SHELBURNE - SOUTH BURLINGTON
STA. 425+48 TO STA. 426+22
SURVEYED BY V.S.C. INC. DATE
DRAWN BY E.A.A. INC. DATE
TRACED BY E.A.A. INC. DATE
PROJECT NH-EGC-019-4(28)
CROSS-SECTION DWG. NO. 121
SHEET 213 OF 283