



K:\6330006 (US Rte 7 Shelburne Rd)\AS BUILT\SWATER\SEWER\2000_C63-pl5(29).DWG, Layout1, 9/5/2006 11:08:03 AM, parrilla, VT ERL HP 1055cm ExtalPage-Draft1.pcl

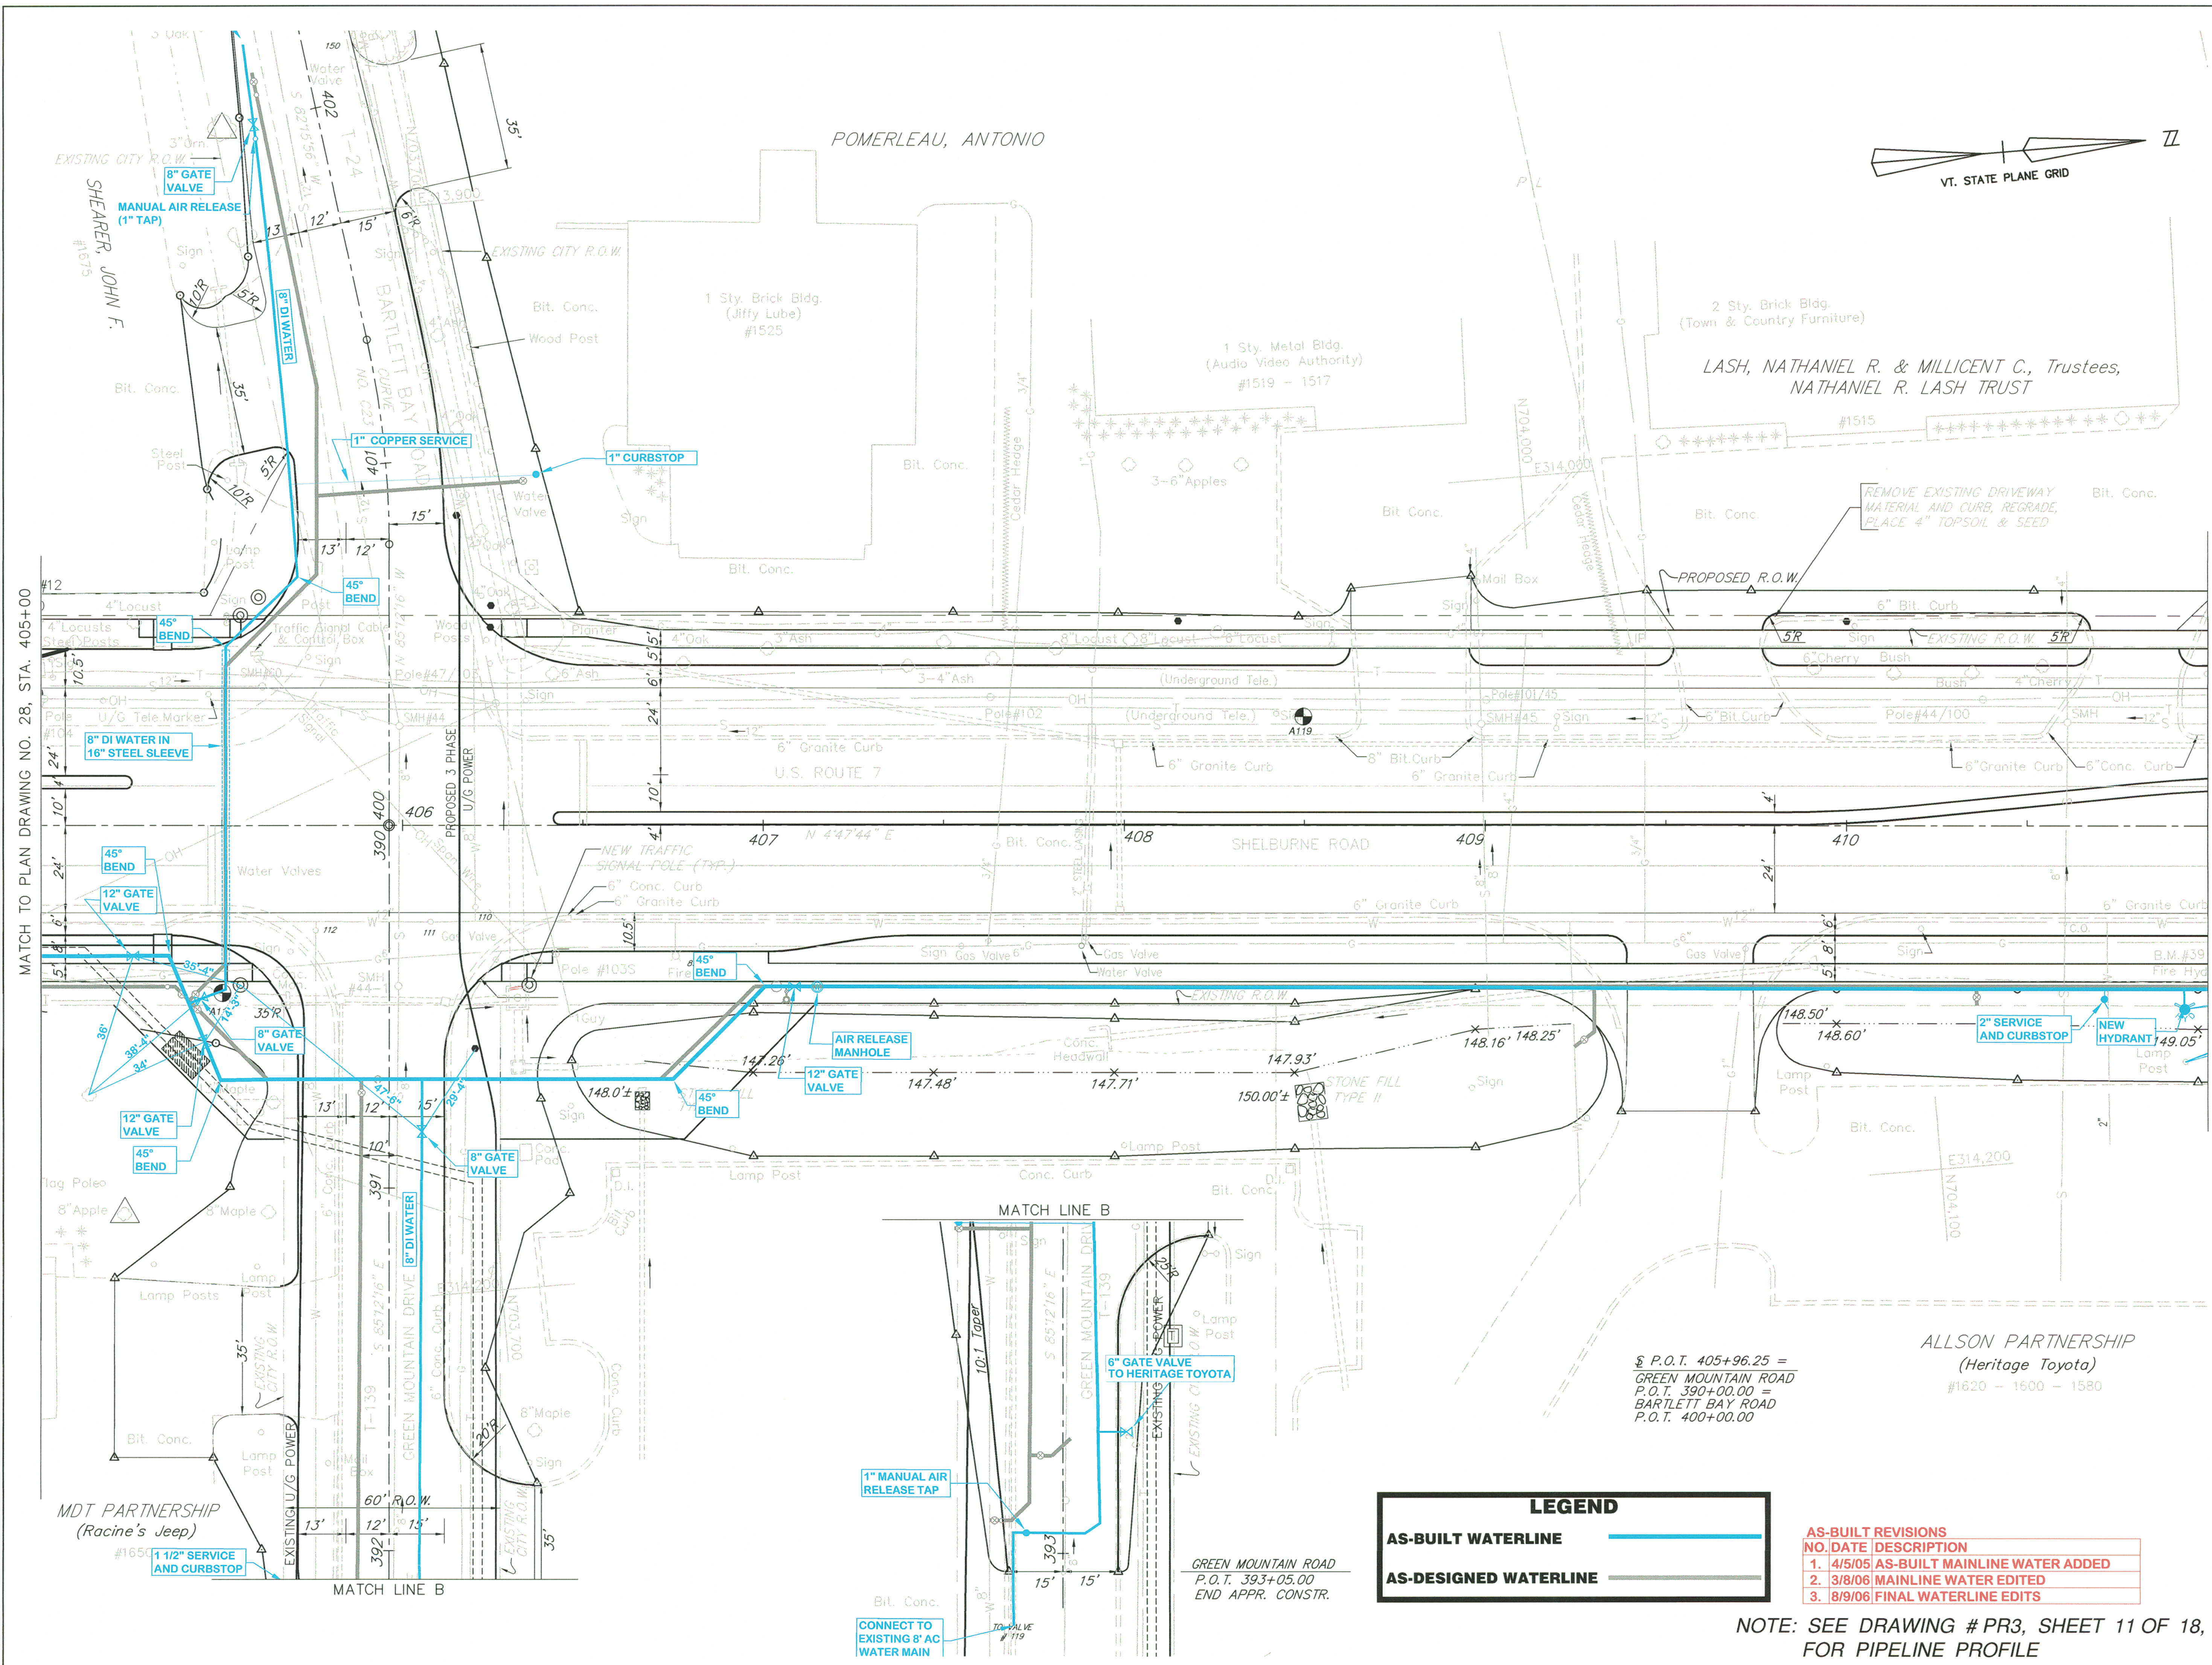

CHAMPLAIN WATER DISTRICT
403 Queen City Park Road
South Burlington, VT. 05403
Phone: (802) 864-7454
Fax: (802) 864-0435

Dedicated to Quality
Water and Service

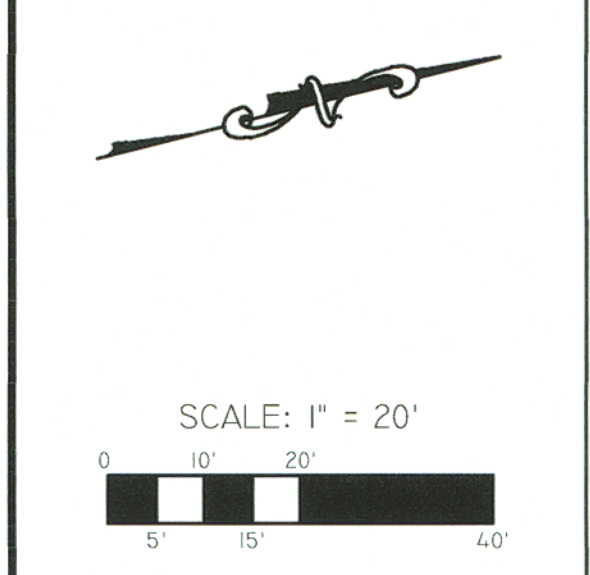

REVISIONS		
REV. #	DATE	BY

CONTRACT #63
WATER MAIN RELOCATION
U.S. ROUTE 7
"SHELBERNE ROAD"
SOUTH BURLINGTON,
VERMONT
PLAN VIEW
STA. 405+00 TO 411+00

250 OF 283
DATE: APRIL, 2002
DESIGNED BY: RAP
DRAWN BY: EJP
CHECKED BY: RAP
APPROVED BY: RAP
FILE NAME: 2000_C63-pl5(29)
SHEET 9 OF 18
DRAWING No.

PL5

LEGEND

AS-BUILT WATERLINE

AS-DESIGNED WATERLINE

AS-BUILT REVISIONS	
NO.	DATE DESCRIPTION
1.	4/5/05 AS-BUILT MAINLINE WATER ADDED
2.	3/8/06 MAINLINE WATER EDITED
3.	8/9/06 FINAL WATERLINE EDITS

NOTE: SEE DRAWING # PR3, SHEET 11 OF 18,
FOR PIPELINE PROFILE