




SCALE: 1" = 20'

A horizontal scale bar with alternating black and white segments. The top is labeled 0, 10', and 20'. The bottom is labeled 5', 15', and 40'.

[illegible]

DISC

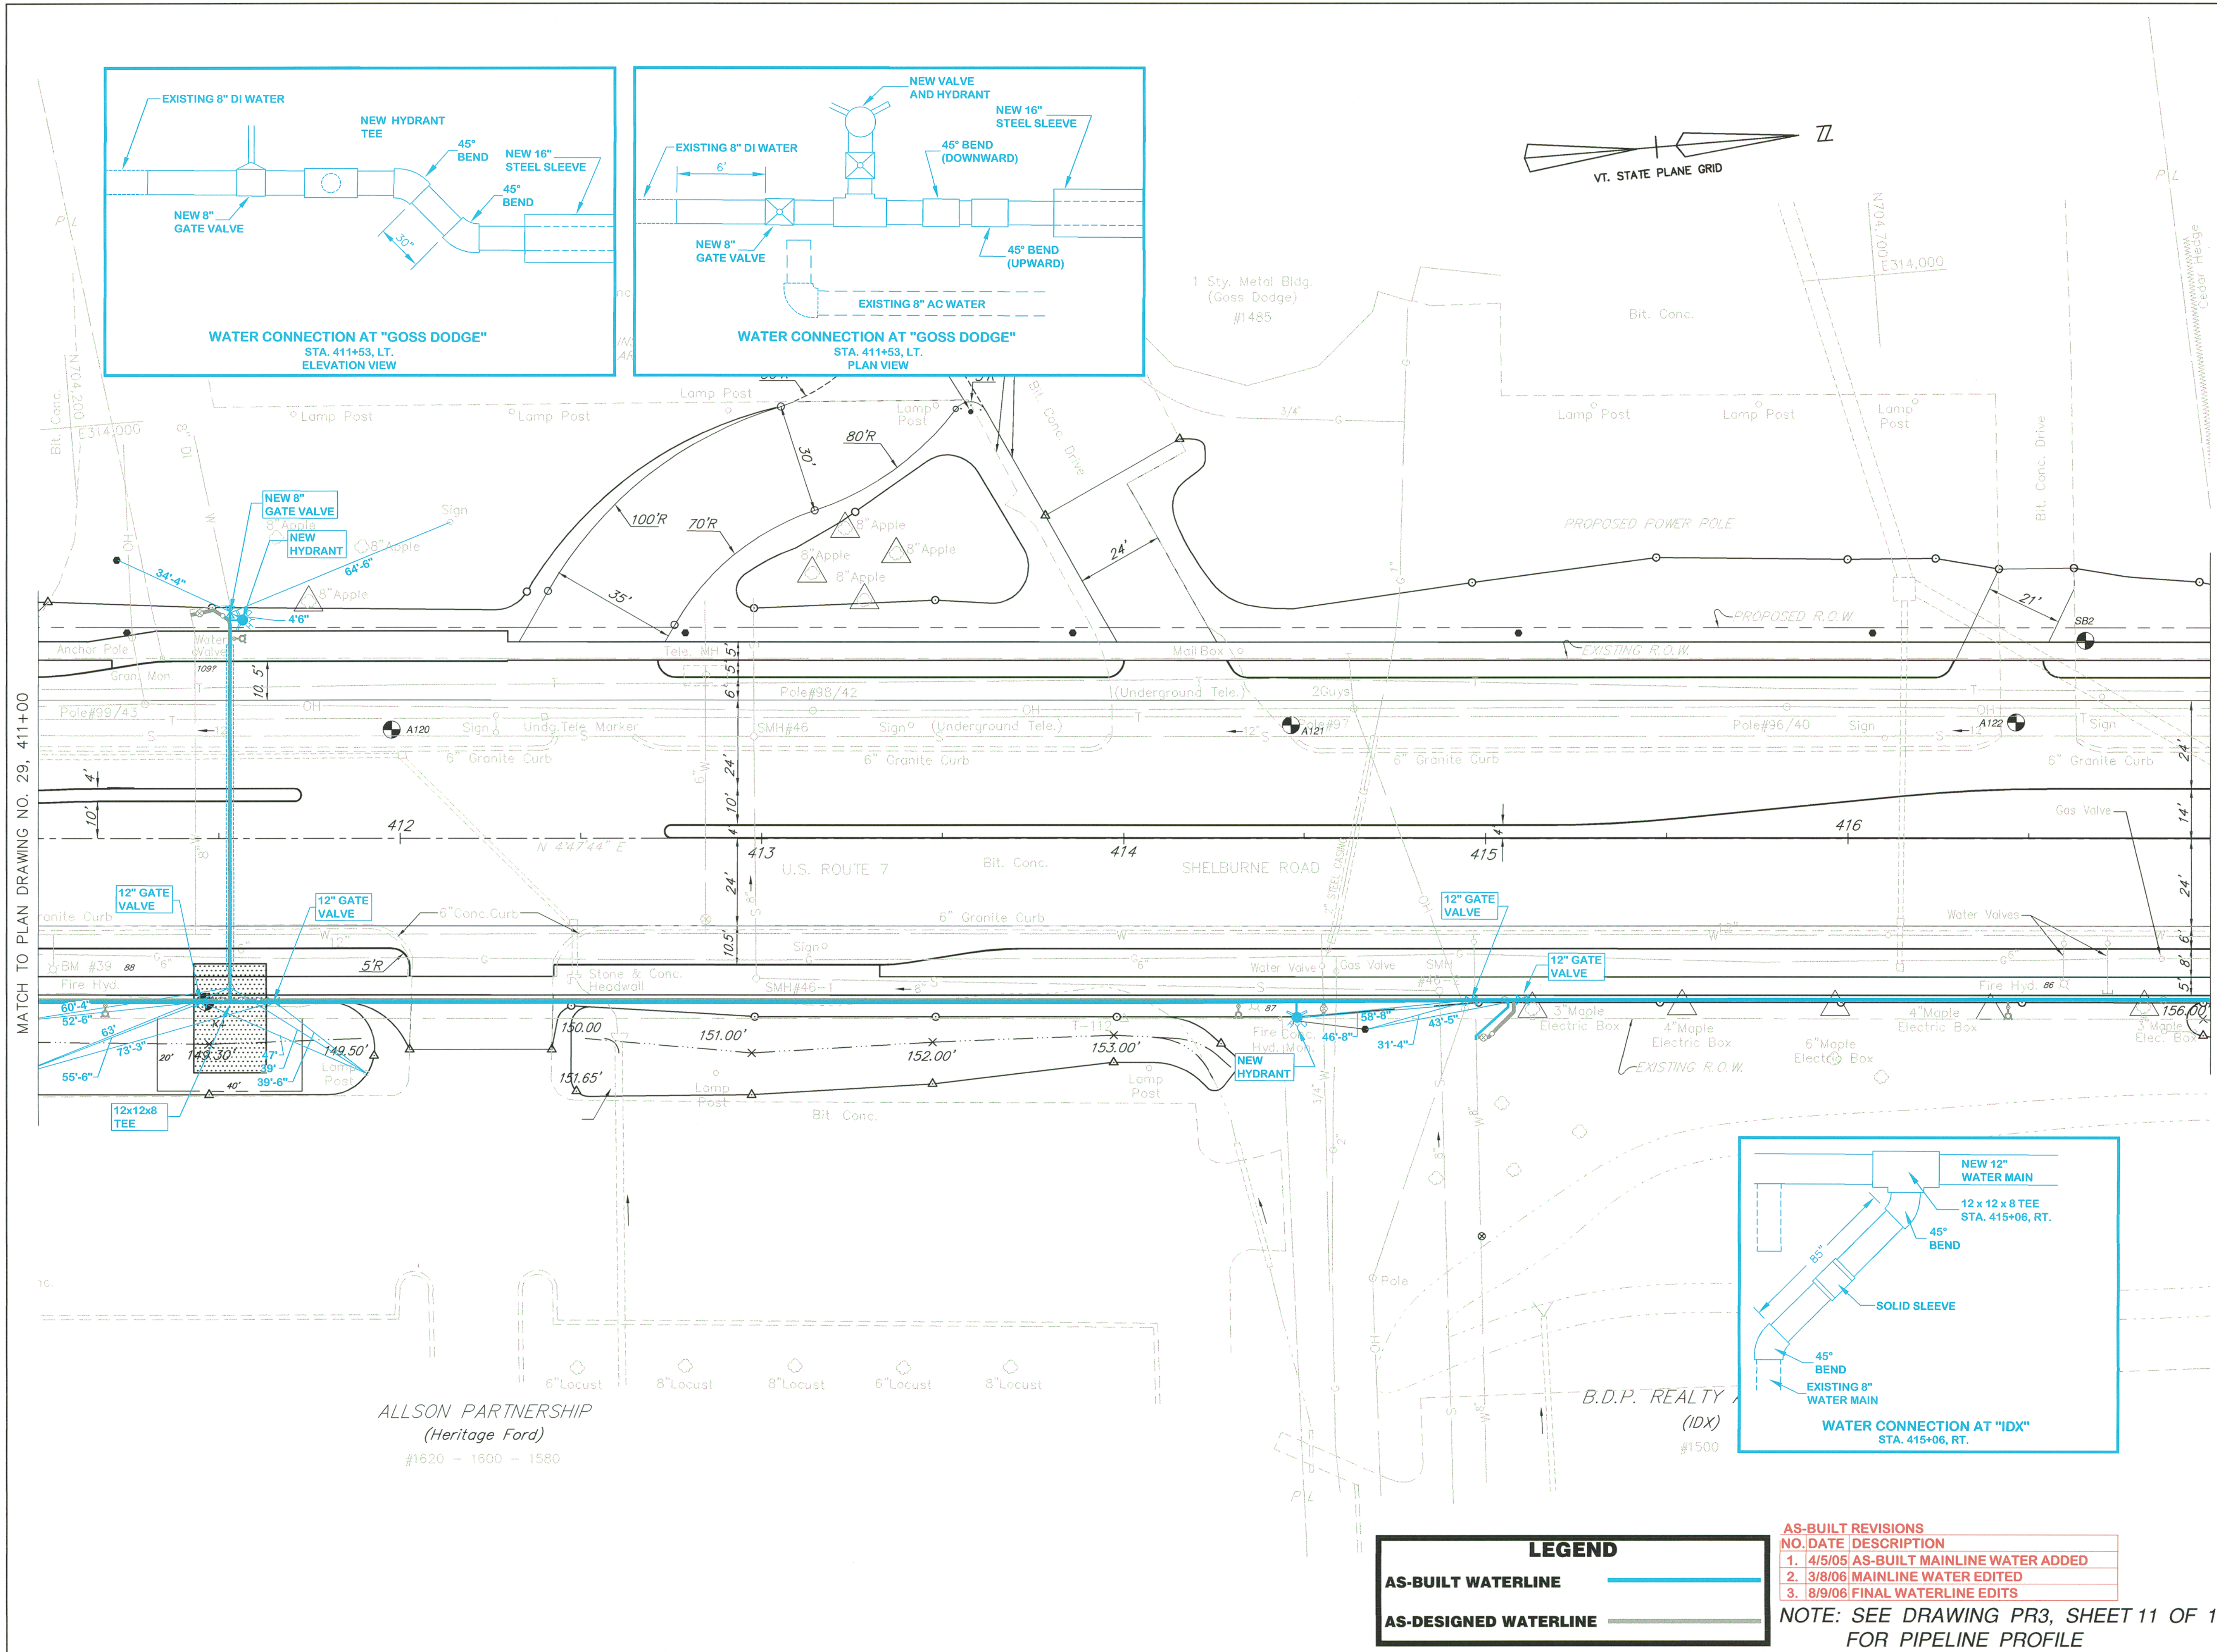

K:\6330008 (US Rte 7 Shelburne Rd)\AS-BUILT\SIWATER-SEWER\2000_C63-pl6(30).dwg, Layout1, 9/5/2006 11:10:28 AM, parmata, VT-BRL-HP1055cm East(Paper-Draft).pc3