

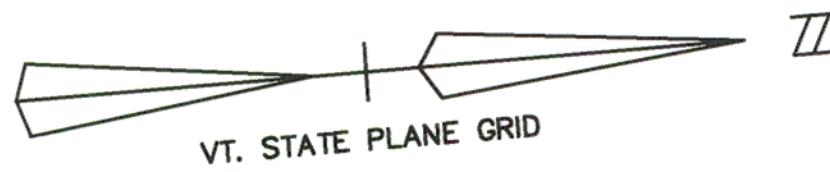
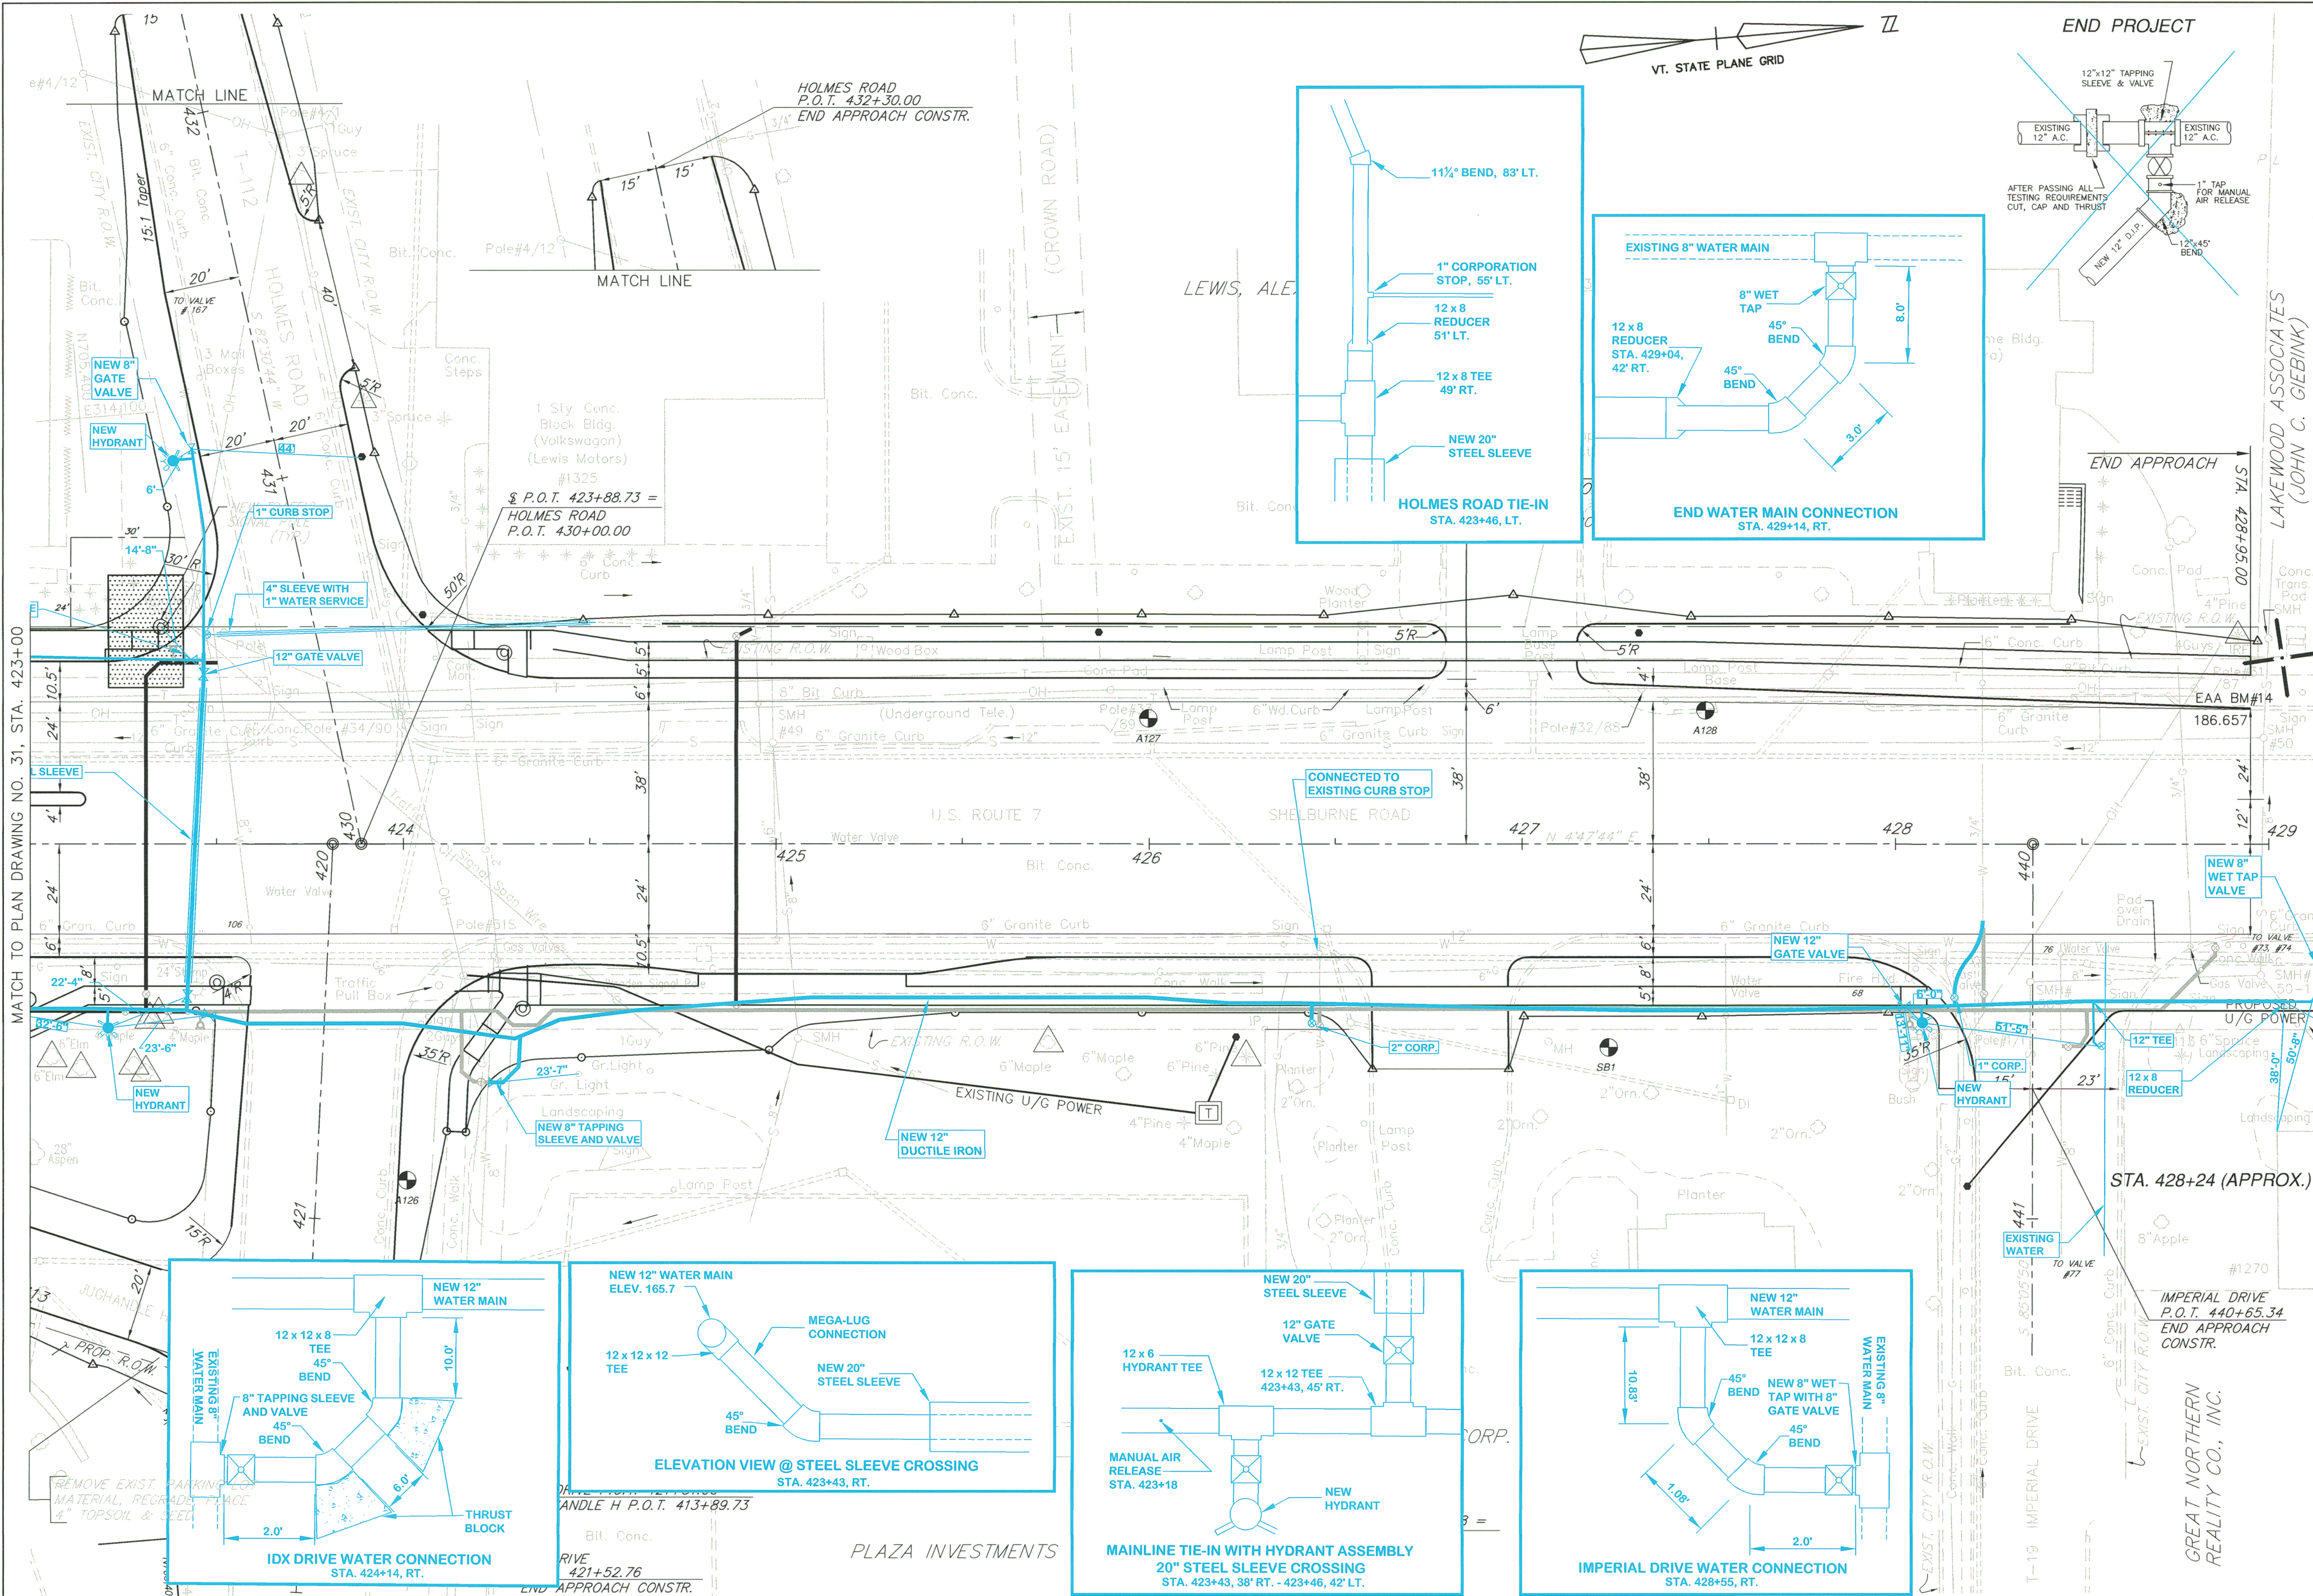
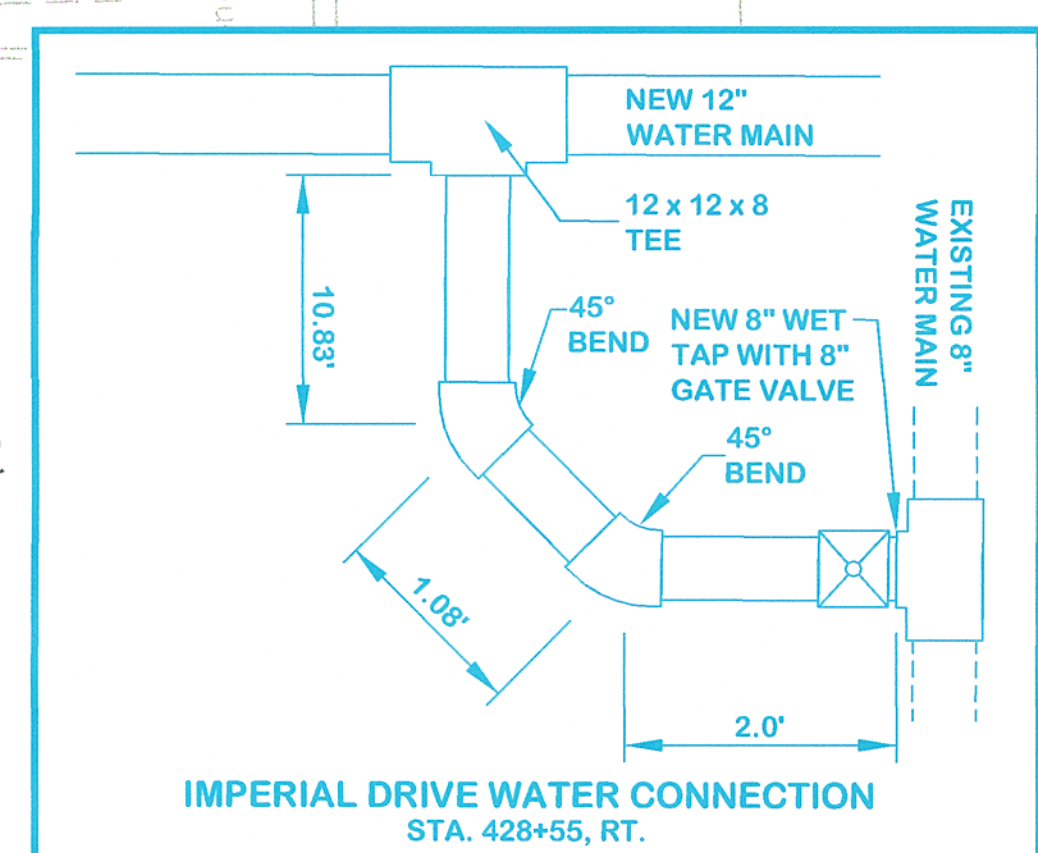
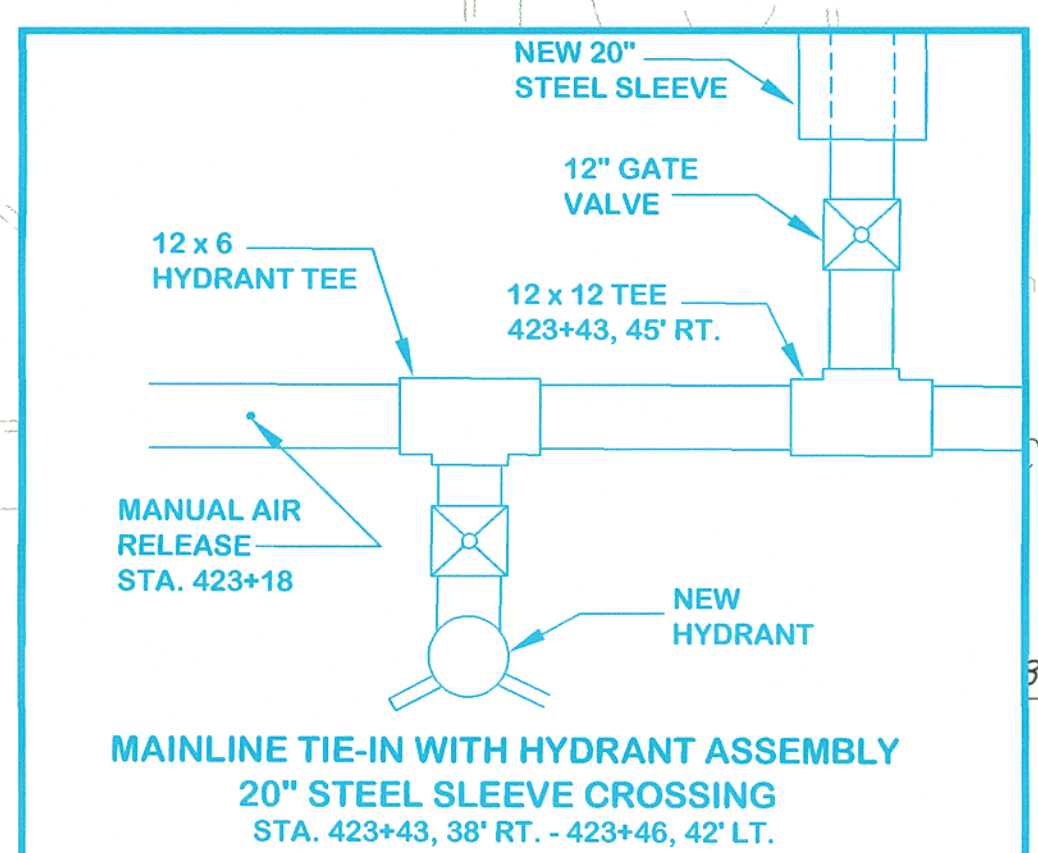
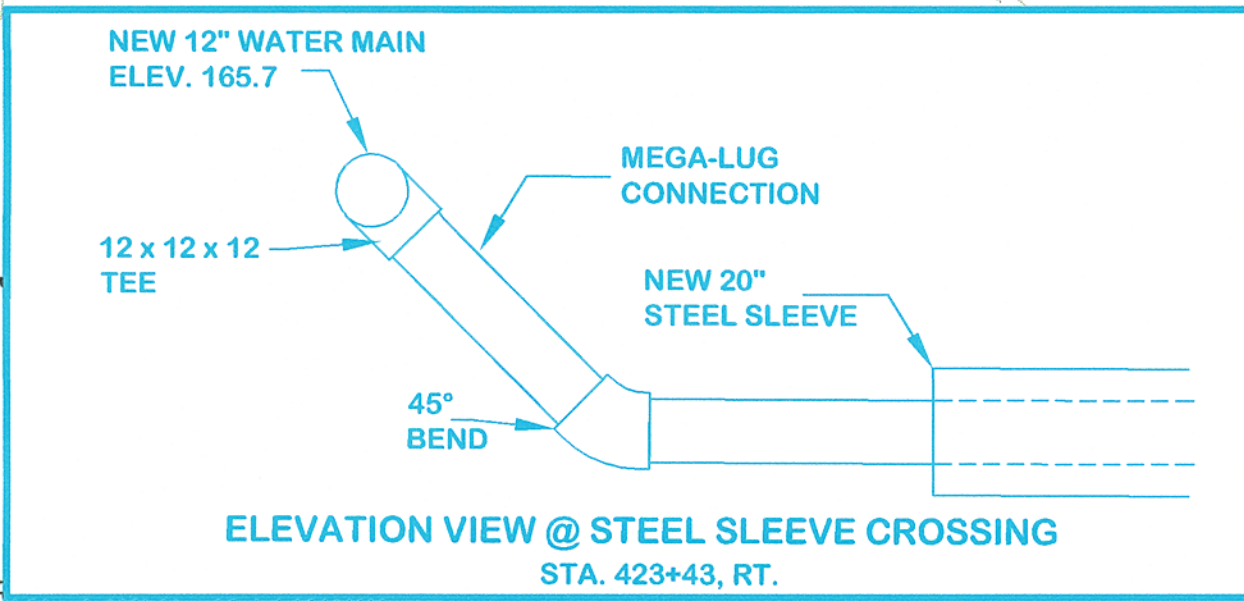
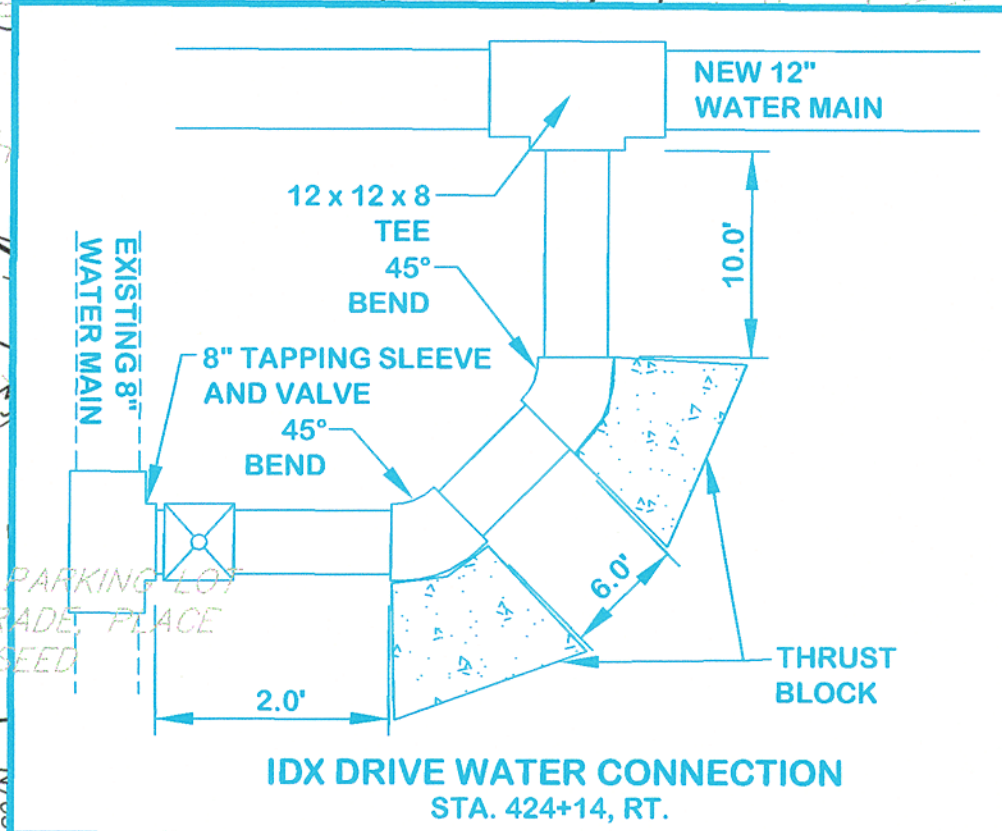
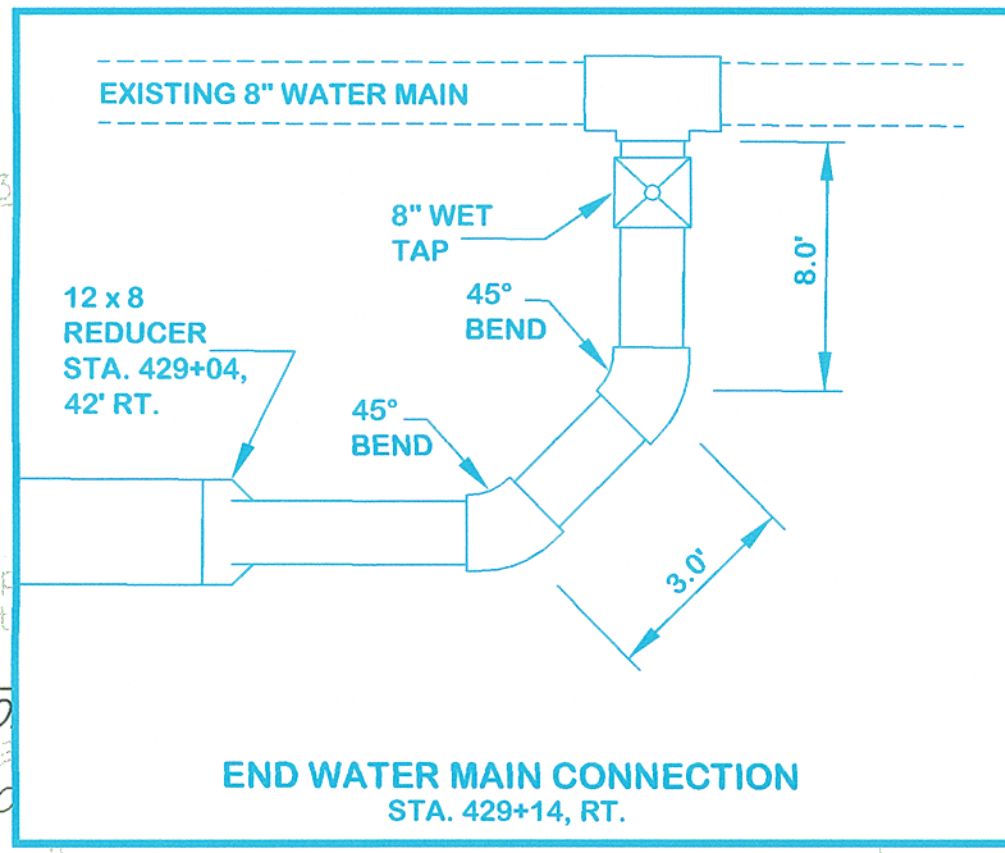


K:\630008 (US) Rte 7 Shelburne Rd\AS-BUILT\WATER-SEWER\2000C63-pl8(32).dwg, Layout1, 9/12/2008 11:16:42 AM, parmalia, VT:BRL-HP1055cm Email:Page-Draft1.plt

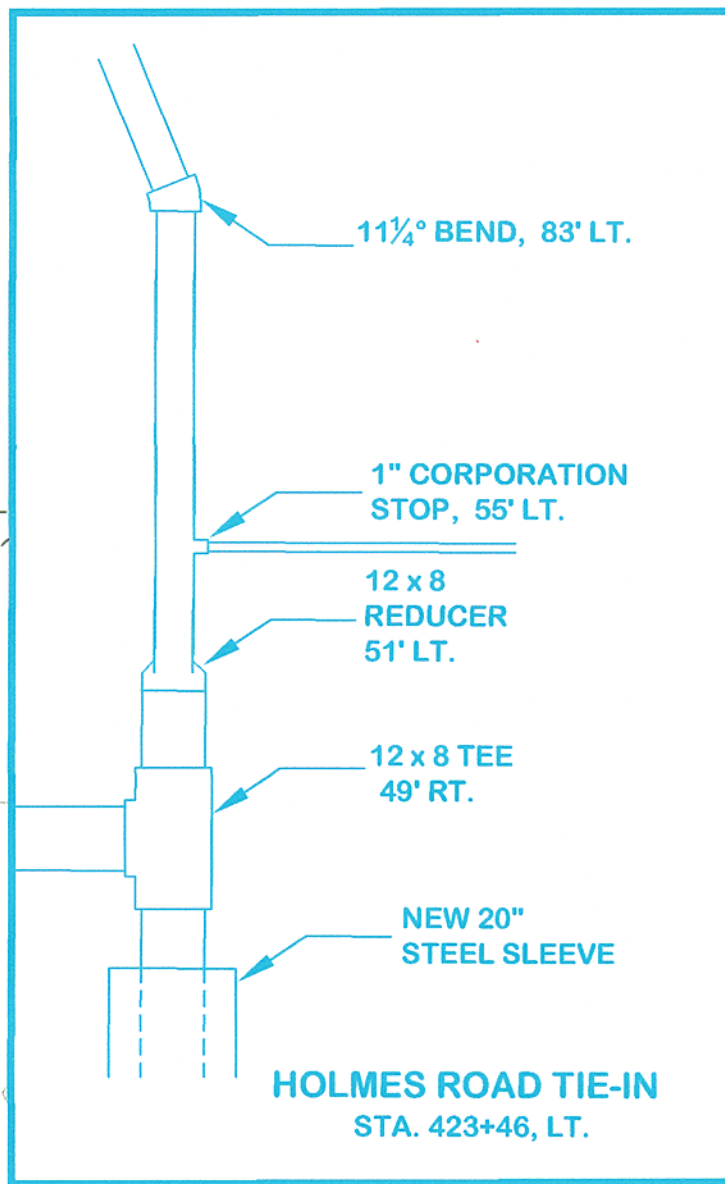

END PROJECT

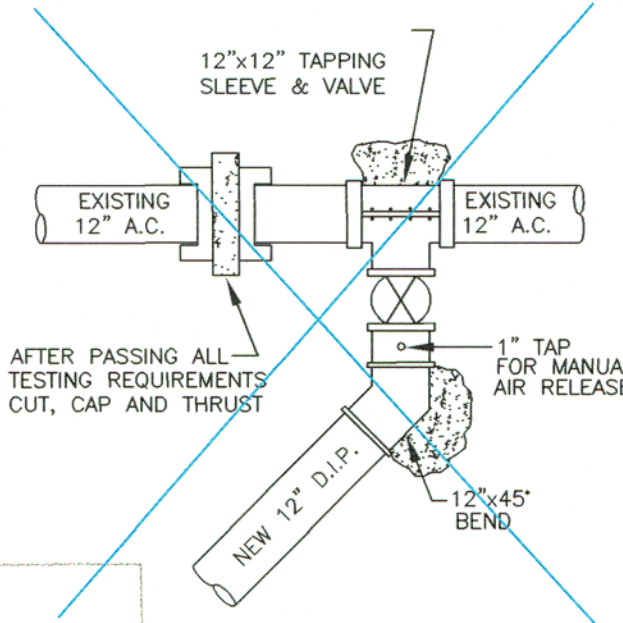


LEGEND	
AS-BUILT WATERLINE	
AS-DESIGNED WATERLINE	


AS-BUILT REVISIONS	
NO.	DATE DESCRIPTION
1.	4/5/05 AS-BUILT MAINLINE WATER ADDED
2.	3/8/06 MAINLINE WATER EDITED

NOTE: SEE DRAWING PR4, SHEET 14 OF 18, FOR PIPELINE PROFILE

CHAMPLAIN WATER DISTRICT
403 Queen City Park Road
South Burlington, VT 05403
Phone: (802) 864-7454
Fax: (802) 864-0435

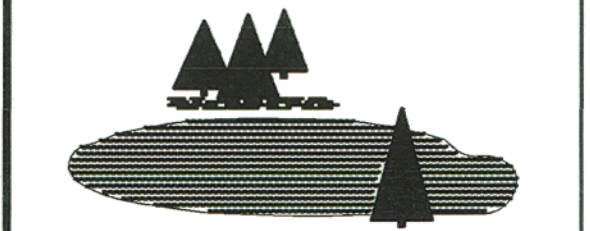

Dedicated to Quality
Water and Service

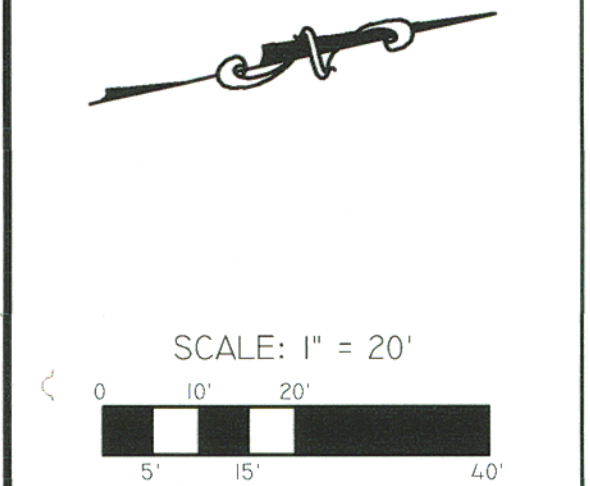

REVISIONS		
REV. #	DATE	BY

CONTRACT #63
WATER MAIN RELOCATION
U.S. ROUTE 7
"SHELburne ROAD"
SOUTH BURLINGTON,
VERMONT
PLAN VIEW
STA. 423+00 TO 429+00

254 of 283
DATE: APRIL, 2002
DESIGNED BY: SGW
DRAWN BY: EJP
CHECKED BY: RAP
APPROVED BY: RAP
FILE NAME: 2000C63-pl8(32)
SHEET 13 OF 18
DRAWING No.

PL8