
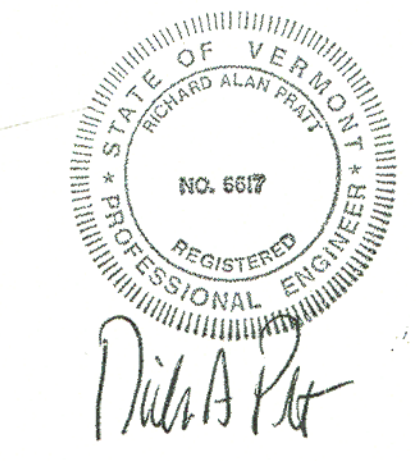


EJP 4/15/04.
CROSSING REDESIGNED
TO CROSS HOLMES RD.

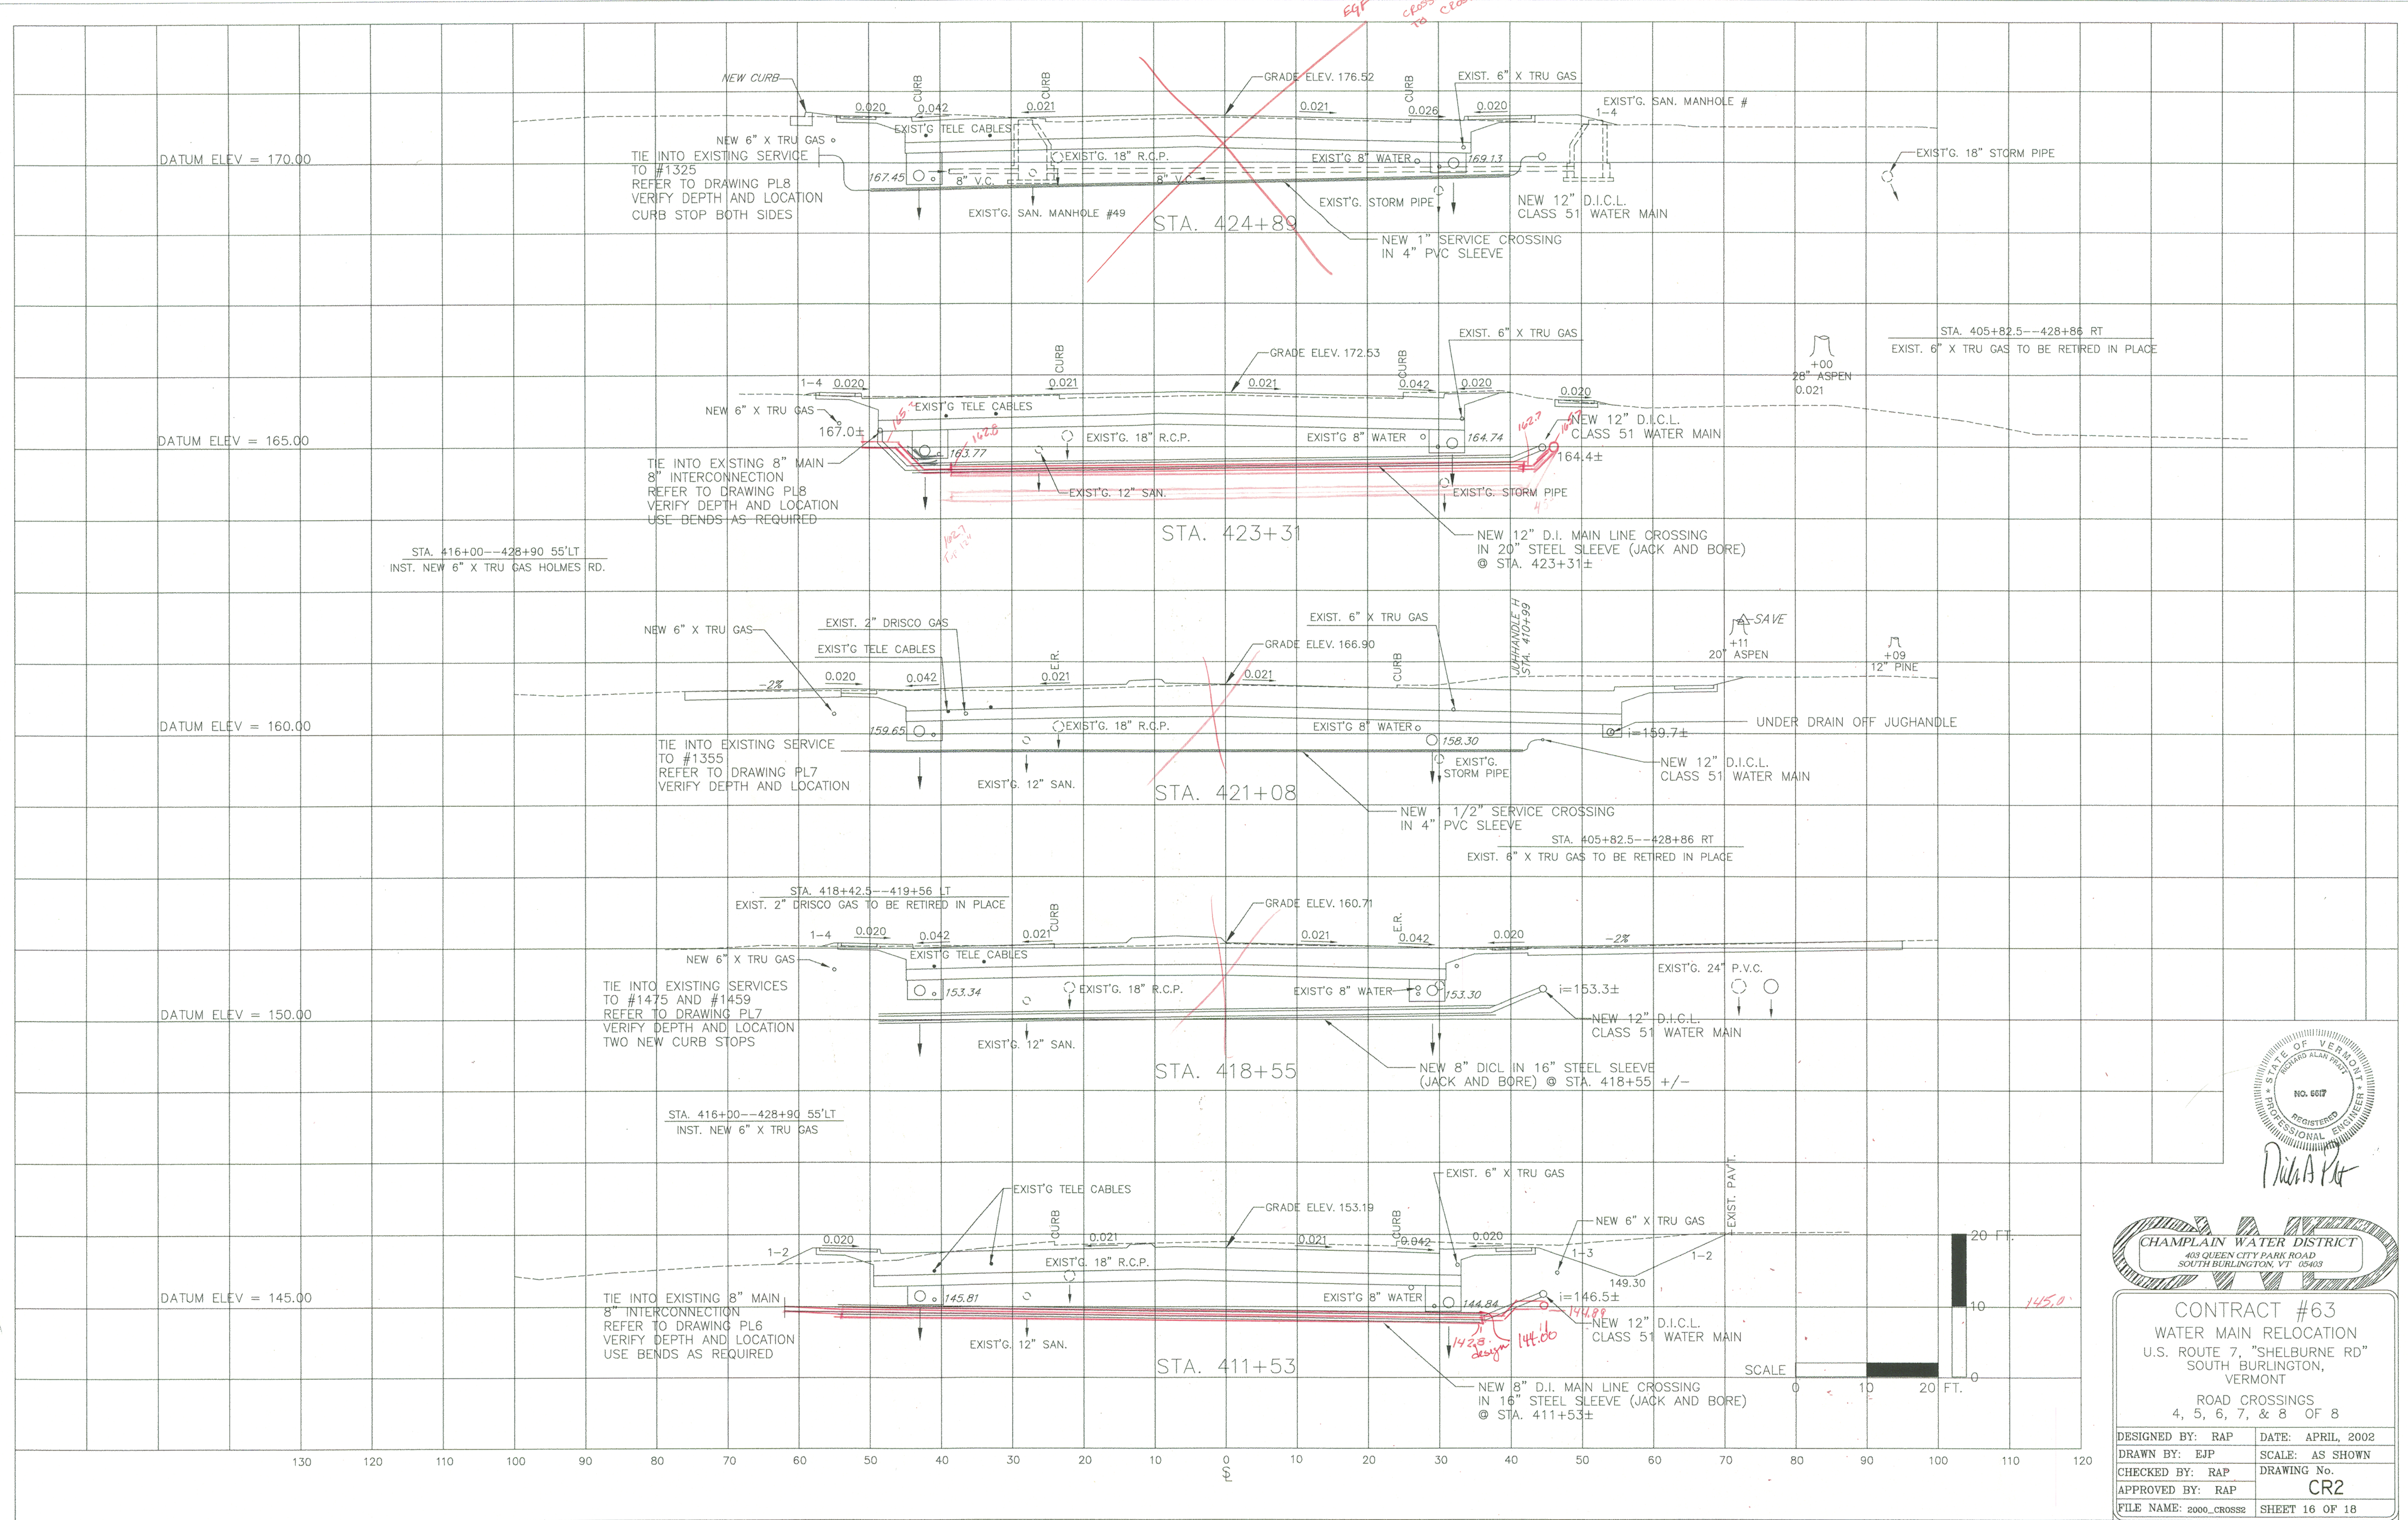

CHAMPLAIN WATER DISTRICT
403 QUEEN CITY PARK ROAD
SOUTH BURLINGTON, VT 05403

CONTRACT #63
WATER MAIN RELOCATION
U.S. ROUTE 7, "SHELburne RD"
SOUTH BURLINGTON,
VERMONT

ROAD CROSSINGS
4, 5, 6, 7, & 8 OF 8

DESIGNED BY: RAP	DATE: APRIL, 2002
DRAWN BY: EJP	SCALE: AS SHOWN
CHECKED BY: RAP	DRAWING No.
APPROVED BY: RAP	CR2
FILE NAME: 2000_CROSS2	SHEET 16 OF 18