


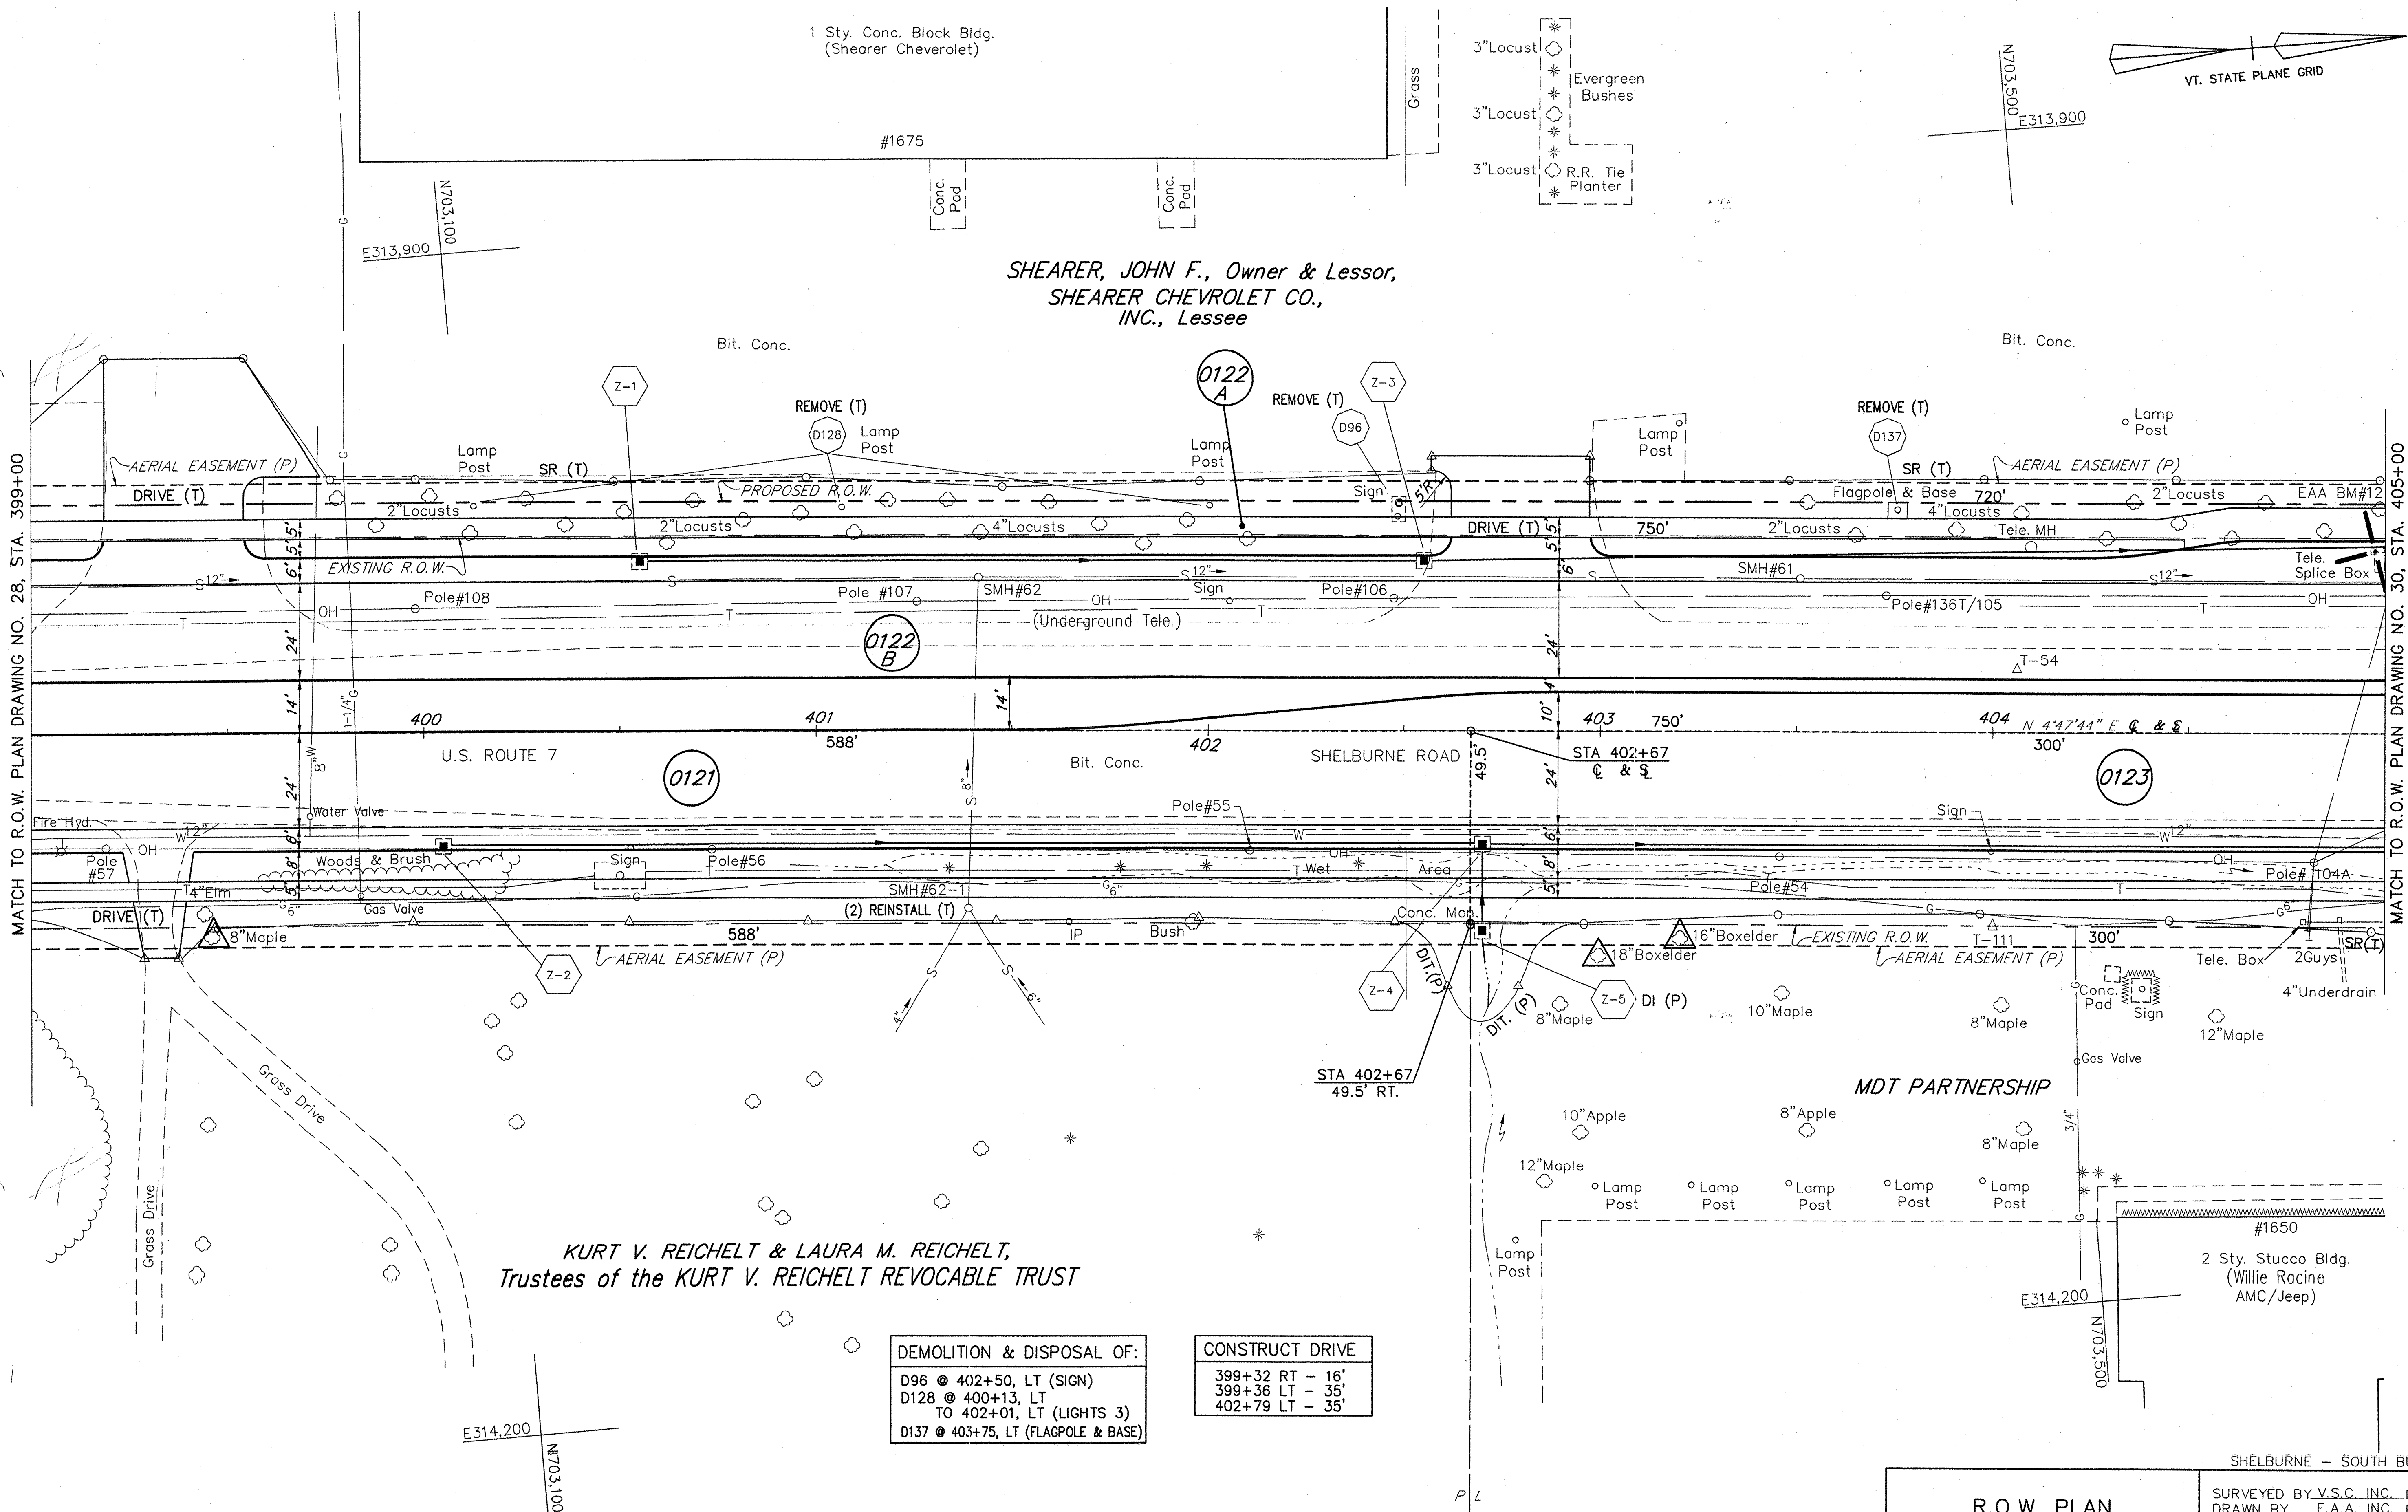

DATUM
VERTICAL NGVD 1929
HORIZONTAL NAD 1927

DEMOLITION & DISPOSAL OF:
D96 @ 402+50, LT (SIGN)
D128 @ 400+13, LT
TO 402+01, LT (LIGHTS 3)
D137 @ 403+75, LT (FLAGPOLE & BASE)

CONSTRUCT DRIVE
399+32 RT - 16'
399+36 LT - 35'
402+79 LT - 35'

SCALE IN FEET
0 20 40

R.O.W. PLAN

THIS SHEET TO BE USED
FOR R.O.W. INFORMATION ONLY.

SURVEYED BY V.S.C. INC. DATE
DRAWN BY E.A.A. INC. DATE
TRACED BY E.A.A. INC. DATE

PROJECT F-EGC-019-4(19)
R.O.W. DRAWING NO. 29
SHEET NO. 26 OF 283

C.O.#9, 5/26/00