


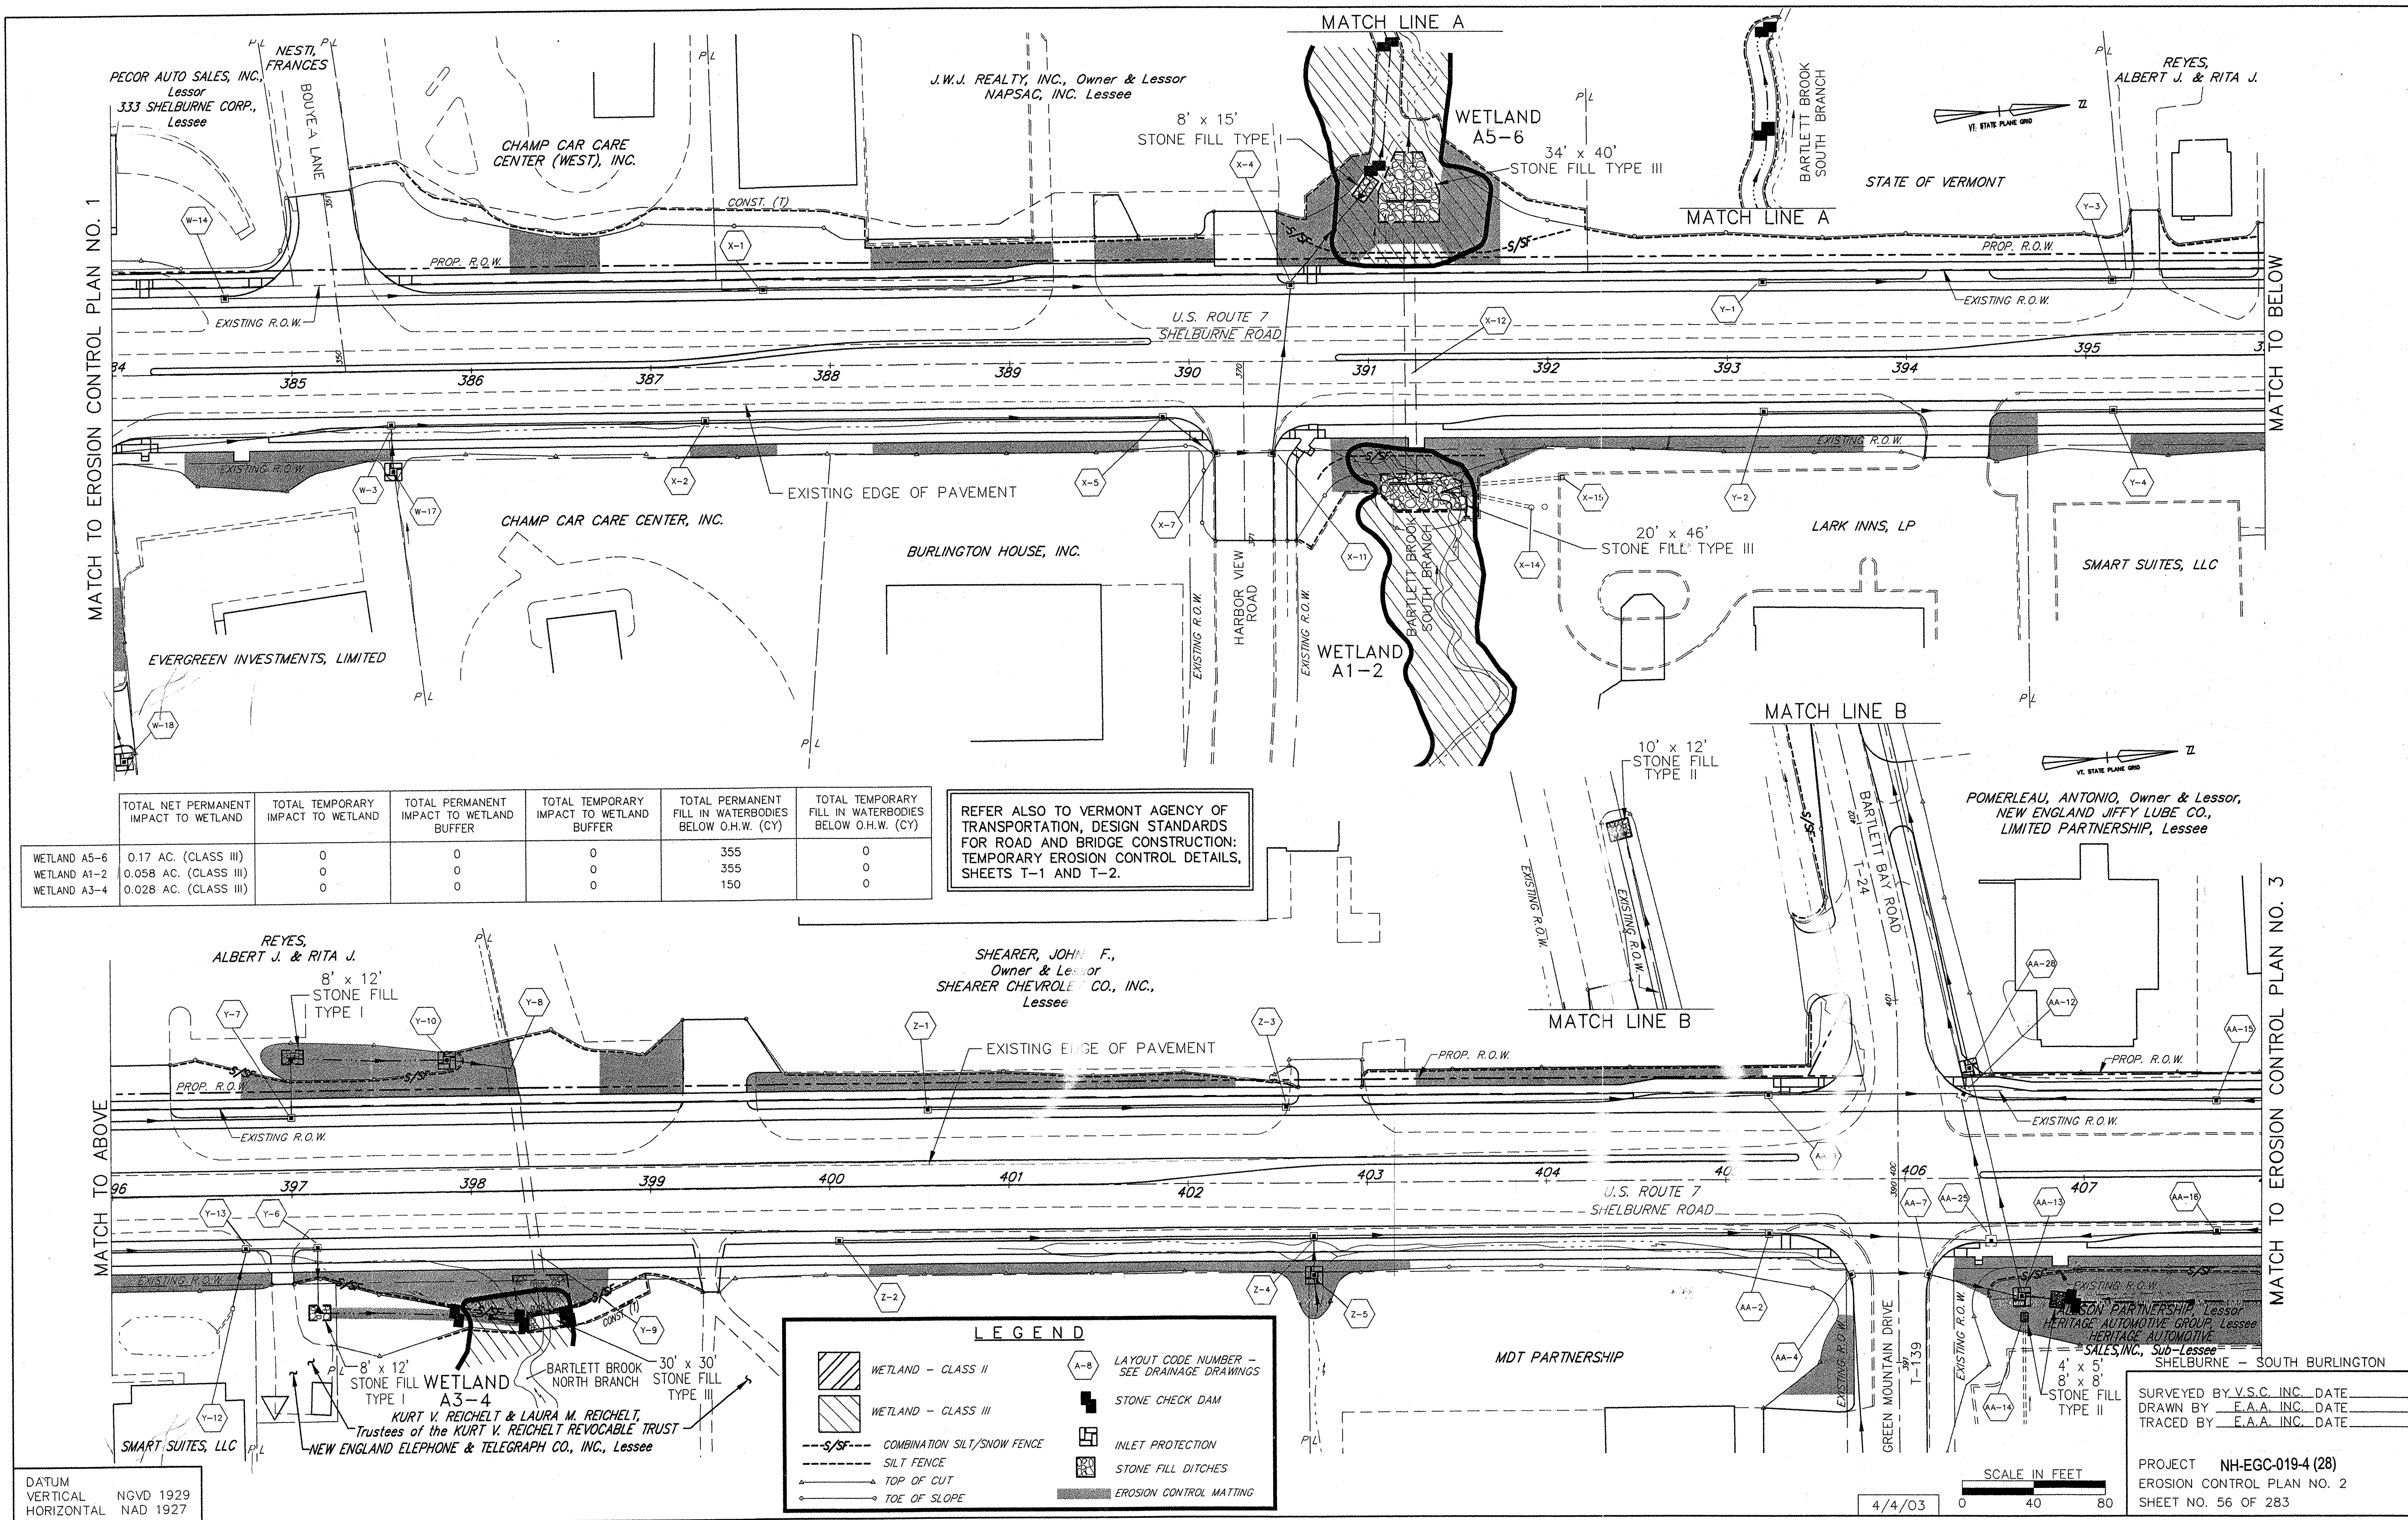

	TOTAL NET PERMANENT IMPACT TO WETLAND	TOTAL TEMPORARY IMPACT TO WETLAND	TOTAL PERMANENT IMPACT TO WETLAND BUFFER	TOTAL TEMPORARY IMPACT TO WETLAND BUFFER	TOTAL PERMANENT FILL IN WATERBODIES BELOW O.H.W. (CY)	TOTAL TEMPORARY FILL IN WATERBODIES BELOW O.H.W. (CY)
WETLAND A5-6	0.17 AC. (CLASS III)	0	0	0	355	0
WETLAND A1-2	0.058 AC. (CLASS III)	0	0	0	355	0
WETLAND A3-4	0.028 AC. (CLASS III)	0	0	0	150	0

REFER ALSO TO VERMONT AGENCY OF TRANSPORTATION, DESIGN STANDARDS FOR ROAD AND BRIDGE CONSTRUCTION: TEMPORARY EROSION CONTROL DETAILS, SHEETS T-1 AND T-2.

LEGEND

WETLAND - CLASS II

WETLAND - CLASS III

COMBINATION SILT/SNOW FENCE

SILT FENCE

TOP OF CUT

TOE OF SLOPE

A-8

LAYOUT CODE NUMBER - SEE DRAINAGE DRAWINGS

STONE CHECK DAM

INLET PROTECTION

STONE FILL DITCHES

EROSION CONTROL MATTING

DATUM
VERTICAL NGVD 1929
HORIZONTAL NAD 1927

SCALE IN FEET
0 40 80
4/4/03

SURVEYED BY V.S.C. INC. DATE
DRAWN BY E.A.A. INC. DATE
TRACED BY E.A.A. INC. DATE
PROJECT NH-EGC-019-4 (28)
EROSION CONTROL PLAN NO. 2
SHEET NO. 56 OF 283