


DATUM
VERTICAL NGVD 1929
HORIZONTAL NAD 1927

- NOTES:
1. UNDERGROUND UTILITY LOCATIONS ARE PLOTTED BASED ON THE BEST AVAILABLE INFORMATION. LOCATIONS SHOULD BE VERIFIED BY THE CONTRACTOR BEFORE WORK.
 2. SEE PLAN NOTES DRAWING NO. 1 FOR PLAN NOTES AND GENERAL NOTES.

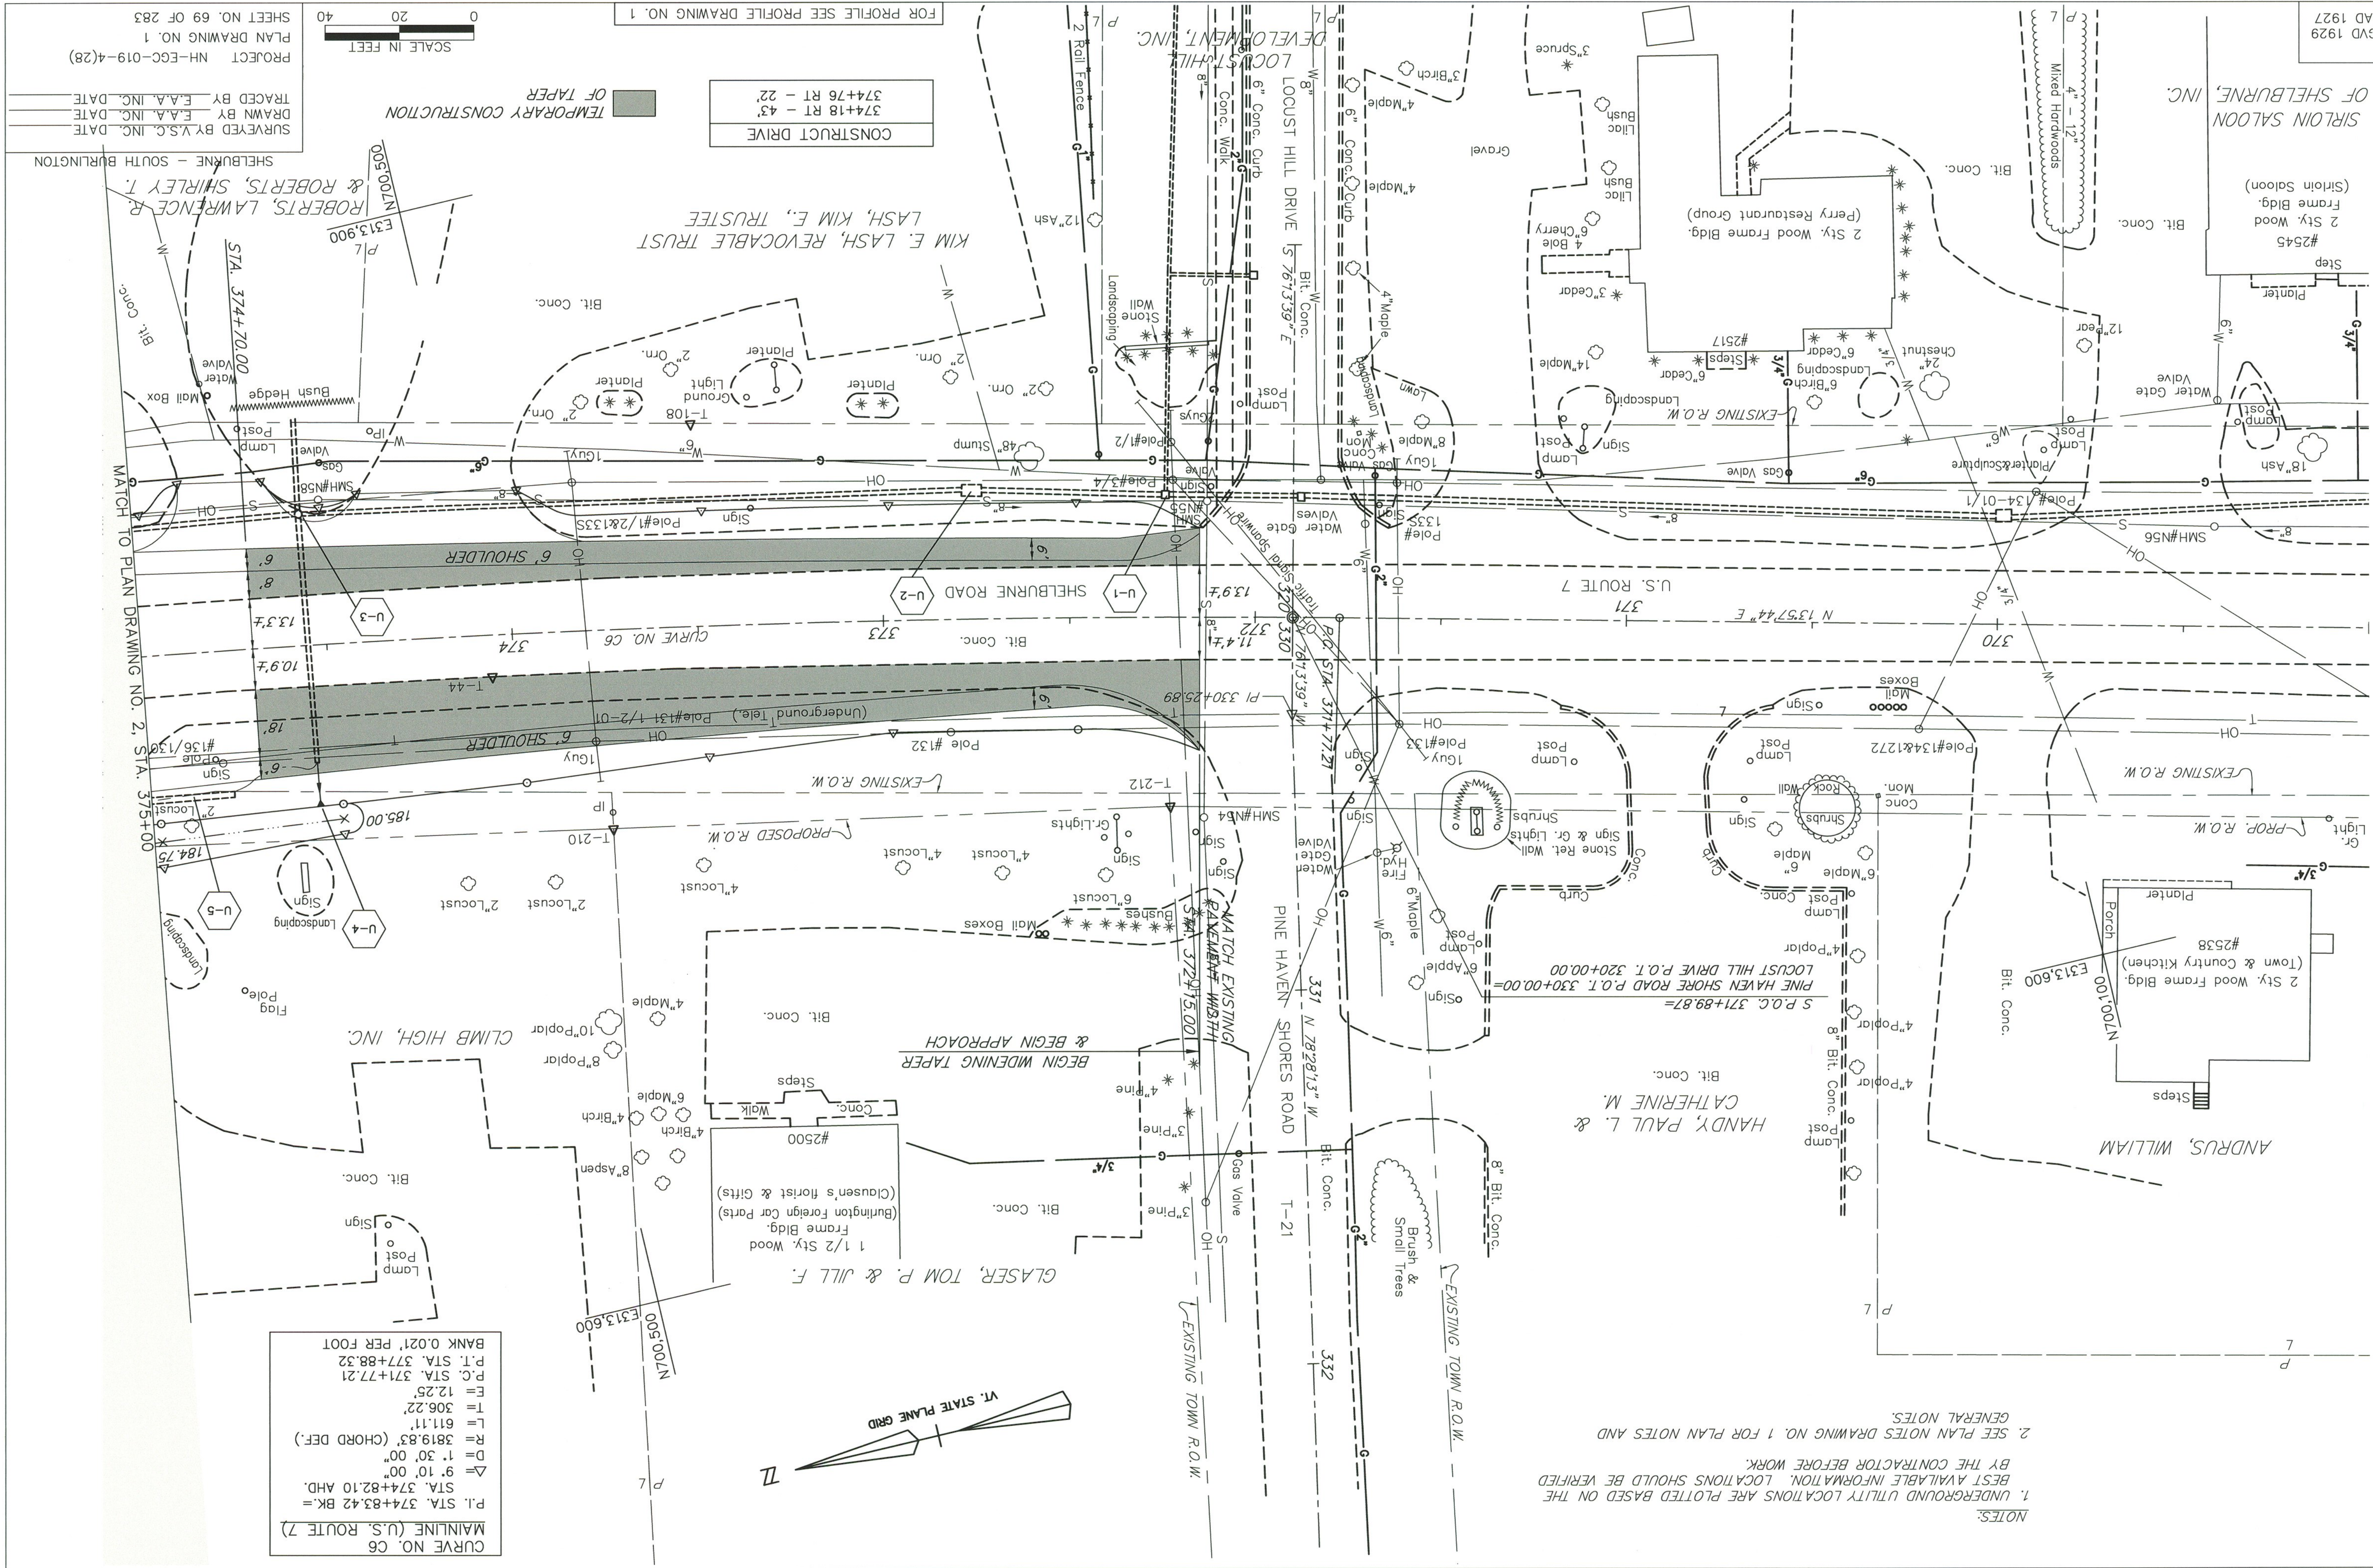

PROJECT NH-EGC-019-4(28)
PLAN DRAWING NO. 1
SURVEYED BY S.C. INC. DATE
DRAWN BY E.A.A. INC. DATE
TRACED BY E.A.A. INC. DATE

CURVE NO. C6
MAINLINE (U.S. ROUTE 7)
P.I. STA. 374+83.42 BK=
STA. 374+82.10 AHD.
D= 9' 10" 00"
R= 3819.83' (CHORD DEF.)
L= 611.11'
T= 306.22'
E= 12.25'
P.C. STA. 371+77.21
P.T. STA. 377+88.32
BANK 0.021' PER FOOT