


DATUM
VERTICAL NGVD 1929
HORIZONTAL NAD 1927



PORTLAND CEMENT
CONCRETE SIDEWALK - 5"
(MEDIAN WIDTH 4'-6" FT.)
381+00 TO 383+12
384+26 TO 387+00

DEMOLITION & DISPOSAL OF:
D76 @ 383+05, RT
D77 @ 383+70, LT (SIGN* & PLANTER)
D78 @ 385+05, LT (SIGN* & PLANTER)
D91 @ 380+90, RT (SIGN & PLANTER)
D92 @ 381+85, RT
TO 382+50, RT (LP* & FENCE*)
D136 @ 383+10, RT (4 PAY PHONES*)
* - REMOVED BY OTHERS AS OF JAN. 2003

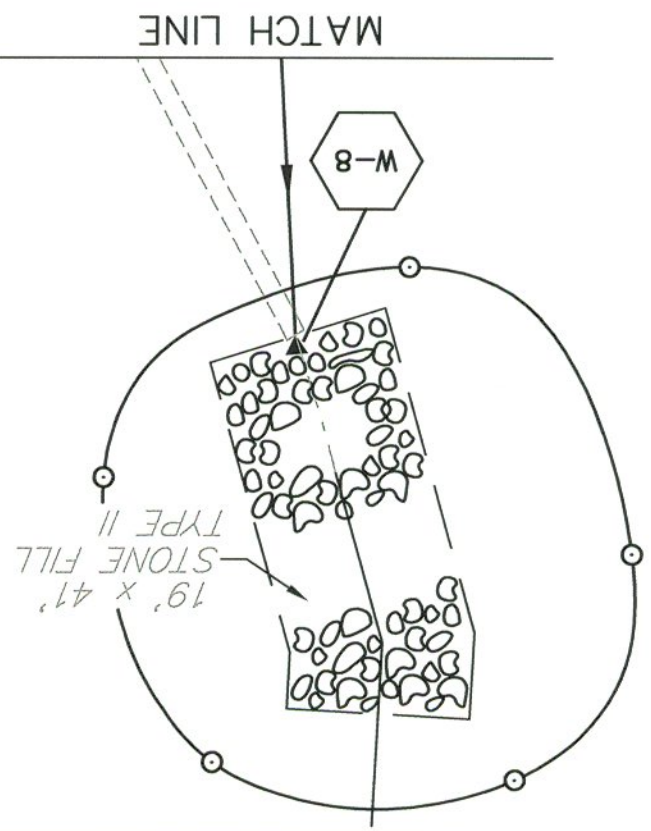

PORTLAND CEMENT
CONCRETE SIDEWALK - 5"
381+00 - 381+16 RT
381+75 - 382+47 RT
382+91 - 383+38 RT
383+97 - 387+00 RT
383+31 - 383+32 LT
384+81 - 384+96 LT
385+45 - 387+00 LT

PAVEMENT
EXPENDED TO
62' LT

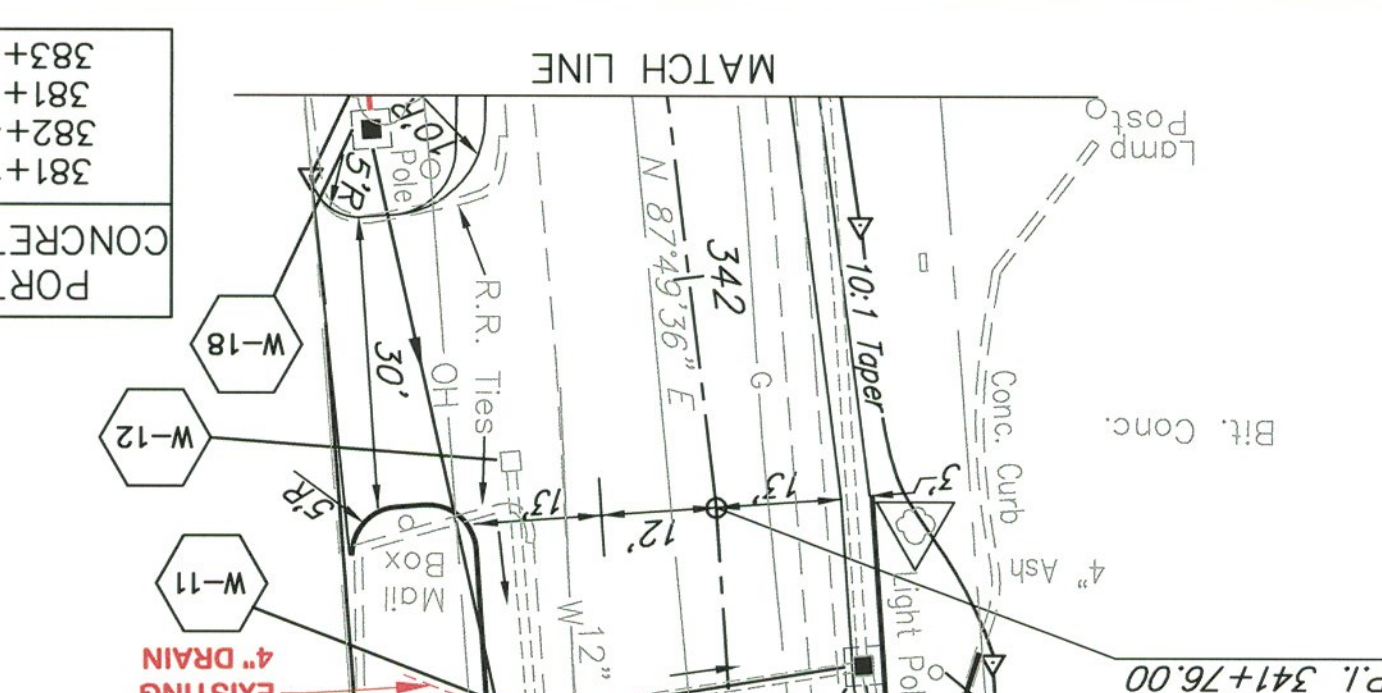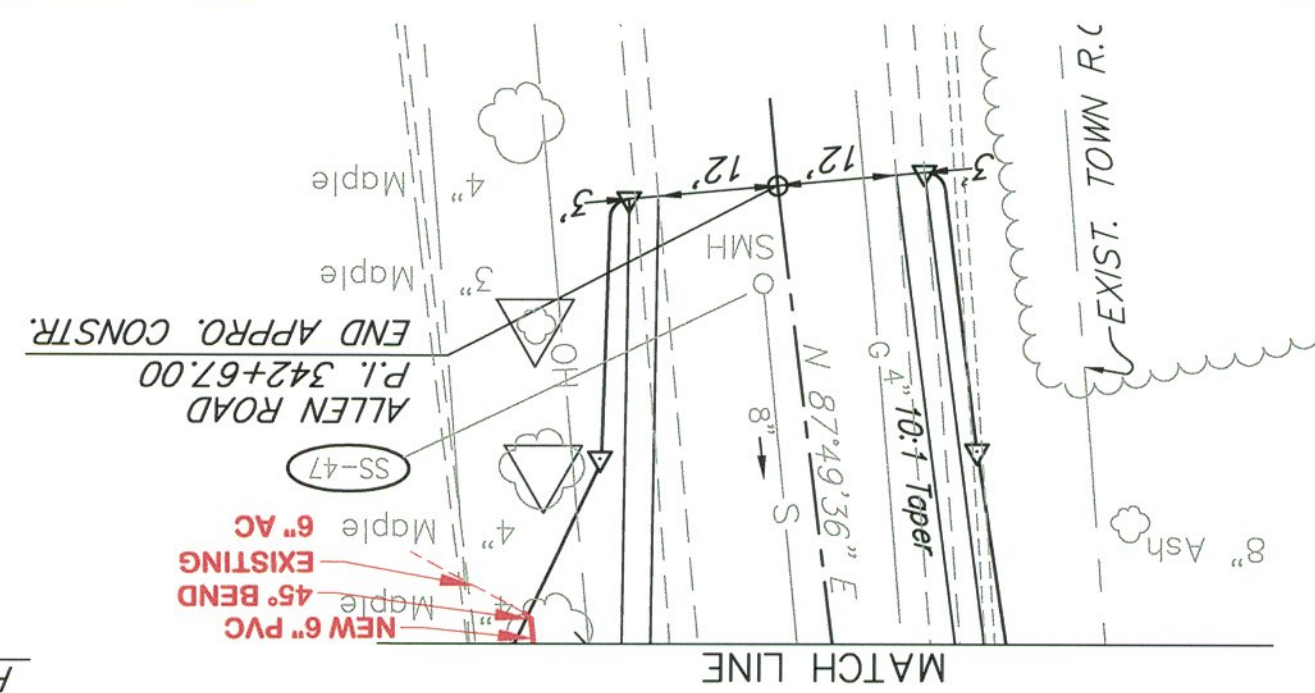

PORTLAND CEMENT
CONCRETE SIDEWALK - 8"
381+16 - 381+75 RT
382+47 - 382+91 RT
383+32 - 383+81 LT
384+00 - 384+31 LT


CONSTRUCT SIDEWALK RAMP
TYPE
383+35, RT
384+02, RT
384+93, LT
385+48, LT
384+18, RT
384+18, LT

AS-BUILT LEGEND
WATER AS-BUILTS
SEWER AS-BUILTS
DRAINAGE AS-BUILTS
ELECTRICAL AS-BUILTS
PAVEMENT OTHER
AS-BUILTS

PROJECT NH-EGC-019-4(28)
SHEET NO. 71 OF 283
SURVEYED BY V.S.C. INC. DATE
DRAWN BY E.A.A. INC. DATE
TRACED BY E.A.A. INC. DATE

MATCH TO PLAN DRAWING NO. 4, STA. 387+00

MATCH TO PLAN DRAWING NO. 2, STA. 381+00

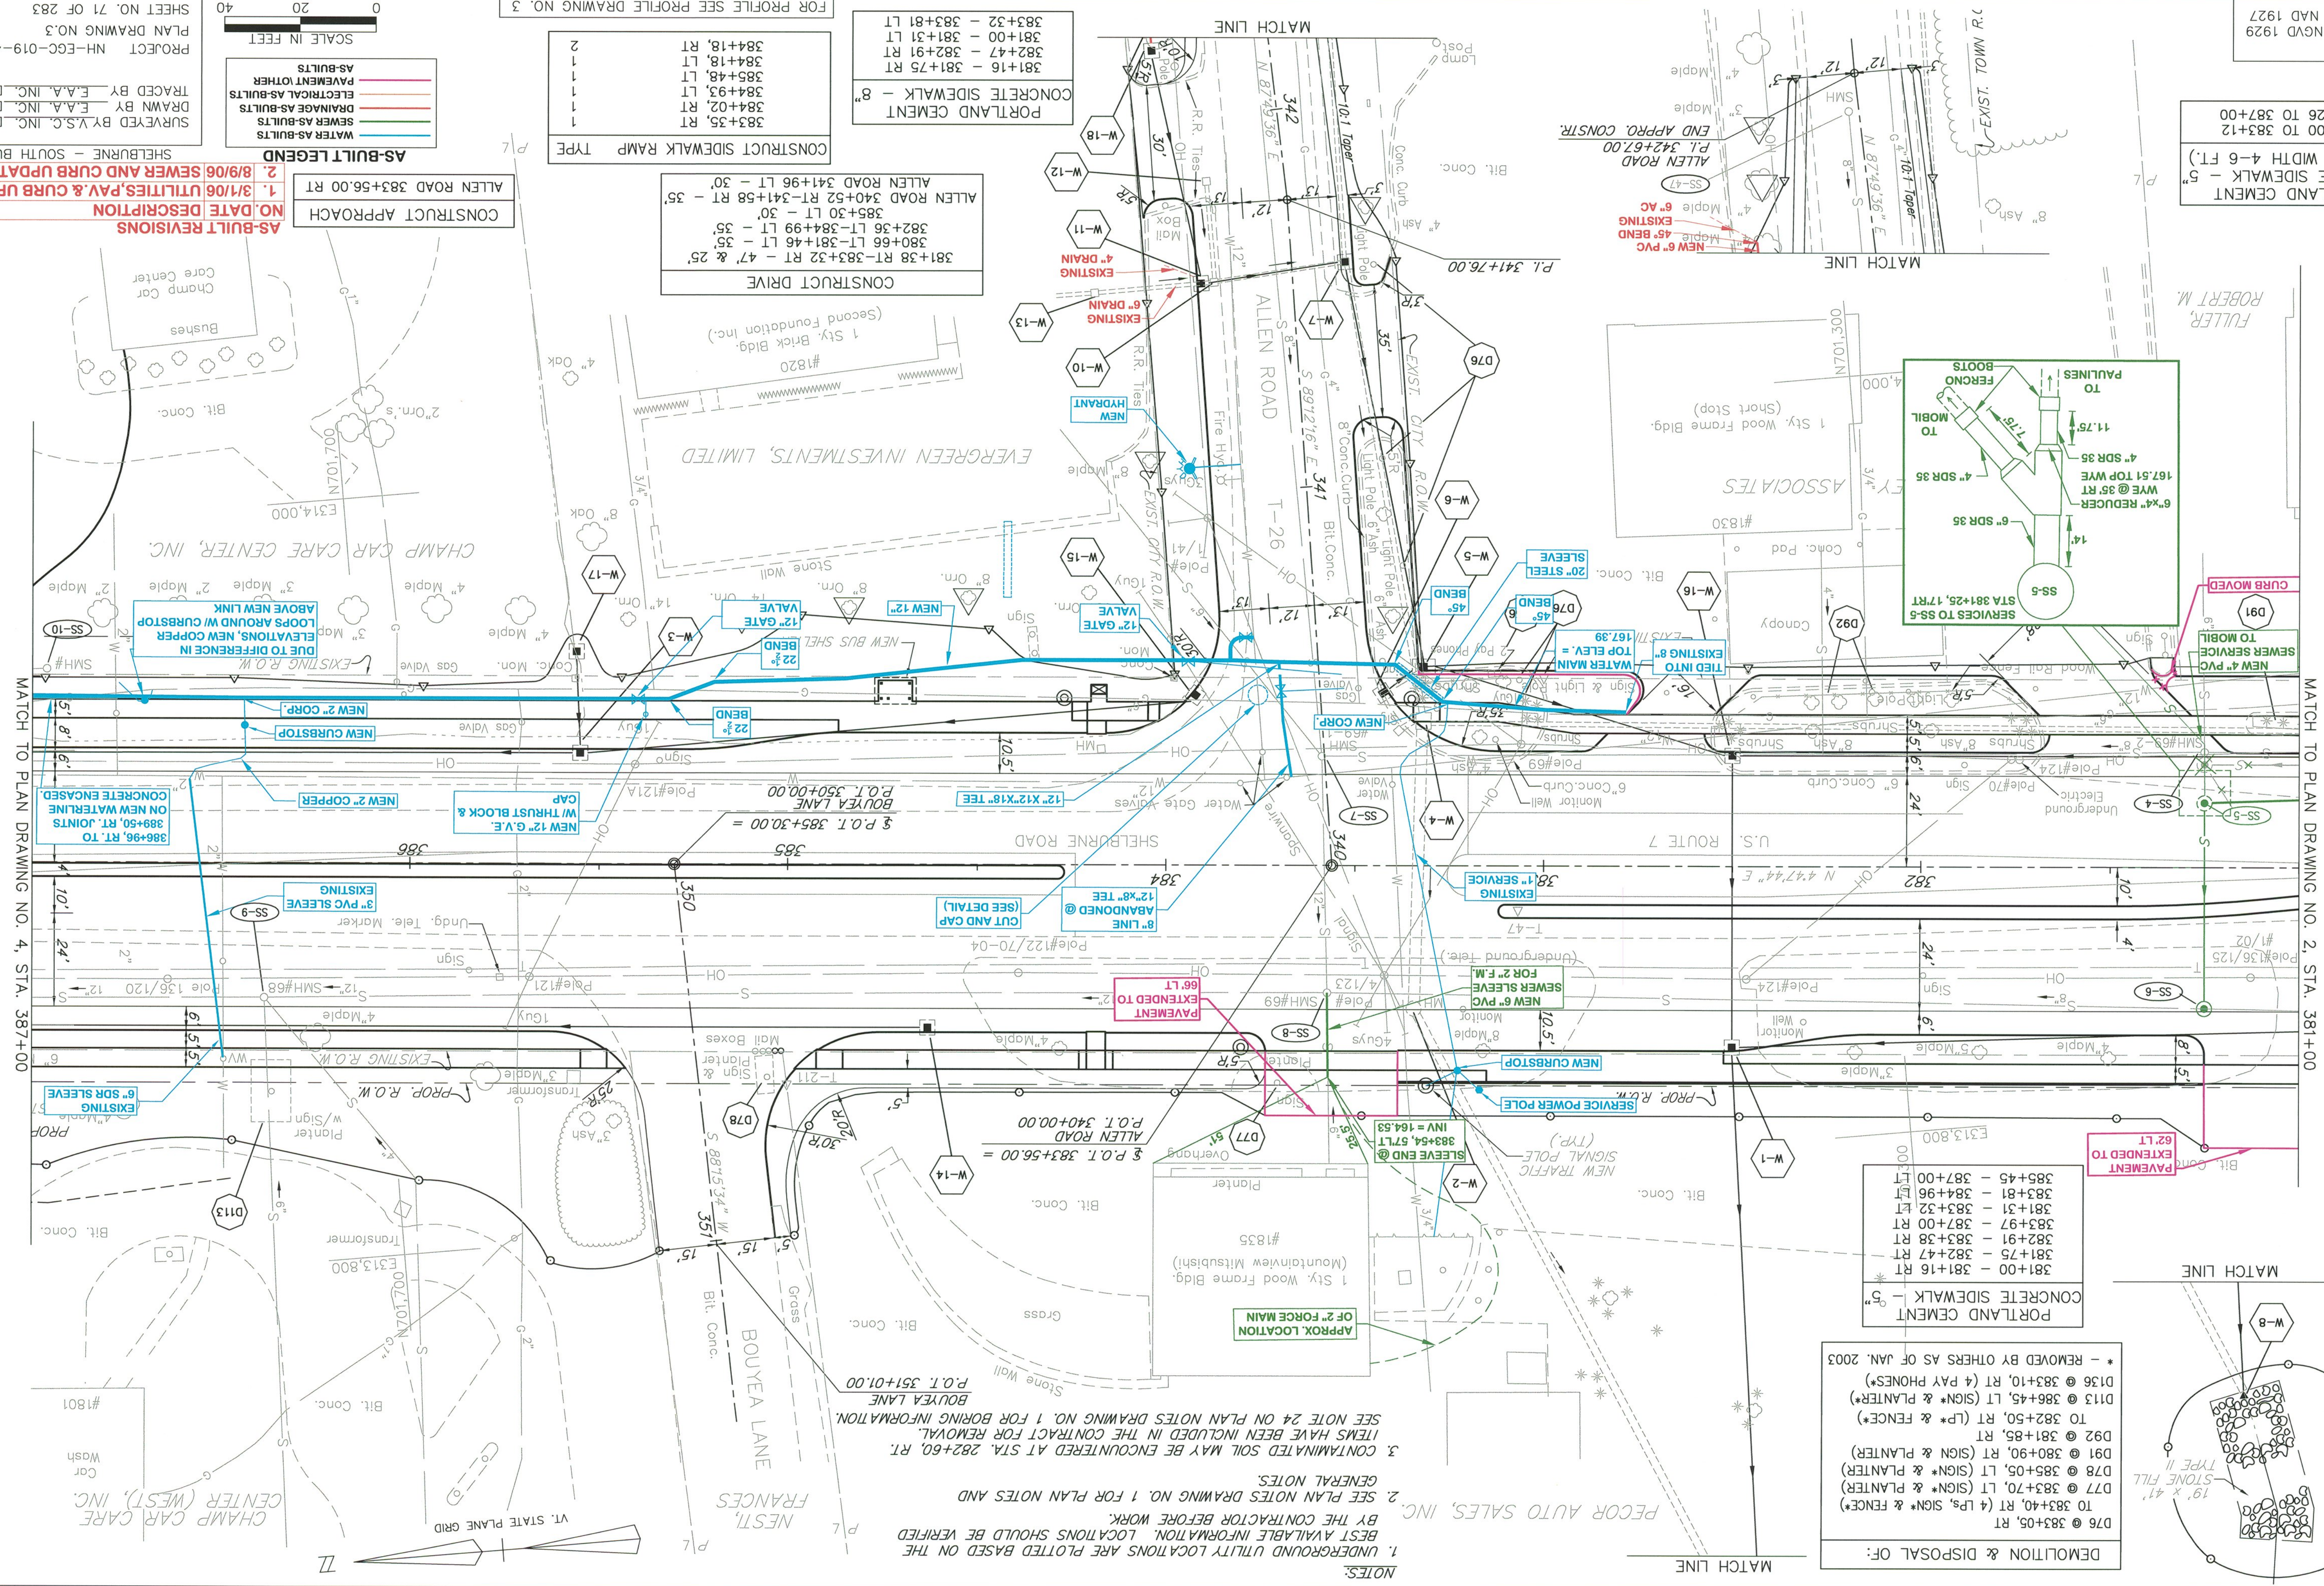

NOTES:
1. UNDERGROUND UTILITY LOCATIONS ARE PLOTTED BASED ON THE BEST AVAILABLE INFORMATION. LOCATIONS SHOULD BE VERIFIED BY THE CONTRACTOR BEFORE WORK.
2. SEE PLAN NOTES DRAWING NO. 1 FOR PLAN NOTES AND GENERAL NOTES.
3. CONTAMINATED SOIL MAY BE ENCOUNTERED AT STA. 282+60, RT. SEE NOTE 24 ON PLAN NOTES DRAWING NO. 1 FOR BORING INFORMATION.

