


DATUM
VERTICAL NGVD 1929
HORIZONTAL NAD 1927

- NOTES:
1. UNDERGROUND UTILITY LOCATIONS ARE PLOTTED BASED ON THE BEST AVAILABLE INFORMATION. LOCATIONS SHOULD BE VERIFIED BY THE CONTRACTOR BEFORE WORK.
 2. SEE PLAN NOTES DRAWING NO. 1 FOR PLAN NOTES AND GENERAL NOTES.

PORTLAND CEMENT
CONCRETE SIDEWALK - 5"
(MEDIAN WIDTH 4'-6 FT.)
387+00 TO 389+79
390+82 TO 393+00

NO.	DATE	DESCRIPTION
1.	3/1/06	SEWER, WATER & DRAINAGE ADDED

AS-BUILT LEGEND
WATER AS-BUILTS
SEWER AS-BUILTS
DRAINAGE AS-BUILTS
ELECTRICAL AS-BUILTS
PAVEMENT OTHER
AS-BUILTS

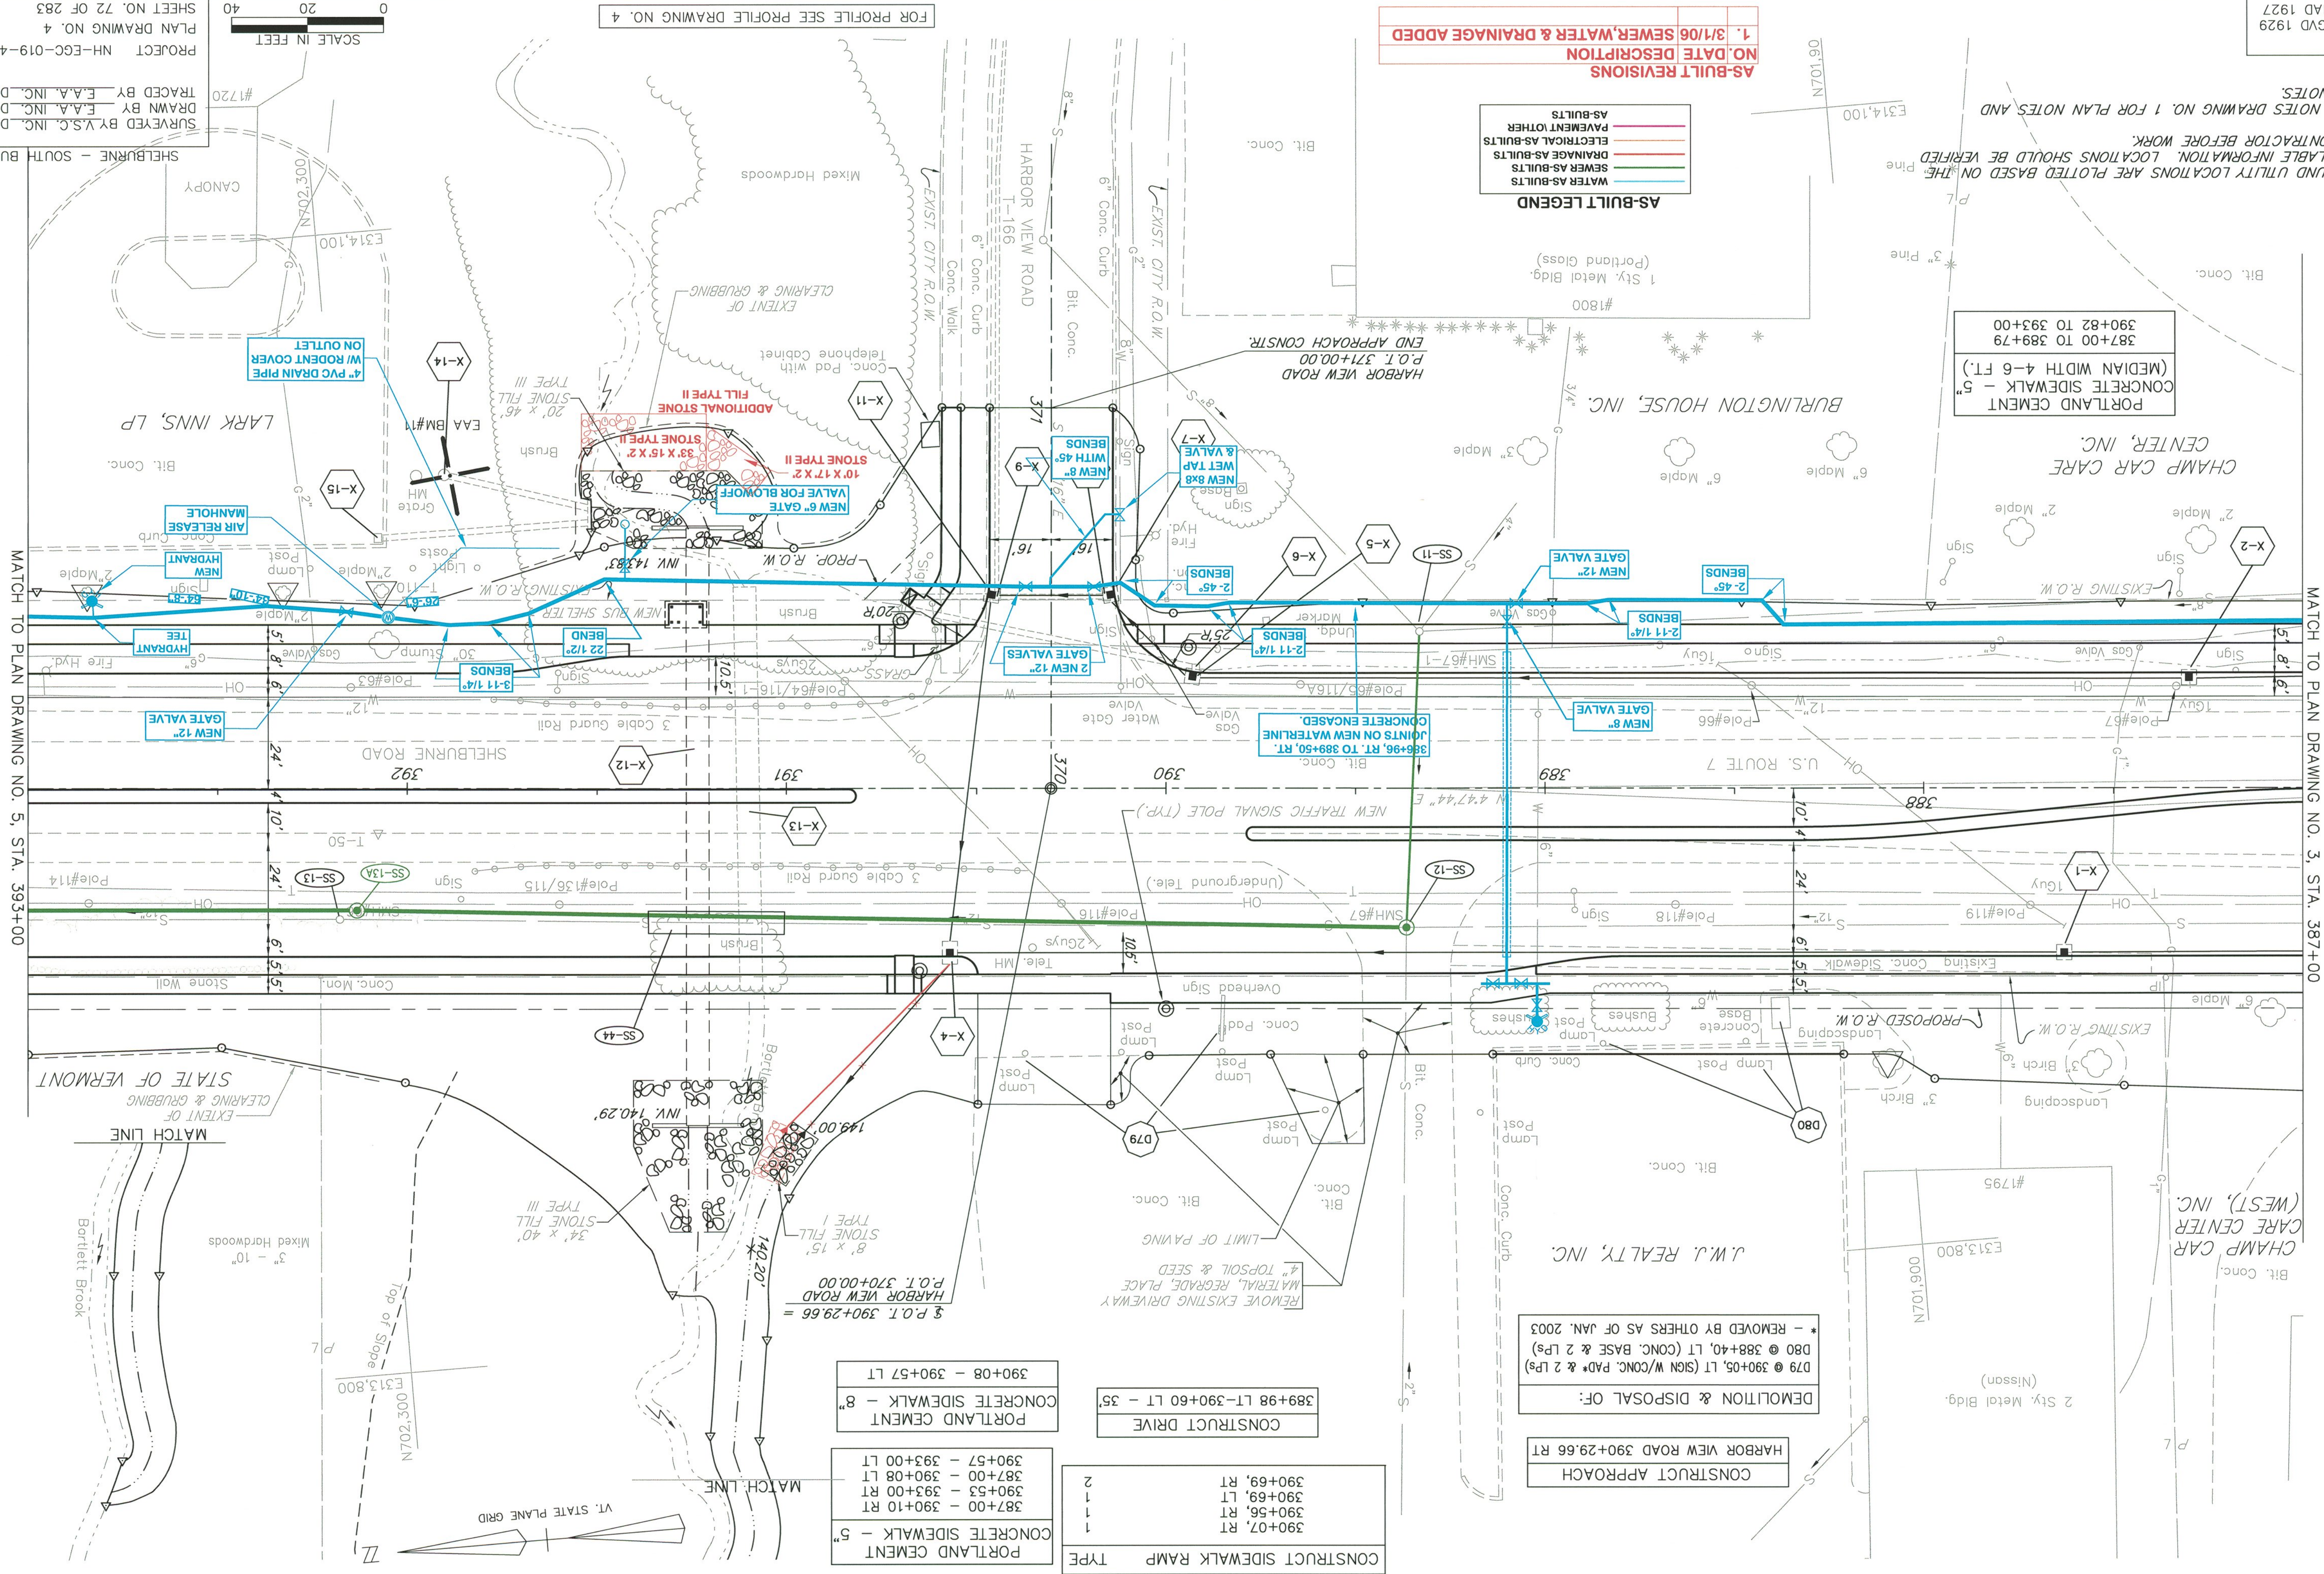

DEMOLITION & DISPOSAL OF:
D79 @ 390+05, LT (SIGN W/ CONC. PAD* & 2 LPs)
D80 @ 388+40, LT (CONC. BASE & 2 LPs)
* - REMOVED BY OTHERS AS OF JAN. 2003

CONSTRUCT APPROACH
HARBOR NEW ROAD 390+29.66 RT

TYPE	
CONSTRUCT SIDEWALK RAMP	390+07, RT
	390+56, RT
	390+69, LT
	390+69, RT
	390+69, LT

CONSTRUCT DRIVE
389+98 LT-390+60 LT - 35'

PORTLAND CEMENT
CONCRETE SIDEWALK - 8"
390+08 - 390+57 LT
390+57 - 393+00 LT

PORTLAND CEMENT
CONCRETE SIDEWALK - 5"
387+00 - 390+10 RT
390+53 - 393+00 RT
387+00 - 390+08 LT
390+57 - 393+00 LT

PROJECT NH-EGC-019-4(28)
PLAN DRAWING NO. 4
SURVEYED BY V.S.C. INC. DATE
DRAWN BY E.A.A. INC. DATE
TRACED BY E.A.A. INC. DATE

SCALE IN FEET
0 20 40

MATCH TO PLAN DRAWING NO. 5, STA. 393+00

MATCH TO PLAN DRAWING NO. 3, STA. 387+00