

DATUM
VERTICAL NGVD 1929
HORIZONTAL NAD 1927

- NOTES:
1. UNDERGROUND UTILITY LOCATIONS ARE PLOTTED BASED ON THE BEST AVAILABLE INFORMATION. LOCATIONS SHOULD BE VERIFIED BY THE CONTRACTOR BEFORE WORK.
 2. SEE PLAN NOTES DRAWING NO. 1 FOR PLAN NOTES AND GENERAL NOTES.
 3. VERIZON UNDERGROUND TELEPHONE (STA. 396+50 - STA. 405+50 RT) TO REMAIN.

AS-BUILT LEGEND

- WATER AS-BUILTS
- SEWER AS-BUILTS
- DRAINAGE AS-BUILTS
- ELECTRICAL AS-BUILTS
- PAVEMENT OTHER
- AS-BUILTS

DEMOLITION & DISPOSAL OF:

- D96 @ 402+50, LT (SIGN*)
- D128 @ 400+13, LT (LIGHTS 3*)
- TO 402+01, LT (FLAGPOLE & BASE)
- D137 @ 403+75, LT (FLAGPOLE & BASE)
- * - REMOVED BY OTHERS AS OF JAN. 2003

- AS-BUILT REVISIONS
1. NO. DATE DESCRIPTION
 2. 8/9/06 STORM DRAIN NOTES UPDATED

PORTLAND CEMENT
CONCRETE SIDEWALK - 8"

399+12 - 399+61 LT
402+55 - 403+04 LT

PORTLAND CEMENT
CONCRETE SIDEWALK - 5"

399+00 - 405+00 RT
399+61 - 402+55 LT
403+04 - 405+00 LT

CONSTRUCT DRIVE

399+32 RT - 16"
399+36 LT - 35"
402+79 LT - 35"

PORTLAND CEMENT
CONCRETE SIDEWALK - 5"
(MEDIAN WIDTH 4-6 FT.)

402+44 TO 405+00


SCALE IN FEET

0 20 40

PROJECT NH-EGC-019-4(28)
PLAN DRAWING NO. 6
SHEET NO. 74 OF 283

SURVEYED BY V.S.C. INC. DATE
DRAWN BY E.A.A. INC. DATE
TRACED BY E.A.A. INC. DATE

SHELburne - SOUTH BURLINGTON

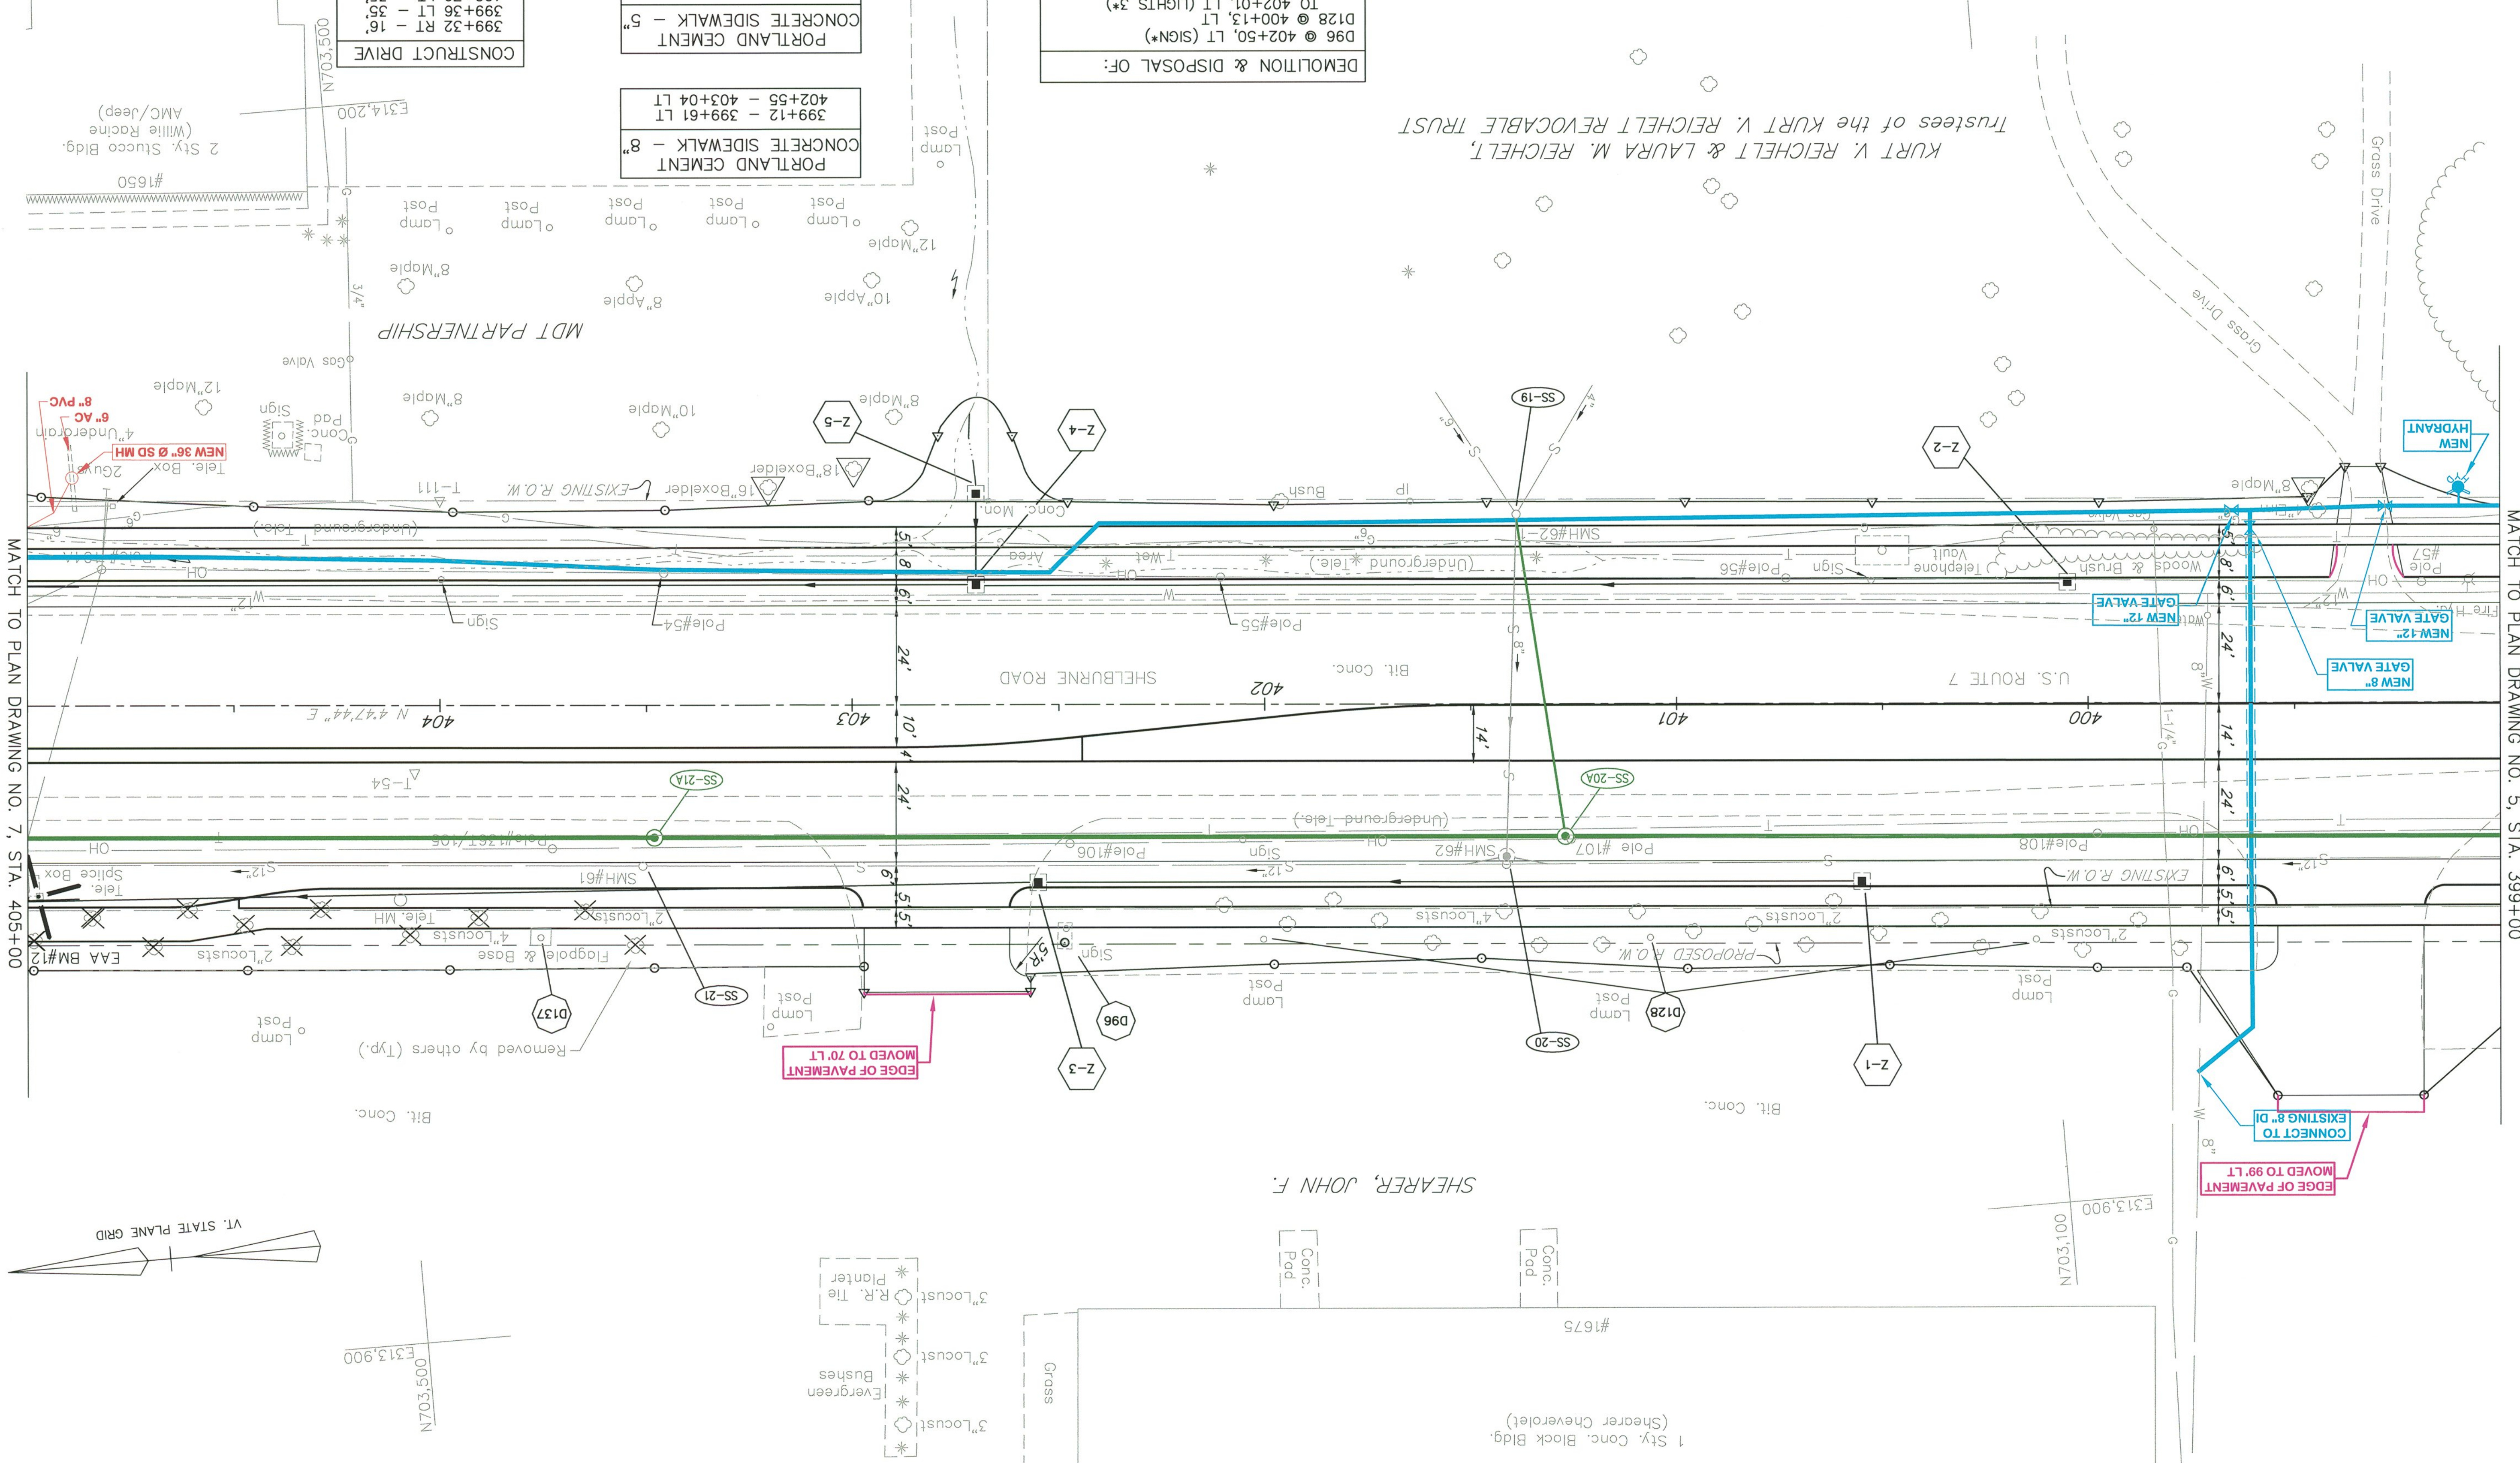

SHEARER, JOHN F.

