
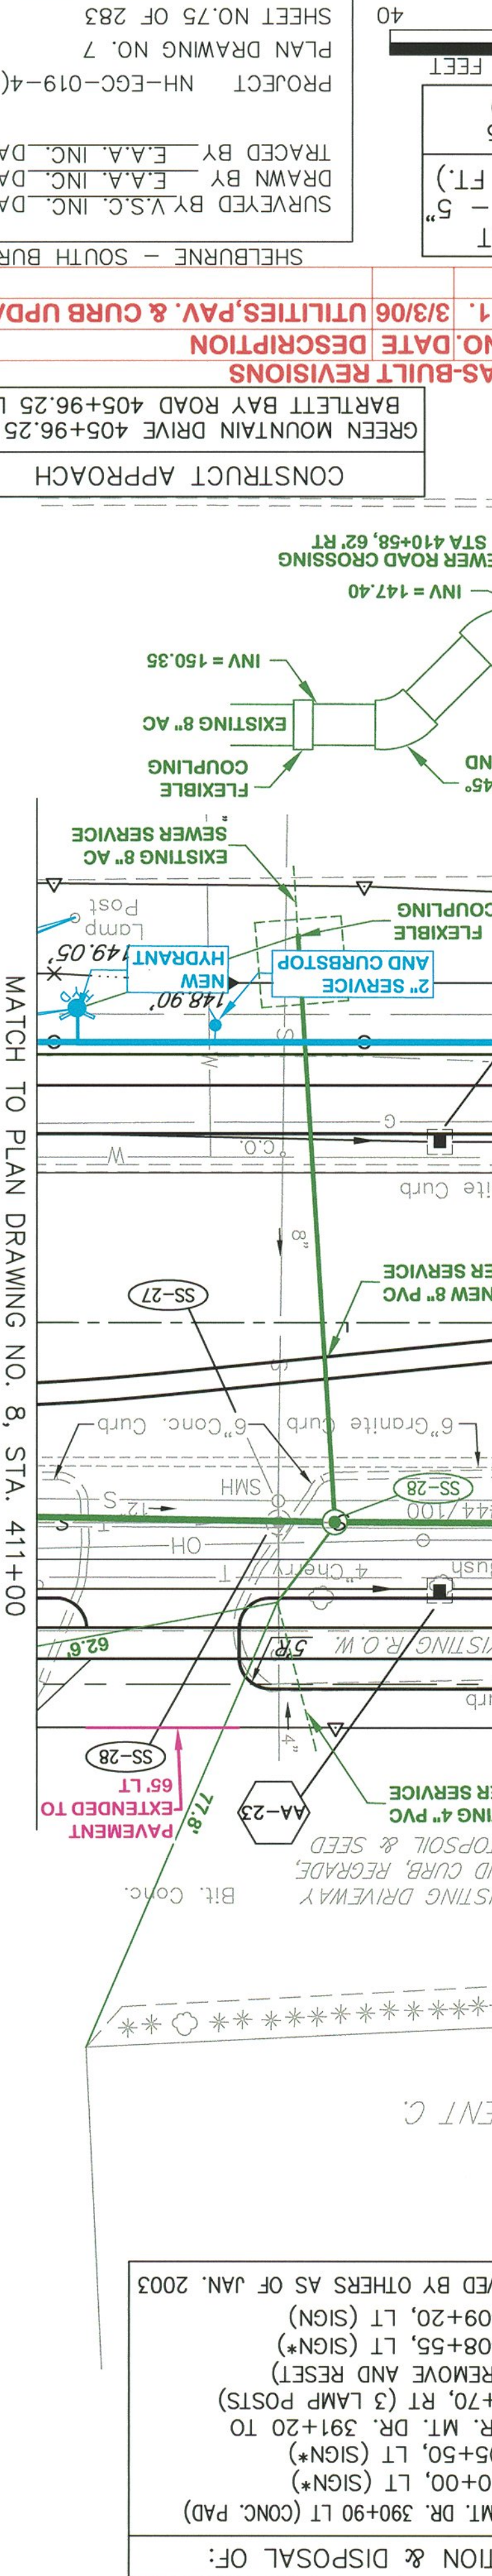
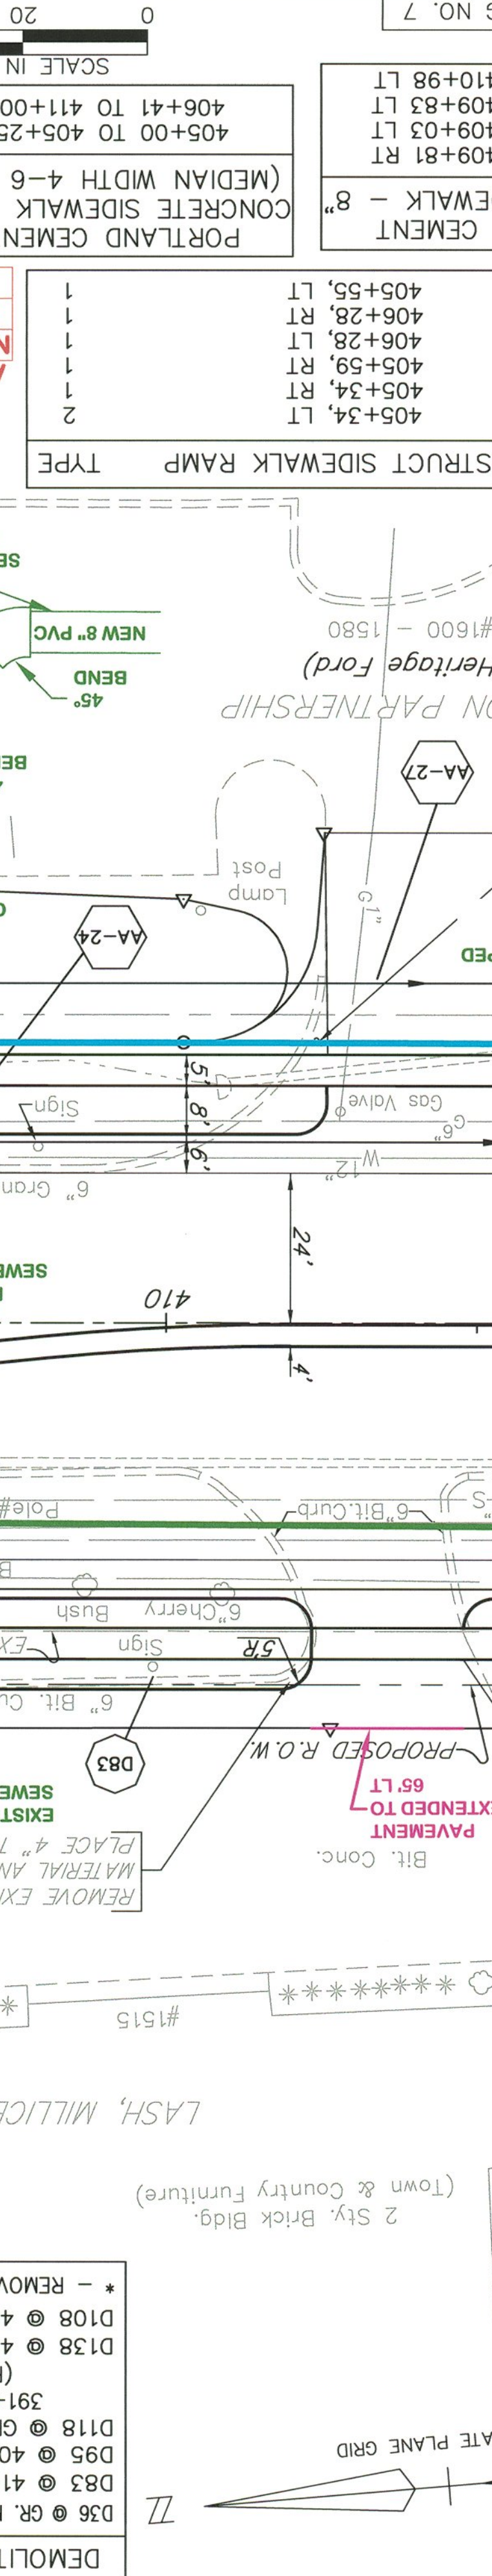
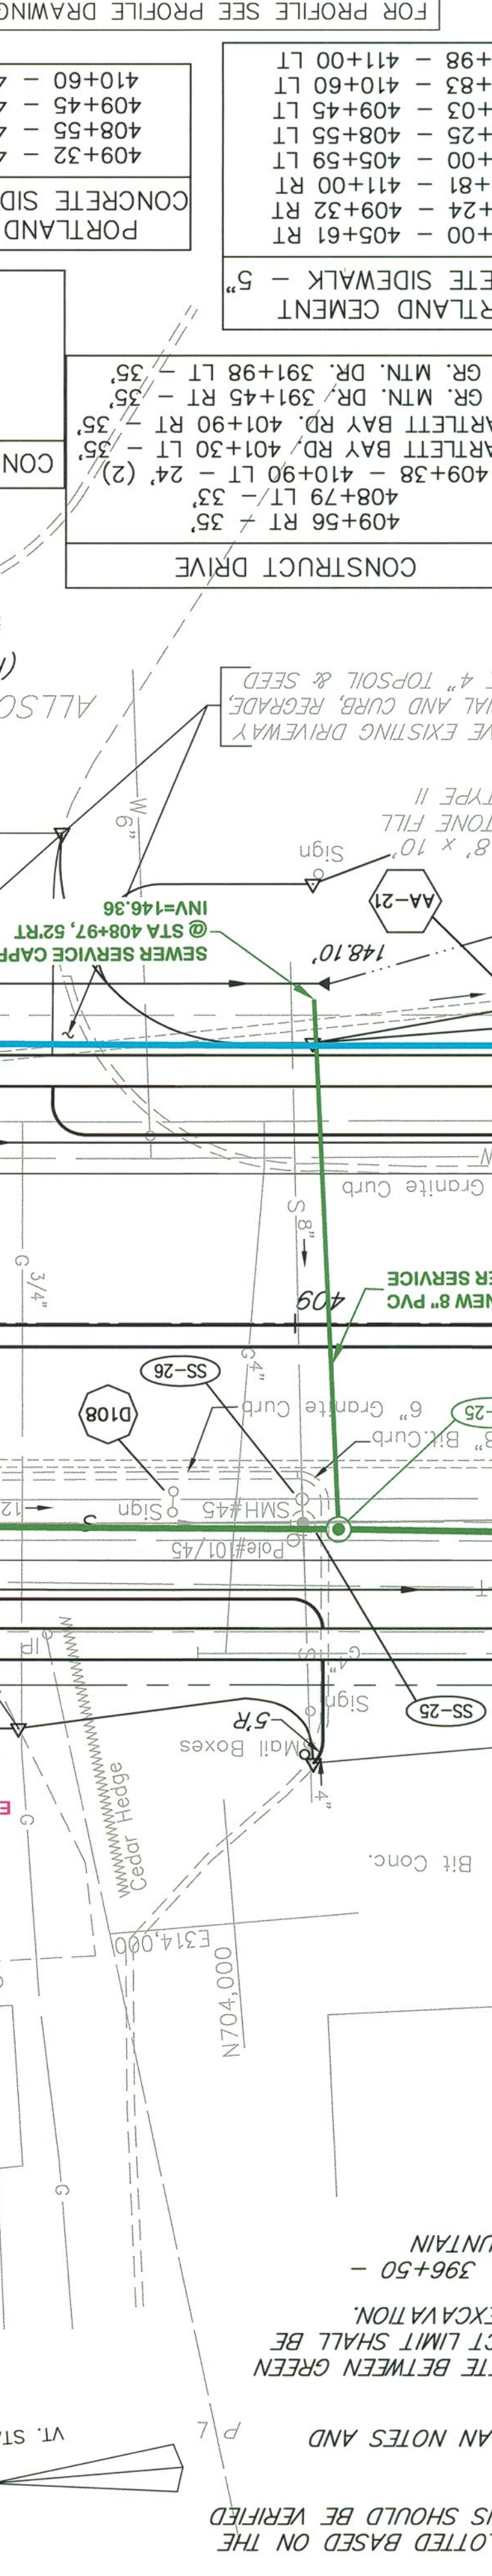
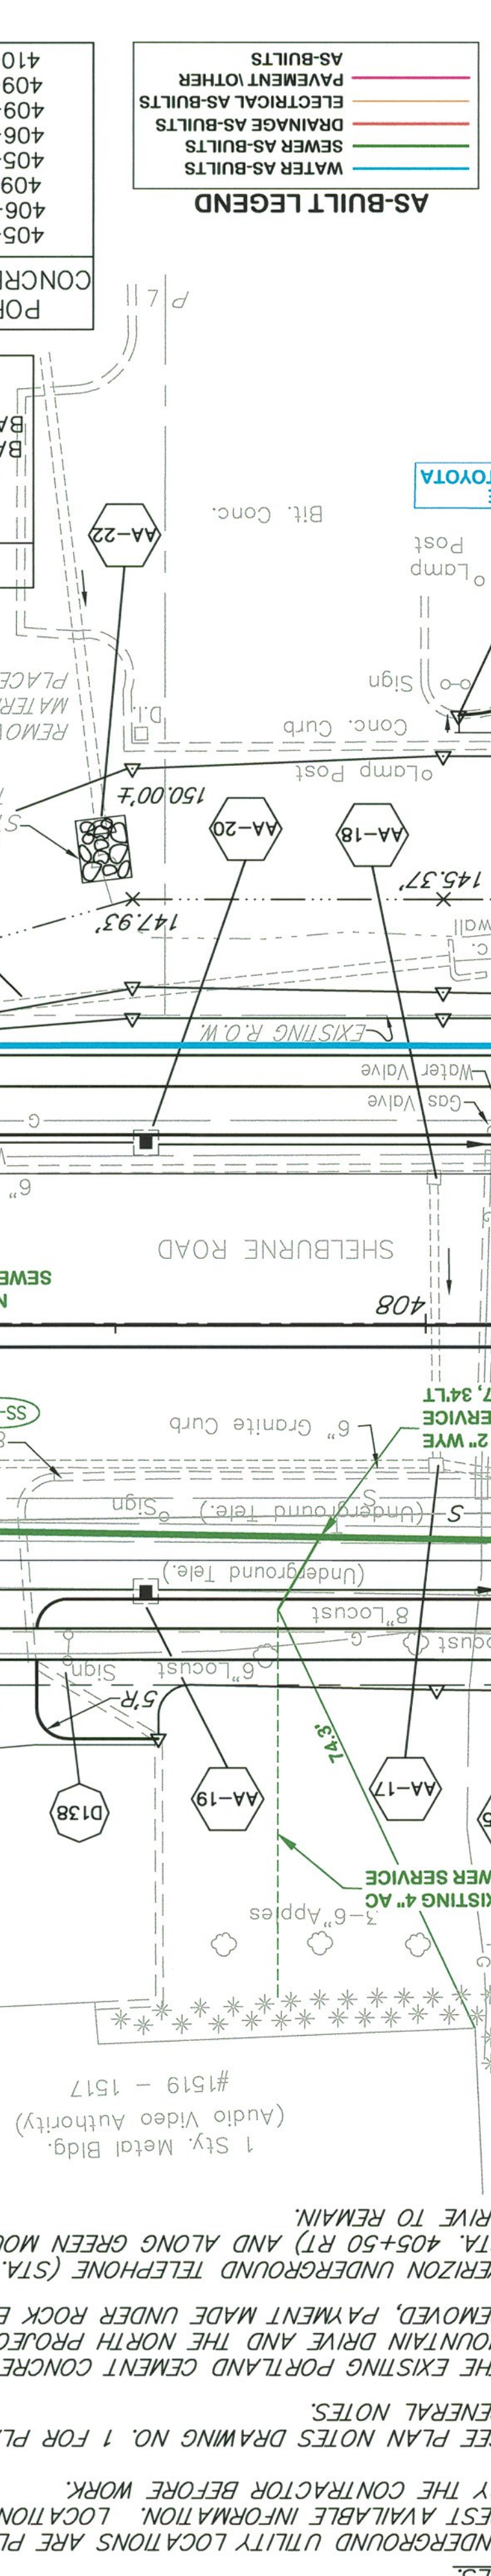
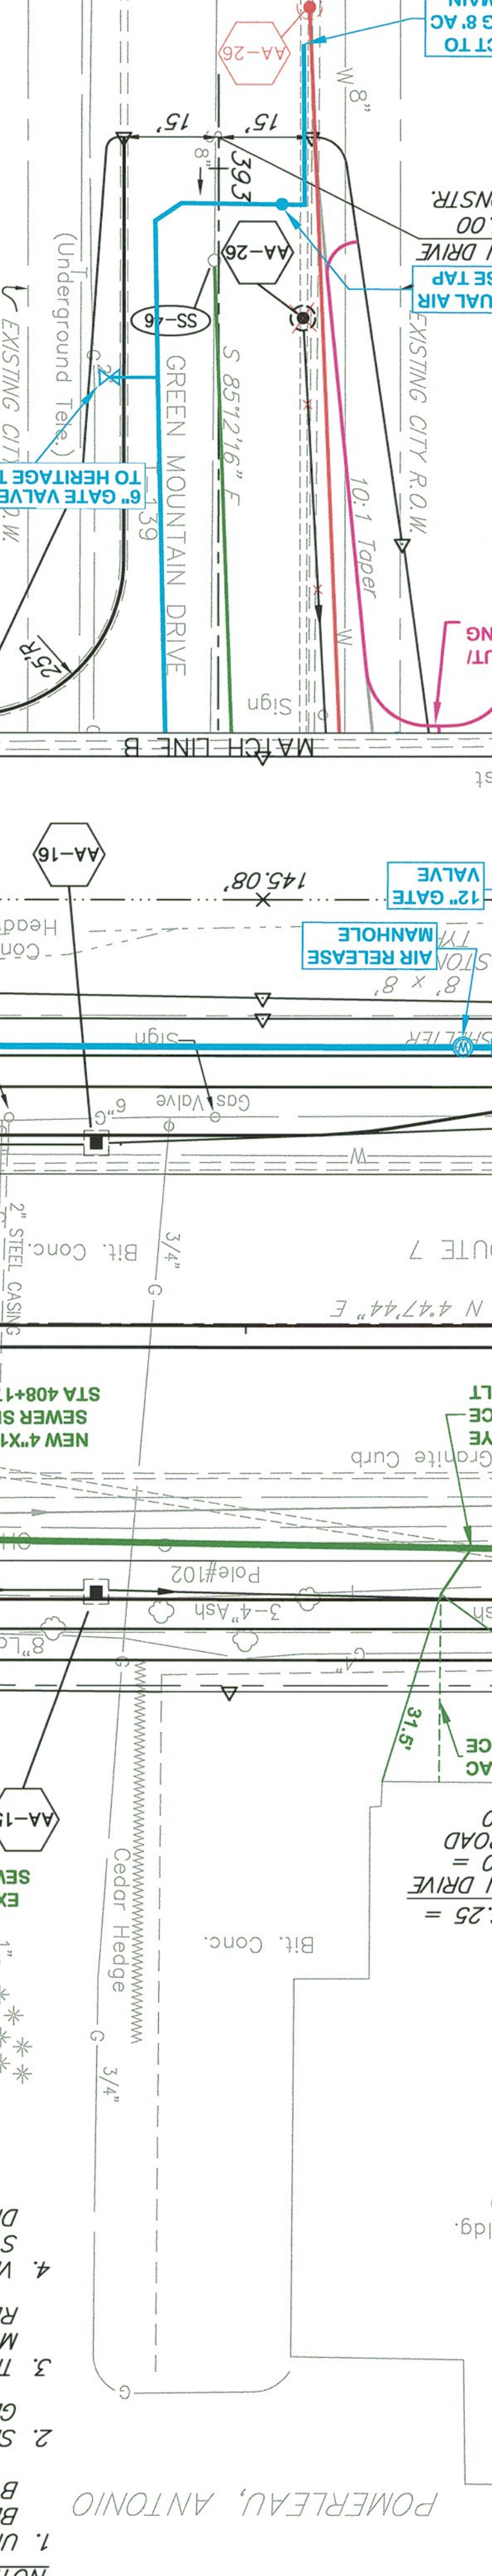
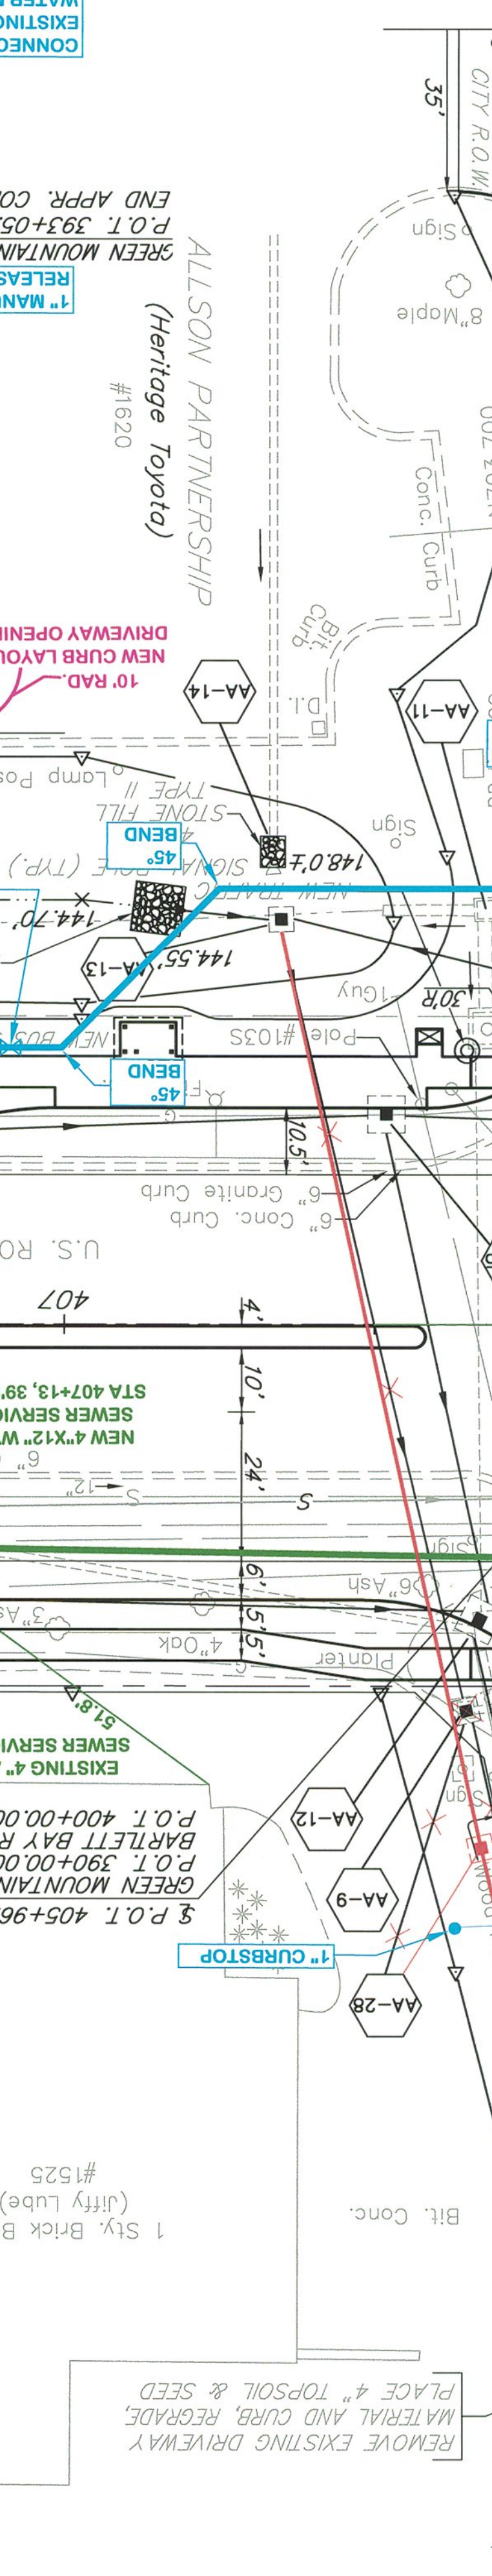
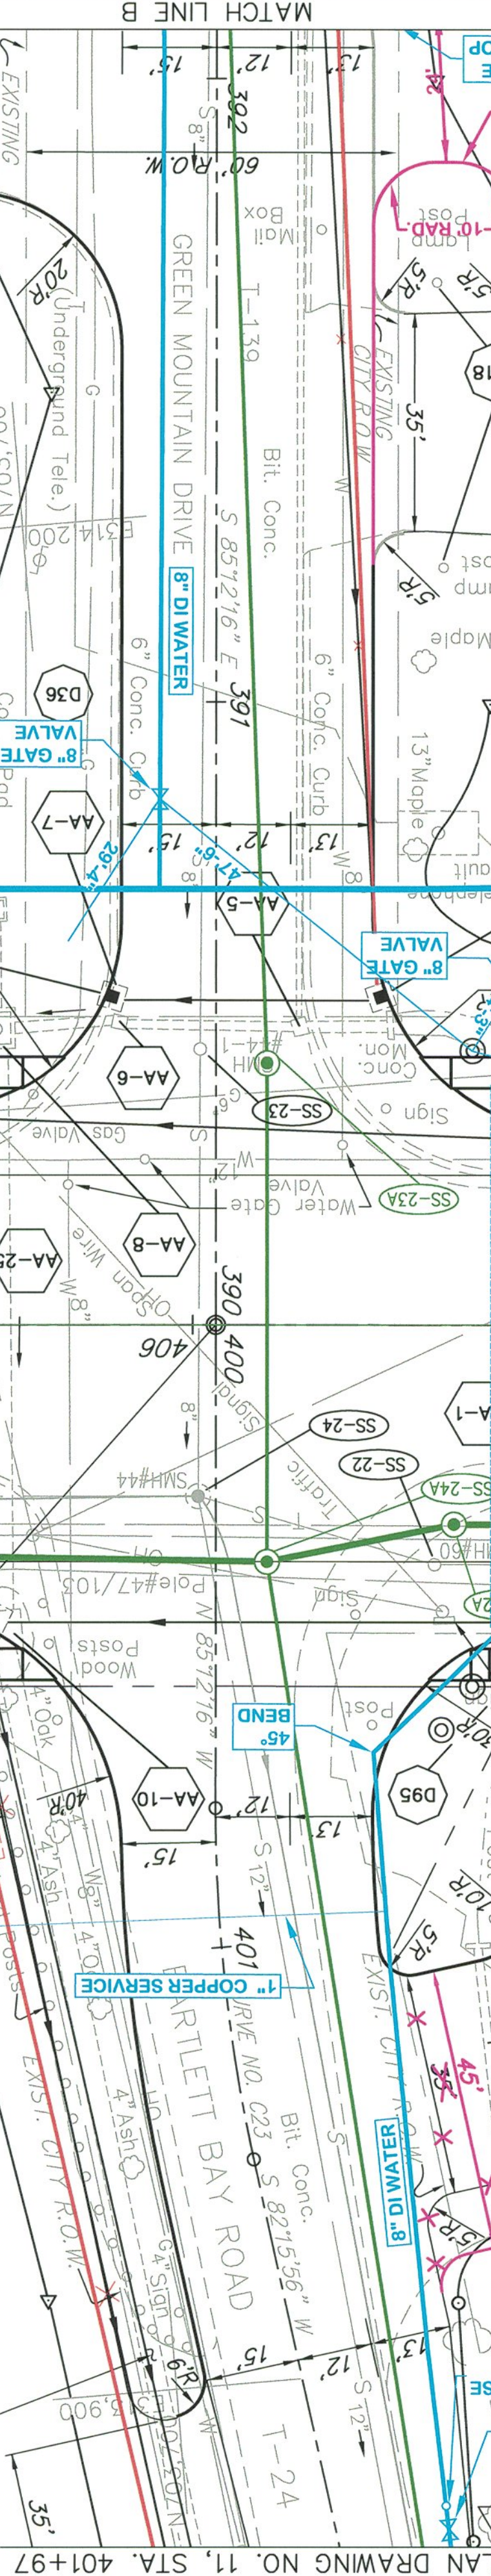


DATUM
VERTICAL NGVD 1927
HORIZONTAL NAD 1927

P.I. STA. 401+06.12 BK.
STA. 401+05.90 AHD.
D= 22' 02" 13"
R= 260.00'
L= 56.86'
E= 1.56'
P.C. STA. 400+77.58
P.T. STA. 401+34.44

MATCH TO PLAN DRAWING NO. 6, STA. 405+00

MATCH TO PLAN DRAWING NO. 11, STA. 401+97

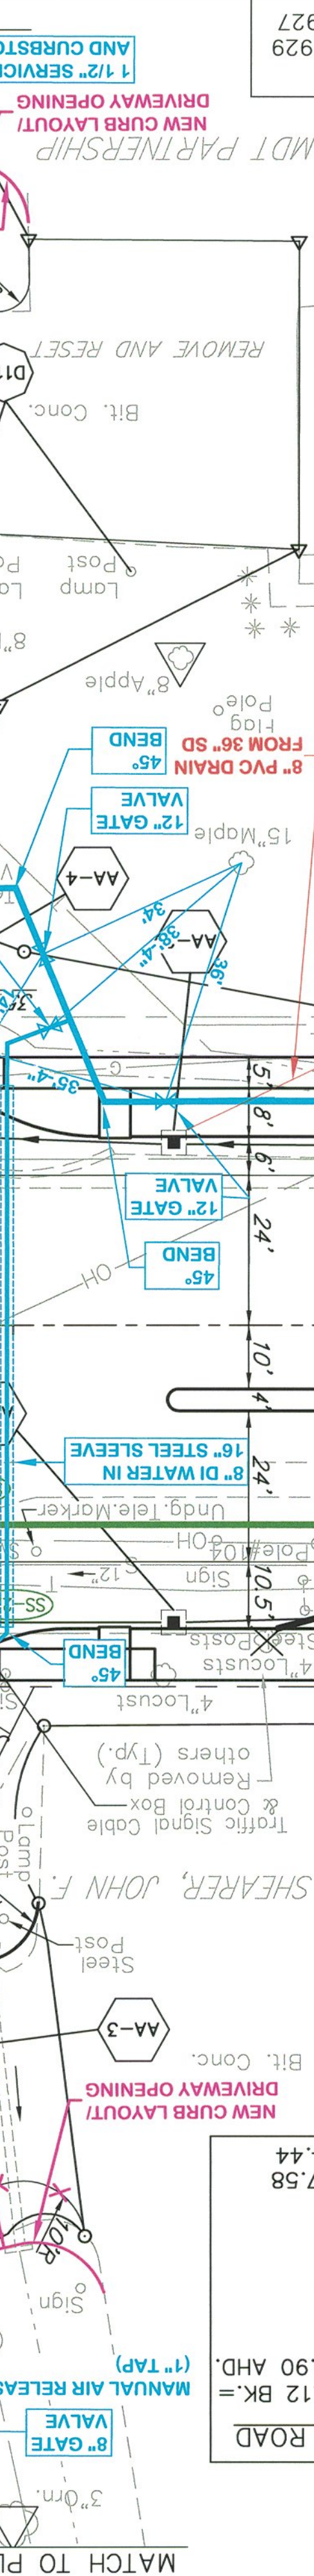

AS-BUILT LEGEND

AS-BUILTS	PAVEMENT OTHER
SEWER AS-BUILTS	ELECTRICAL AS-BUILTS
WATER AS-BUILTS	DRAINAGE AS-BUILTS

PORTLAND CEMENT CONCRETE SIDEWALK - 5"

405+00 - 405+61 RT	409+24 - 409+32 RT	405+00 - 405+61 RT
409+81 - 411+00 RT	409+25 - 409+33 RT	409+81 - 411+00 RT
409+82 - 410+00 RT	409+26 - 409+34 RT	409+82 - 410+00 RT
409+83 - 410+01 RT	409+27 - 409+35 RT	409+83 - 410+01 RT
409+84 - 410+02 RT	409+28 - 409+36 RT	409+84 - 410+02 RT
409+85 - 410+03 RT	409+29 - 409+37 RT	409+85 - 410+03 RT
409+86 - 410+04 RT	409+30 - 409+38 RT	409+86 - 410+04 RT
409+87 - 410+05 RT	409+31 - 409+39 RT	409+87 - 410+05 RT
409+88 - 410+06 RT	409+32 - 409+40 RT	409+88 - 410+06 RT
409+89 - 410+07 RT	409+33 - 409+41 RT	409+89 - 410+07 RT
409+90 - 410+08 RT	409+34 - 409+42 RT	409+90 - 410+08 RT
409+91 - 410+09 RT	409+35 - 409+43 RT	409+91 - 410+09 RT
409+92 - 410+10 RT	409+36 - 409+44 RT	409+92 - 410+10 RT
409+93 - 410+11 RT	409+37 - 409+45 RT	409+93 - 410+11 RT
409+94 - 410+12 RT	409+38 - 409+46 RT	409+94 - 410+12 RT
409+95 - 410+13 RT	409+39 - 409+47 RT	409+95 - 410+13 RT
409+96 - 410+14 RT	409+40 - 409+48 RT	409+96 - 410+14 RT
409+97 - 410+15 RT	409+41 - 409+49 RT	409+97 - 410+15 RT
409+98 - 410+16 RT	409+42 - 409+50 RT	409+98 - 410+16 RT
409+99 - 410+17 RT	409+43 - 409+51 RT	409+99 - 410+17 RT
410+00 - 411+00 RT	409+44 - 409+52 RT	410+00 - 411+00 RT

PORTLAND CEMENT CONCRETE SIDEWALK - 5" (MEDIAN WIDTH 4-6 FT.)		
405+00 TO 405+25	406+41 TO 411+00	SCALE IN FEET