

DATUM
VERTICAL NGVD 1929
HORIZONTAL NAD 1927

- NOTES:
1. UNDERGROUND UTILITY LOCATIONS ARE PLOTTED BASED ON THE BEST AVAILABLE INFORMATION. LOCATIONS SHOULD BE VERIFIED BY THE CONTRACTOR BEFORE WORK.
 2. SEE PLAN NOTES DRAWING NO. 1 FOR PLAN NOTES AND GENERAL NOTES.

AS-BUILT REVISIONS
NO. DATE DESCRIPTION
1. 3/3/06 UTILITIES, & PAV. EDITS

AS-BUILT LEGEND
WATER AS-BUILTS
SEWER AS-BUILTS
DRAINAGE AS-BUILTS
ELECTRICAL AS-BUILTS
PAVEMENT OTHER
AS-BUILTS


PORTLAND CEMENT
CONCRETE SIDEWALK - 5"
411+00 - 411+96 RT
412+50 - 417+00 RT
412+23 LT - 412+23 LT
413+89 LT - 413+89 LT
414+22 LT - 416+22 LT
416+61 - 417+00 LT

PORTLAND CEMENT
CONCRETE SIDEWALK - 8"
411+96 - 412+50 RT
412+23 - 412+78 LT
414+36 LT - 416+61 LT
416+22 - 416+61 LT

PORTLAND CEMENT
CONCRETE SIDEWALK - 5"
(MEDIAN WIDTH 4-6 FT.)
411+00 TO 411+73
412+73 TO 415+60


SHELBURNE - SOUTH BURLINGTON
SURVEYED BY S.C. INC. DATE
DRAWN BY E.A.A. INC. DATE
PROJECT NH-EGC-019-4(28)
SHEET NO. 76 OF 283

SCALE IN FEET
0 20 40

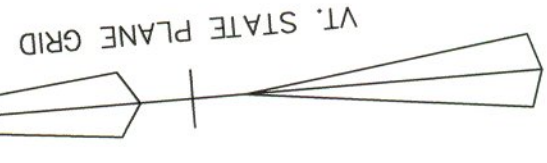

MATCH TO PLAN DRAWING NO. 7, 411+00

HOAR, DOUGLAS W. & CHERYL A.

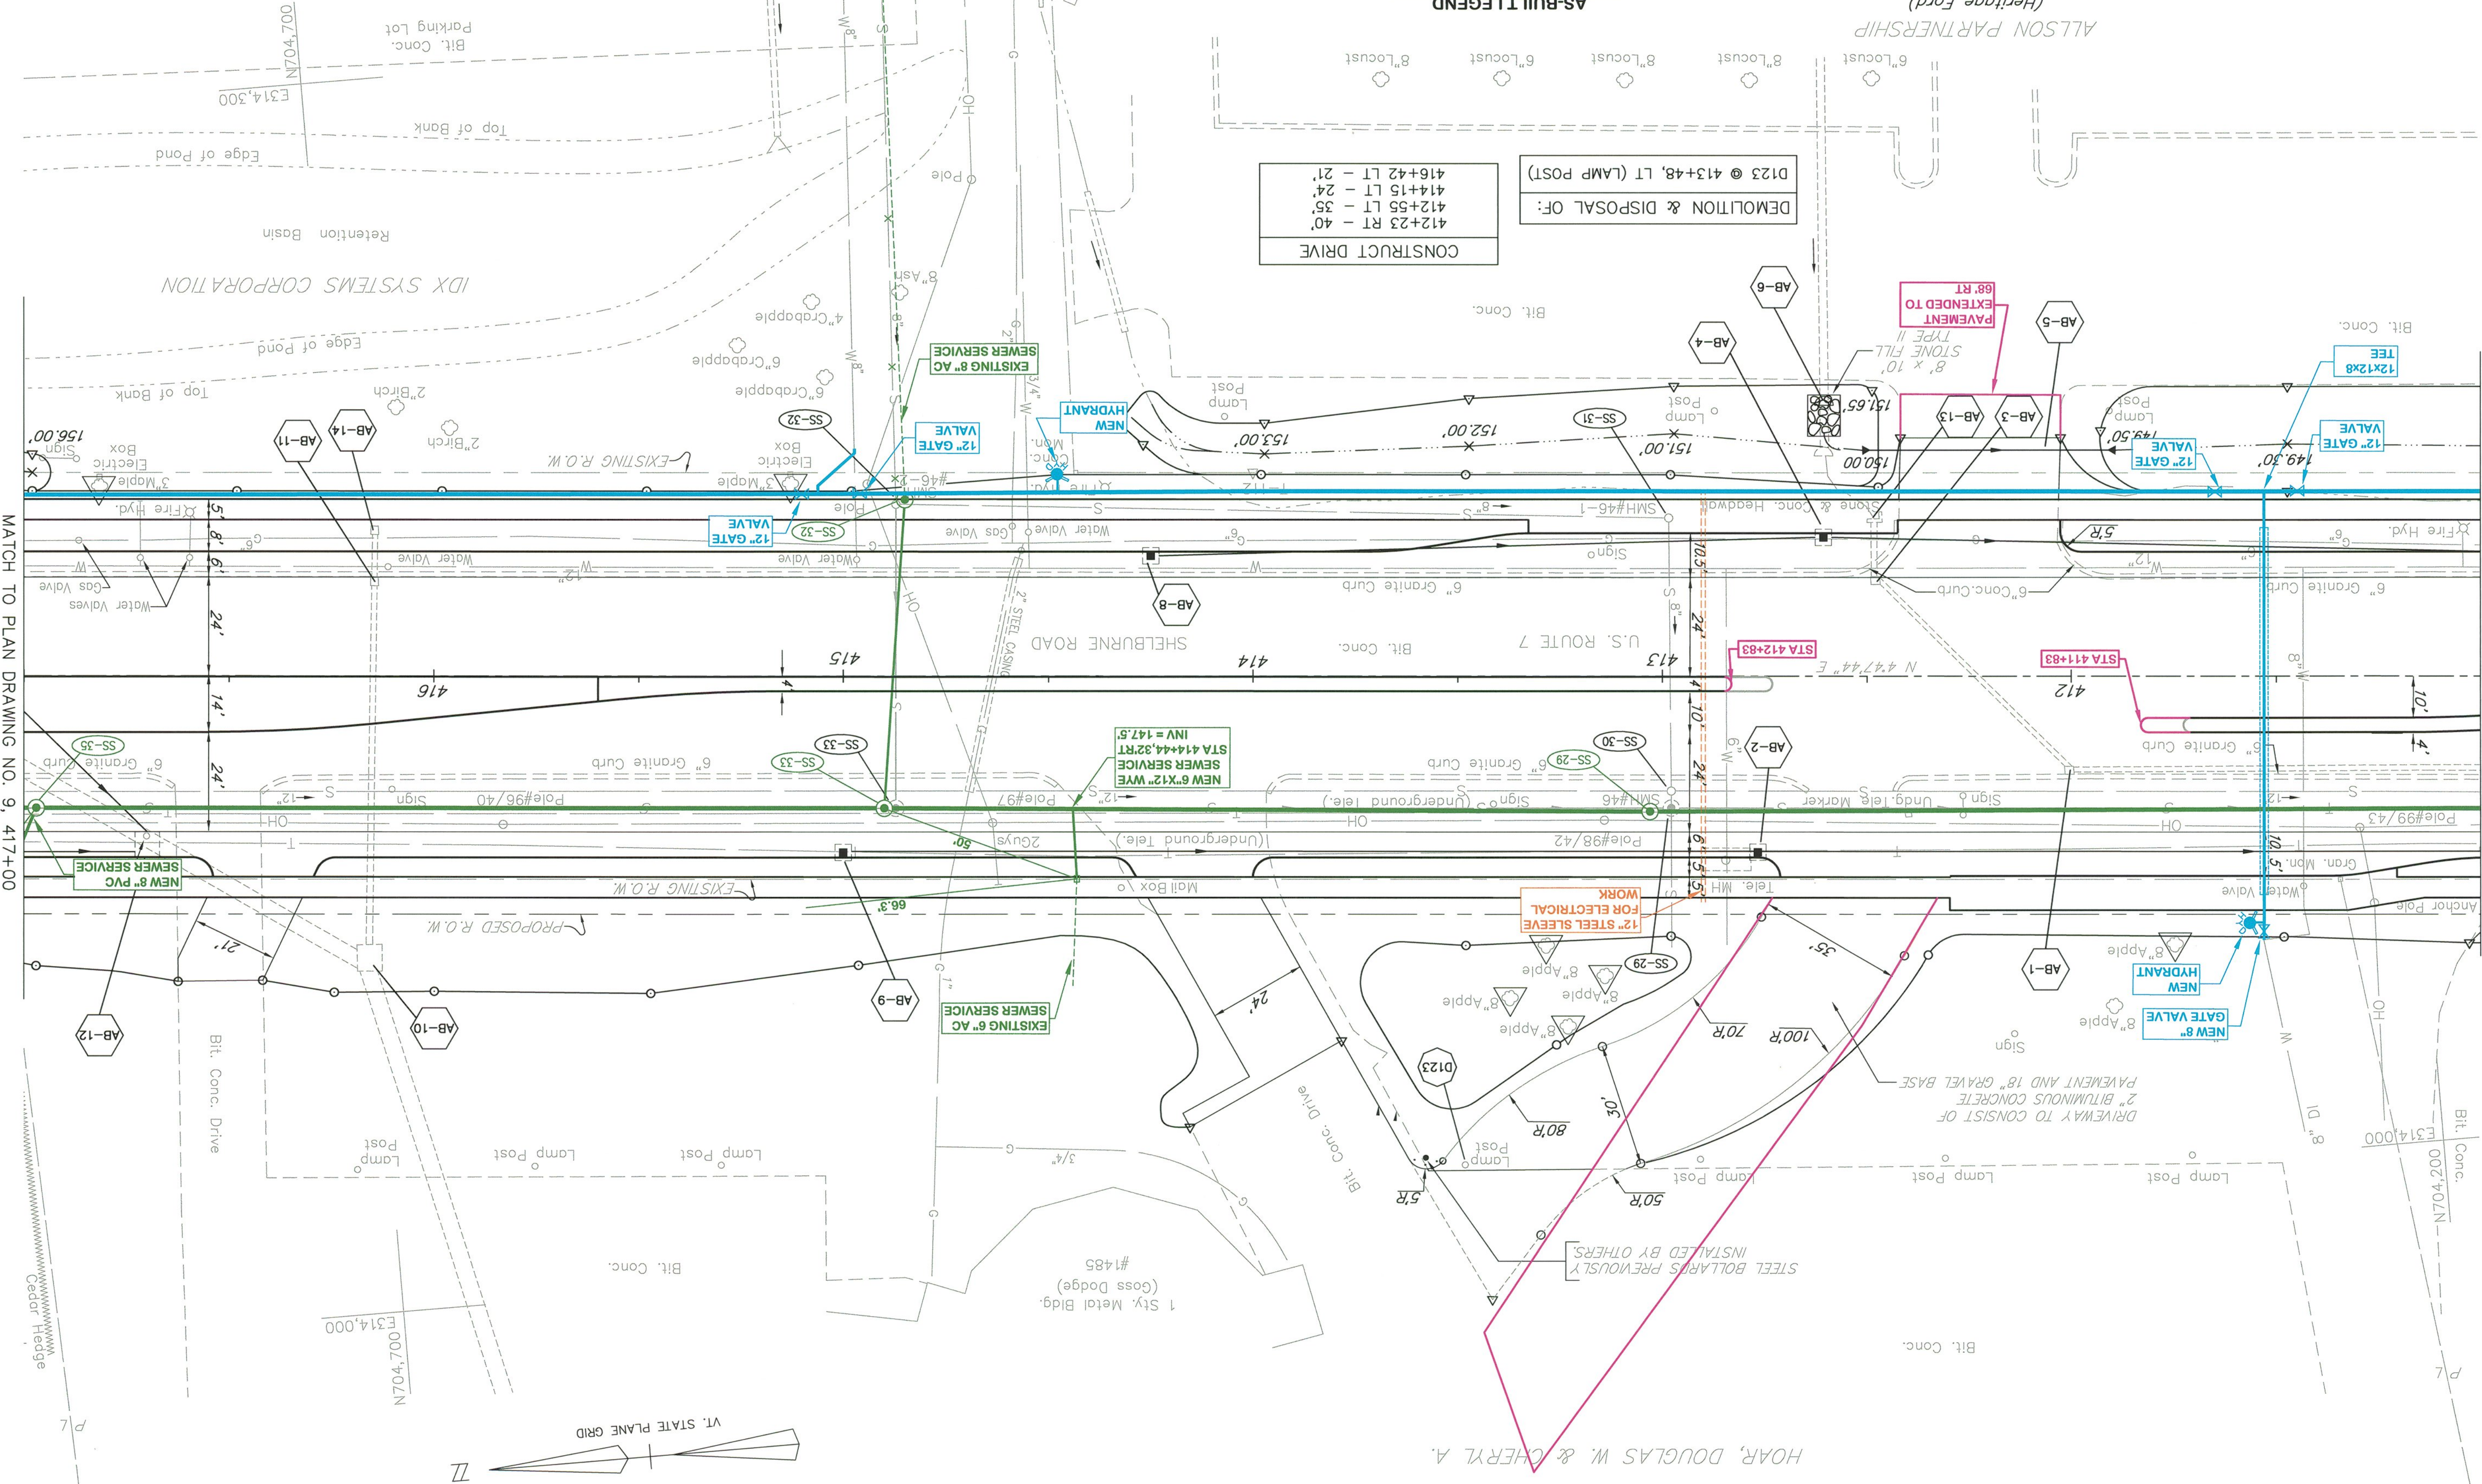

MATCH TO PLAN DRAWING NO. 9, 417+00