


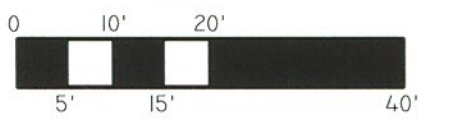

SCALE: 1" = 20'

[illegible]

CONTRACT #63

WATER MAIN RELOCATION
U.S. ROUTE 7
"SHELBURNE ROAD"

SOUTH BURLINGTON,
VERMONT

PLAN VIEW
STA. 387+00 TO 393+00

245 OF 283

DATE: APRIL, 2002

DESIGNED BY: RAP

DRAWN BY: EJP

CHECKED BY: RAP

APPROVED BY: RAP

FILE NAME:2000_C63

SHEET 4 OF 18

PL2

