

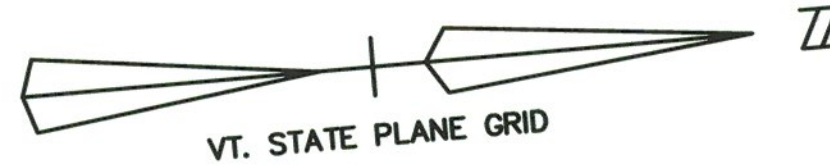


Dedicated to Quality
Water and Service

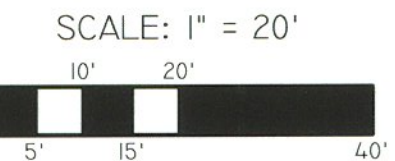

REYES, ALBERT J. & RITA J.
Oil'n Go

SHEARER, JOHN F.

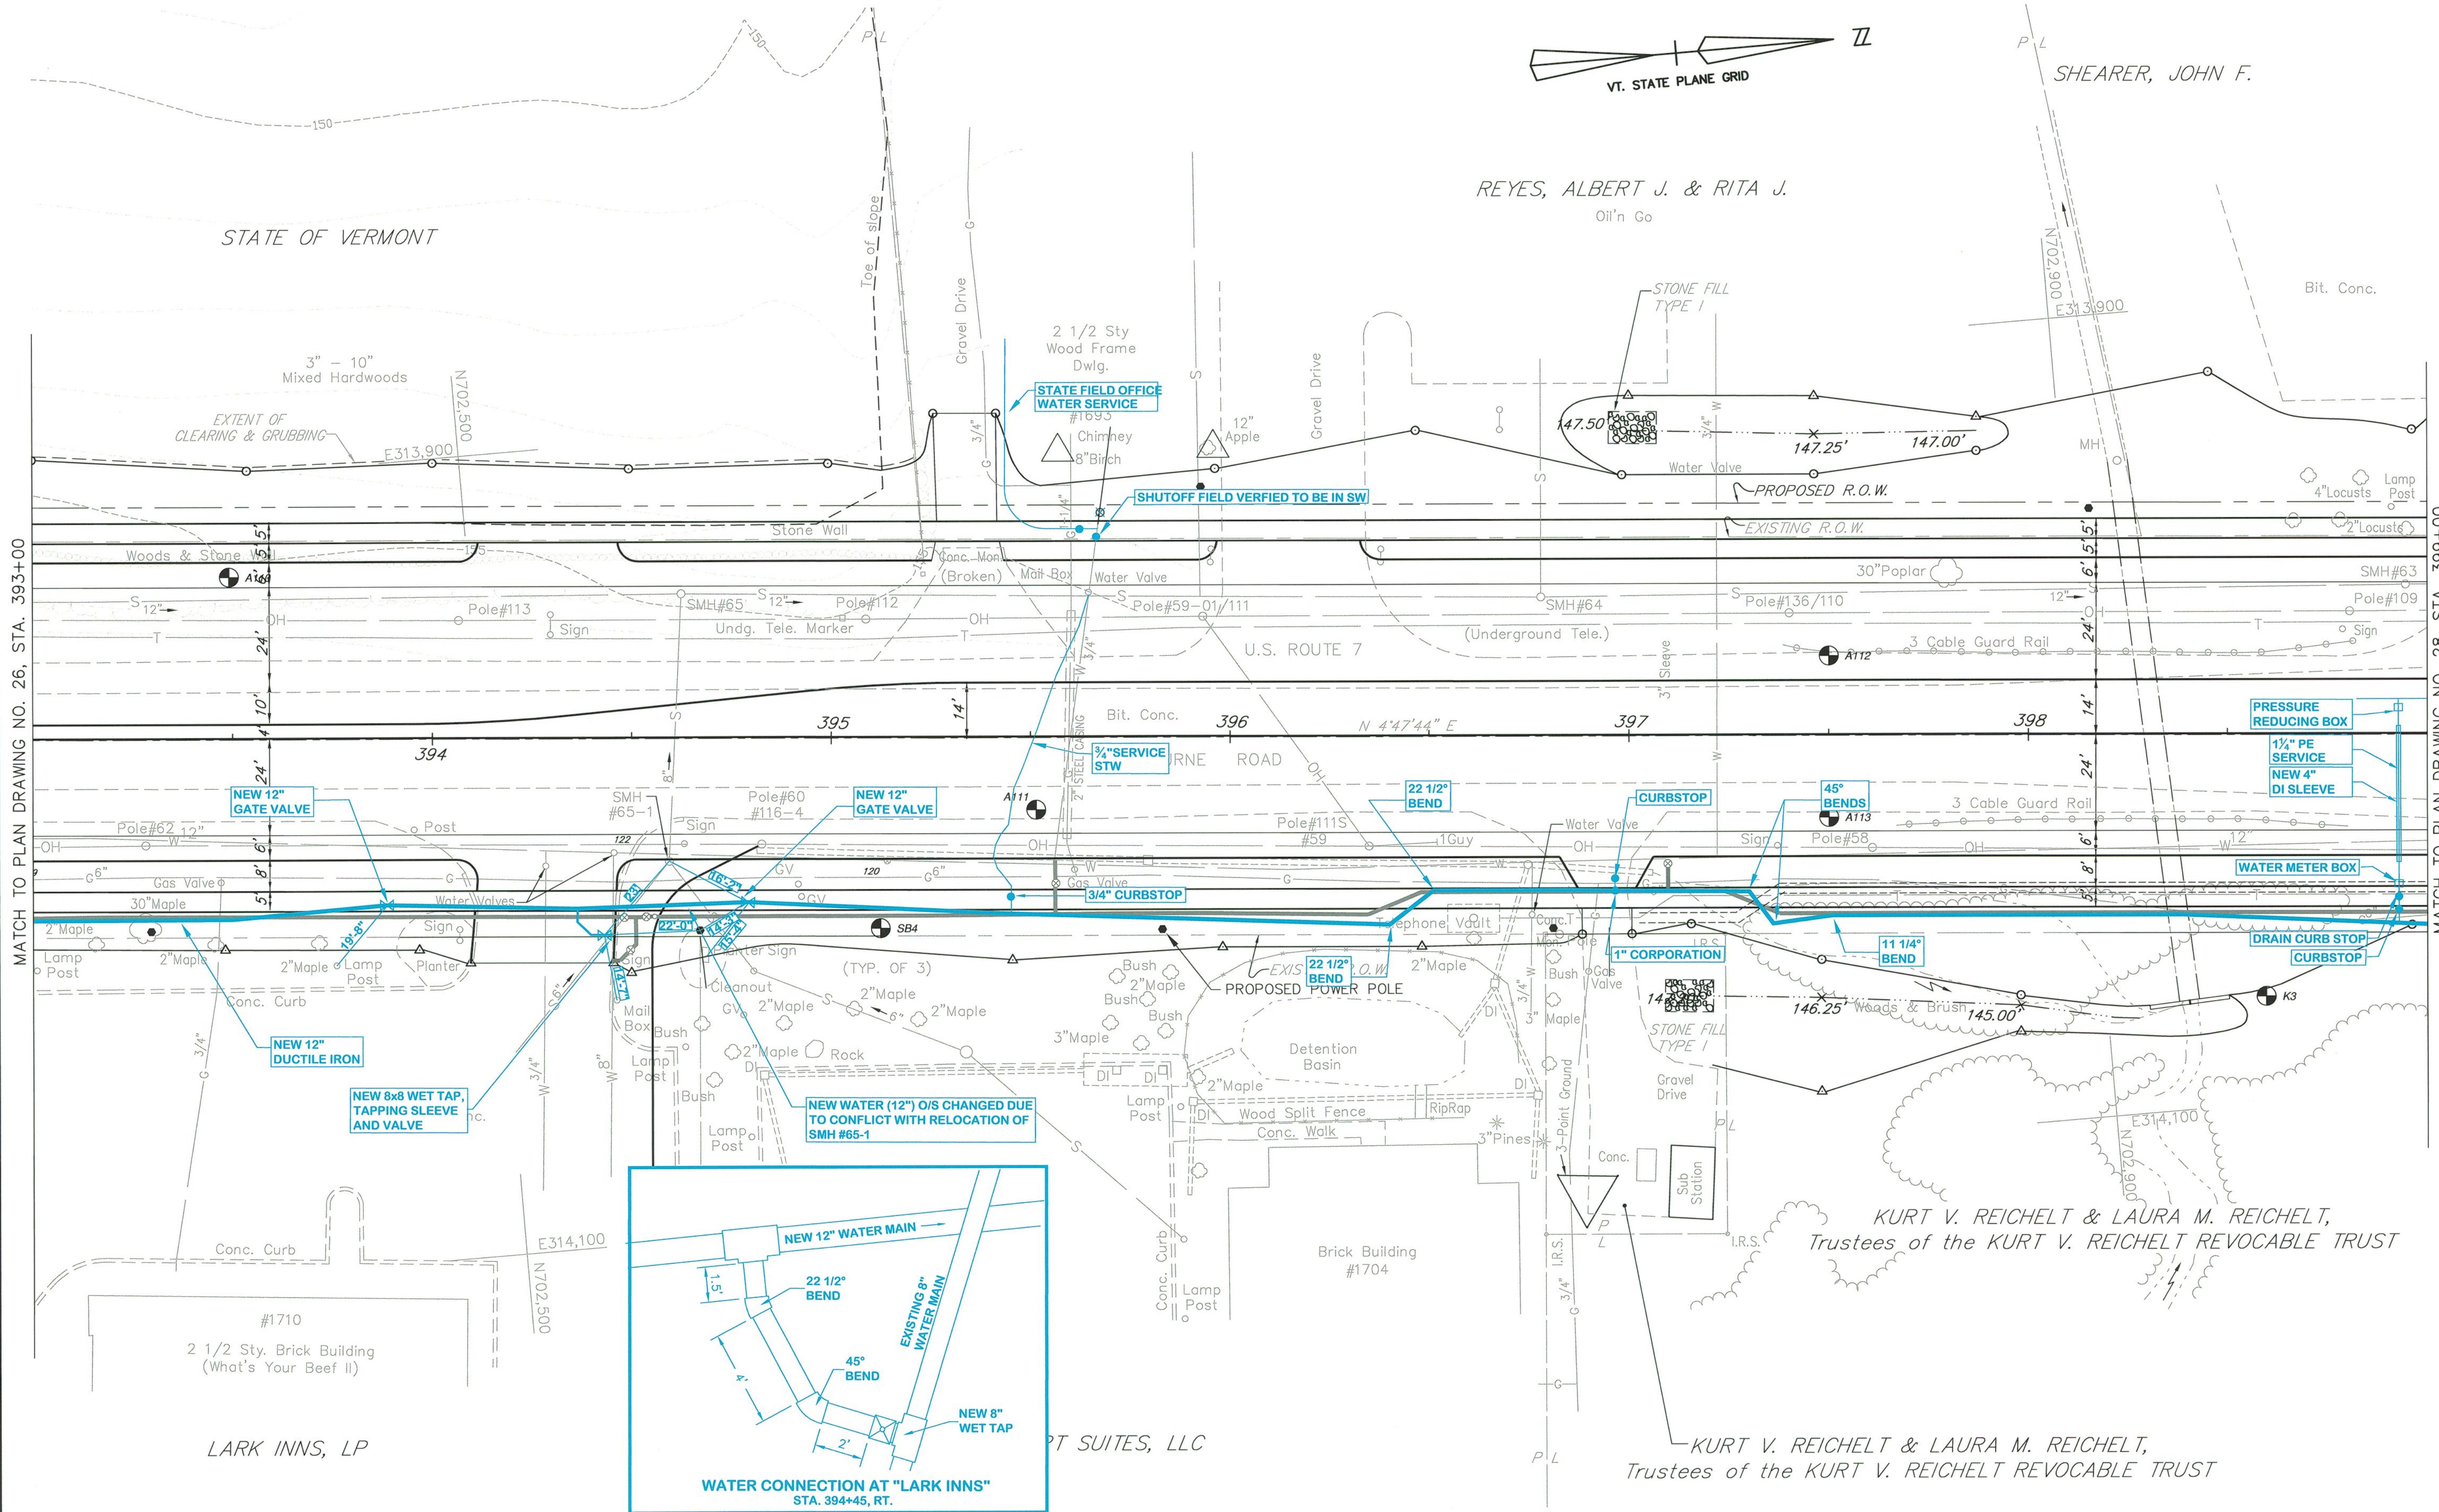

REVISIONS		
REV. #	DATE	BY

CONTRACT #63
WATER MAIN RELOCATION
U.S. ROUTE 7
"SHELBURNE ROAD"
SOUTH BURLINGTON,
VERMONT
PLAN VIEW
STA. 393+00 TO 399+00

247 of 283
DATE: APRIL, 2002
DESIGNED BY: RAP
DRAWN BY: EJP
CHECKED BY: RAP
APPROVED BY: RAP
FILE NAME: 2000_C63-pl3(27)
SHEET 6 OF 18
DRAWING No.

PL3

LEGEND

AS-BUILT WATERLINE

AS-DESIGNED WATERLINE

AS-BUILT REVISIONS		
NO.	DATE	DESCRIPTION
1.	4/5/05	AS-BUILT MAINLINE WATER ADDED
2.	3/8/06	MAINLINE WATER EDITED
3.	8/9/06	FINAL WATERLINE EDITS

NOTE: SEE DRAWING # PR2 SHEET 8 OF 18,
FOR PIPELINE PROFILE