



K:\6330008 (US Rte 7 Shelburne Rd)\AS-BUILT\TSHWATER\SEWER\2000_C63-pl4(28).dwg, Layout1, 9/12/2005 3:02:24 PM, jarmada, 14x11, 40/117, BRL-JRP, 105cm East

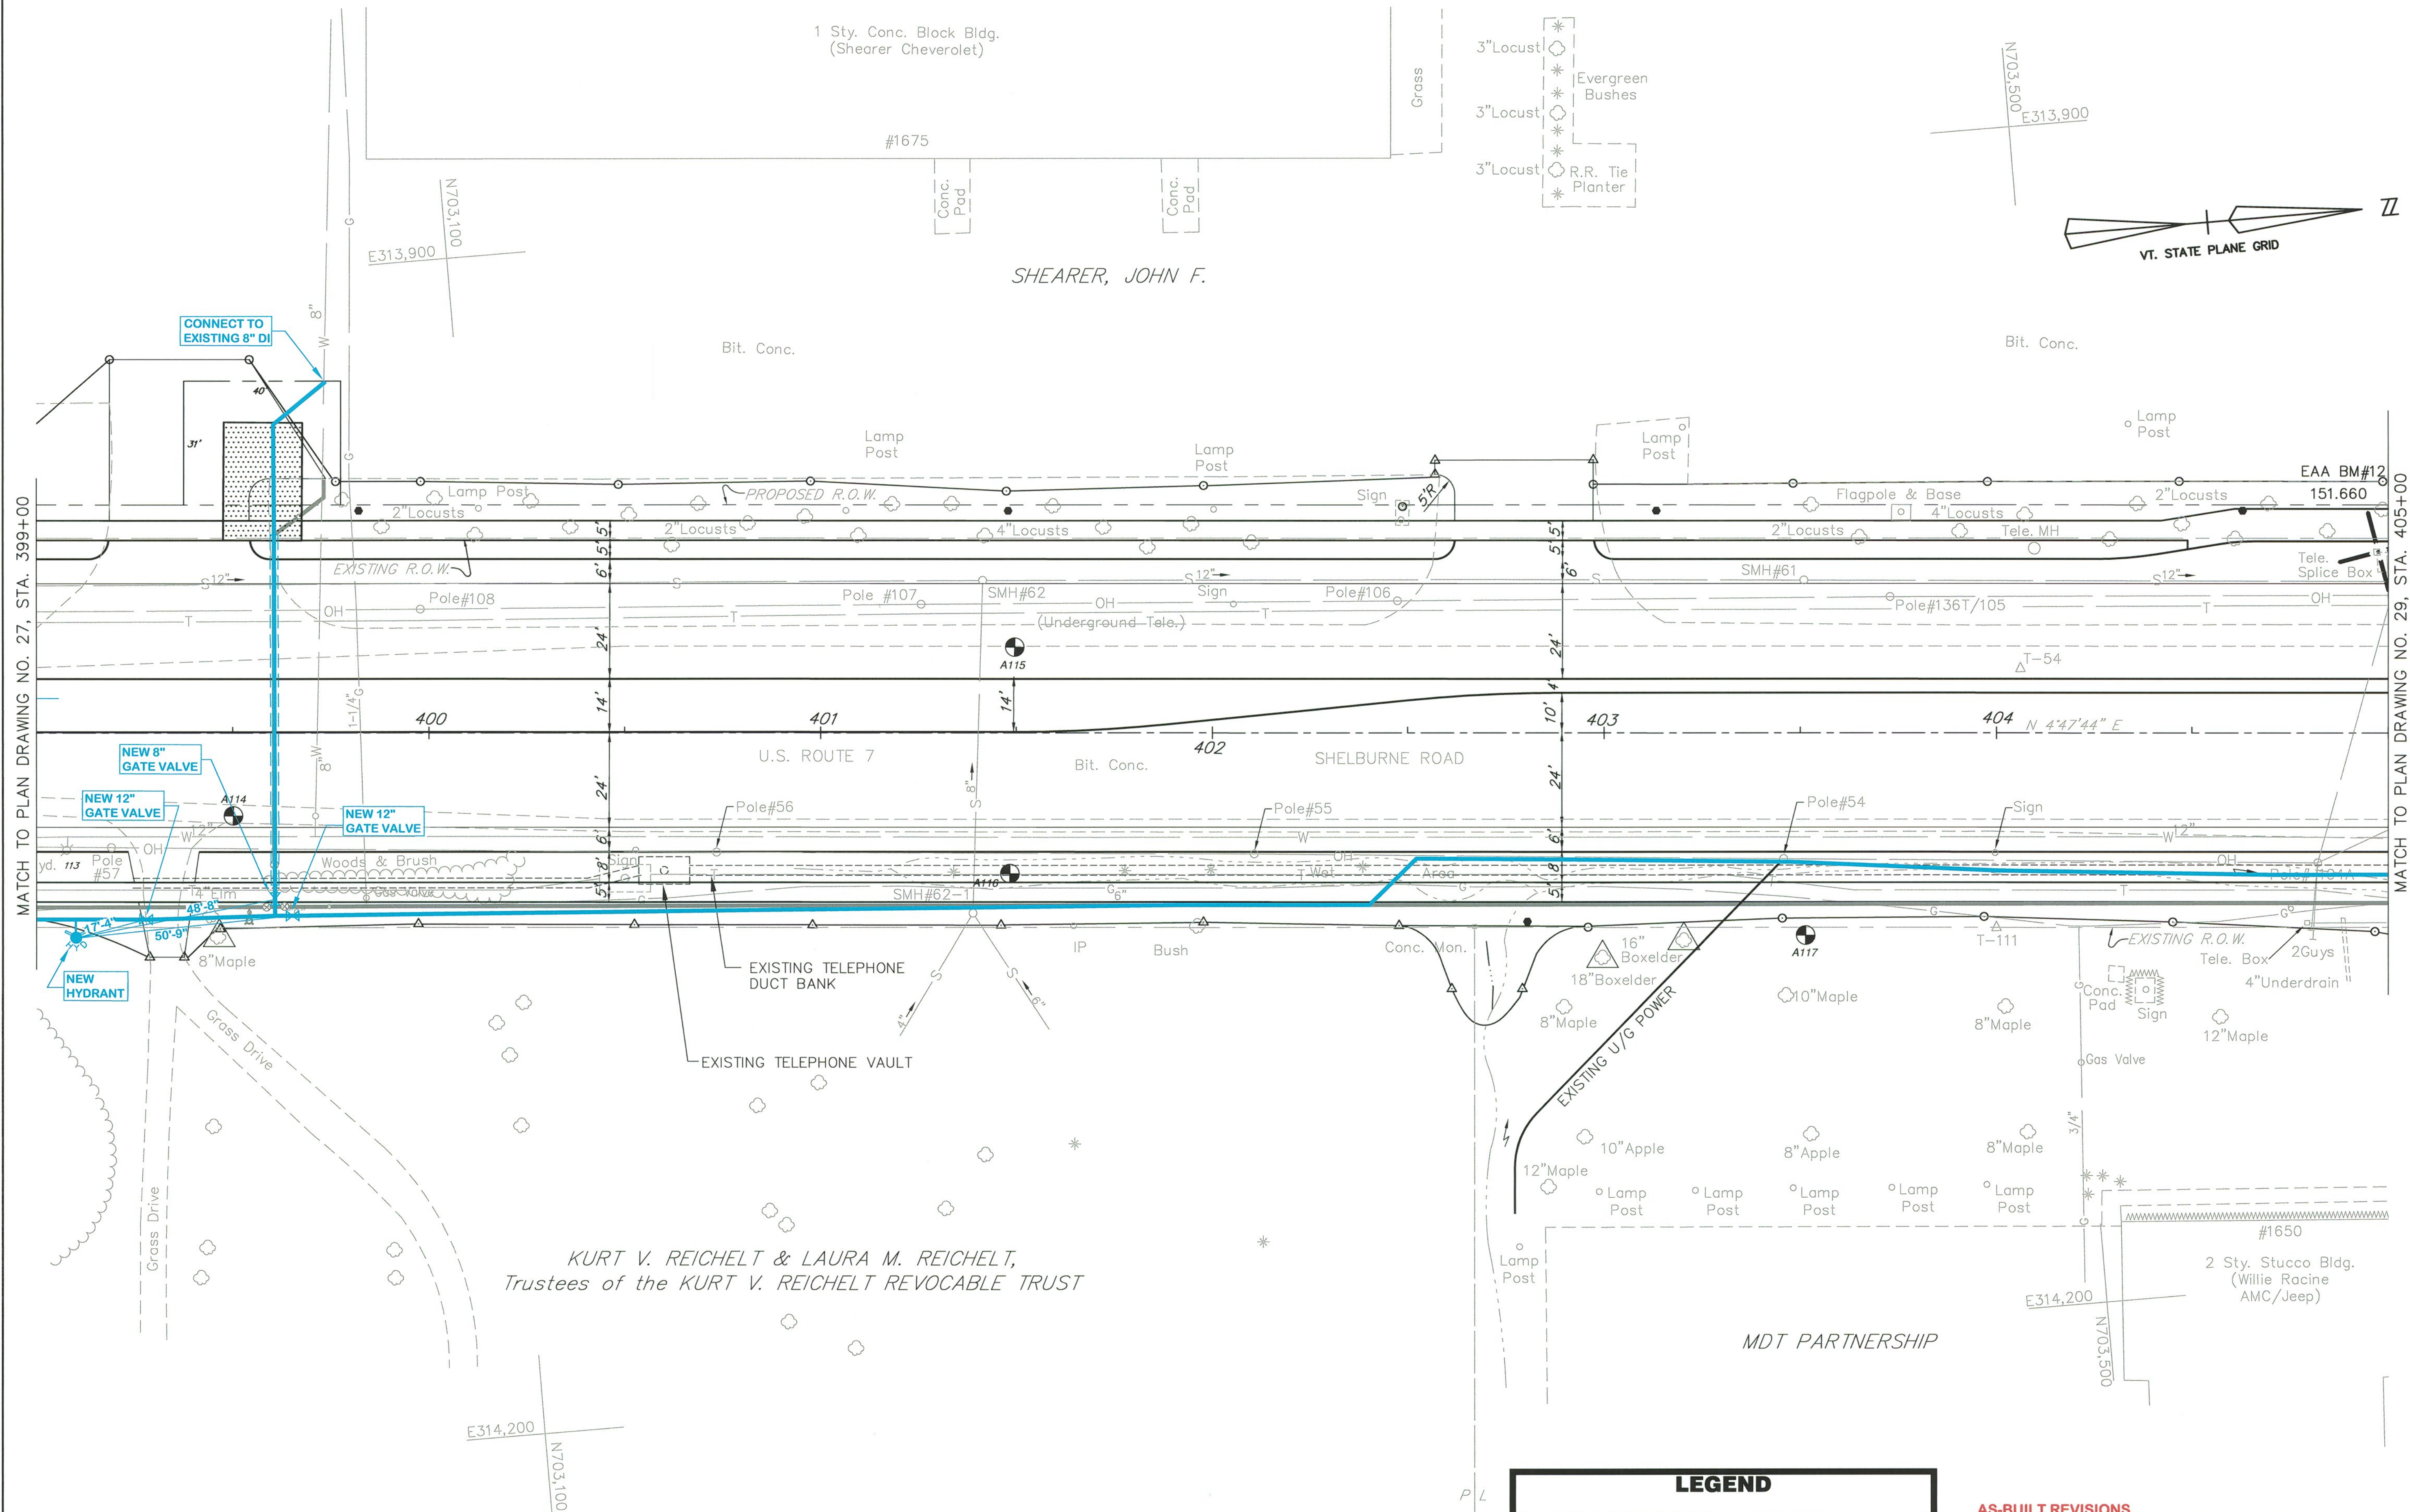

LEGEND	
AS-BUILT WATERLINE	—
AS-DESIGNED WATERLINE	—

AS-BUILT REVISIONS	
NO.	DATE DESCRIPTION
1.	4/5/05 AS-BUILT MAINLINE WATER ADDED
2.	3/8/06 MAINLINE WATER EDITED
3.	8/9/06 FINAL WATERLINE EDITS

NOTE: SEE DRAWING # PR2, SHEET 8 OF 18,
FOR PIPELINE PROFILE

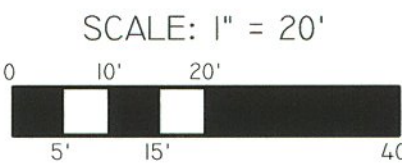

REVISIONS		
REV. #	DATE	BY