
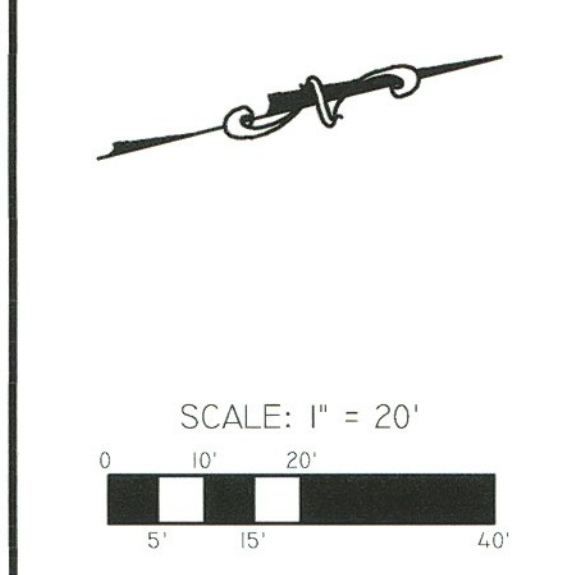


K:\6330008 (US Rte 7 Shelburne Rd)\AS BUILT\SWATER-SEWER\2000\_C63-pl5(29) DWG, Layout1, 9/5/2006 11:08:03 AM, pannaia, VT ERL HP 1055cm ExtalPage-Data1.p3

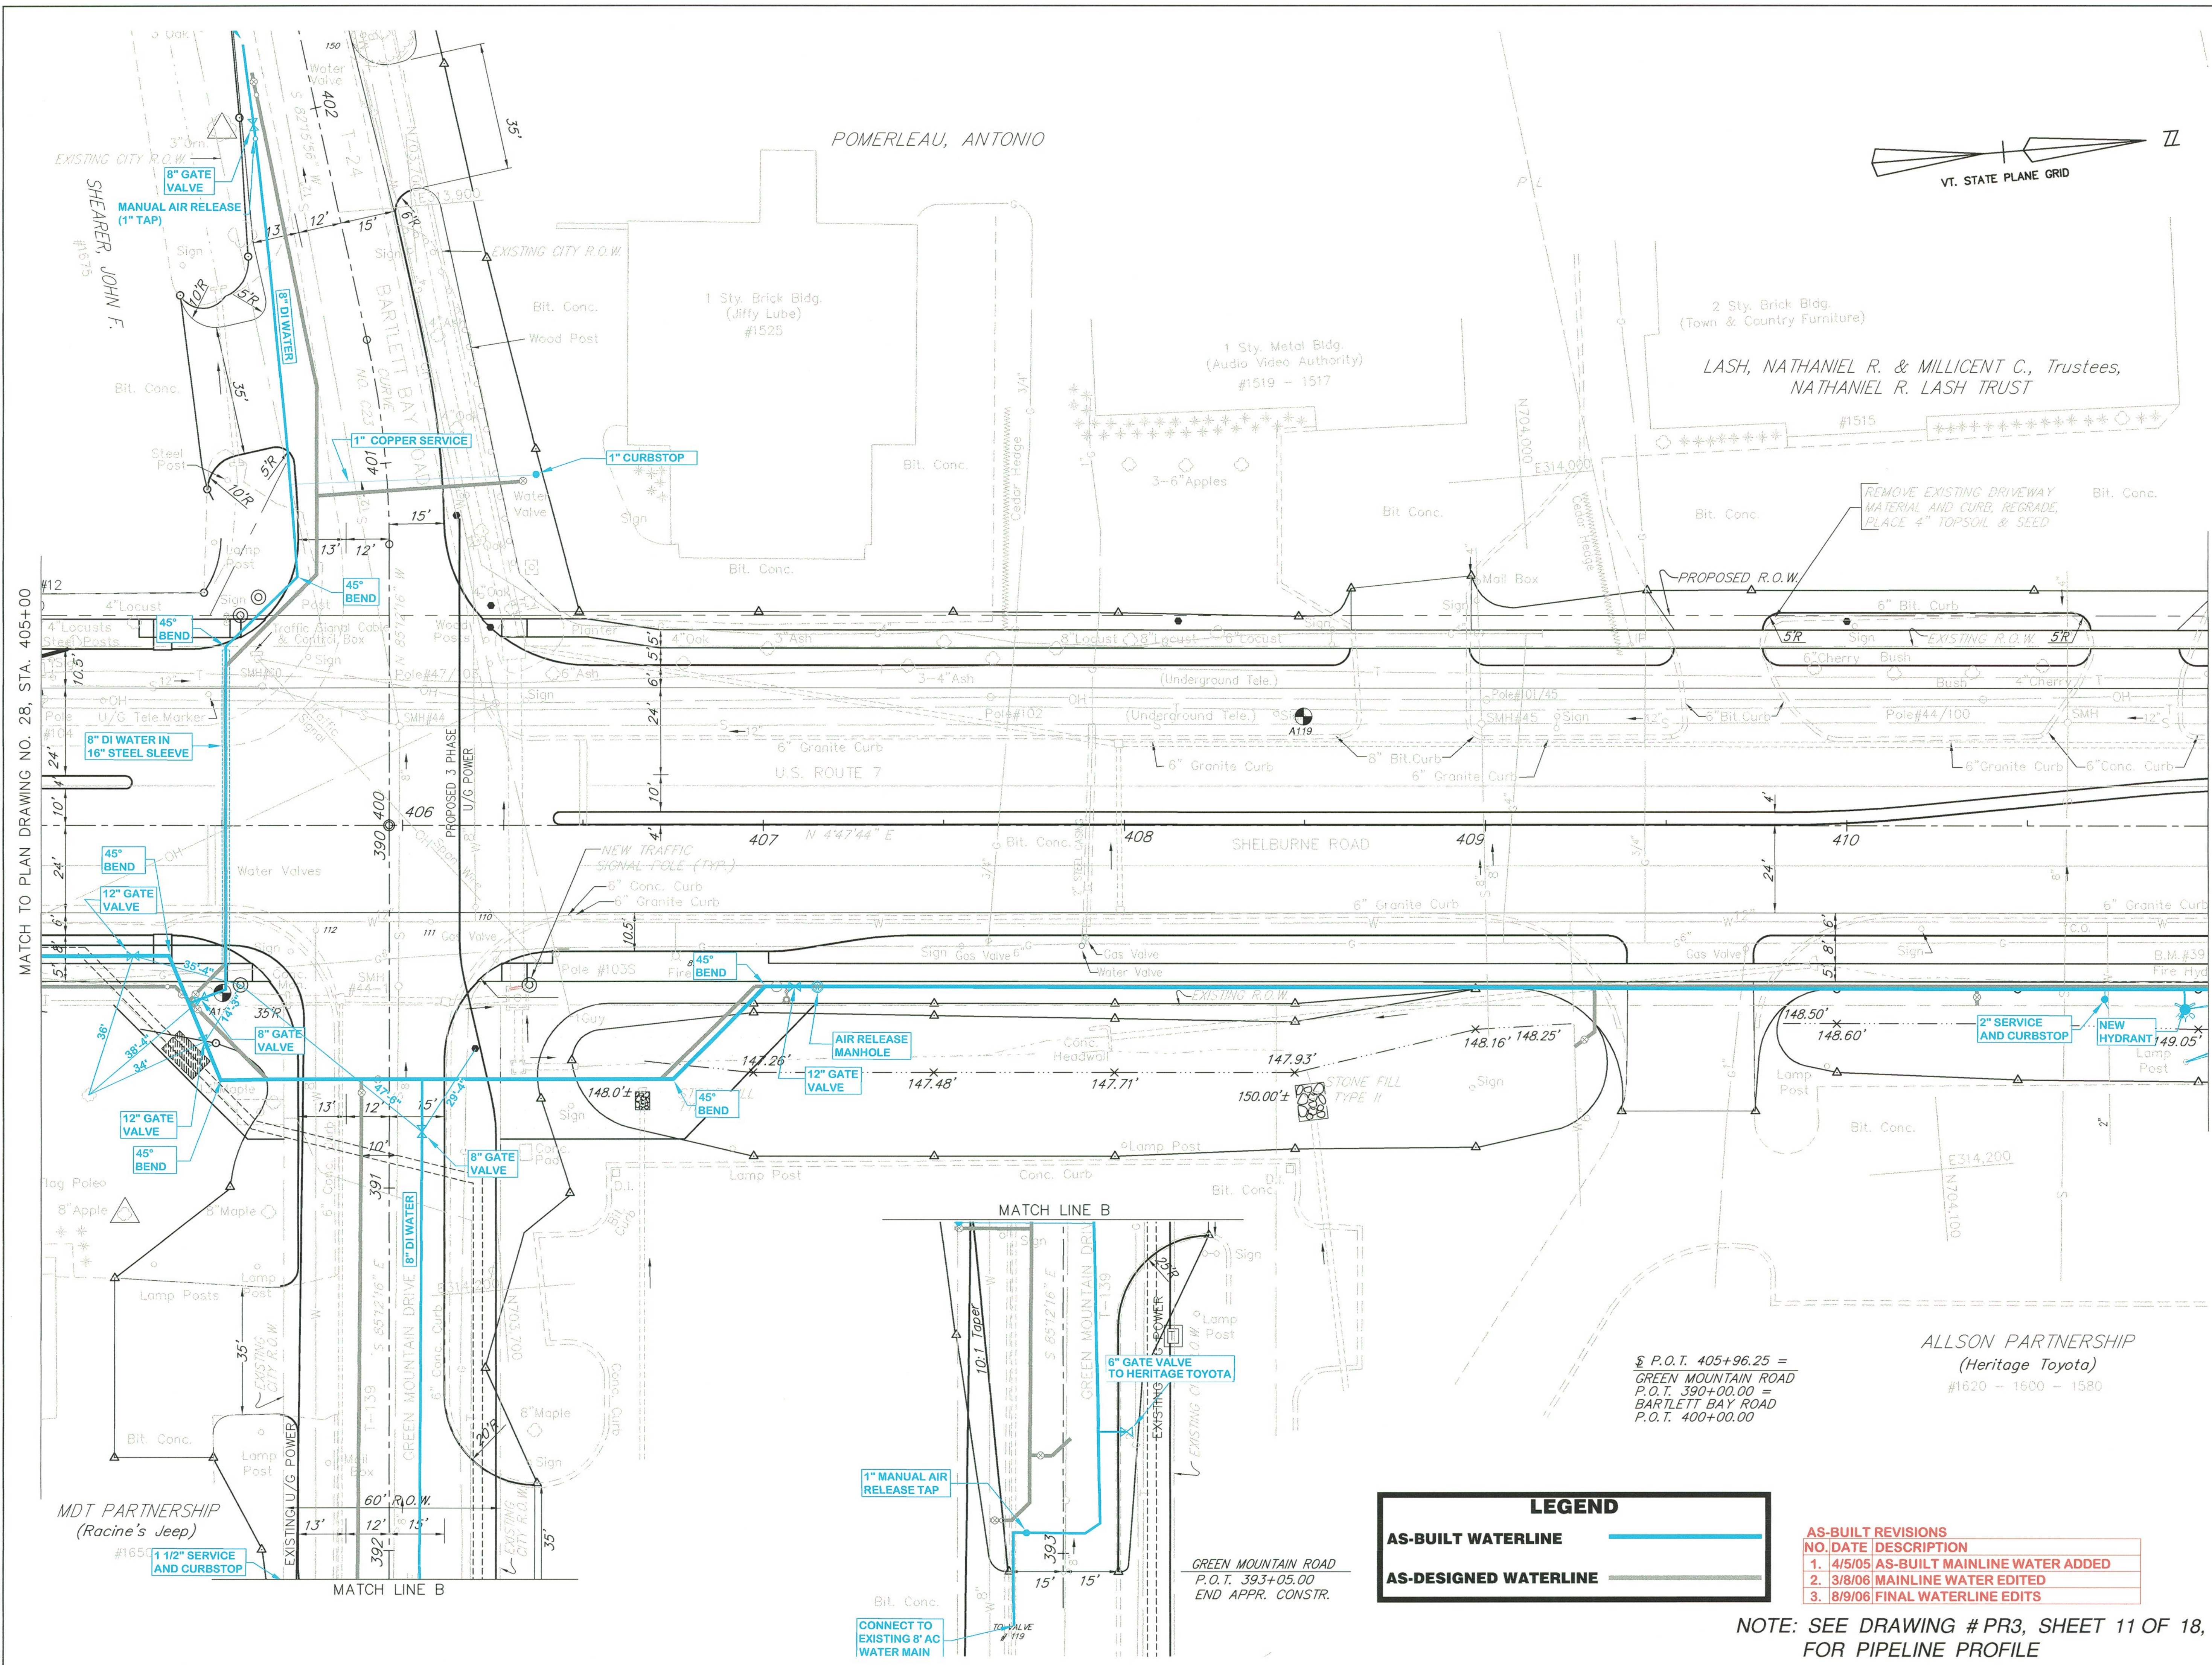

| REVISIONS |      |    |
|-----------|------|----|
| REV. #    | DATE | BY |
|           |      |    |
|           |      |    |
CONTRACT #63  
WATER MAIN RELOCATION  
U.S. ROUTE 7  
"SHELBURNE ROAD"  
SOUTH BURLINGTON,  
VERMONT  
PLAN VIEW  
STA. 405+00 TO 411+00

250 OF 283  
DATE: APRIL, 2002  
DESIGNED BY: RAP  
DRAWN BY: EJP  
CHECKED BY: RAP  
APPROVED BY: RAP  
FILE NAME: 2000\_C63-pl5(29)  
SHEET 9 OF 18  
DRAWING NO.

PL5

| LEGEND                |  |
|-----------------------|--|
| AS-BUILT WATERLINE    |  |
| AS-DESIGNED WATERLINE |  |

| AS-BUILT REVISIONS |                                      |
|--------------------|--------------------------------------|
| NO.                | DATE DESCRIPTION                     |
| 1.                 | 4/5/05 AS-BUILT MAINLINE WATER ADDED |
| 2.                 | 3/8/06 MAINLINE WATER EDITED         |
| 3.                 | 8/9/06 FINAL WATERLINE EDITS         |

NOTE: SEE DRAWING # PR3, SHEET 11 OF 18,  
FOR PIPELINE PROFILE