

Dedicated to Quality
Water and Service



SCALE: 1" = 20'

REVISIONS

REV. #	DATE	BY

CONTRACT #63

WATER MAIN RELOCATION
U.S. ROUTE 7
"SHELBURNE ROAD"


SOUTH BURLINGTON,
VERMONT

PLAN VIEW
STA. 411+00 TO 417+00

251 OF 283

DATE: APRIL, 2002
DESIGNED BY: RAP
DRAWN BY: EJP
CHECKED BY: RAP
APPROVED BY: RAP
FILE NAME: 2000_C63-pl6(30)
SHEET 10 OF 18
DRAWING No.

PL6

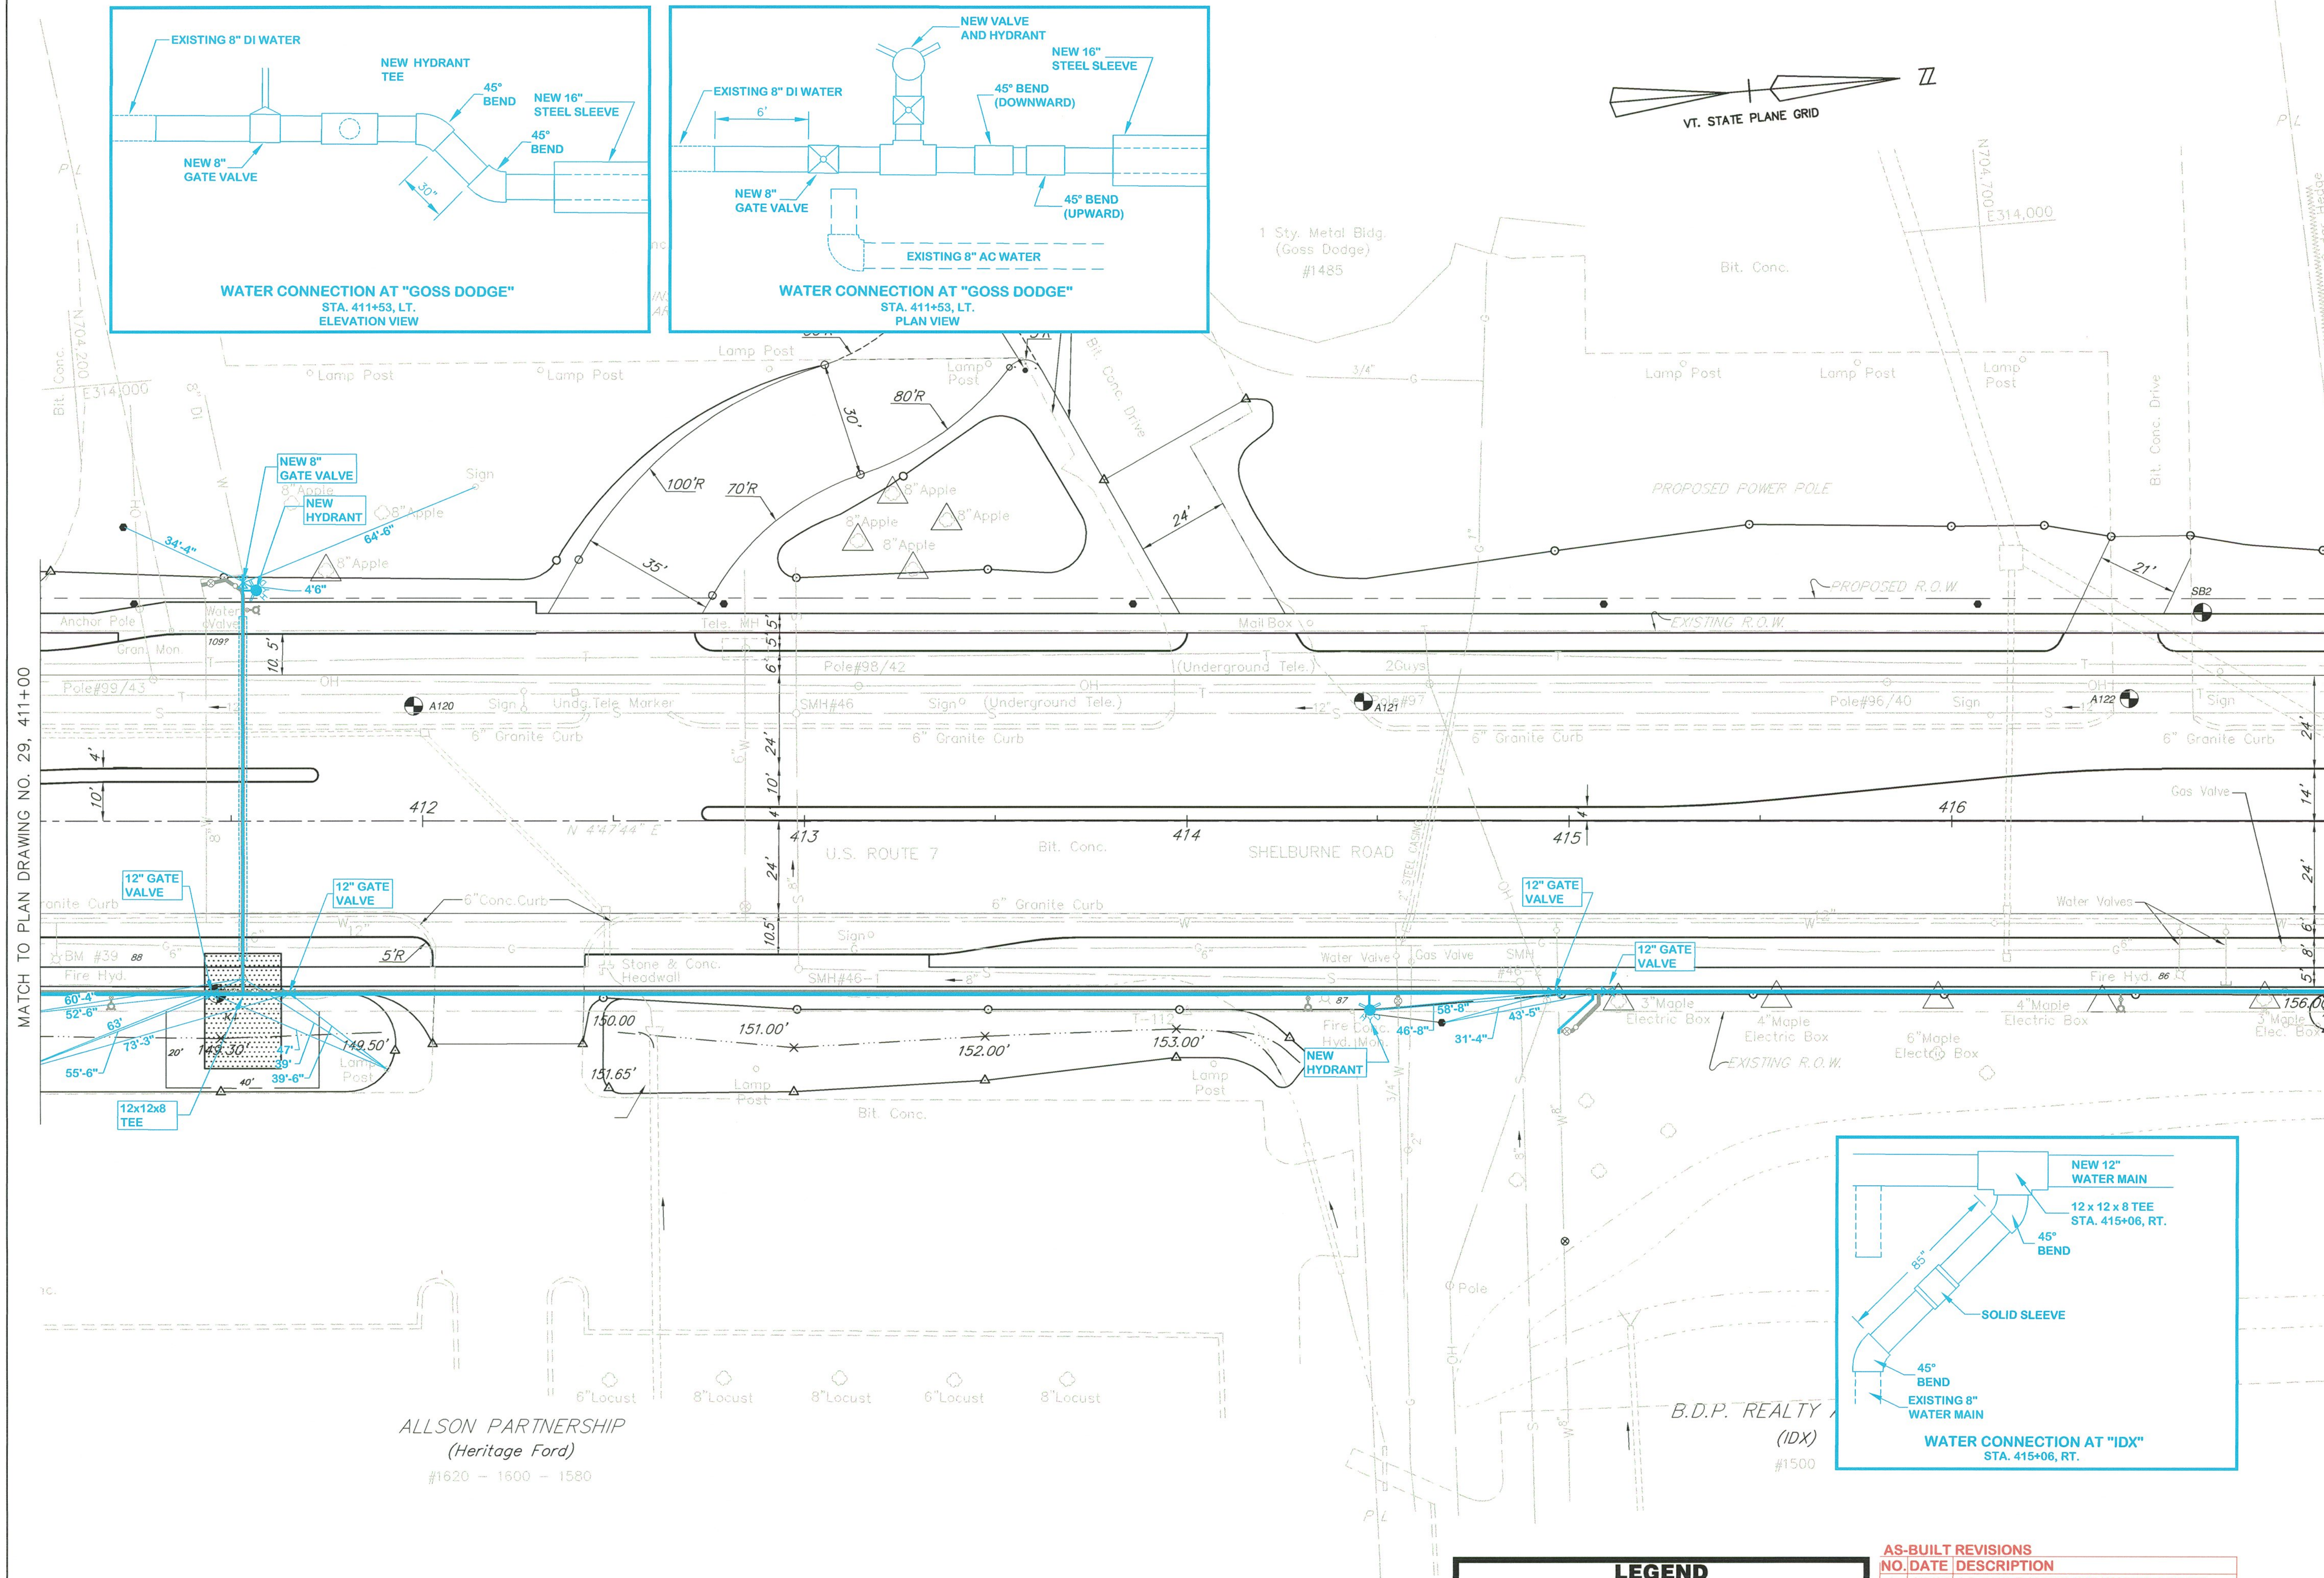

LEGEND

AS-BUILT WATERLINE

AS-DESIGNED WATERLINE

AS-BUILT REVISIONS

NO.	DATE	DESCRIPTION
1.	4/5/05	AS-BUILT MAINLINE WATER ADDED
2.	3/8/06	MAINLINE WATER EDITED
3.	8/9/06	FINAL WATERLINE EDITS

NOTE: SEE DRAWING PR3, SHEET 11 OF 18,
FOR PIPELINE PROFILE