

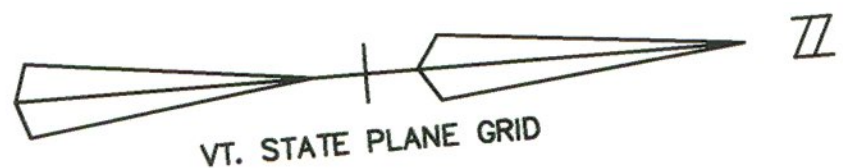


K:\6303008 US Rte 7 Shelburne Rd\AS-BUILT\WATER-SEWER\2000C63-pl7(31).dwg, Layout1, 9/12/2006 11:14:32 AM, pmlama, VT SBL-HP (055cm EastPaper-Drain).pc3

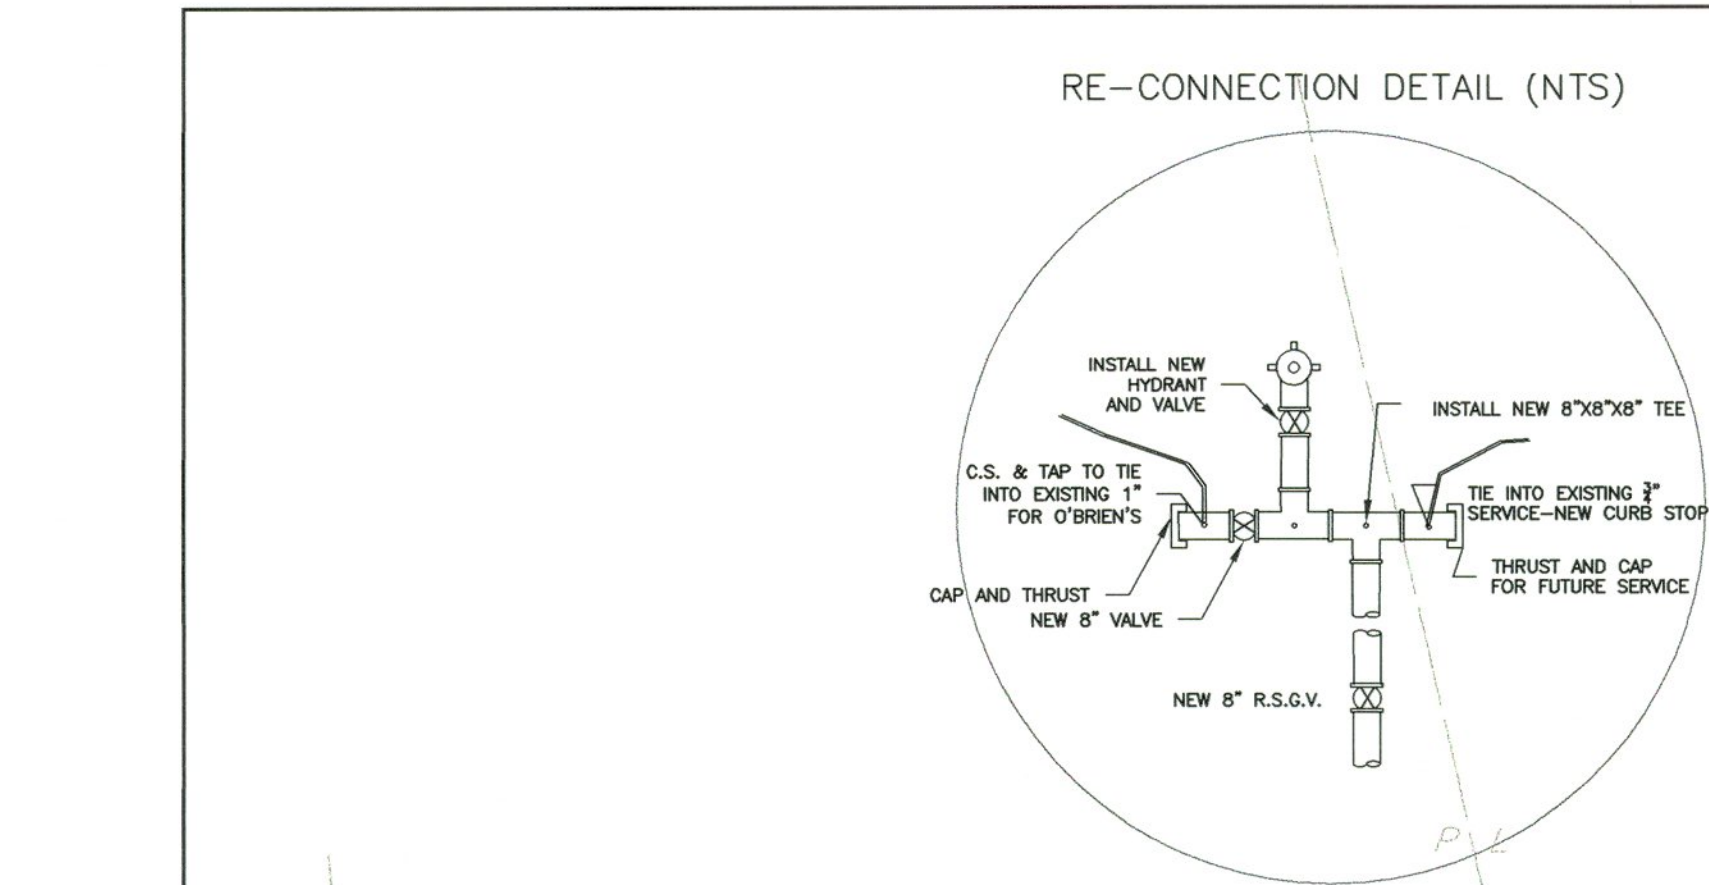

CHAMPLAIN WATER DISTRICT
403 Queen City Park Road
South Burlington, VT 05403
Phone: (802) 864-7454
Fax: (802) 864-0435

Dedicated to Quality
Water and Service

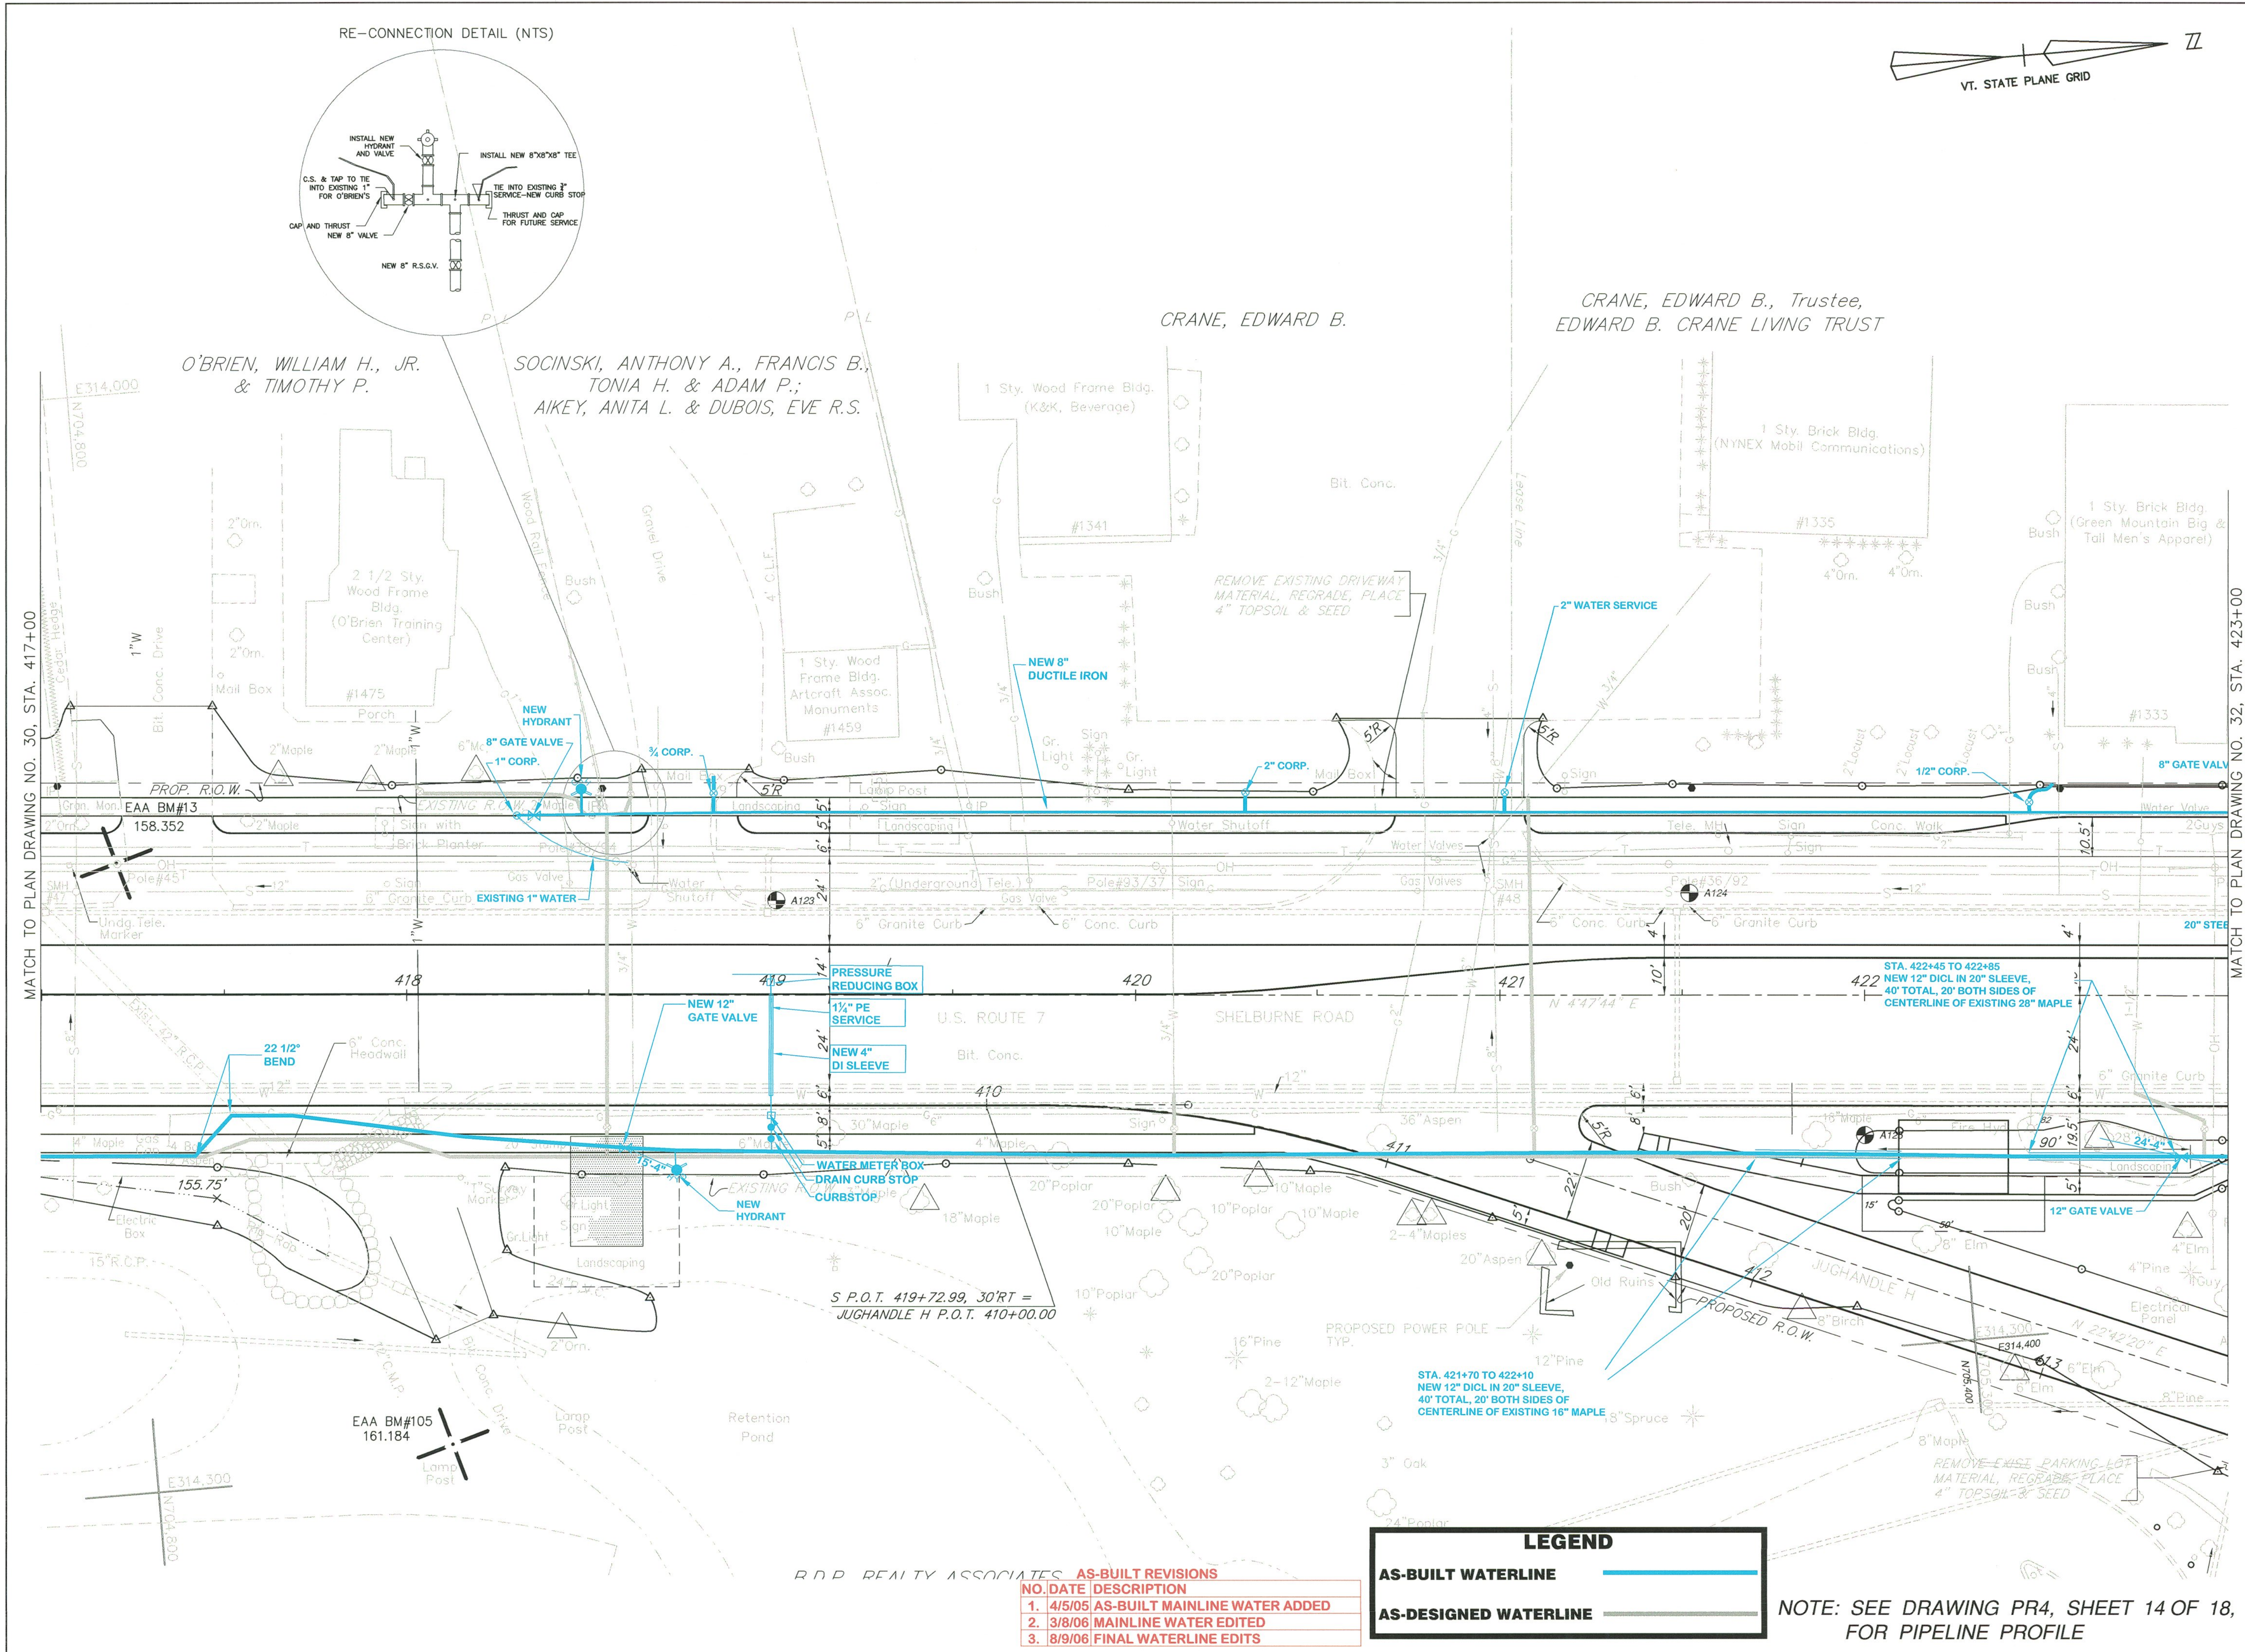

SCALE: 1" = 20'
0 10' 20' 40'

REVISIONS		
REV. #	DATE	BY

PLAN VIEW
STA. 417+00 TO 423+00

253 OF 283

DATE:	APRIL, 2002
DESIGNED BY:	RAP
DRAWN BY:	EJP
CHECKED BY:	RAP
APPROVED BY:	RAP
FILE NAME:	2000C63-pl7(31)
SHEET	12 OF 18
DRAWING No.	

LEGEND	
AS-BUILT WATERLINE	
AS-DESIGNED WATERLINE	

NOTE: SEE DRAWING PR4, SHEET 14 OF 18,
FOR PIPELINE PROFILE

AS-BUILT REVISIONS	
NO.	DATE DESCRIPTION
1.	4/5/05 AS-BUILT MAINLINE WATER ADDED
2.	3/8/06 MAINLINE WATER EDITED
3.	8/9/06 FINAL WATERLINE EDITS

PL7