


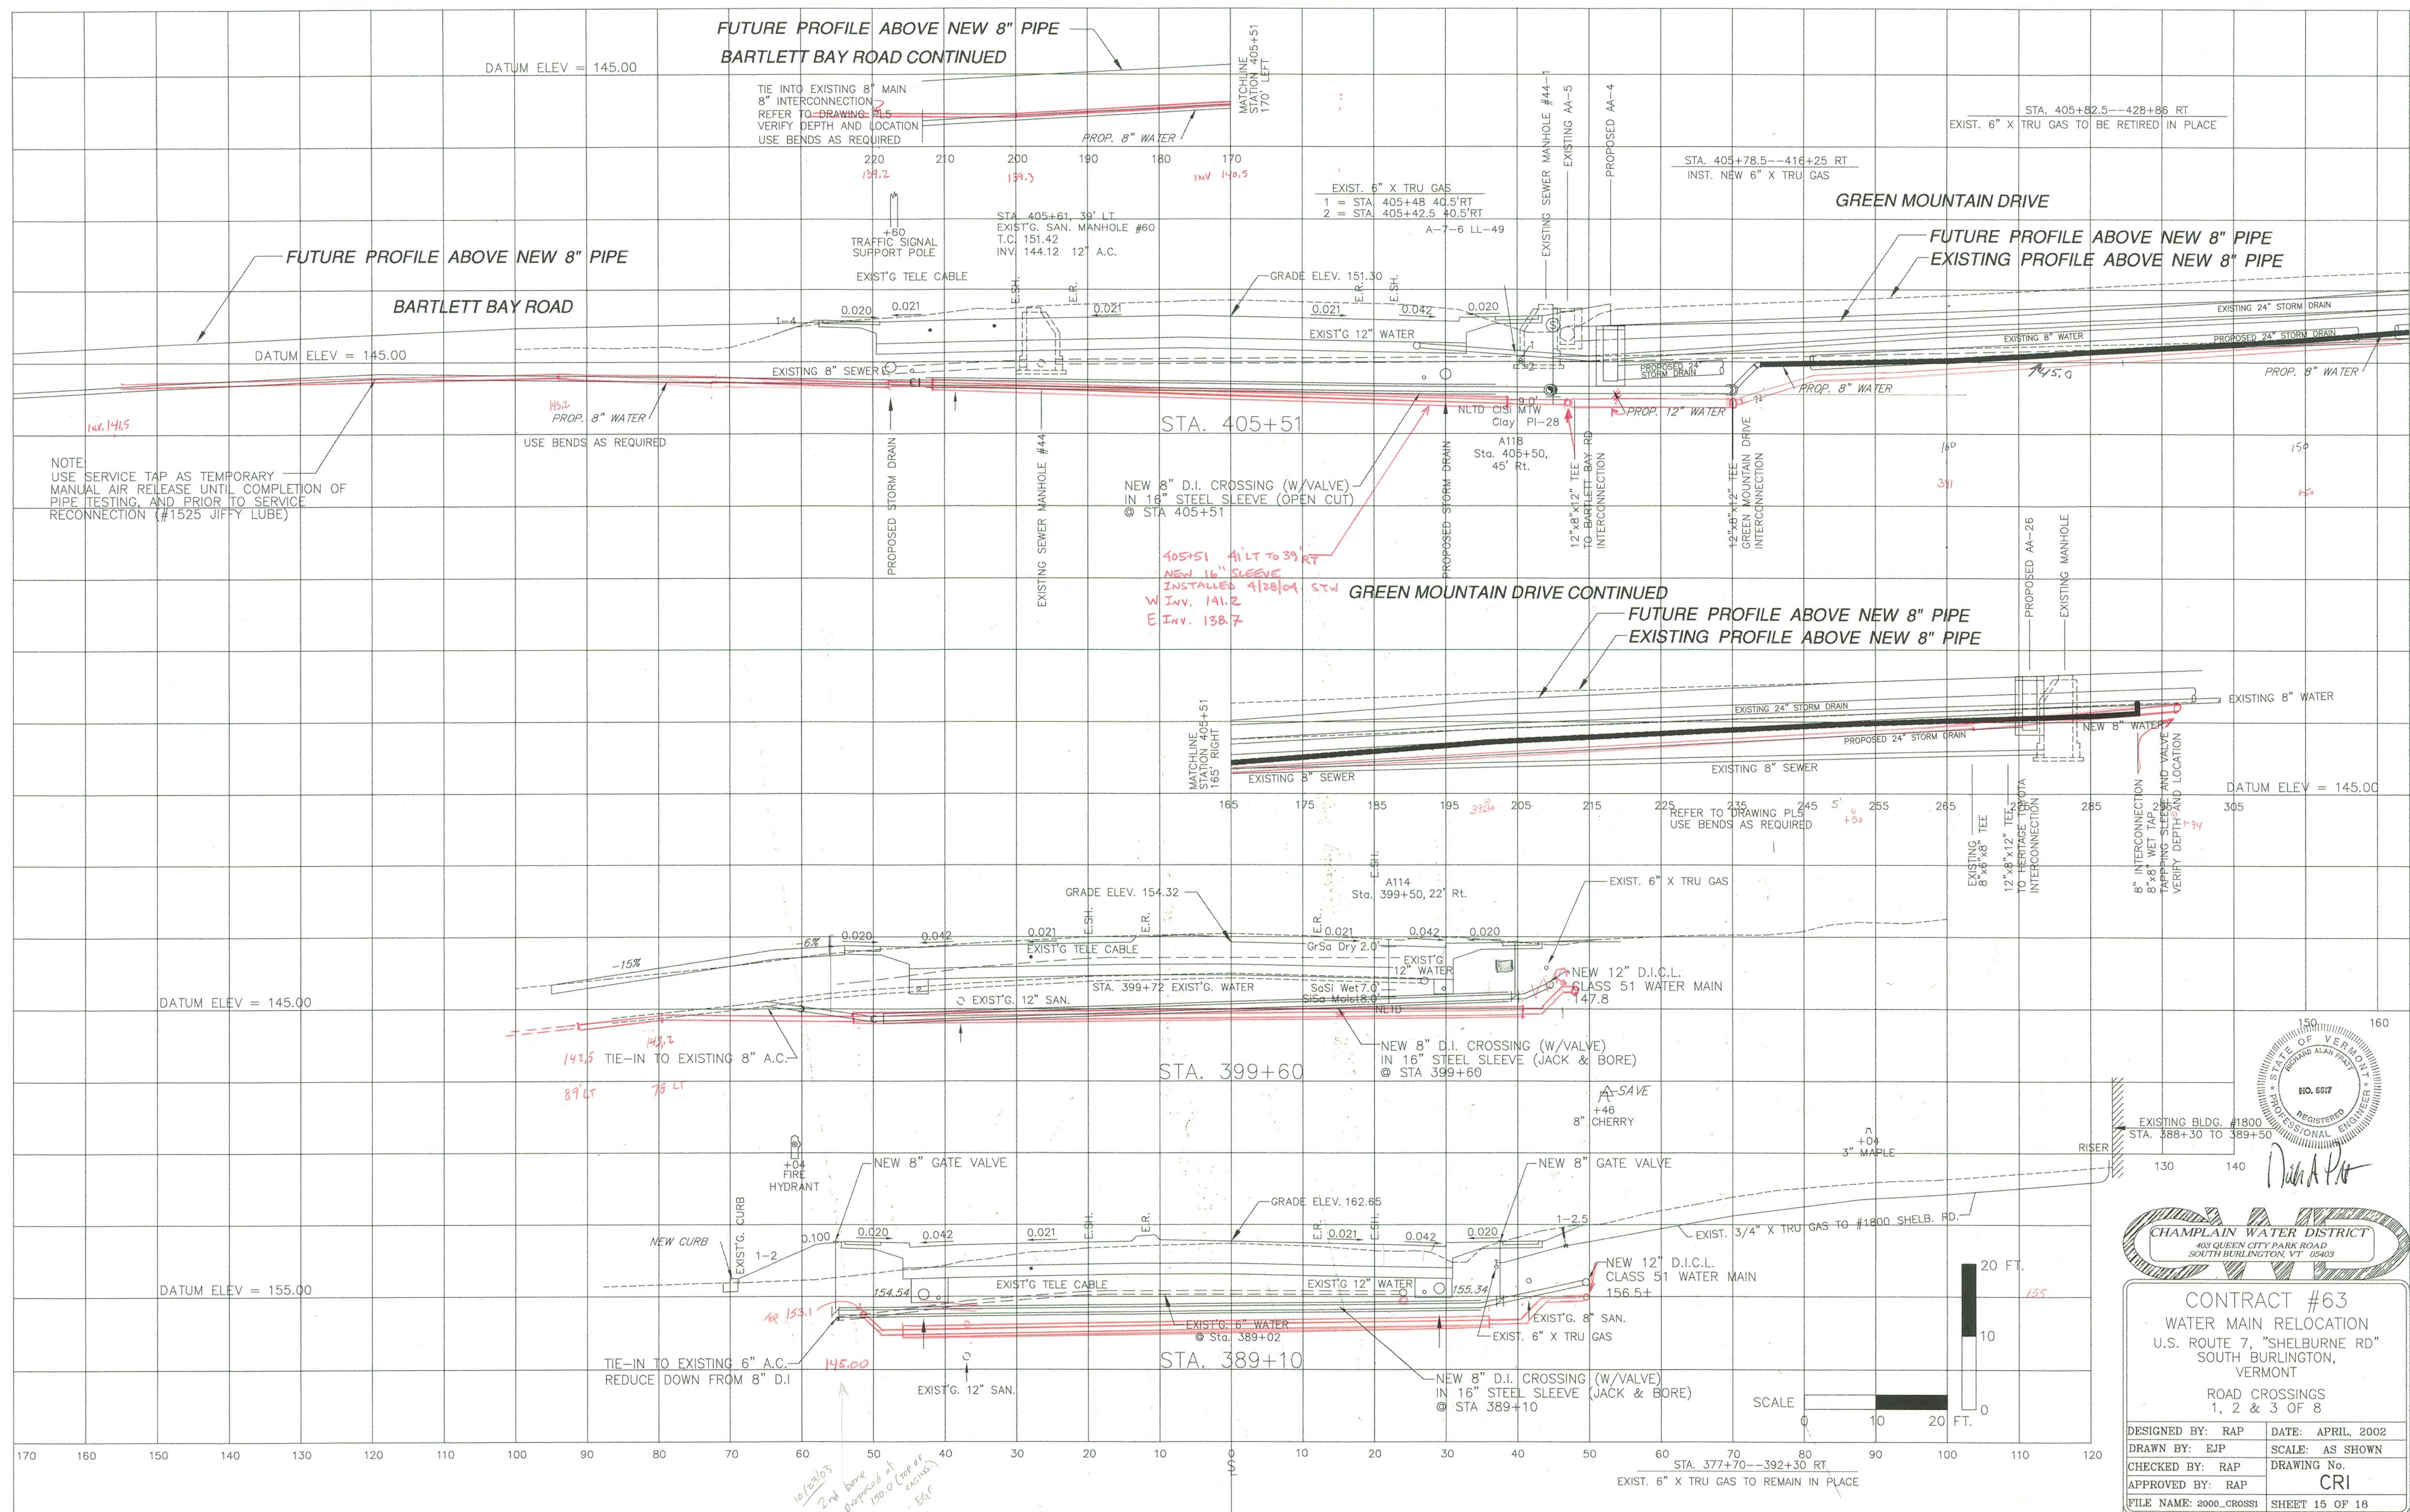

CHAMPLAIN WATER DISTRICT
403 QUEEN CITY PARK ROAD
SOUTH BURLINGTON, VT 05403

CONTRACT #63
WATER MAIN RELOCATION
U.S. ROUTE 7, "SHELburne RD"
SOUTH BURLINGTON,
VERMONT

ROAD CROSSINGS
1, 2 & 3 OF 8

DESIGNED BY: RAP	DATE: APRIL, 2002
DRAWN BY: EJP	SCALE: AS SHOWN
CHECKED BY: RAP	DRAWING NO.
APPROVED BY: RAP	CR1
FILE NAME: 2000_CROSS1	SHEET 15 OF 18

256 of 283