


NOTES:

1. UNDERGROUND AND AERIAL UTILITY LOCATIONS ARE PLOTTED BASED ON THE BEST AVAILABLE INFORMATION. LOCATIONS SHOULD BE VERIFIED BY THE CONTRACTOR BEFORE WORK.
2. SEE PLAN NOTES DRAWING NO. 1 FOR PLAN NOTES AND GENERAL NOTES.

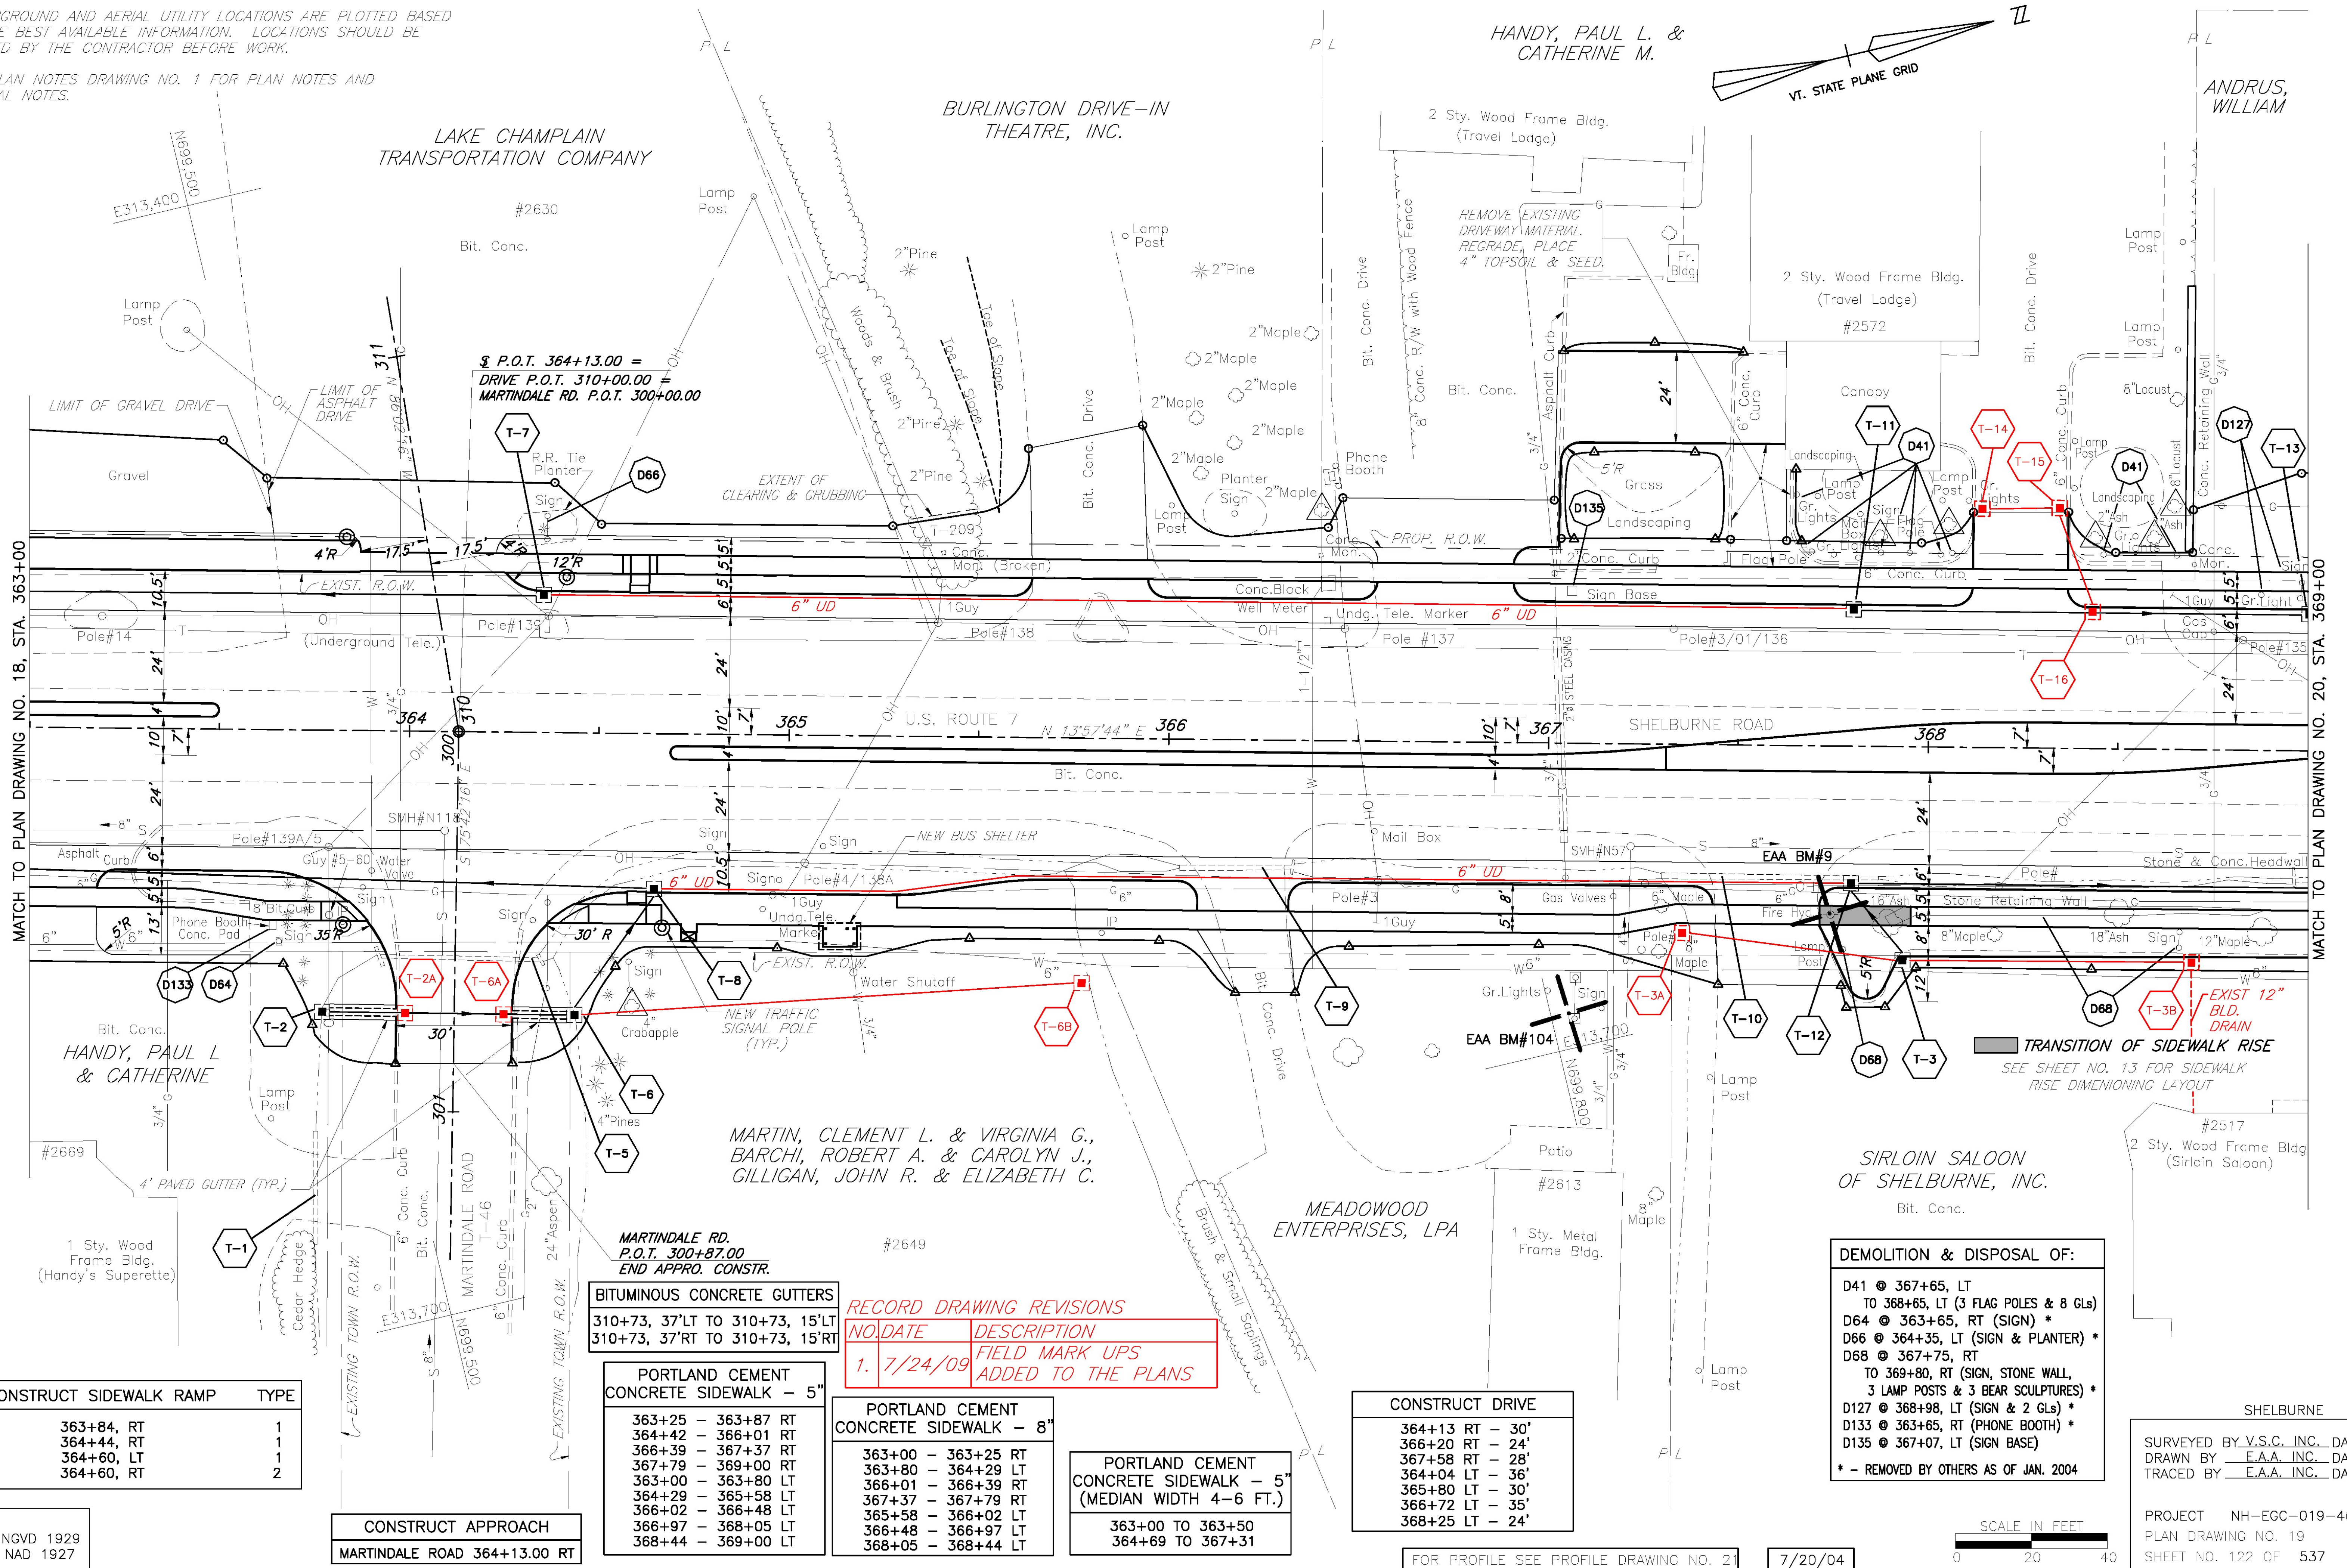

CONSTRUCT SIDEWALK RAMP	TYPE
363+84, RT	1
364+44, RT	1
364+60, LT	1
364+60, RT	2

CONSTRUCT APPROACH
MARTINDALE ROAD 364+13.00 RT

BITUMINOUS CONCRETE GUTTERS	
310+73, 37'LT TO 310+73, 15'LT	
310+73, 37'RT TO 310+73, 15'RT	
PORTLAND CEMENT CONCRETE SIDEWALK - 5"	
363+25 - 363+87 RT	
364+42 - 366+01 RT	
366+39 - 367+37 RT	
367+79 - 369+00 RT	
363+00 - 363+80 LT	
364+29 - 365+58 LT	
366+02 - 366+48 LT	
366+97 - 368+05 LT	
368+44 - 369+00 LT	

RECORD DRAWING REVISIONS	
NO.	DATE
1.	7/24/09
DESCRIPTION	
FIELD MARK UPS ADDED TO THE PLANS	

PORTLAND CEMENT CONCRETE SIDEWALK - 8"	
363+00 - 363+25 RT	
363+80 - 364+29 LT	
366+01 - 366+39 RT	
367+37 - 367+79 RT	
365+58 - 366+02 LT	
366+48 - 366+97 LT	
368+05 - 368+44 LT	

PORTLAND CEMENT CONCRETE SIDEWALK - 5" (MEDIAN WIDTH 4-6 FT.)	
363+00 TO 363+50	
364+69 TO 367+31	

CONSTRUCT DRIVE	
364+13 RT - 30'	
366+20 RT - 24'	
367+58 RT - 28'	
364+04 LT - 36'	
365+80 LT - 30'	
366+72 LT - 35'	
368+25 LT - 24'	

DEMOLITION & DISPOSAL OF:	
D41 @ 367+65, LT	
TO 368+65, LT (3 FLAG POLES & 8 GLs)	
D64 @ 363+65, RT (SIGN) *	
D66 @ 364+35, LT (SIGN & PLANTER) *	
D68 @ 367+75, RT	
TO 369+80, RT (SIGN, STONE WALL, 3 LAMP POSTS & 3 BEAR SCULPTURES) *	
D127 @ 368+98, LT (SIGN & 2 GLs) *	
D133 @ 363+65, RT (PHONE BOOTH) *	
D135 @ 367+07, LT (SIGN BASE)	
* - REMOVED BY OTHERS AS OF JAN. 2004	

SHELBURNE

SURVEYED BY V.S.C. INC. DATE _____
 DRAWN BY E.A.A. INC. DATE _____
 TRACED BY E.A.A. INC. DATE _____

PROJECT NH-EGC-019-4(27)
 PLAN DRAWING NO. 19
 SHEET NO. 122 OF 537

DATUM
 VERTICAL NGVD 1929
 HORIZONTAL NAD 1927

FOR PROFILE SEE PROFILE DRAWING NO. 21

7/20/04

SCALE IN FEET
 0 20 40