

646.415 DURABLE 150 mm YELLOW LINE

STA. 14+400.000 - STA. 16+000.000 SOLID LINE 3.6 m RT

646.615 TEMPORARY 150 mm YELLOW LINE

STA. 14+400.000 - STA. 16+000.000 SOLID LINE 3.6 m RT

646.414 DURABLE 150 mm WHITE LINE

S=SOLID, D=DASHED

STA. 14+400.000 - STA. 16+000.000 LT  $\frac{C}{D}$  RT  $\frac{C}{D}$   
STA. 14+400.000 - STA. 16+000.000 SOLID LINE 3.6 m LT


646.614 TEMPORARY 150 mm WHITE LINE

S=SOLID, D=DASHED

STA. 14+400.000 - STA. 16+000.000 LT  $\frac{C}{D}$  RT  $\frac{C}{D}$   
STA. 14+400.000 - STA. 16+000.000 SOLID LINE 3.6 m LT

675.50 REMOVING SIGNS

AS SHOWN - 3

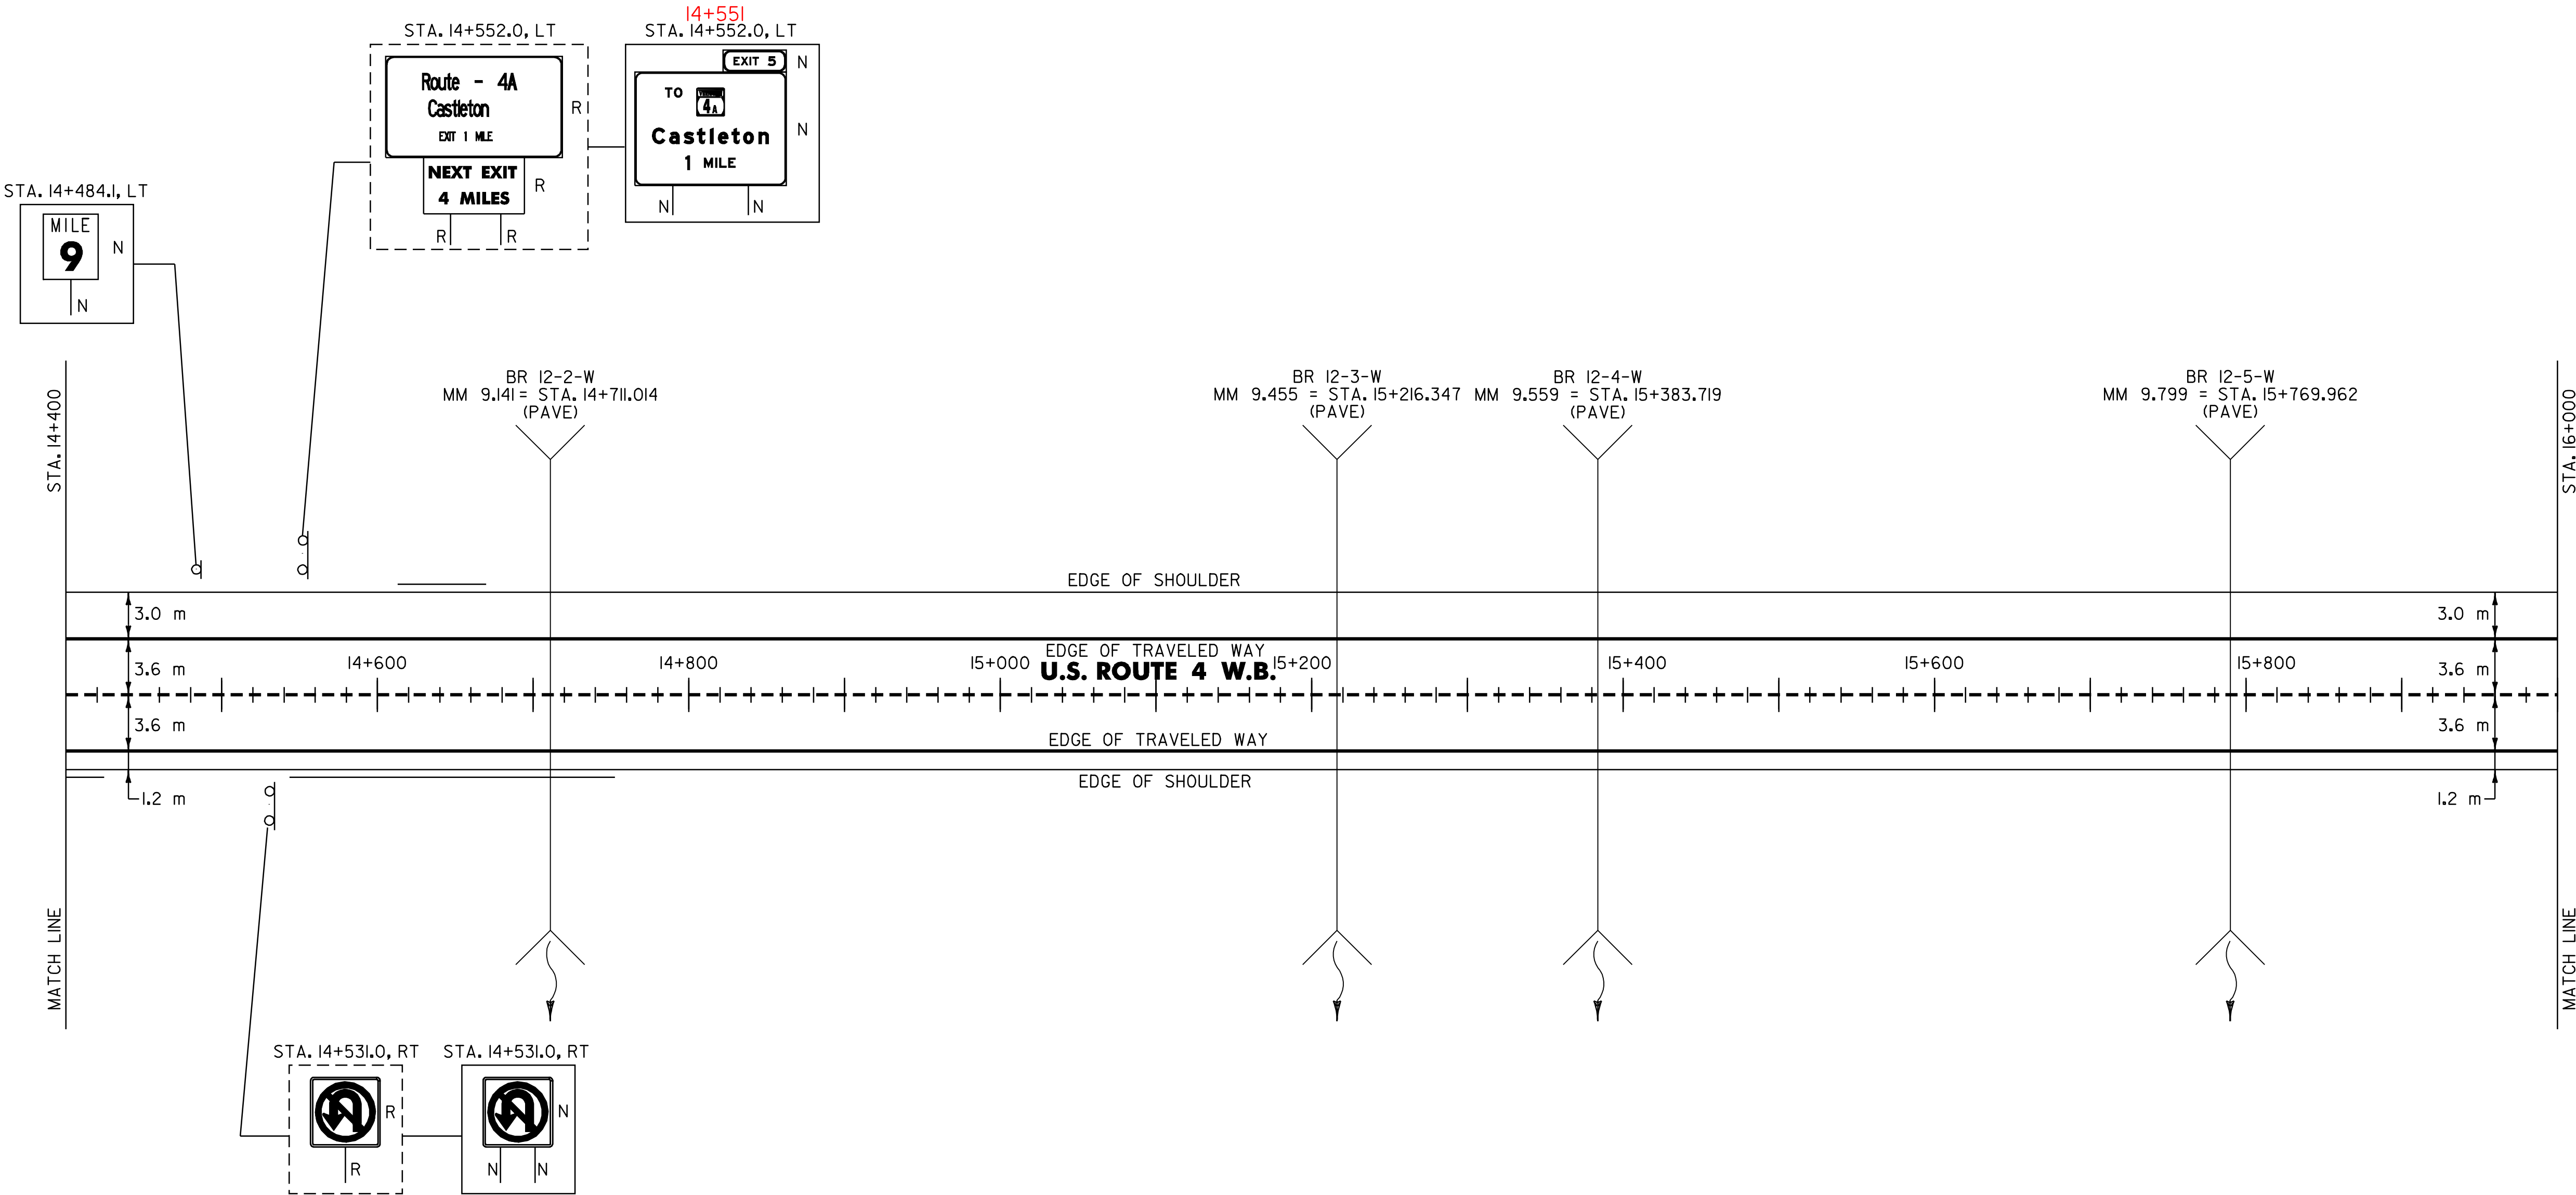

621.20 STEEL BEAM GUARDRAIL

~~532.1~~ STA. 14+400.0 - STA. 14+413.0 RT (13.0 m) ~~708~~  
~~STA. 14+543.4 - STA. 14+741.0 RT (197.6 m)~~  
~~570~~ STA. 14+612.9 - STA. 14+658.5 LT (45.6 m) ~~635~~

621.54 MODIFIED ECCENTRIC LOADER TERMINAL

~~STA. 14+413.0 - STA. 14+424.4 RT~~  
~~635~~ STA. 14+658.5 - STA. 14+669.9 LT ~~646.5~~  
~~708~~ STA. 14+741.0 - STA. 14+752.4 RT ~~719.4~~

621.60 ANCHOR FOR STEEL BEAM RAIL

STA. 14+544.0 RT ~~532~~  
STA. 14+613.5 LT ~~565~~

621.80 REMOVAL AND DISPOSAL OF GUARDRAIL

~~709~~ STA. 14+400.0 - STA. 14+413.0 RT (13.0 m) ~~534~~  
~~STA. 14+572.0 - STA. 14+741.0 RT (169.0 m)~~  
~~570~~ STA. 14+611.0 - STA. 14+666.0 LT (55.0 m) ~~646~~

SIGN LEGEND

R= REMOVE  
S= SALVAGE  
N= NEW  
RET= RETAIN  
B-B= BACK TO BACK  
EXISTING= -----  
NEW= -----

PAVING  
PROJECT  
LAYOUT

SURVEYED BY N/A DATE N/A  
DRAWN BY J.N. DATE 8/98  
SQUAD LEADER T.P.K.  
DESIGN FILE NO. /pave/96bl54/pbl54.dgn  
IPARM pbl54110.i DATE N/A  
FILE PLOTTED  
PROJ. NAME FAIR HAVEN - RUTLAND  
PROJ. NO. NH 9727(1)S  
SHEET 21 OF 119 SHEETS

|            |     |
|------------|-----|
| DATUM      |     |
| VERTICAL   | N/A |
| HORIZONTAL | N/A |